

Appendix 2

Structural Proposal



S. T. Wong & Partners Ltd

Consulting Engineers

黃成增顧問工程師有限公司

Telephone 2625-1776
Mobile 9320-6580
Facsimile 2467-9618
Address Flat B, 8/F, Lee May Building,
788-790 Nathan Road, Kowloon, HK
九龍彌敦道788-790號利美大廈八樓B室
Email stwong@st Wong.com.hk
Website www.stwong.com.hk

PROJECT:

HUNG HOM BAY RECLAMATION PHASE II, HUNG
HOM (NORTH) FERRY PIER, HONG KONG

Structural Appraisal Report
Apr 2024

Title

AP/RSE

Name

Wong Shing Tsang
(RSE 12/00)

Signature

Date

03 April 2024

I. Introduction

This report presents a structural appraisal calculation for addition of a proposed sprinkler water tank and sprinkler pump room on the roof floor of Hung Hom (North) Ferry Pier, Hung Hom, Kowloon, Hong Kong.



II. Relevance Regulations and Code of Practices for Checking

The works shall be carried out in strict compliance with, but not limited to the following:

- Hong Kong Building (Construction) Regulation
- Code of Practice for the Structural Use of Steel –2011
- Code of Practice for Structural Use of Concrete – 2013
- Code of Practice for Dead and Imposed Load – 2011
- Code of Practice on Wind Effects in Hong Kong – 2019

III. Design Data

1.1 Dead Load:

Reinforced Concrete Self-weight = 24.5 kN/m^3 ,

Water Density = 9.81 kN/m^3 ,

Sprinkler Water Tank Self-weight = 2150kg,

Sprinkler Pump Room Self-weight = 300kg.

1.2 Wind Pressure: Water Tank = 1.991kPa

Effective height = 13.65m, $Q_{0,z} = 2.08 \text{ kPa}$, $C_p = 1.1$, $S_s = 1.024$, $L_{0.5p} = 10$

IV. Existing Structural Data

- a). Concrete Grade of structural elements to be designed concrete mix with following minimum strength at 28 days and maximum size of aggregate 20mm:
Column, wall, beam, slab and staircases - 40MPa
- b). Concrete Cover:
40mm above +4.000 Chart Datum (C.D.)
60mm at or below +4.000 C.D.
75mm bottom of pile cap unless otherwise specified.
- c). All reinforcement to comply with B.S. 4449.
- d). Existing Slab Thickness = 150mm

V. Conclusion

In conclusion, the proposed addition of water tanks on the roof is structurally feasible. Steel beams are proposed to transfer the extra load of the water tanks to the columns directly.

In general, the existing structures (columns and piles) are capable for supporting the new loading from the proposed water tanks.

Appendices

Appendix A *Structural Calculation*


Appendix B *Drawings*

Appendix C *Record Plan*

Appendix A

Structural Calculation

Loading

 S. T. Wong & Partners Ltd Consulting Engineers 黃成增顧問工程師有限公司		Project Structural Study for the Existing Ferry Pier To Kwa Wan (DeSpace)																																																																
Section	Additional loading	Rev.	Page:																																																															
Subject		Date																																																																
REF.	CALCULATIONS		OUTPUT																																																															
	<p><u>Loading</u></p> <p>Loading due to two new sprinkler water tanks and sprinkler pump room (Assume Size = 7m x 4m x 3m (H) = 84m³ x 2 tanks = 168m³ with capacity of not less than 110m³ Assume Size = 1.5m x 2.5m x 1m (H) = 3.75m³ Loading due to New Steel Platform (Assume 8.3m x 5.3m x 3.9m(H)) and New Steel Catwalk (Assume Size = 3.35m x 0.6m) Dead Load (D.L.), Live Load (L.L.) and Wind Load (W.L.) should be considered are as follows:</p> <p><u>D.L.: Include Self-Weight of Water Tank, steel works, etc.</u></p> <table> <tr> <td>Assume Dead Weight of New Steel Platform with Barrier Railing</td> <td>=</td> <td>1.000 kPa</td> </tr> <tr> <td>On Steel Platform, D.L. = 8.3m x 5.3m x 1kPa</td> <td>=</td> <td>43.990 kN</td> </tr> <tr> <td>On Steel Catwalk, D.L. = 3.35m x 0.6m x 1kPa</td> <td>=</td> <td>2.010 kN</td> </tr> <tr> <td>Self-weight of Water Tank, D.L. = 2 x 2150kg x 9.81ms⁻²/1000</td> <td>=</td> <td>42.183 kN</td> </tr> <tr> <td>Self-weight of sprinkler pump room, D.L. = 300kg x 9.81ms⁻²/1000</td> <td>=</td> <td>2.943 kN</td> </tr> </table> <p><u>L.L.: Imposed Load for Roof and Water Load</u></p> <table> <tr> <td>Imposed load for roof</td> <td>=</td> <td>2.000 kPa</td> </tr> <tr> <td>On Steel Platform, L.L. = 8.3m x 5.3m x 2kPa</td> <td>=</td> <td>87.980 kN</td> </tr> <tr> <td>On Steel Catwalk, L.L. = 3.35m x 0.6m x 2kPa</td> <td>=</td> <td>4.020 kN</td> </tr> </table> <p>Water Load</p> <table> <tr> <td>Case A) For the 110,000Litres (110m³) water, 110m³x9.81N/m³</td> <td>=</td> <td>1079.1 kN</td> </tr> <tr> <td>Case B) For the maximum 70% of the 168,000Litres (168m³) water, = (168x0.7)m³x9.81kN/m³</td> <td>=</td> <td>1153.7 kN</td> </tr> </table> <p><u>W.L.: Wind force acting on sprinkler water tank</u></p> <table> <tr> <td>Breadth of the sprinkler water tank</td> <td>=</td> <td>7.000 m</td> </tr> <tr> <td>Height of the sprinkler water tank</td> <td>=</td> <td>3.000 m</td> </tr> <tr> <td>Pressure coefficient (C_p)</td> <td>=</td> <td>1.100</td> </tr> <tr> <td>Effective height (Z_e)</td> <td>=</td> <td>13.650 m</td> </tr> <tr> <td>Design wind reference pressure (Q_{0,z}) = 3.7 x (13.65/500)^{0.16}</td> <td>=</td> <td>2.080 kPa</td> </tr> <tr> <td>Topography factor (S_t)</td> <td>=</td> <td>1.000</td> </tr> <tr> <td>The wind directionality factor (S_θ)</td> <td>=</td> <td>0.850</td> </tr> <tr> <td>Design wind pressure (Q_z) = Q_{0,z} x S_t x S_θ = 2.08 x 1 x 0.85</td> <td>=</td> <td>1.768 kPa</td> </tr> <tr> <td>Size of loaded area (L_{0,sp}) = 7+3</td> <td>=</td> <td>10.000 m</td> </tr> <tr> <td>Size factor (S_s) = exp(0.17-0.07x10^{0.32})</td> <td>=</td> <td>1.024</td> </tr> <tr> <td>Design wind pressure (P) = Q_z x C_p x S_s = 1.768x1.1x1.024</td> <td>=</td> <td>1.991 kPa</td> </tr> </table>		Assume Dead Weight of New Steel Platform with Barrier Railing	=	1.000 kPa	On Steel Platform, D.L. = 8.3m x 5.3m x 1kPa	=	43.990 kN	On Steel Catwalk, D.L. = 3.35m x 0.6m x 1kPa	=	2.010 kN	Self-weight of Water Tank, D.L. = 2 x 2150kg x 9.81ms ⁻² /1000	=	42.183 kN	Self-weight of sprinkler pump room, D.L. = 300kg x 9.81ms ⁻² /1000	=	2.943 kN	Imposed load for roof	=	2.000 kPa	On Steel Platform, L.L. = 8.3m x 5.3m x 2kPa	=	87.980 kN	On Steel Catwalk, L.L. = 3.35m x 0.6m x 2kPa	=	4.020 kN	Case A) For the 110,000Litres (110m ³) water, 110m ³ x9.81N/m ³	=	1079.1 kN	Case B) For the maximum 70% of the 168,000Litres (168m ³) water, = (168x0.7)m ³ x9.81kN/m ³	=	1153.7 kN	Breadth of the sprinkler water tank	=	7.000 m	Height of the sprinkler water tank	=	3.000 m	Pressure coefficient (C _p)	=	1.100	Effective height (Z _e)	=	13.650 m	Design wind reference pressure (Q _{0,z}) = 3.7 x (13.65/500) ^{0.16}	=	2.080 kPa	Topography factor (S _t)	=	1.000	The wind directionality factor (S _θ)	=	0.850	Design wind pressure (Q _z) = Q _{0,z} x S _t x S _θ = 2.08 x 1 x 0.85	=	1.768 kPa	Size of loaded area (L _{0,sp}) = 7+3	=	10.000 m	Size factor (S _s) = exp(0.17-0.07x10 ^{0.32})	=	1.024	Design wind pressure (P) = Q _z x C _p x S _s = 1.768x1.1x1.024	=	1.991 kPa	
Assume Dead Weight of New Steel Platform with Barrier Railing	=	1.000 kPa																																																																
On Steel Platform, D.L. = 8.3m x 5.3m x 1kPa	=	43.990 kN																																																																
On Steel Catwalk, D.L. = 3.35m x 0.6m x 1kPa	=	2.010 kN																																																																
Self-weight of Water Tank, D.L. = 2 x 2150kg x 9.81ms ⁻² /1000	=	42.183 kN																																																																
Self-weight of sprinkler pump room, D.L. = 300kg x 9.81ms ⁻² /1000	=	2.943 kN																																																																
Imposed load for roof	=	2.000 kPa																																																																
On Steel Platform, L.L. = 8.3m x 5.3m x 2kPa	=	87.980 kN																																																																
On Steel Catwalk, L.L. = 3.35m x 0.6m x 2kPa	=	4.020 kN																																																																
Case A) For the 110,000Litres (110m ³) water, 110m ³ x9.81N/m ³	=	1079.1 kN																																																																
Case B) For the maximum 70% of the 168,000Litres (168m ³) water, = (168x0.7)m ³ x9.81kN/m ³	=	1153.7 kN																																																																
Breadth of the sprinkler water tank	=	7.000 m																																																																
Height of the sprinkler water tank	=	3.000 m																																																																
Pressure coefficient (C _p)	=	1.100																																																																
Effective height (Z _e)	=	13.650 m																																																																
Design wind reference pressure (Q _{0,z}) = 3.7 x (13.65/500) ^{0.16}	=	2.080 kPa																																																																
Topography factor (S _t)	=	1.000																																																																
The wind directionality factor (S _θ)	=	0.850																																																																
Design wind pressure (Q _z) = Q _{0,z} x S _t x S _θ = 2.08 x 1 x 0.85	=	1.768 kPa																																																																
Size of loaded area (L _{0,sp}) = 7+3	=	10.000 m																																																																
Size factor (S _s) = exp(0.17-0.07x10 ^{0.32})	=	1.024																																																																
Design wind pressure (P) = Q _z x C _p x S _s = 1.768x1.1x1.024	=	1.991 kPa																																																																
Calc.	Checked	Remarks																																																																



Section	The existing loading		Rev.		Page:															
Subject			Date																	
REF.	CALCULATIONS				OUTPUT															
	<p><u>Loading</u> Dead Load (D.L.), Live Load (L.L.) should be considered are as follows:</p> <p><u>D.L.: Include self-weight of the slab, finishes, service</u></p> <table> <tr> <td>Finishes</td> <td>=</td> <td>0.600 kPa</td> </tr> <tr> <td>Service</td> <td>=</td> <td>0.600 kPa</td> </tr> <tr> <td>Self-weight of the slab</td> <td>=</td> <td>10.000 kPa</td> </tr> </table> <p><u>L.L.: Imposed Load</u></p> <table> <tr> <td>L.L.</td> <td>=</td> <td>5.000 kPa</td> </tr> </table> <p>Total loading = 1.4D.L.+1.6L.L. = 23.68 kPa For considering the wind load x 1.25 = 29.60 kPa</p> <p>There are three storey at the Pier, 4m, 7.3m and 10.65m level, Hence, the loading add to the column should be 3 times of the total load 88.800 kPa</p> <table> <tr> <td>Load Area of Column C19 = 6.2m x 4.85m</td> <td>=</td> <td>30.070 m²</td> </tr> </table> <p>Hence, the loading adding to the column C19 = 2670.216 kN</p>				Finishes	=	0.600 kPa	Service	=	0.600 kPa	Self-weight of the slab	=	10.000 kPa	L.L.	=	5.000 kPa	Load Area of Column C19 = 6.2m x 4.85m	=	30.070 m ²	(Critical)
Finishes	=	0.600 kPa																		
Service	=	0.600 kPa																		
Self-weight of the slab	=	10.000 kPa																		
L.L.	=	5.000 kPa																		
Load Area of Column C19 = 6.2m x 4.85m	=	30.070 m ²																		
Calc.	Checked	Remarks																		



Section	Loading for the Beam B1 (203x203x46kg/m UC) (6200mm(L))	Rev.		Page:
Subject		Date		

REF.	CALCULATIONS			OUTPUT
	Dead Load (D.L.)			
	= 43.99 + 2.01 + 42.183 + 2.943			
	+ 46.1kg/m x 6400/1000 x 9.81ms ⁻² /1000	=	314.520 kN	
	+ 24.5kN/m ³ x 60m ² x 150/1000			
	Live Load (L.L.)			
	= 87.98 + 4.02 + 1079.1 + 2kPa x 60m ² (Case A)	=	1291.1 kN	
	= 87.98 + 4.02 + 1153.7 + 2kPa x 60m ² (Case B)	=	1365.7 kN	
	Wind Load (W.L.)			
	= 1.991kPa x 7m x 3m	=	41.815 kN	
	Total Load			
	= (314.52 + 1291.1 + 41.815)/6.2 (Case A)	=	265.715 kN/m	
	= (314.52 + 1365.7 + 41.815)/6.2 (Case B)	=	277.748 kN/m	
	Shear			
	= (314.52 + 1291.1 + 41.815)/2 (Case A)	=	823.718 kN	
	= (314.52 + 1365.7 + 41.815)/2 (Case B)	=	861.018 kN	
	Moment			
	Support moment	=	0.000 kNm	
	Mid-span momen = 265.715 x 6.2 x 6.2/8 (Case A)	=	1276.762 kNm	
	Mid-span momen = 277.748 x 6.2 x 6.2/8 (Case B)	=	1334.577 kNm	

Calc.



Section	Loading for the Beam B1 (203x203x46kg/m UC) (6200mm(L))	Rev.		Page:
Subject		Date		

REF.	CALCULATIONS	OUTPUT								
	<p><u>Load Area of Steel Beams and Columns</u></p> <p>Load Area of Steel Beam B1 = 21.235 m²</p> <p>Load Area of Column C19 = 30.070 m²</p> <p>The Loading of Existing Columns are as follows:</p> <table border="1"> <thead> <tr> <th></th> <th>D.L.</th> <th>L.L.</th> <th>D.L.+L.L.</th> </tr> </thead> <tbody> <tr> <td>C19)</td> <td>5000kN</td> <td>1520kN</td> <td>6520kN</td> </tr> </tbody> </table> <p><u>Original Design Data</u></p> <p>Concrete Grade = 40 MPa</p> <p>Concrete Cover of column = 40 mm</p> <p>Load Path of New Steel Platform (D.L. +L.L. +W.L.) -->Steel Platform -->New Steel Beams (B1)-->Existing R.C. Columns (B19, B20, C17, C19, C20, D17, D19 and D20) --> Existing Foundation</p>		D.L.	L.L.	D.L.+L.L.	C19)	5000kN	1520kN	6520kN	(Critical)
	D.L.	L.L.	D.L.+L.L.							
C19)	5000kN	1520kN	6520kN							

Calc.	Checked	Remarks
-------	---------	---------




Section	Existing column	Rev.		Page:
Subject		Date		

REF.	CALCULATIONS	OUTPUT
	<u>For checking the Column C19</u>	
	Area of Column C19 = 0.19635 m ²	
	Self-weight of the C19 = 24.5kN/m ³ x (0.19635m ² x 6.65m) = 31.990 kN	
	The loading of the beam B1 (New) = 277.748kN/m x 6.2m = 1722.038 kN	
	The loading adding to the Column C19 = 2670.216 kN	
	Total load on the Column C19 = 2670.216 + 1722.038 + 31.99 = 4424.244 kN	
	< 6520 kN	O.K.

Calc.	Checked	Remarks
-------	---------	---------

Appendix B
Drawings

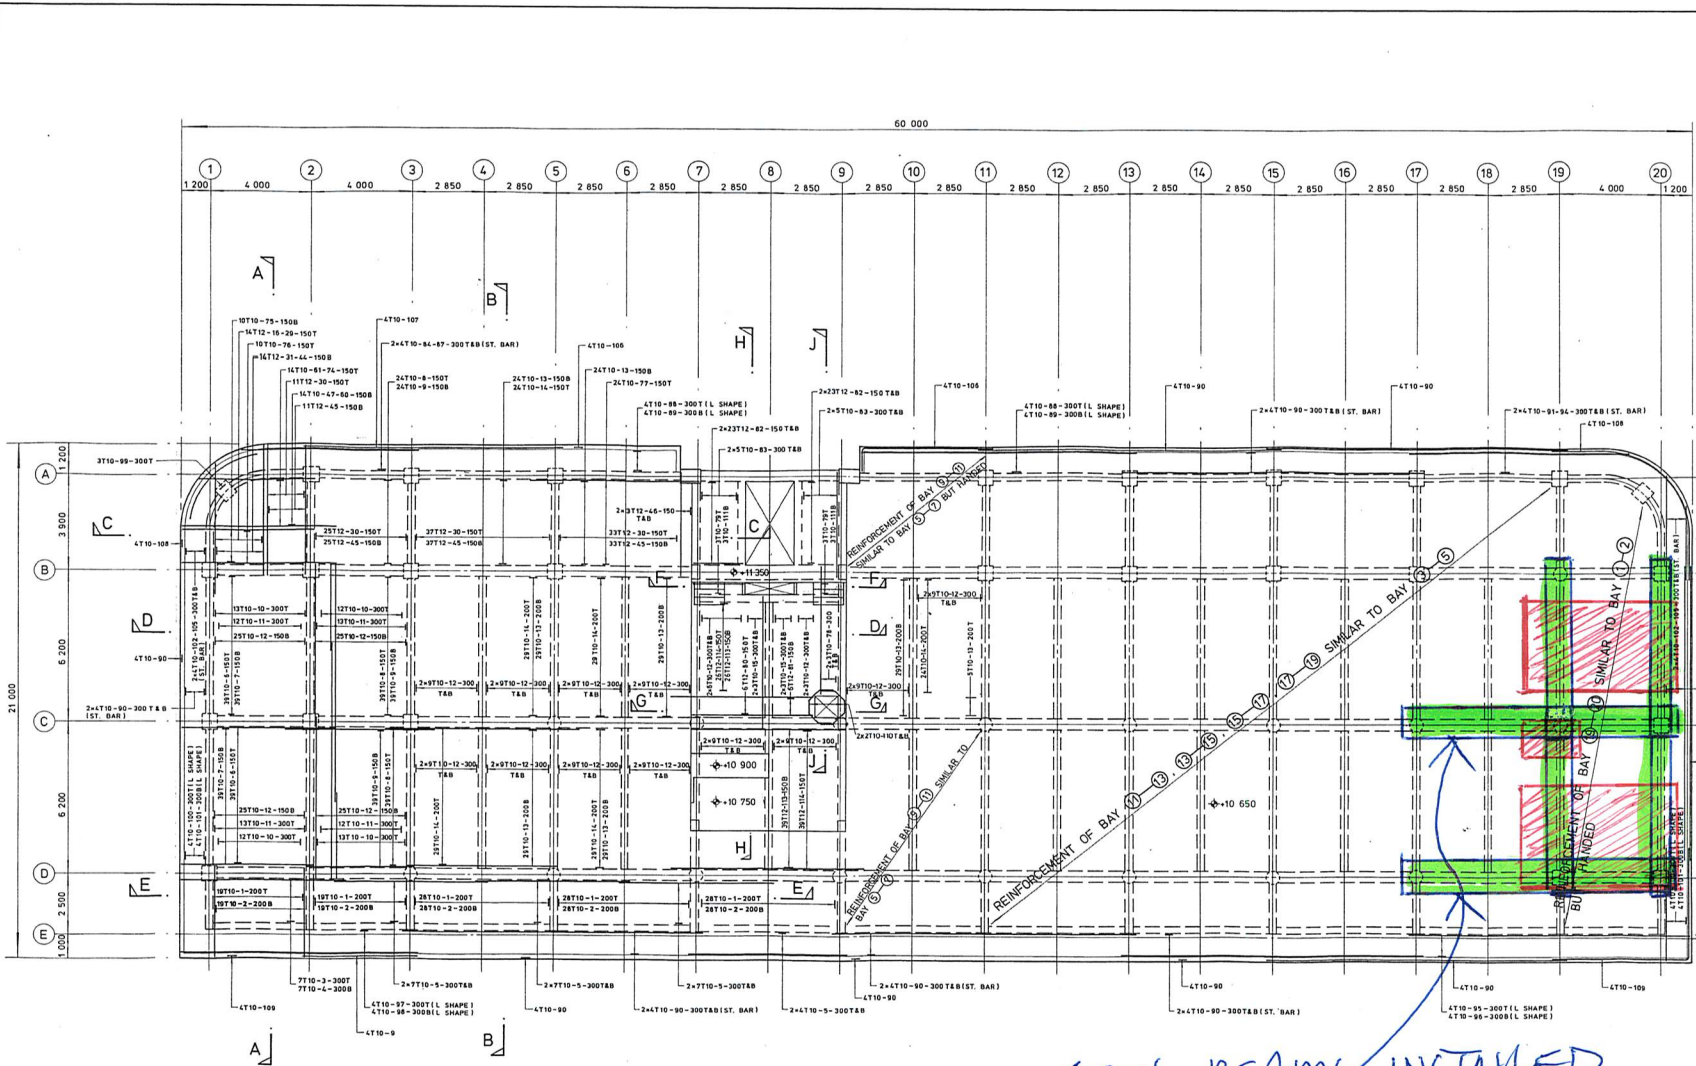

ROOF SLAB
(THICKNESS OF SLAB = 150)

STEEL BEAMS INSTALLED
ON TOP OF ROOF COLUMN
HEADS TO SUPPORT THE
ADDITIONAL WATER TANKS

- NOTES:
1. ALL DIMENSIONS IN MILLIMETRES.
 2. ALL LEVELS REFER TO CHART DATUM (C.D.) AND IN MILLIMETRES.
 3. CONCRETE TO STRUCTURES TO BE OF GRADE 40 / 20
 4. ALL REINFORCEMENT TO COMPLY WITH B.S. 4449.
 5. CONCRETE COVER TO REINFORCEMENT TO BE 40mm UNLESS OTHERWISE SPECIFIED.
 6. MINIMUM LAP LENGTH FOR REINFORCEMENT OF HIGH YIELD TYPE 2 DEFORMED BARS TO BE 25 TIMES THE DIAMETER OF THE SMALLER LAPPED BAR UNLESS OTHERWISE SPECIFIED.
 7. MINIMUM ANCHORAGE LENGTH FOR REINFORCEMENT OF HIGH YIELD TYPE 2 DEFORMED BARS TO BE 32 TIMES THE DIAMETER OF BAR UNLESS OTHERWISE SPECIFIED.
 8. ALL EXTERNAL CONCRETE ARRISSES TO BE 25x25mm CHAMFERED UNLESS OTHERWISE SPECIFIED.


AS CONSTRUCTED	
PREPARED:	T. N. TSUI
CERTIFIED:	M. C. LEE
(ENGINEER)	
no. date	description
REVISION	
designed	T. K. CHEUNG
drawn	Y. M. LEUNG
checked	W. TSUI
approved	
contract no.	CV/87/08
file no.	P. W. O. CV/87/08
project no.	228 CL

HUNG HOM BAY
RECLAMATION PHASE II
CONSTRUCTION OF
FERRY PIERS AND
SEAWALL STAGE I


drawing title
PIER B —
R. C. DETAILS OF
MAIN ROOF SLAB
(SHEET 1 OF 5)

drawing no.
P 16093A


office
PORT WORKS DIVISION
CIVIL ENGINEERING OFFICE

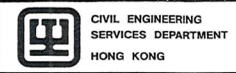


Appendix C
Record Plan

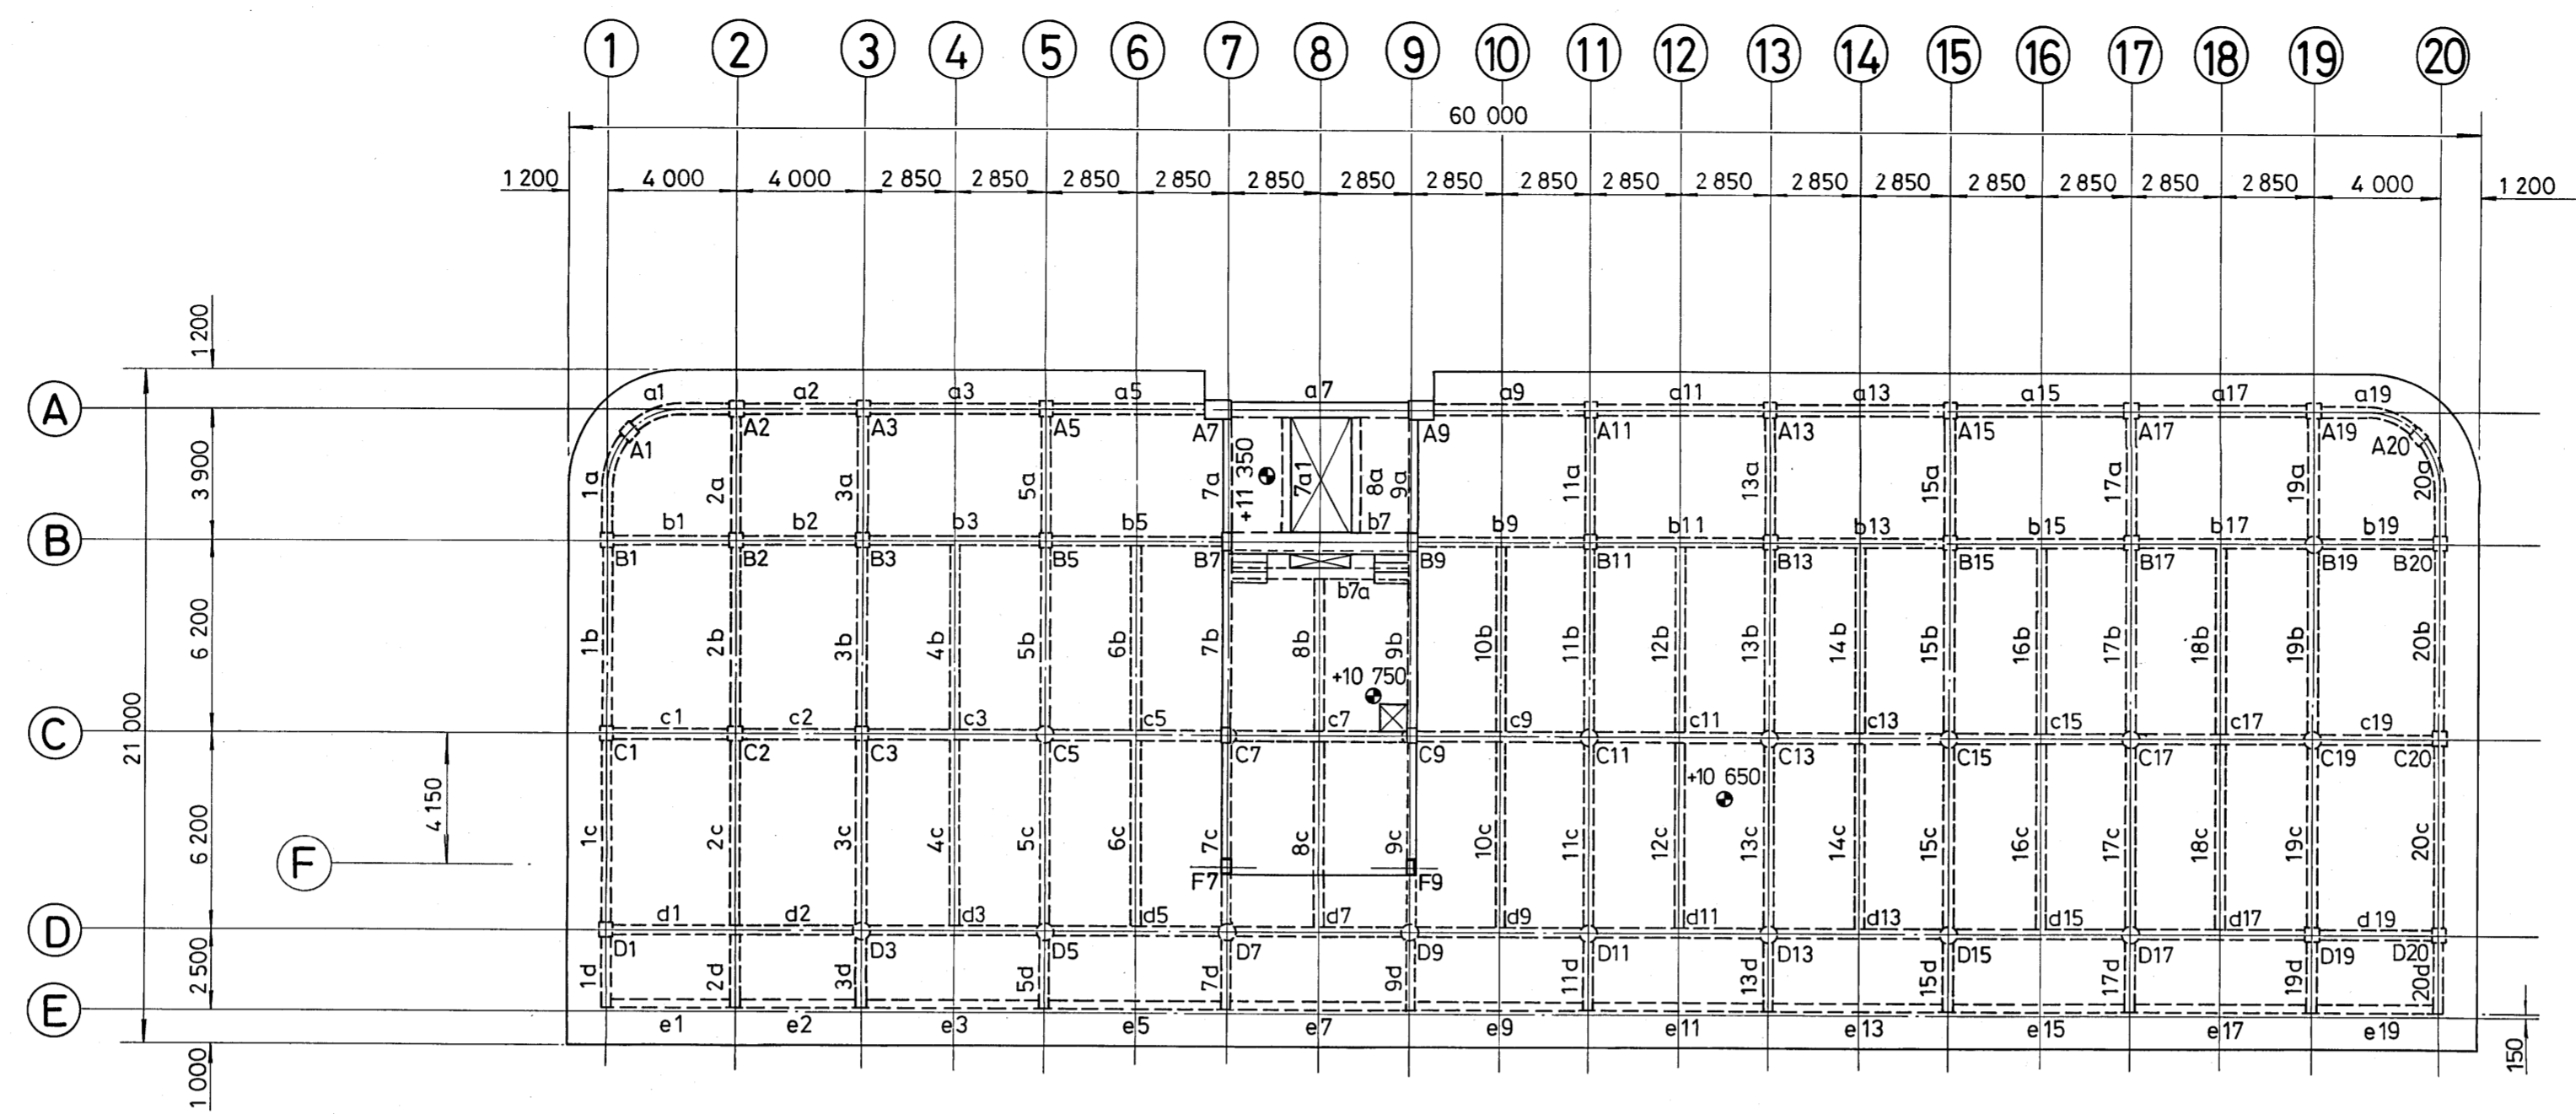


ROOF PLAN

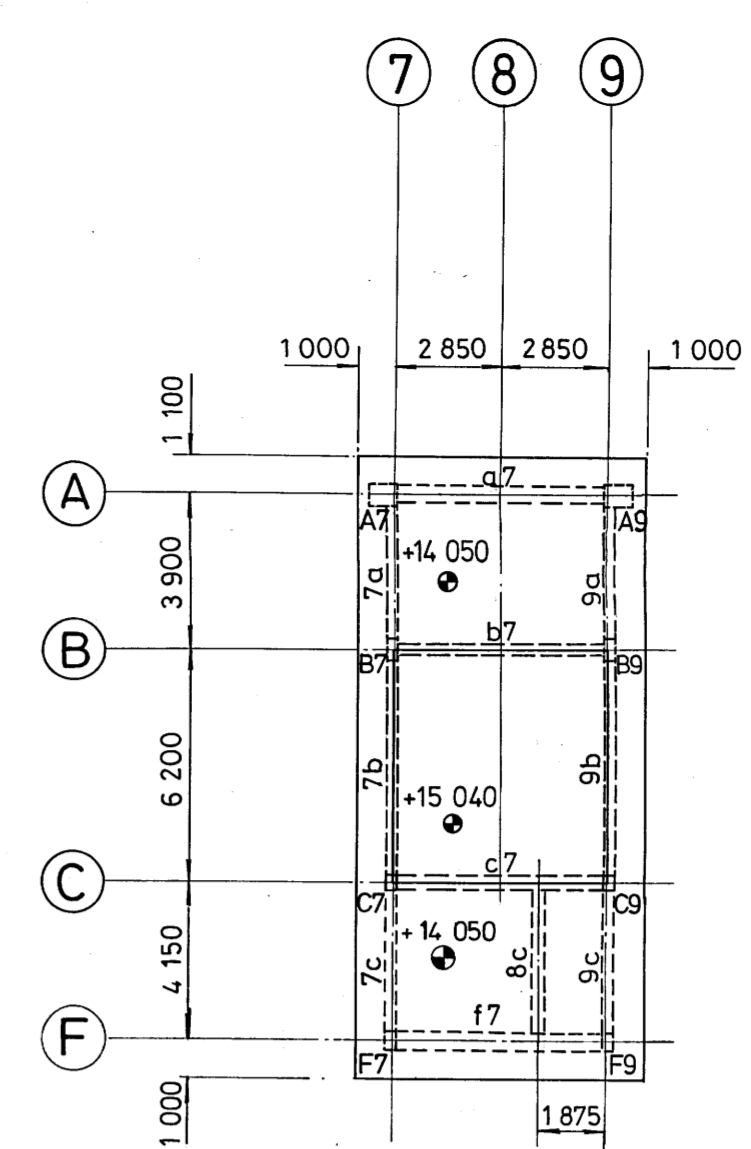


UPPER ROOF PLAN

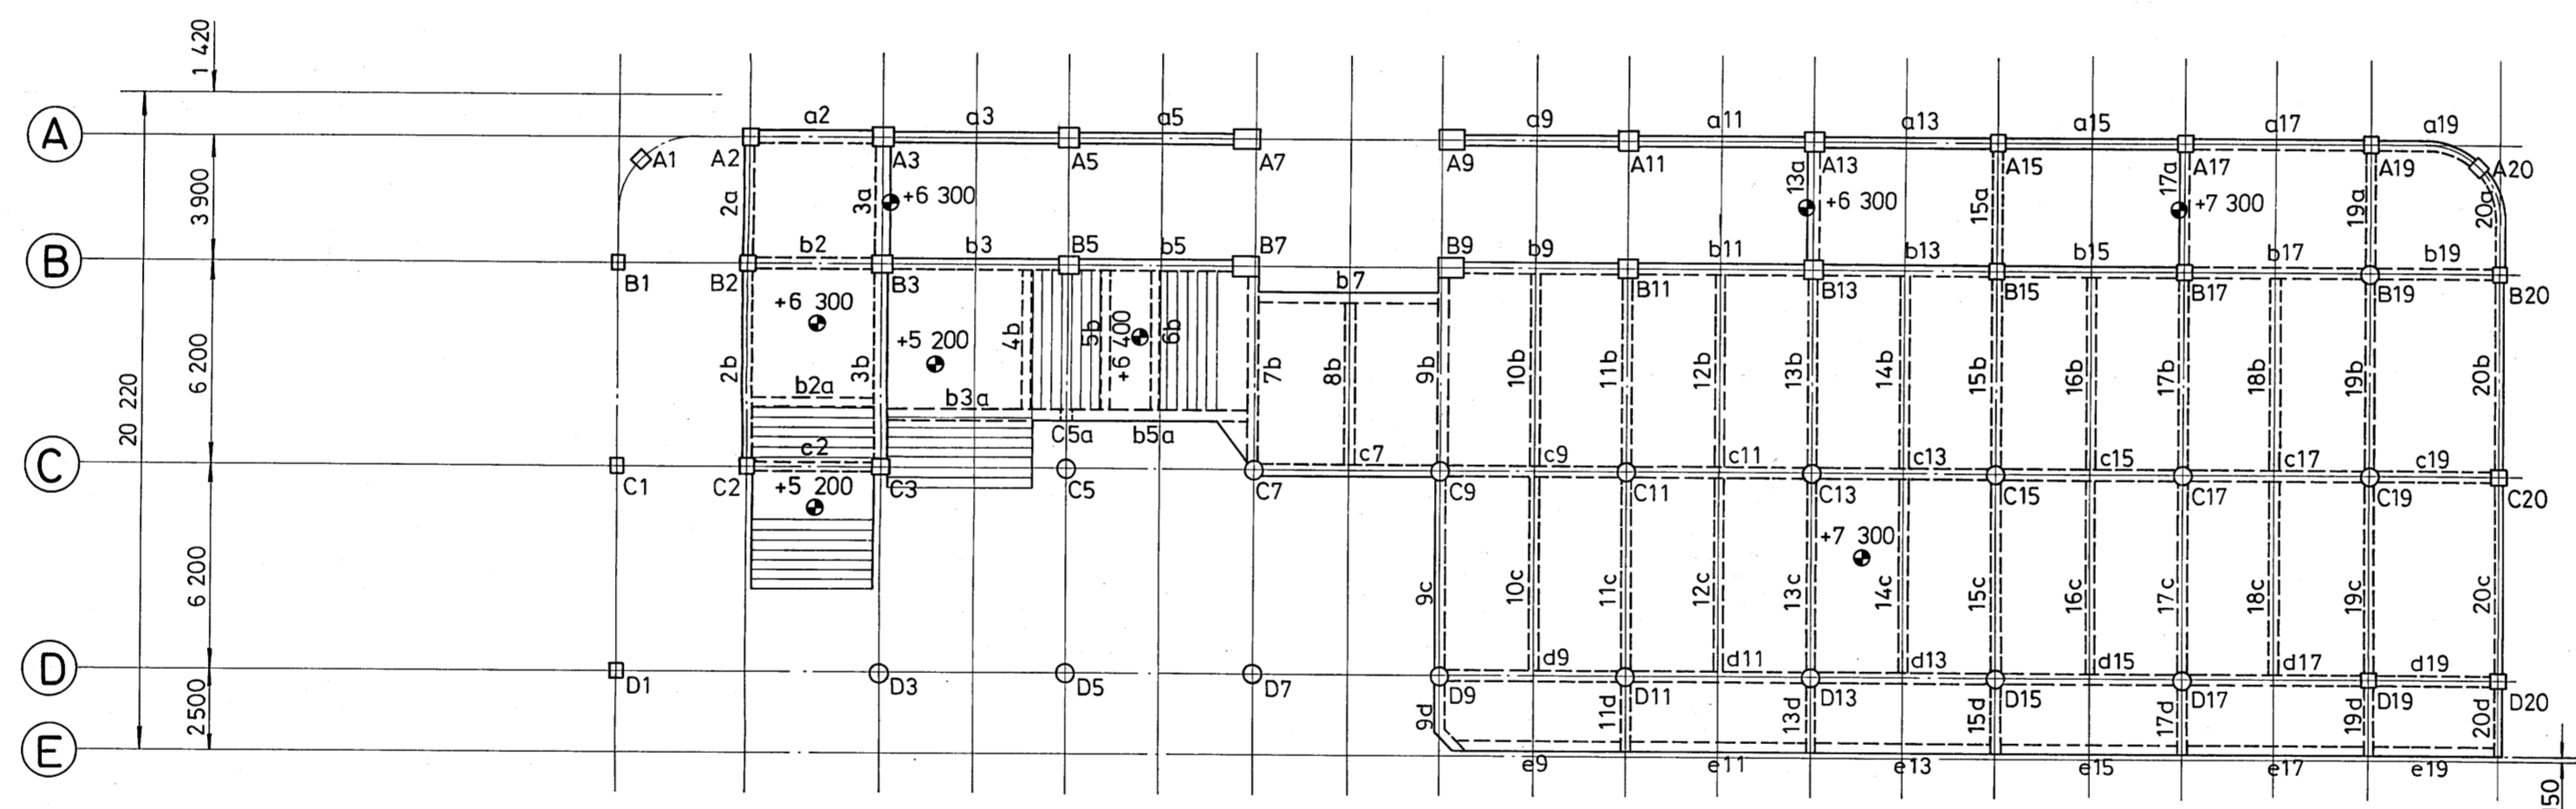


UPPER DECK PLAN

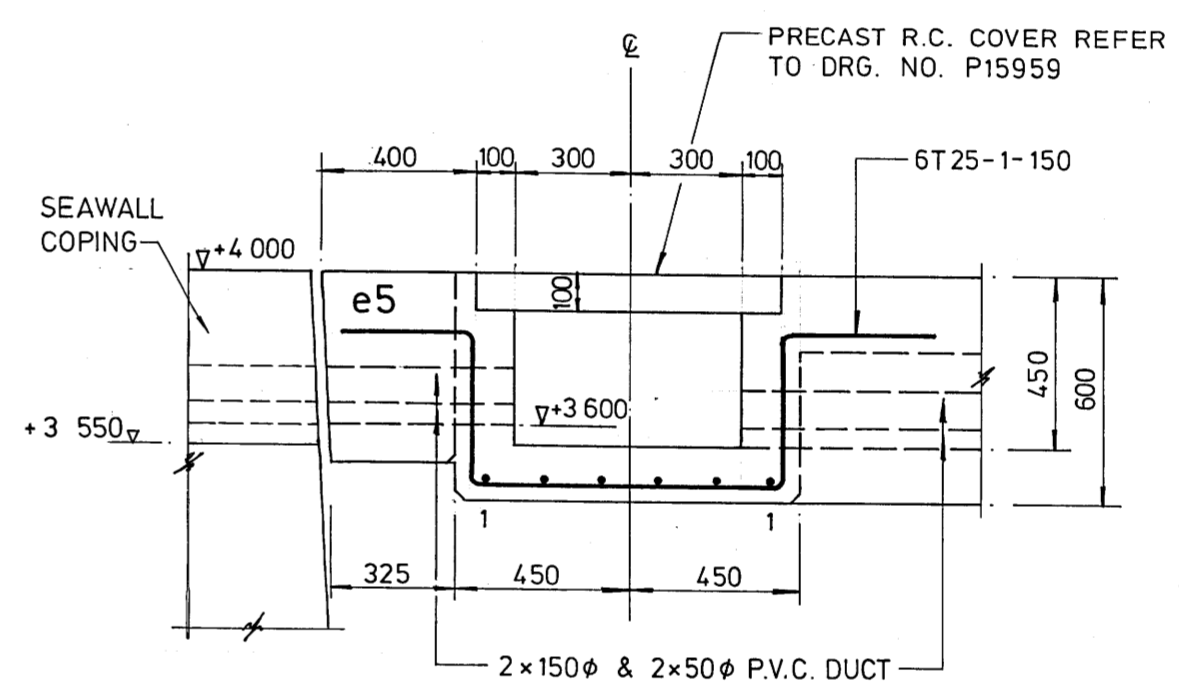

SECTION A-A
SCALE: 1 : 20

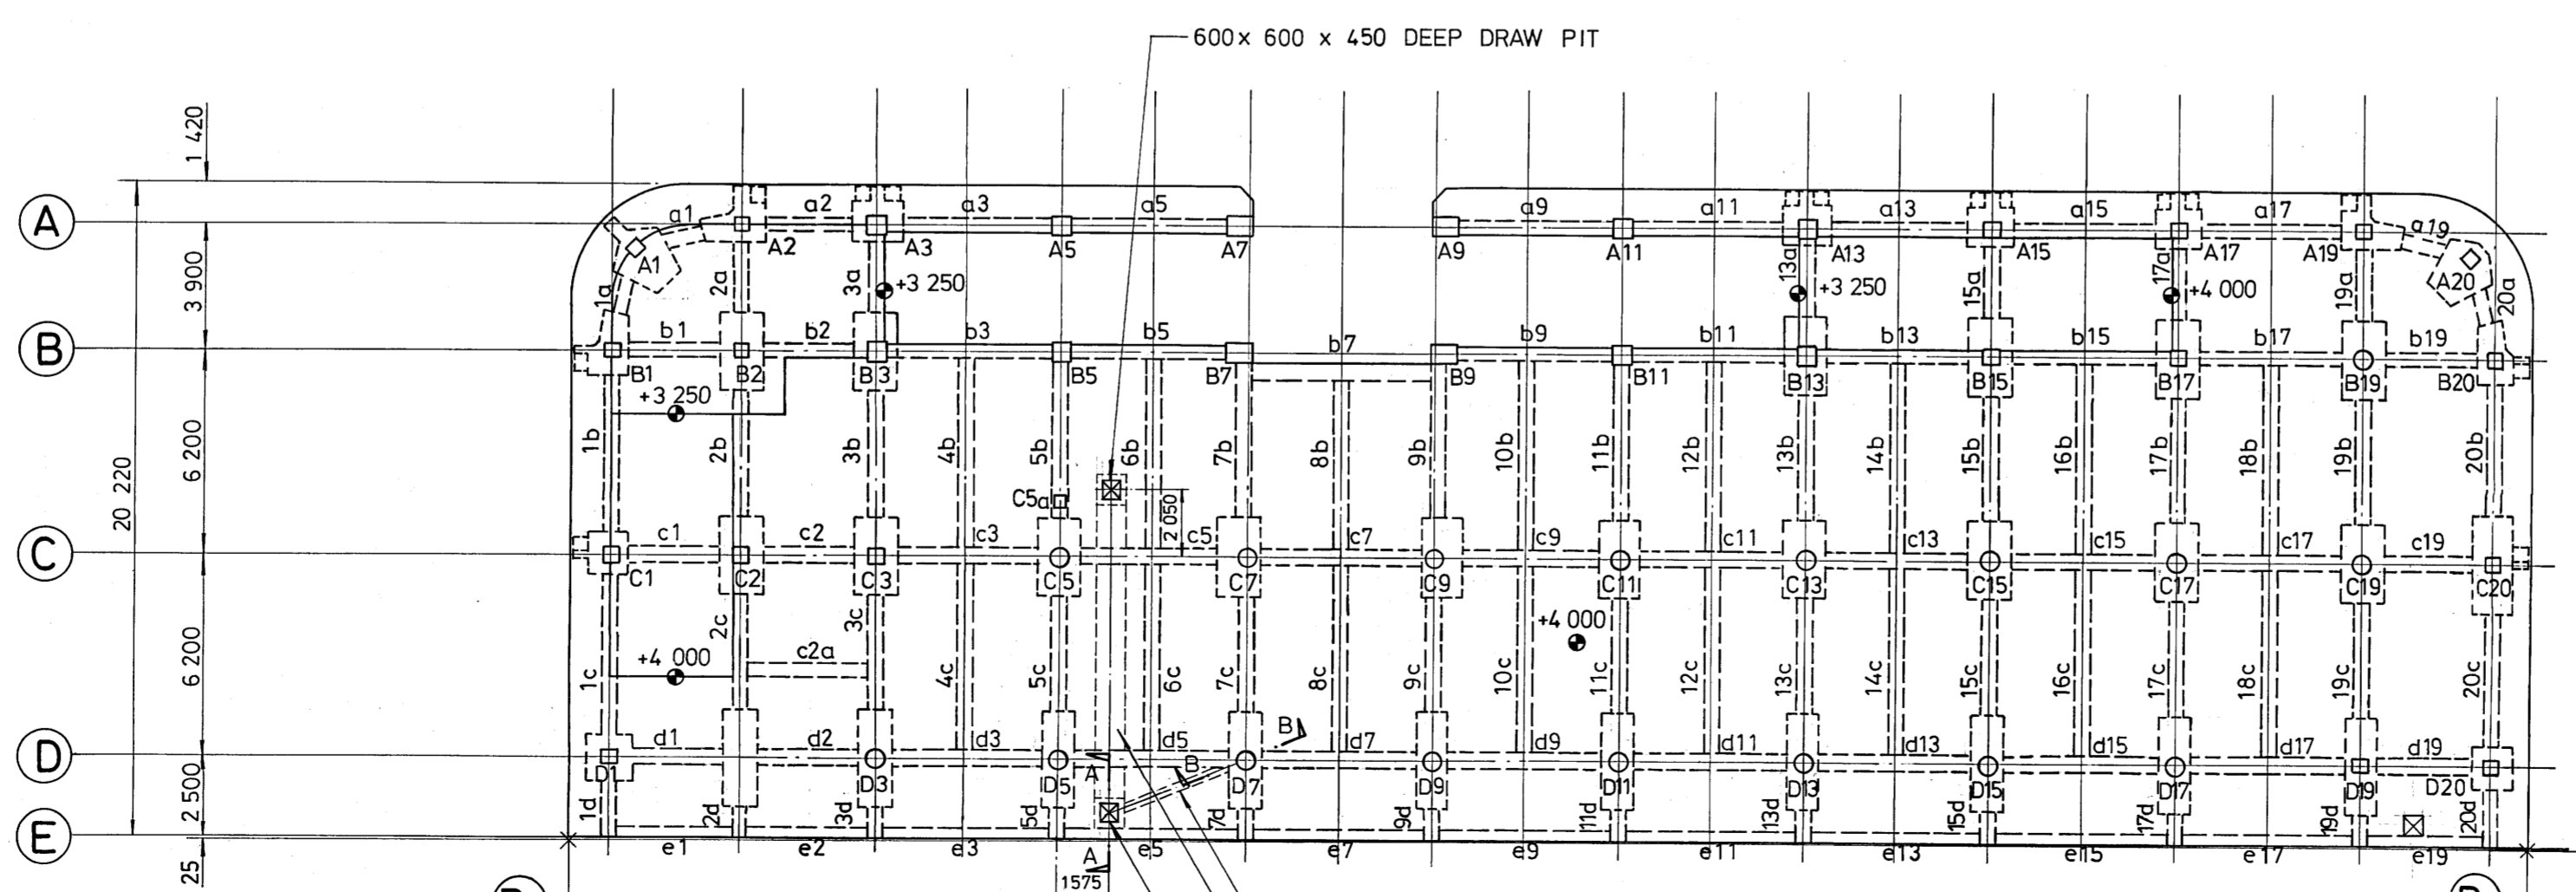

MAIN DECK PLAN

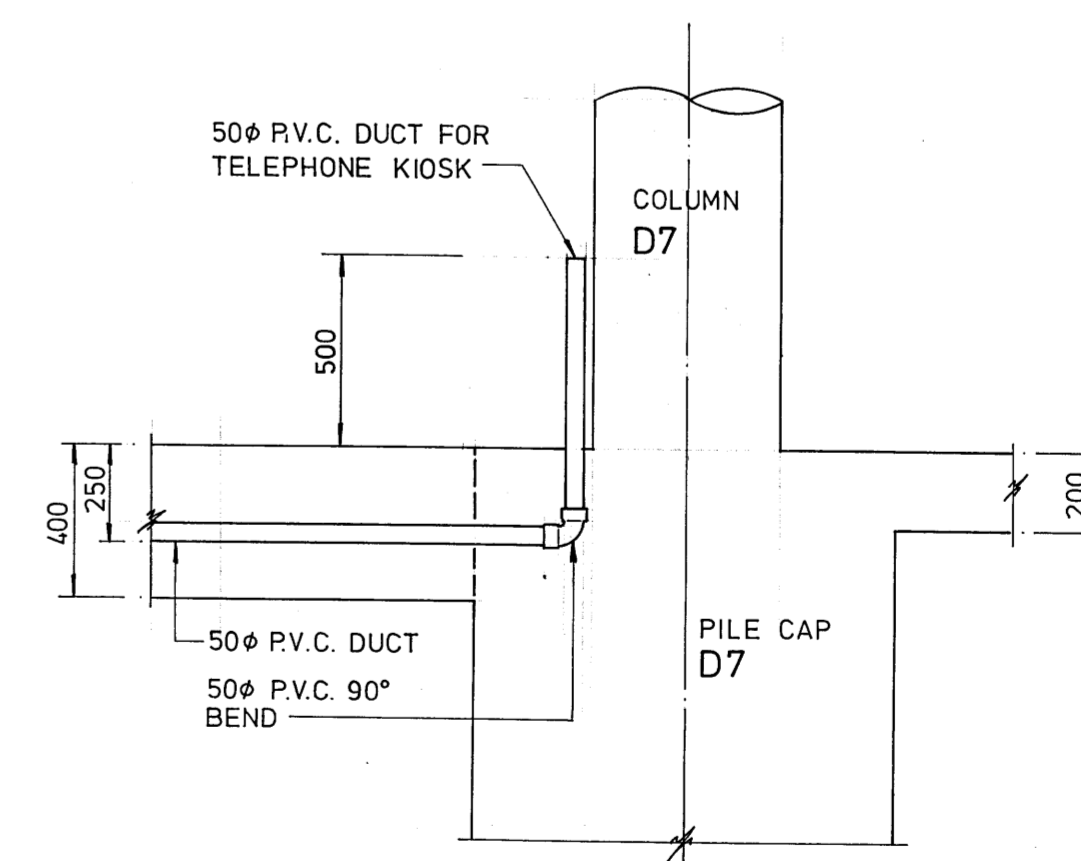

SECTION B-B
SCALE: 1 : 20

- NOTES:
1. ALL DIMENSIONS IN MILLIMETRES.
 2. ALL LEVELS TO BE STRUCTURAL LEVEL REFER TO CHART DATUM (C.D.) AND IN MILLIMETRES.
 3. FOR R.C. DETAILS OF DUMMY BEAMS REFER TO DRAWING NOS. P15917B AND P15959A

AS CONSTRUCTED			
B	4/93	PREPARED: (I.O.W.) T. N. TSUI	<i>[Signature]</i>
		CERTIFIED: (ENGINEER) M. C. LEE	<i>[Signature]</i>
A	7-9-89	DUMMY BEAM WIDENED AND DRAW PIT SIZE INCREASED, SECTIONS A-A AND B-B ADDED	<i>[Signature]</i>
no.	date	description	initial
REVISION			
		name	date
surveyed			
designed		T. K. CHEUNG <i>[Signature]</i>	17-9-87
drawn		C. Y. LAI <i>[Signature]</i>	23-9-87
traced		C. Y. LAI <i>[Signature]</i>	28-9-87
checked		W. TSUI <i>[Signature]</i>	6-1-88
approved		<i>[Signature]</i>	13-1-88


contract no. CV / 87 / 08
 file no. P.W.O. CV / 87 / 08
 project no. 228 CL
 contract
 HUNG HOM BAY RECLAMATION PHASE II CONSTRUCTION OF FERRY PIERS AND SEAWALL STAGE I

drawing title
 PIER B - FRAMING PLANS

drawing no. P16040B
 scale 1 : 200 OR AS SHOWN

office
 PORT WORKS DIVISION
 CIVIL ENGINEERING OFFICE



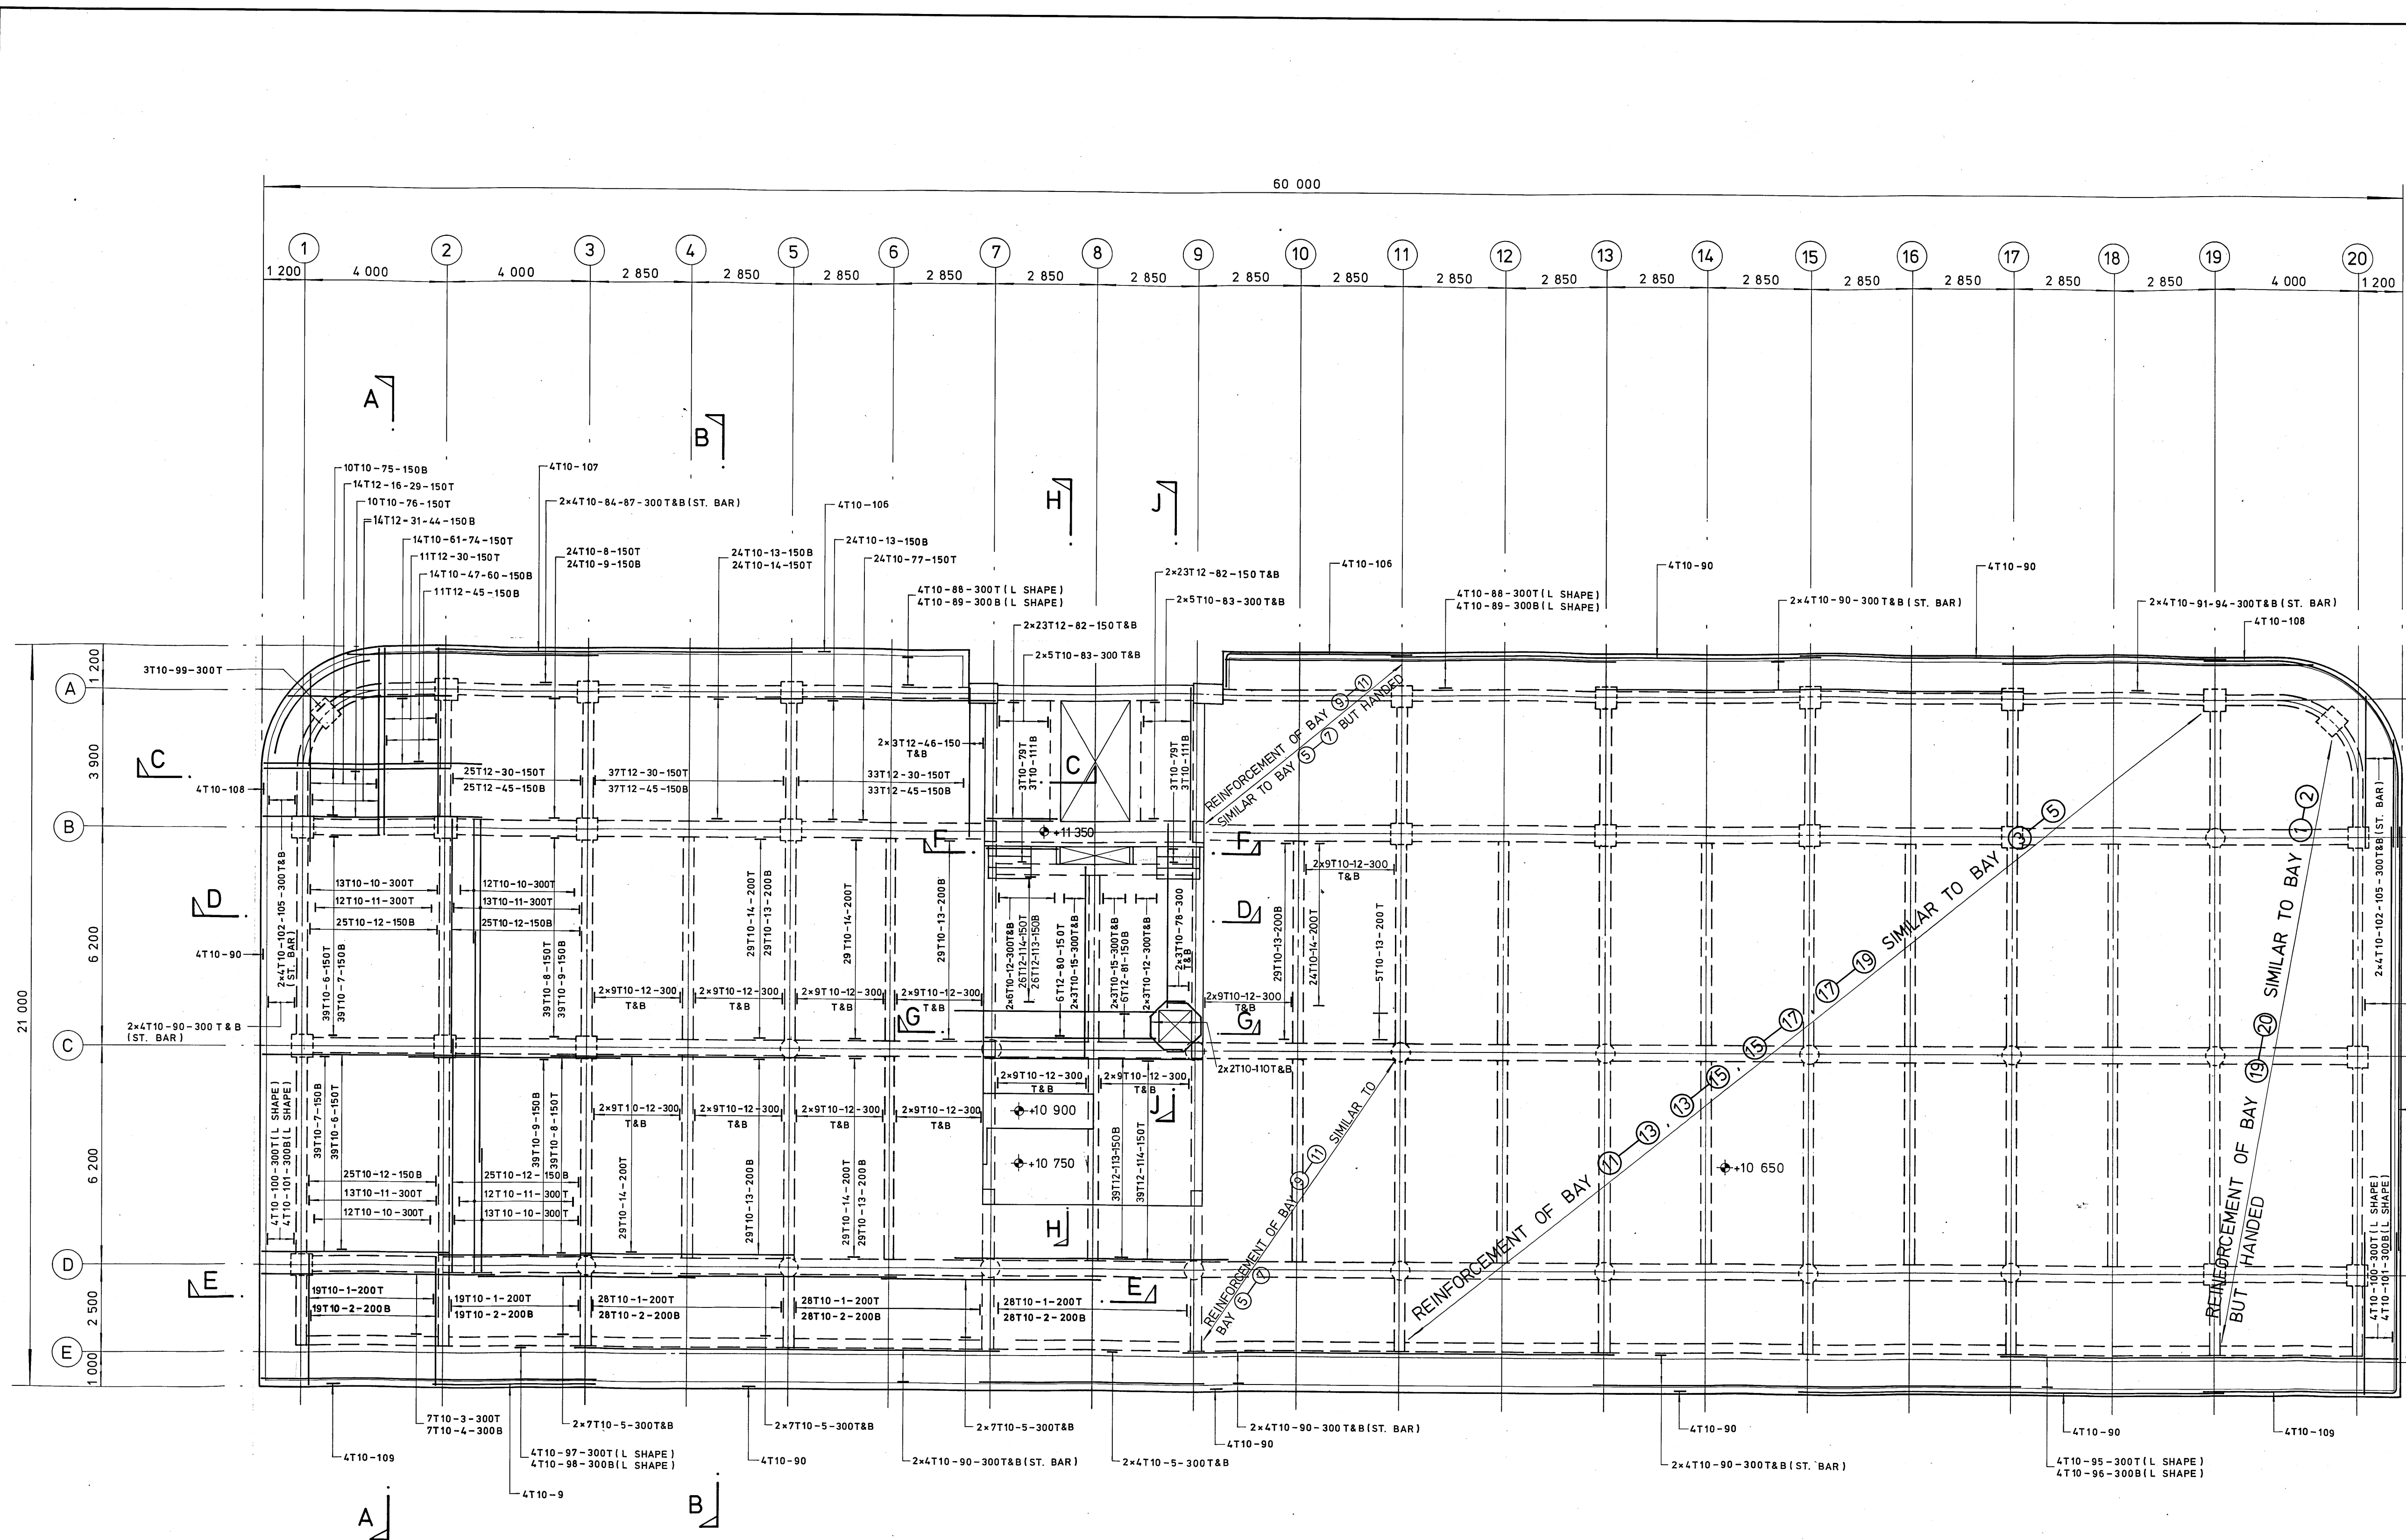

ROOF SLAB
(THICKNESS OF SLAB = 150)

- NOTES:**
1. ALL DIMENSIONS IN MILLIMETRES.
 2. ALL LEVELS REFER TO CHART DATUM (C.D.) AND IN MILLIMETRES.
 3. CONCRETE TO STRUCTURES TO BE OF GRADE 40/20
 4. ALL REINFORCEMENT TO COMPLY WITH B.S. 4449.
 5. CONCRETE COVER TO REINFORCEMENT TO BE 40mm UNLESS OTHERWISE SPECIFIED.
 6. MINIMUM LAP LENGTH FOR REINFORCEMENT OF HIGH YIELD TYPE 2 DEFORMED BARS TO BE 45 TIMES THE DIAMETER OF THE SMALLER LAPPED BAR UNLESS OTHERWISE SPECIFIED.
 7. MINIMUM ANCHORAGE LENGTH FOR REINFORCEMENT OF HIGH YIELD TYPE 2 DEFORMED BARS TO BE 32 TIMES THE DIAMETER OF BAR UNLESS OTHERWISE SPECIFIED.
 8. ALL EXTERNAL CONCRETE ARRISSES TO BE 25x25mm CHAMFERED UNLESS OTHERWISE SPECIFIED.

AS CONSTRUCTED			
PREPARED: (I.O.W.)	T. N. TSUI		
CERTIFIED: (ENGINEER)	M. C. LEE		
no.	date	description	initial
REVISION			
		name	date
surveyed			
designed	T. K. CHEUNG	<i>TKC</i>	17-9-87
drawn	Y. M. LEUNG	<i>YML</i>	3-11-87
traced	Y. M. LEUNG	<i>YML</i>	3-11-87
checked	W. TSUI	<i>WTS</i>	6-1-88
approved		<i>W. Tsui</i>	14-1-88
contract no.	CV/87/08		
file no.	P. W. O. CV/87/08		
project no.	228CL		


contract
HUNG HOM BAY
RECLAMATION PHASE II
CONSTRUCTION OF
FERRY PIERS AND
SEAWALL STAGE I

drawing title
PIER B —
R. C. DETAILS OF
MAIN ROOF SLAB
(SHEET 1 OF 5)

drawing no. P 16093A **scale** 1:100

office
PORT WORKS DIVISION
CIVIL ENGINEERING OFFICE



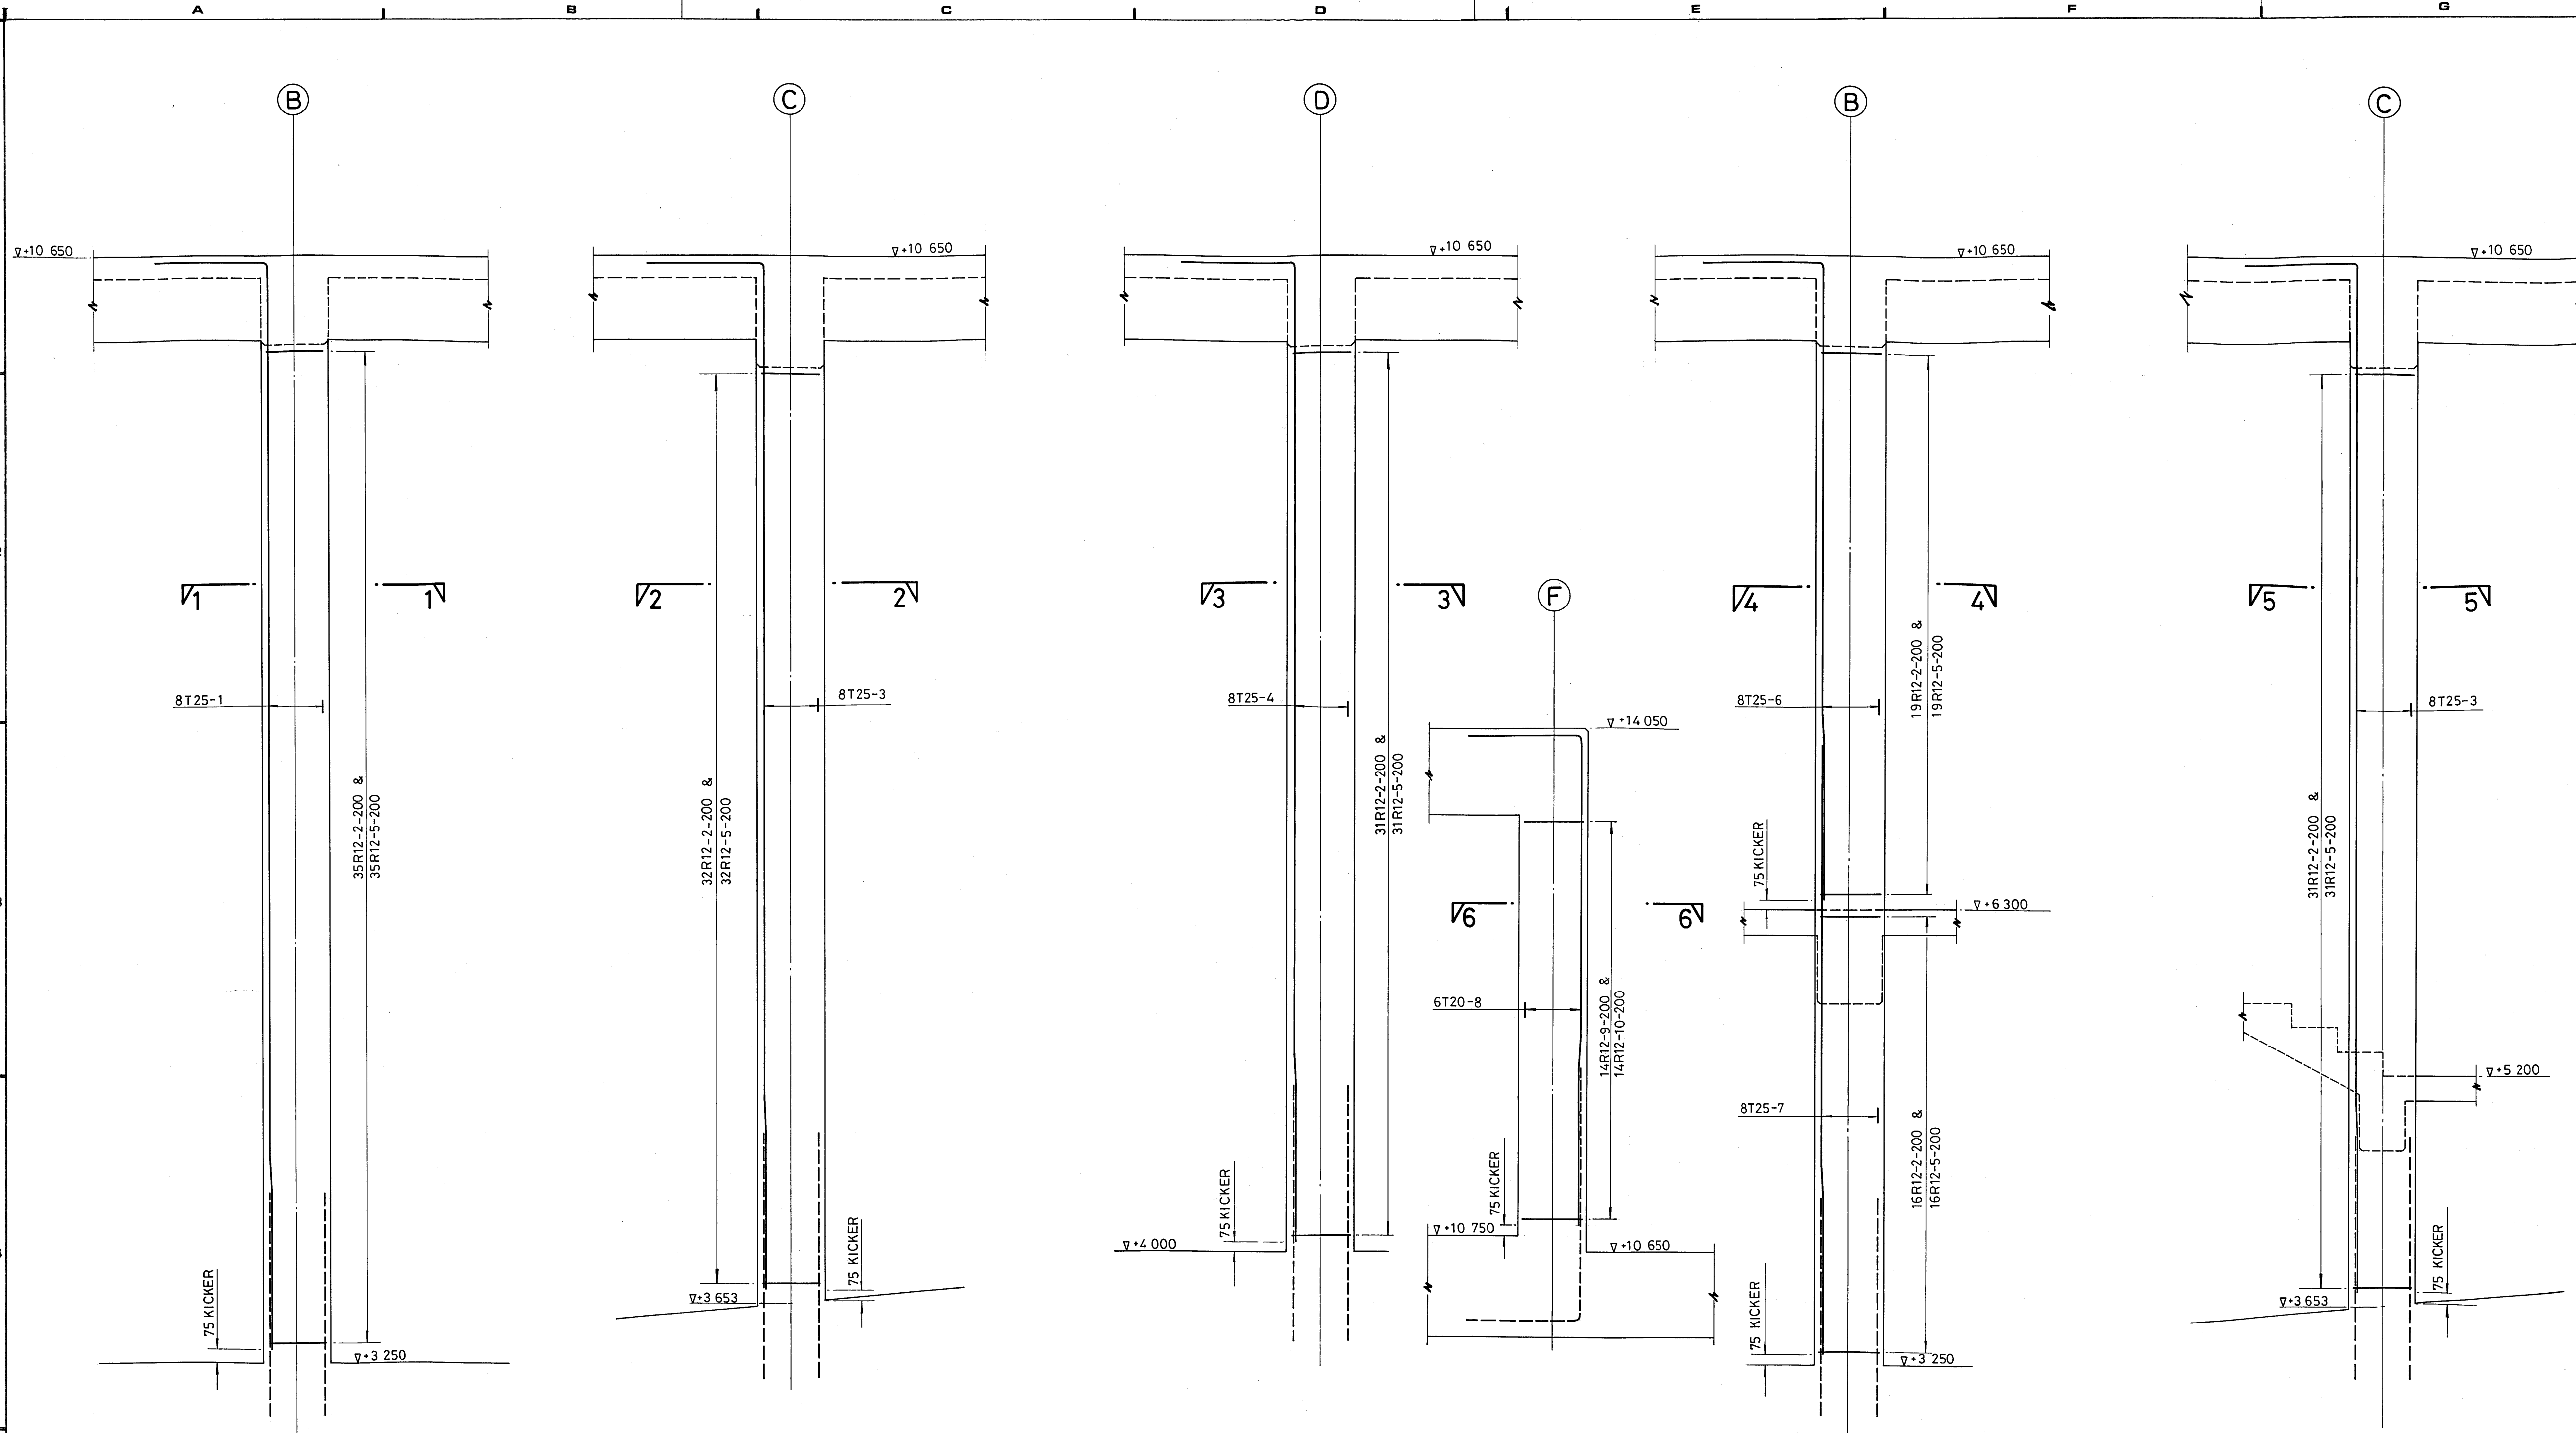

B1 (A1 SIMILAR)


C1

D1


F7 (F9 SIMILAR BUT HANDED)

B2 (A2 SIMILAR)


C2

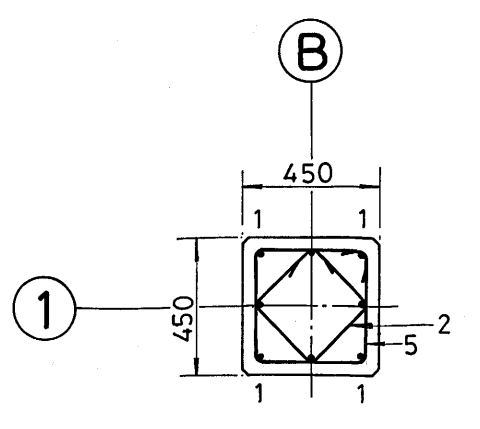


SECTION 1-1

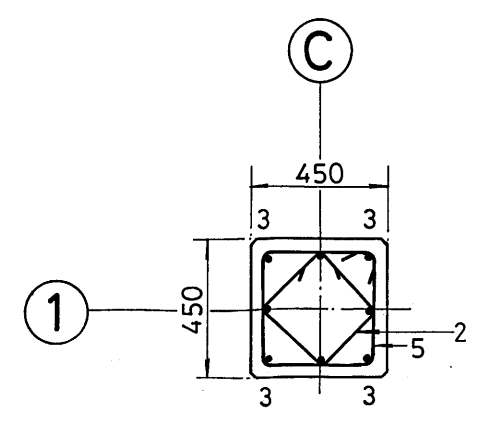


SECTION 2-2

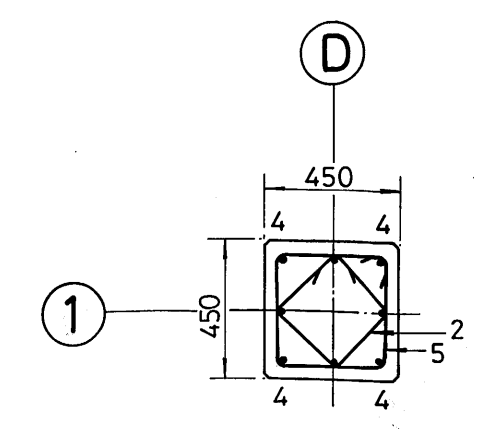


SECTION 3-3

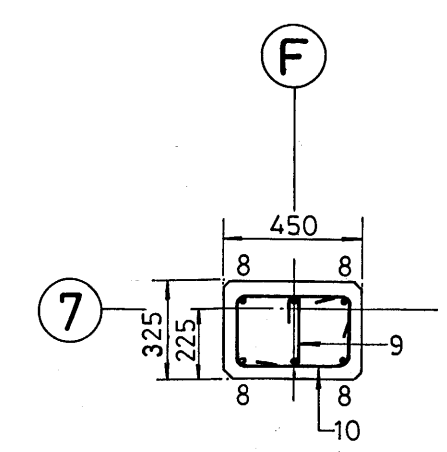

SECTION 6-6

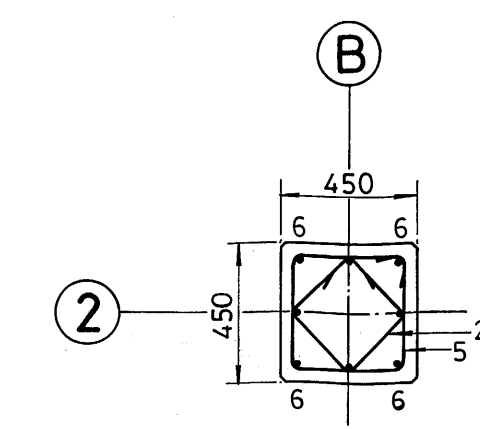

SECTION 4-4

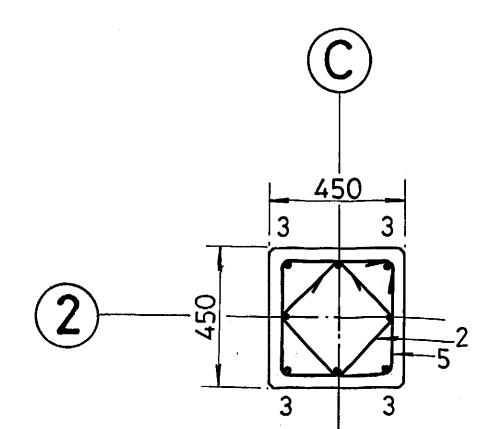

SECTION 5-5

- NOTES:**
1. ALL DIMENSIONS IN MILLIMETRES.
 2. ALL LEVELS REFER TO CHART DATUM (C.D.) AND IN MILLIMETRES.
 3. CONCRETE TO STRUCTURES TO BE OF GRADE 40/20.
 4. ALL REINFORCEMENT TO COMPLY WITH B.S. 4449.
 5. CONCRETE COVER TO REINFORCEMENT TO BE 40mm.
 6. MINIMUM LAP LENGTH FOR REINFORCEMENT OF HIGH YIELD TYPE 2 DEFORMED BARS TO BE 45 TIMES THE DIAMETER OF THE SMALLER LAPPED BAR UNLESS OTHERWISE SPECIFIED.
 7. MINIMUM ANCHORAGE LENGTH FOR REINFORCEMENT OF HIGH YIELD TYPE 2 DEFORMED BARS TO BE 32 TIMES THE DIAMETER OF BAR UNLESS OTHERWISE SPECIFIED.
 8. ALL EXTERNAL CONCRETE ARRISSES TO BE 25 x 25 mm CHAMFERED UNLESS OTHERWISE SPECIFIED.

AS CONSTRUCTED

A	493	PREPARED: (I.O.W.)	T. N. TSUI	<i>[Signature]</i>
		CERTIFIED: (ENGINEER)	M. C. LEE	<i>[Signature]</i>
no.	date	description	initial	
REVISION				
		name		date
designed		T. K. CHEUNG	<i>TKC</i>	17-9-87
drawn		C. Y. LAI	<i>Lai</i>	12-10-87
traced		C. Y. LAI	<i>Lai</i>	14-10-87
checked		W. TSUI	<i>WTS</i>	6-1-88
approved		<i>[Signature]</i>		13-1-88

contract no. CV / 87 / 08
 file no. P.W.O. CV / 87 / 08
 project no. 228 CL

contract
 HUNG HOM BAY
 RECLAMATION PHASE II
 CONSTRUCTION OF
 FERRY PIERS AND
 SEAWALL STAGE I

drawing title
 PIER B —
 R. C. DETAILS OF
 COLUMNS
 (SHEET 1 OF 4)


drawing no. P16099A
 scale 1 : 25

office
 PORT WORKS DIVISION
 CIVIL ENGINEERING OFFICE




CIVIL ENGINEERING
 SERVICES DEPARTMENT
 HONG KONG


- NOTES:**
1. ALL DIMENSIONS IN MILLIMETRES.
 2. ALL LEVELS REFER TO CHART DATUM (C.D.) AND IN MILLIMETRES.
 3. FOR GENERAL NOTES REFER TO DRAWING NO. P16099A.

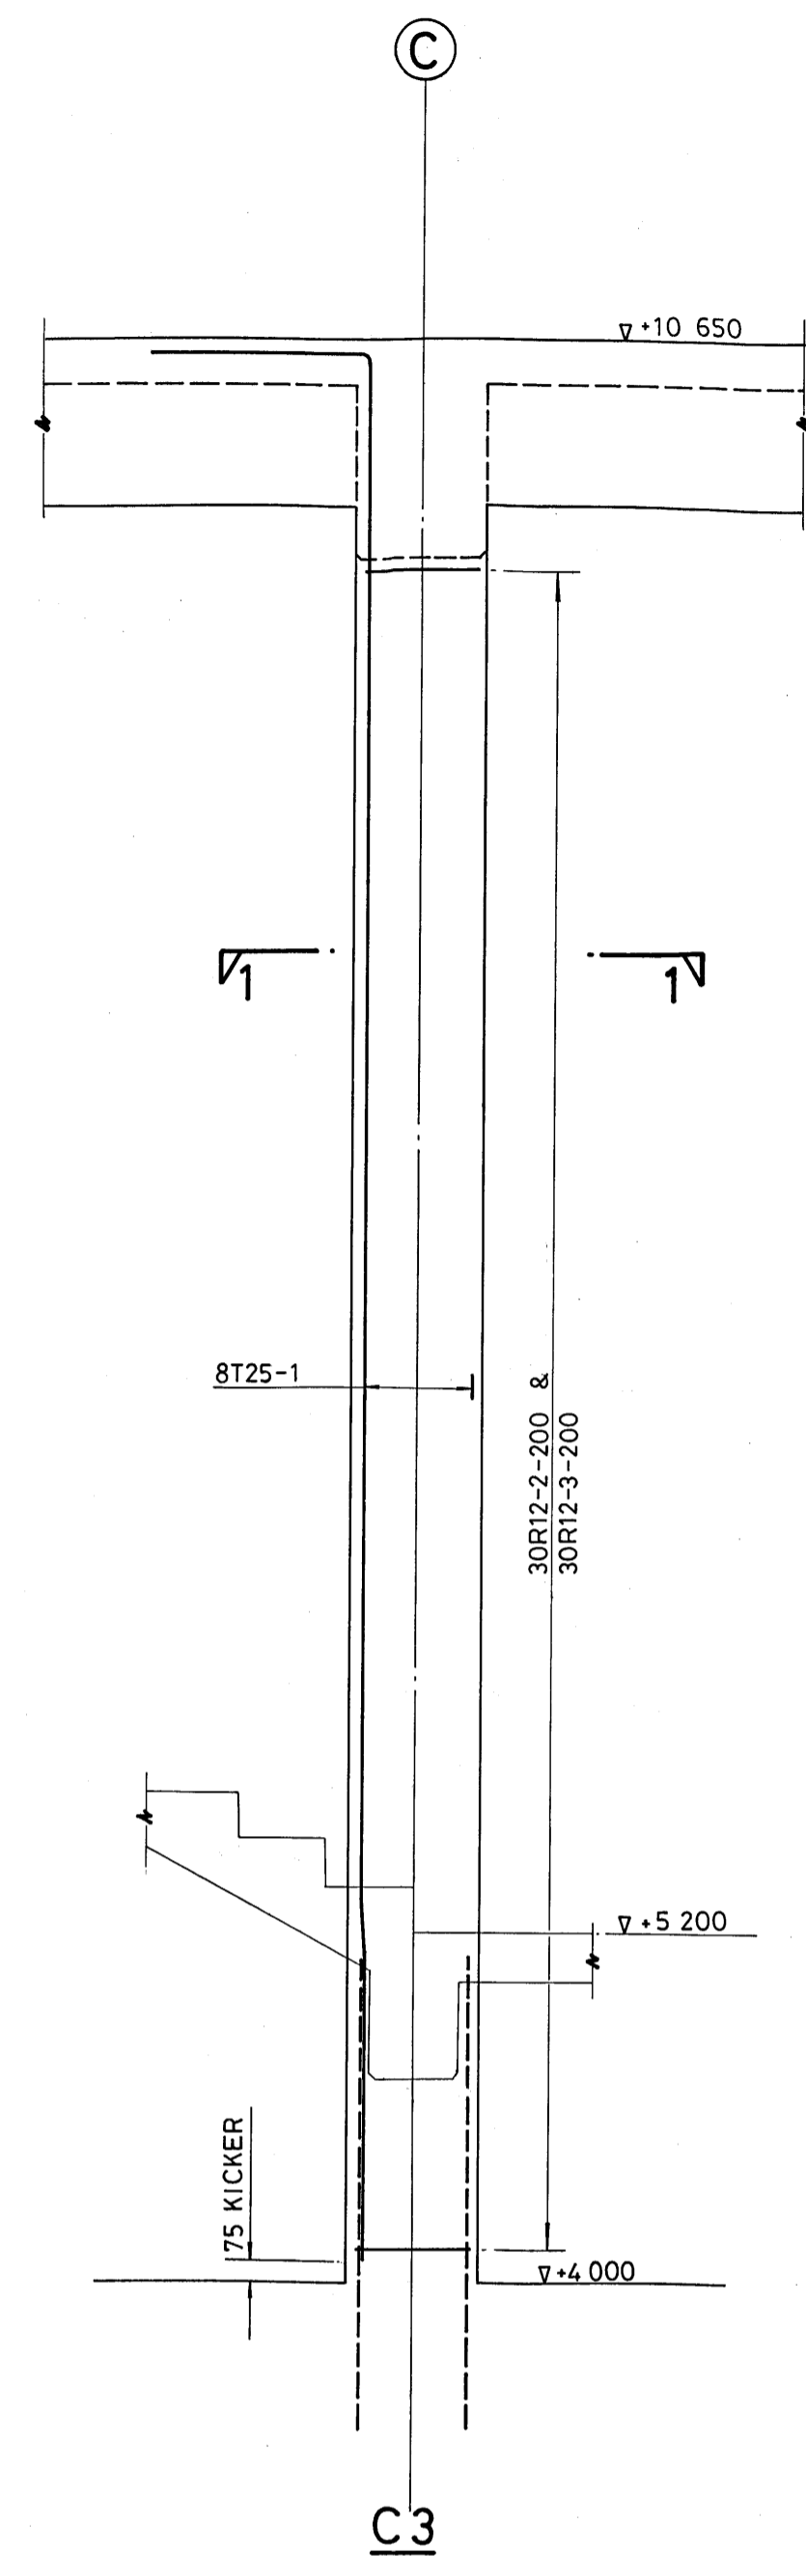


C3

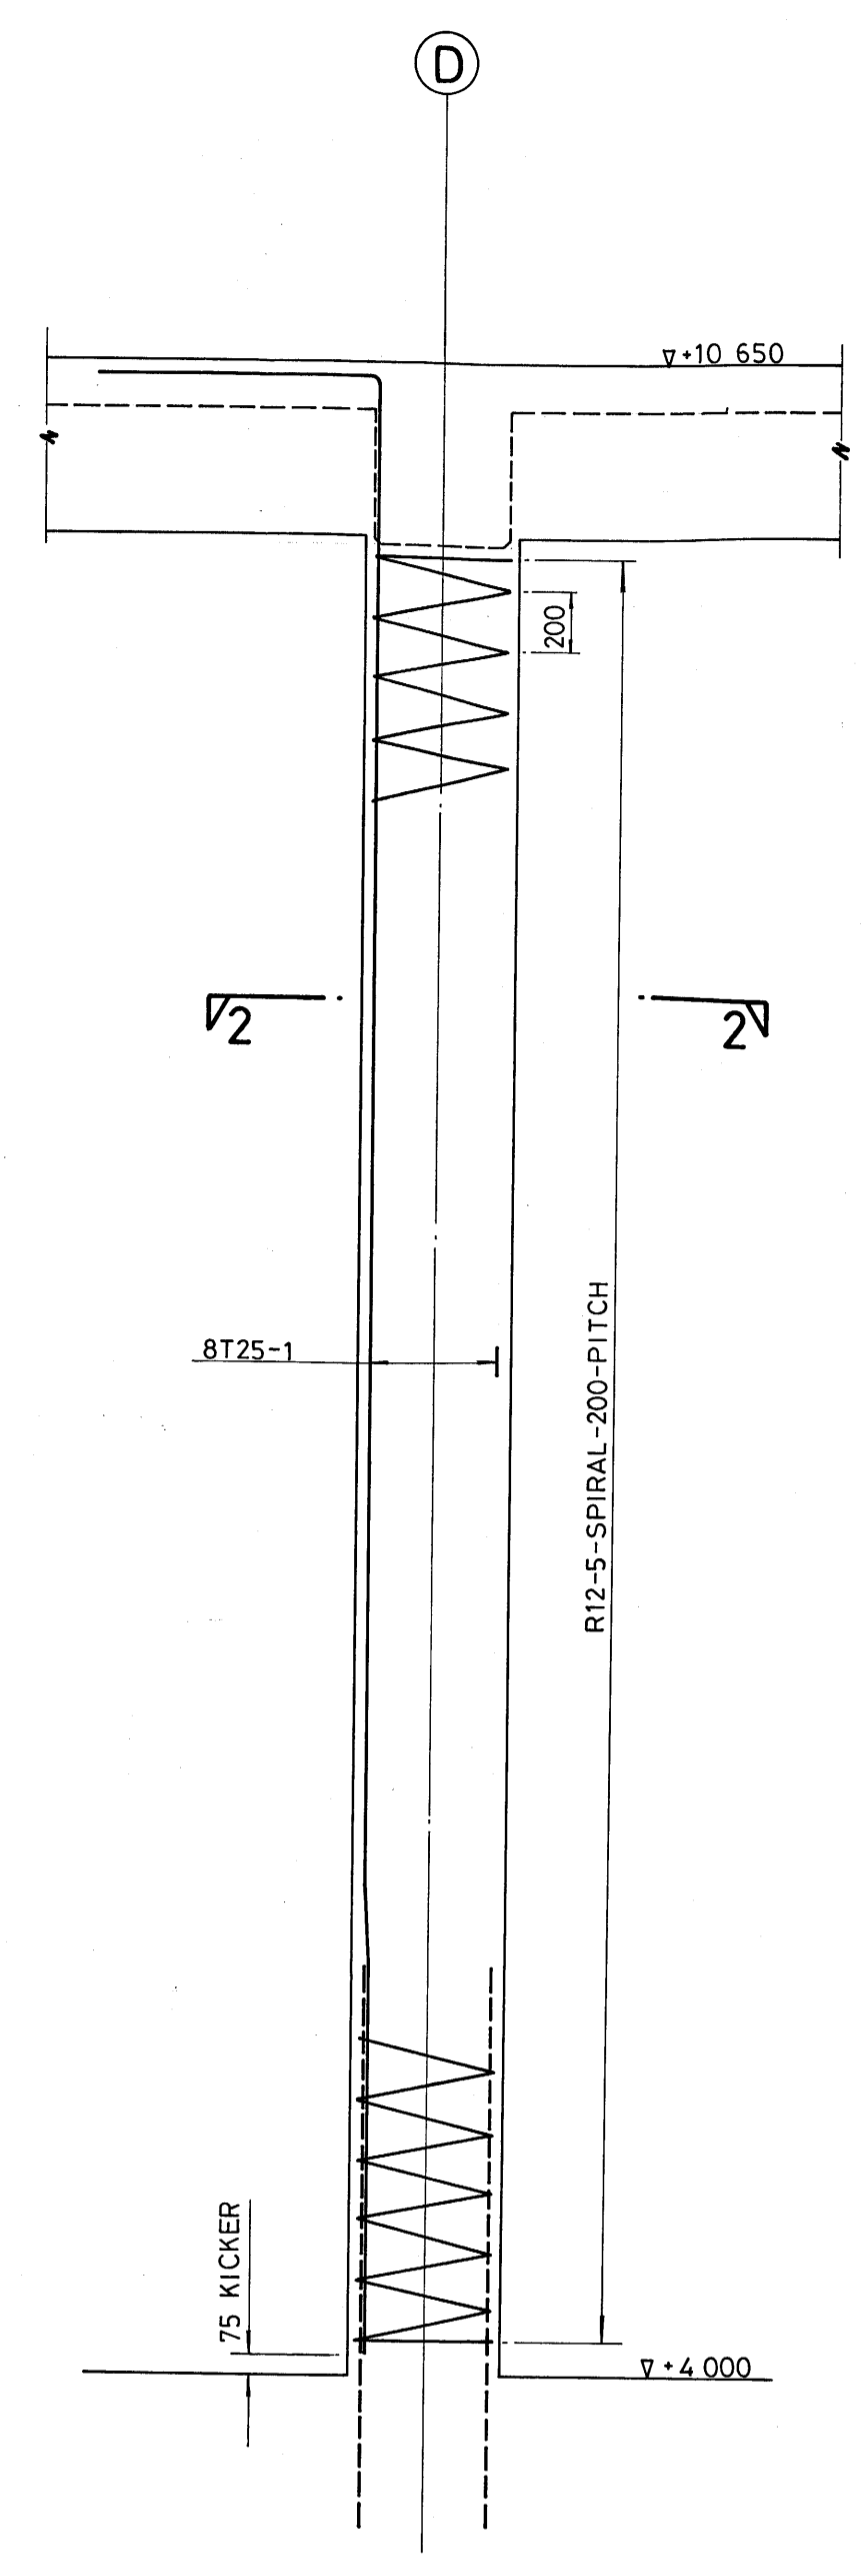


D3
(C5, D5, D7 SIMILAR)

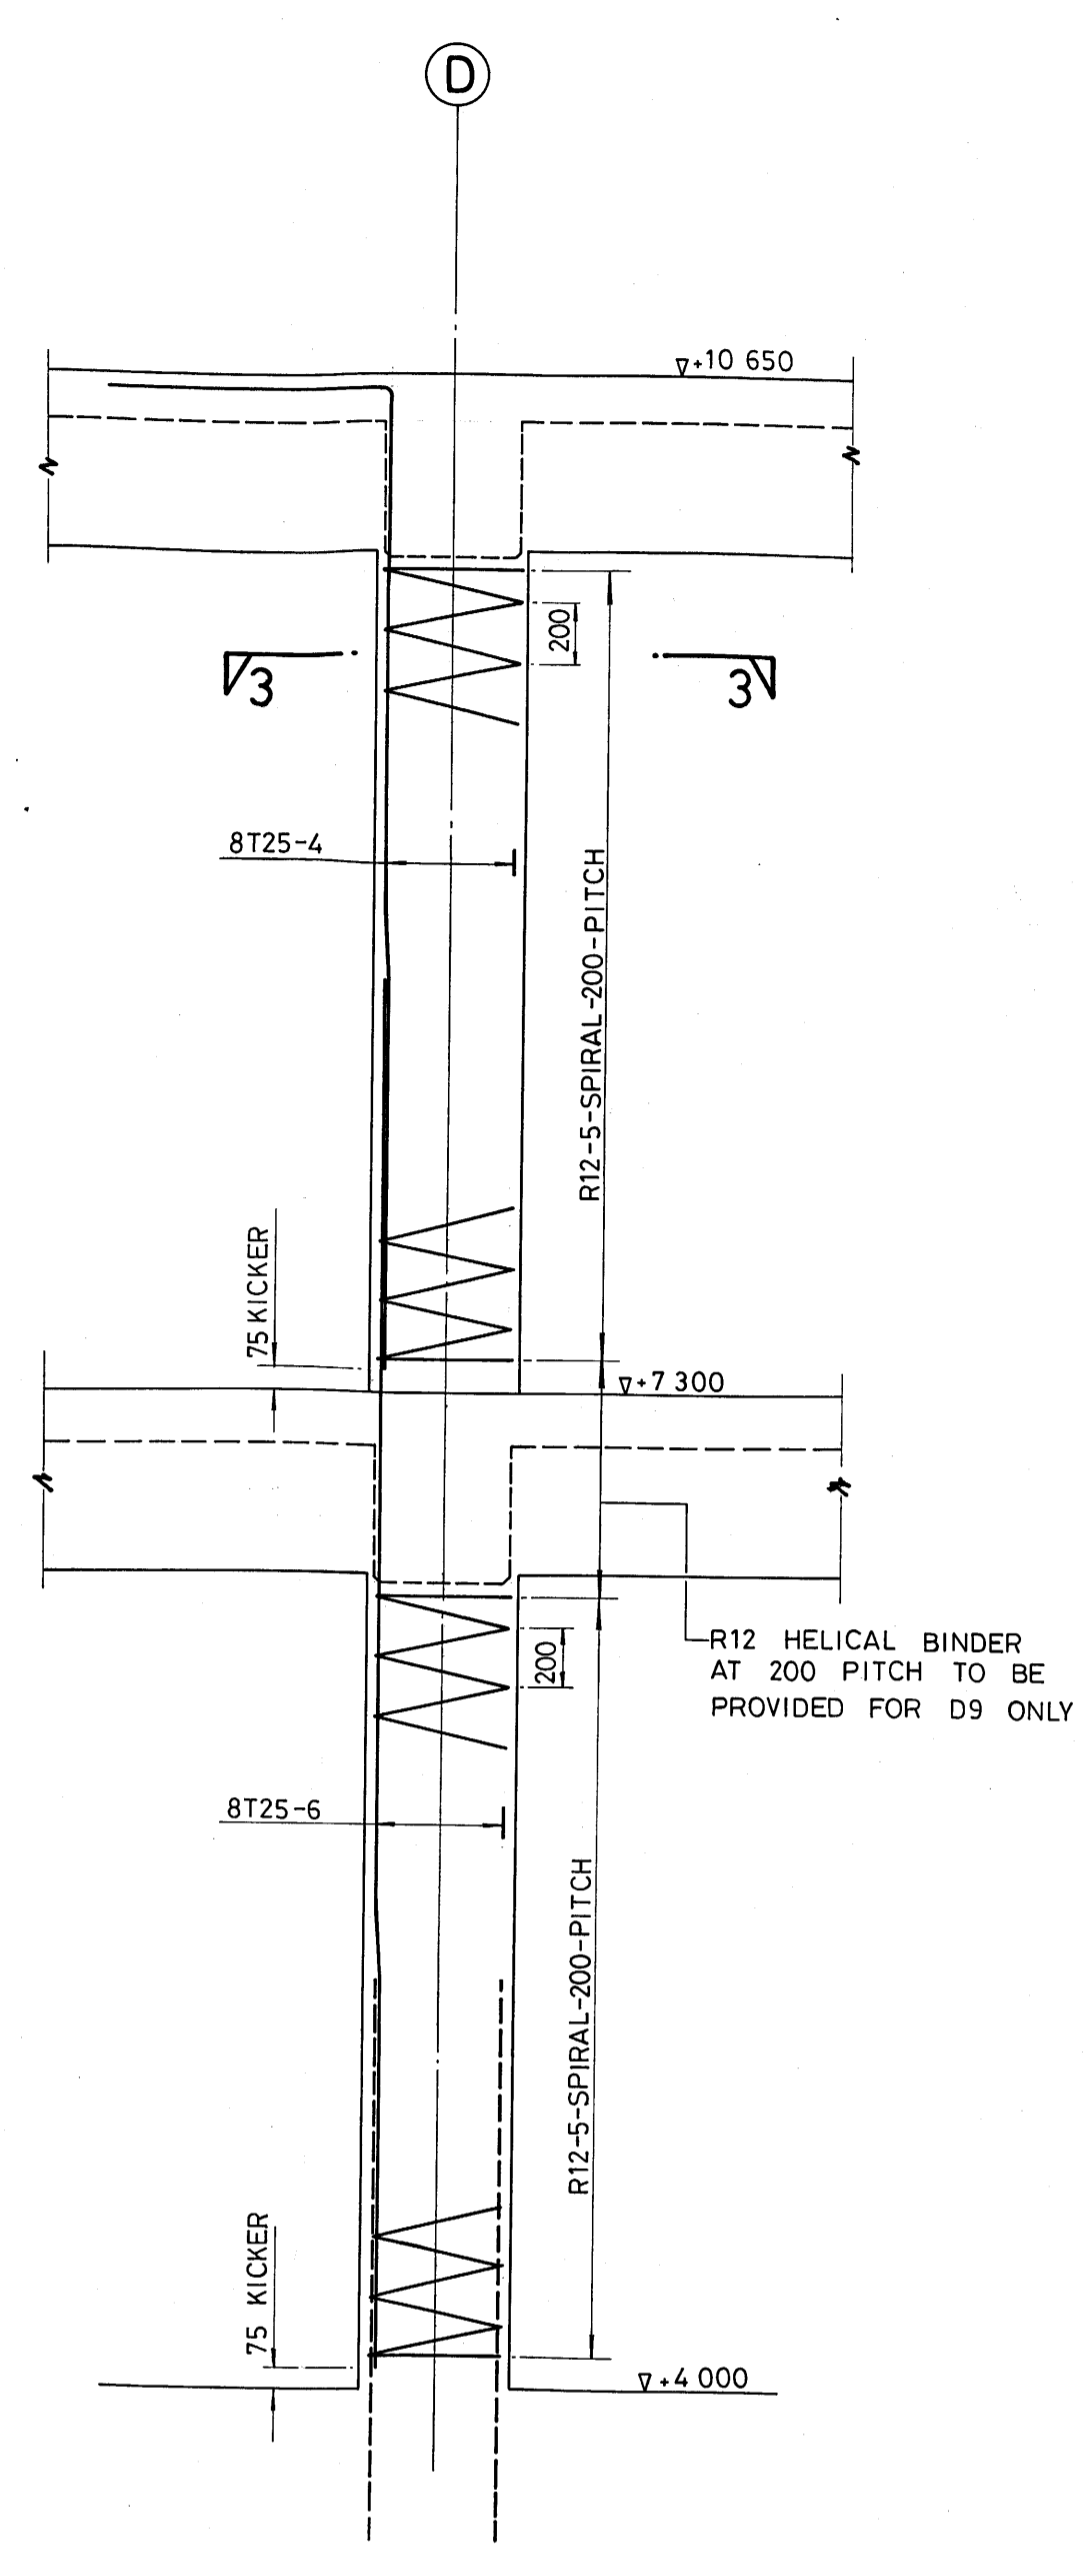


D9
(C11, D11, C13, D13, C15, D15, C17, D17, B19, C19 SIMILAR)

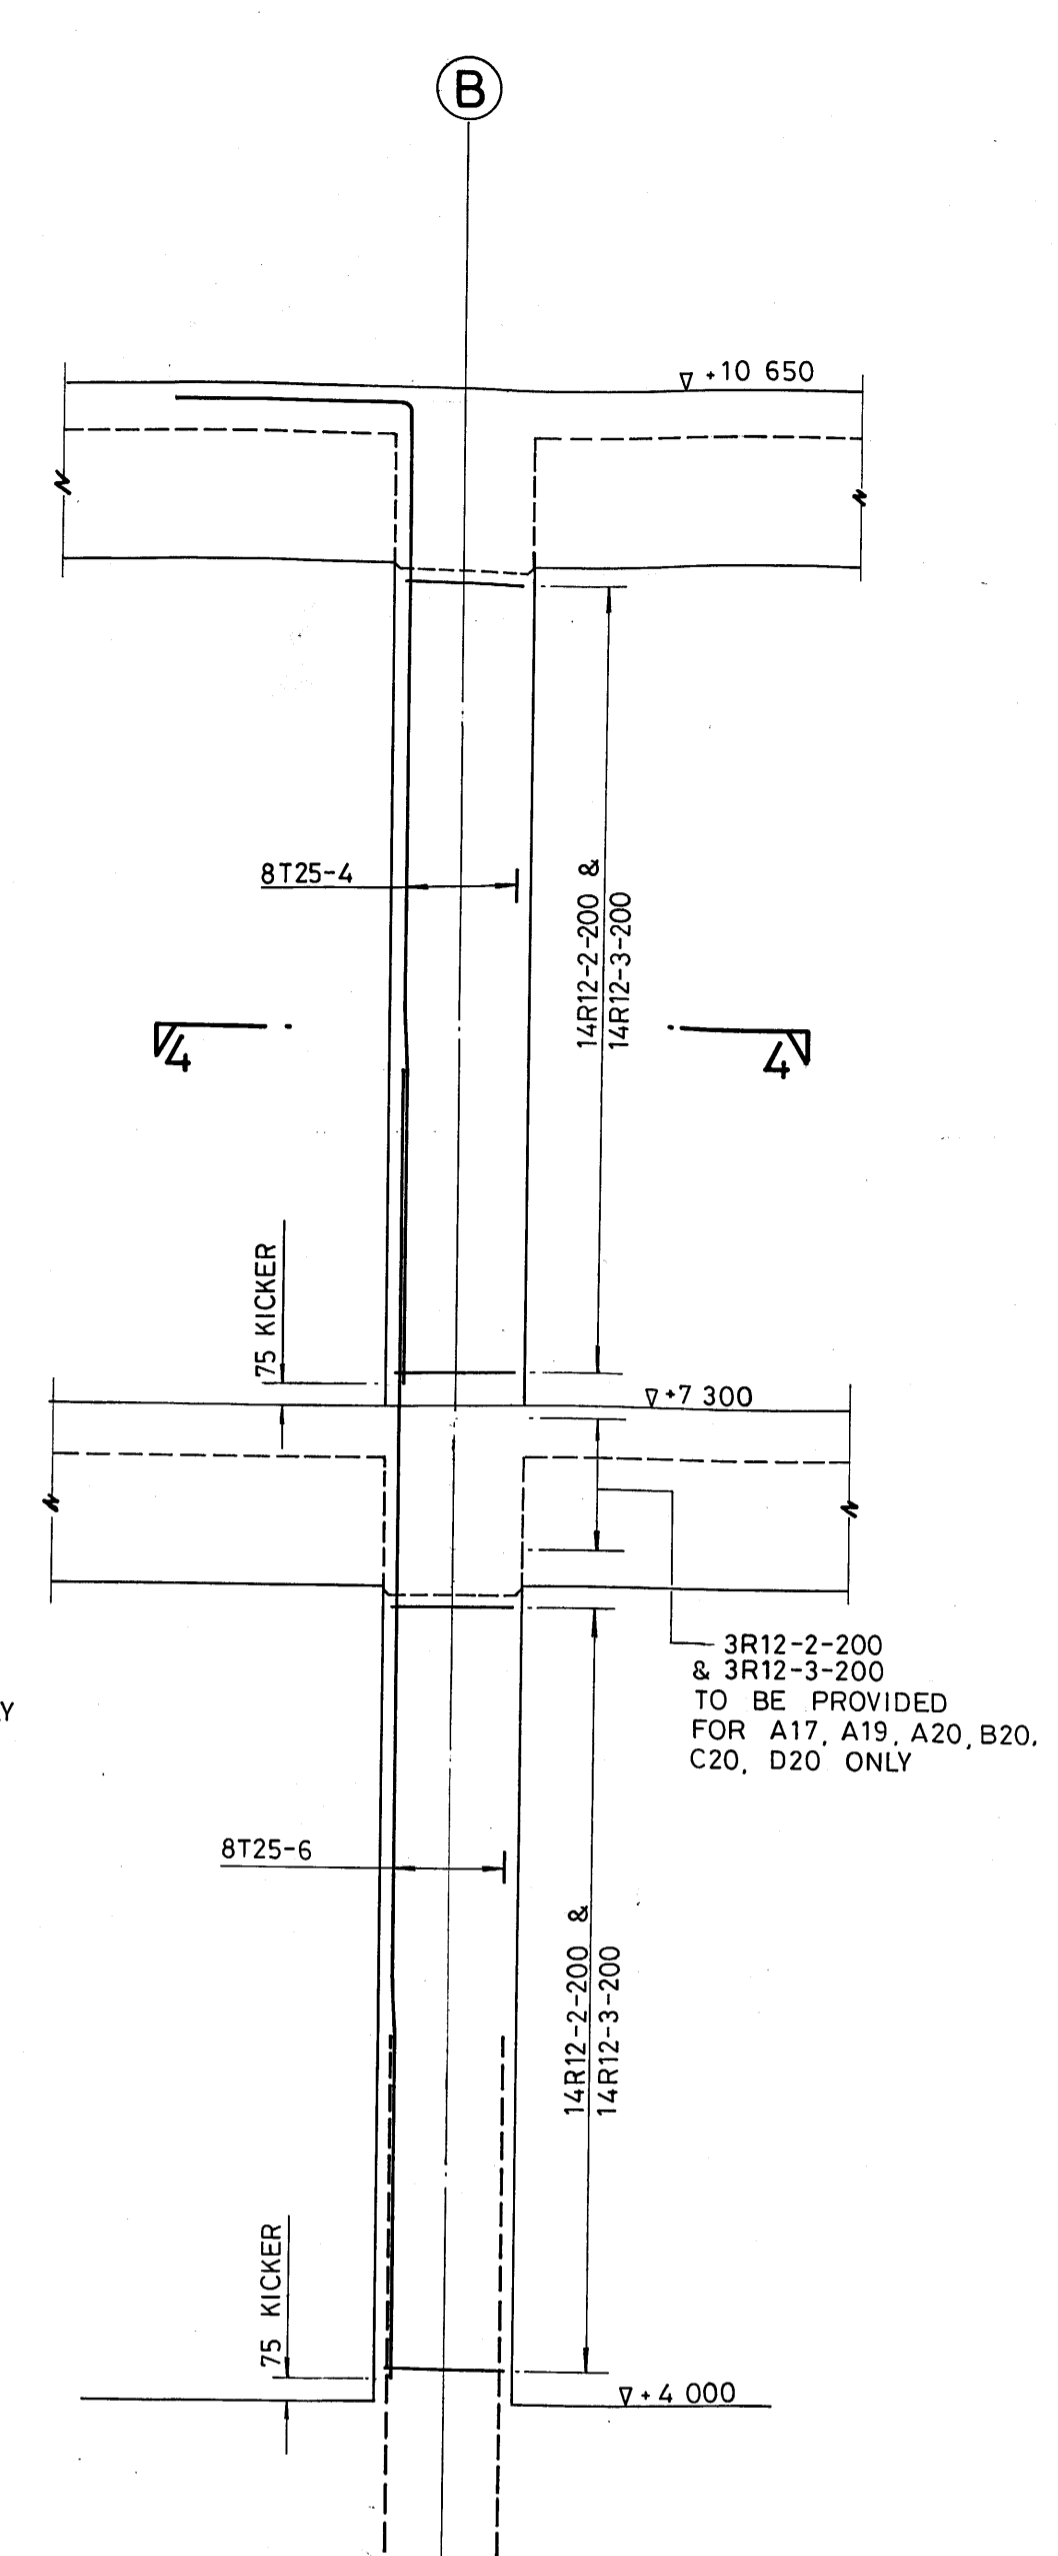


B17
(A17, A19, D19, A20, B20, C20, D20 SIMILAR)

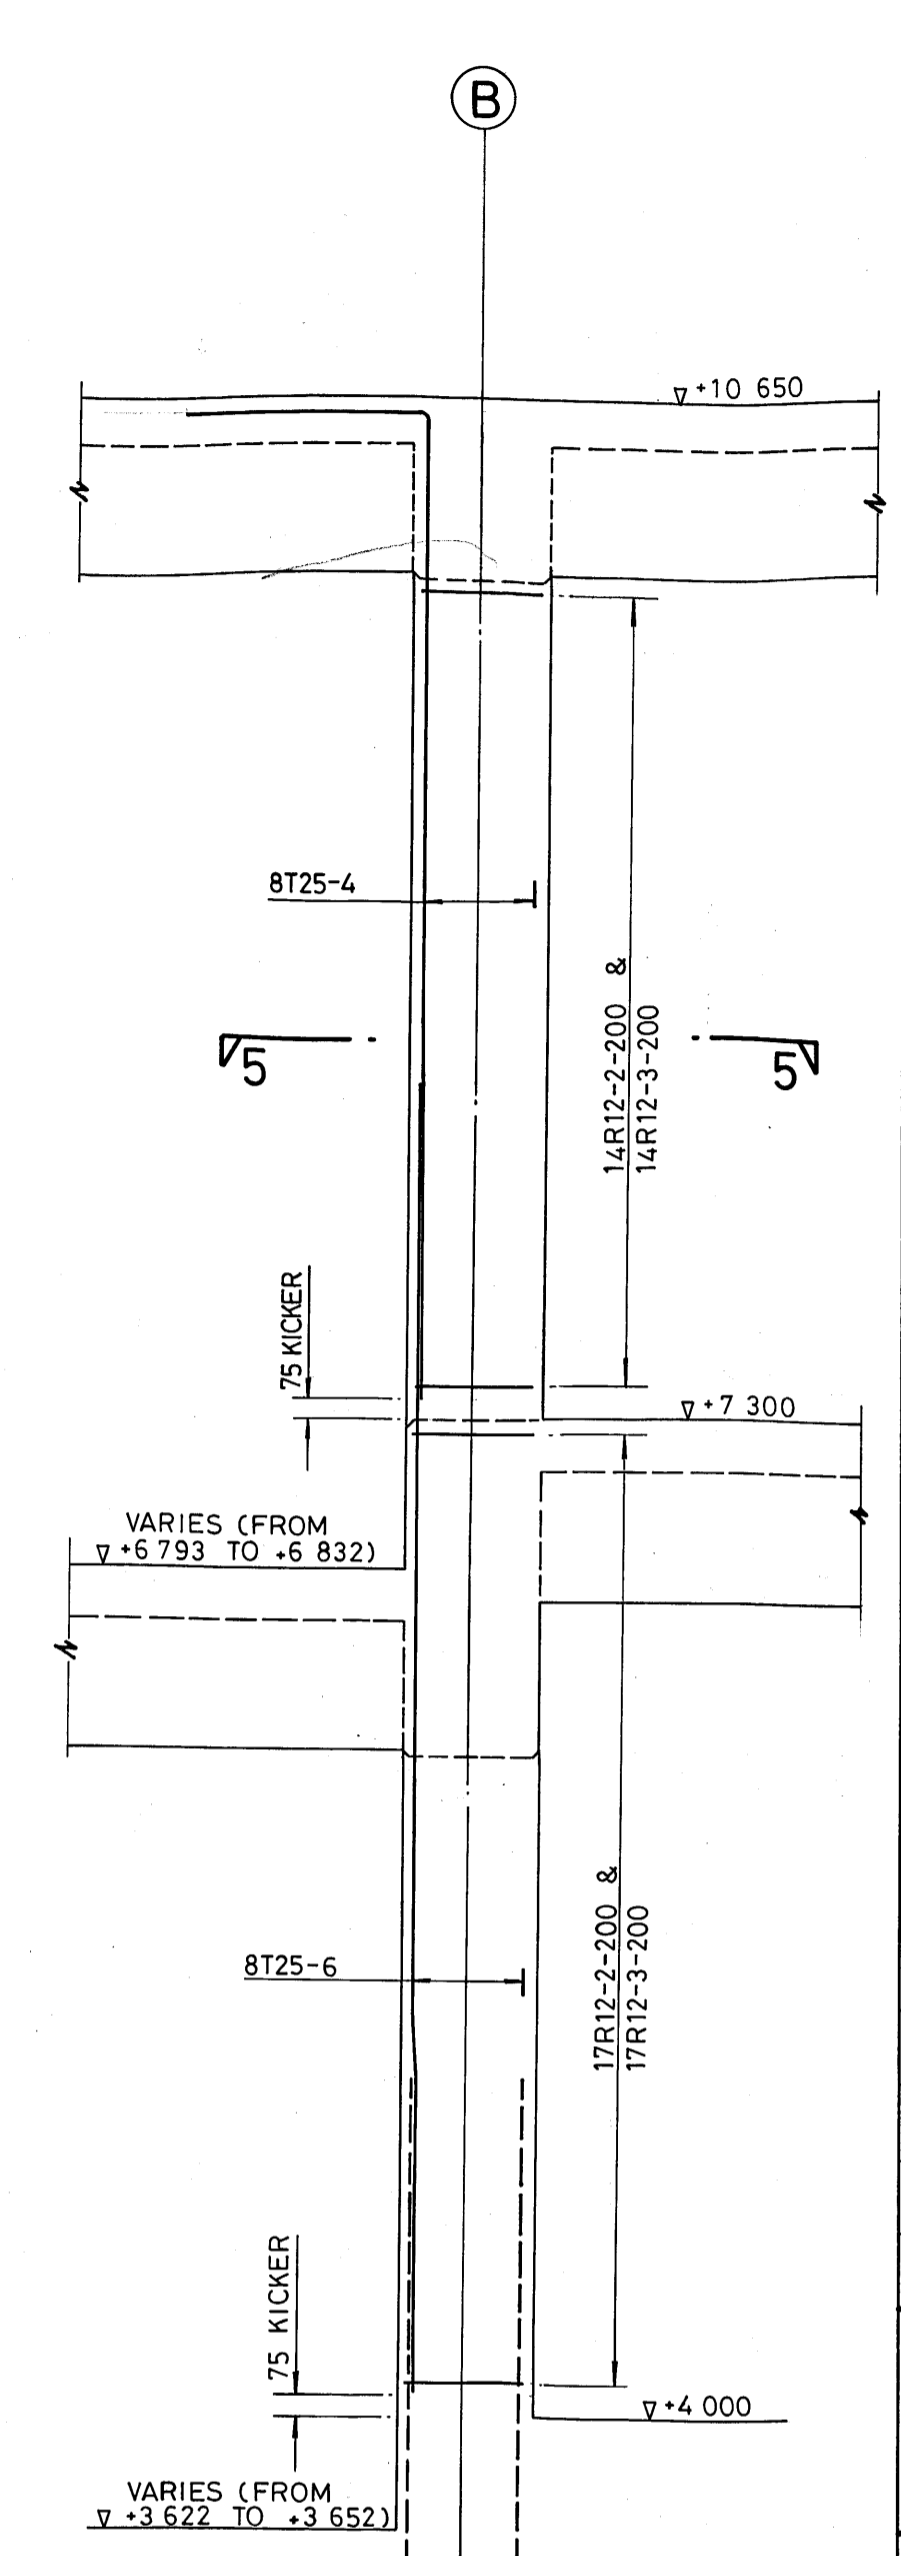


B15
(A15 SIMILAR)

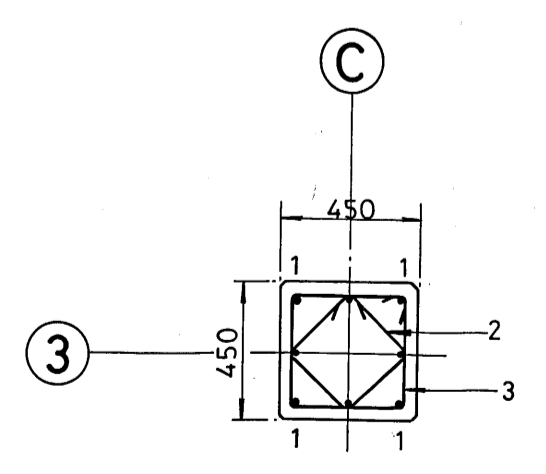


SECTION 1-1

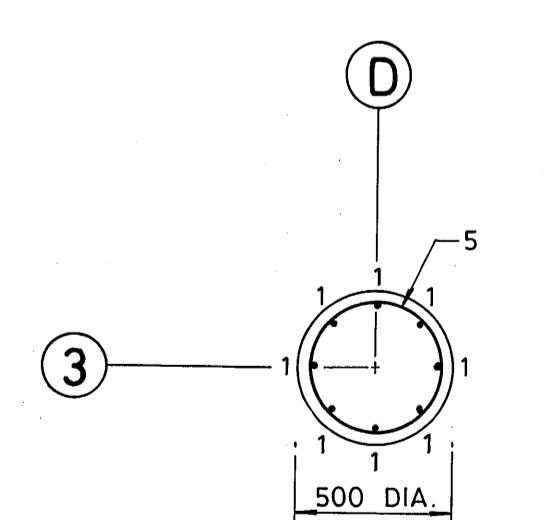


SECTION 2-2

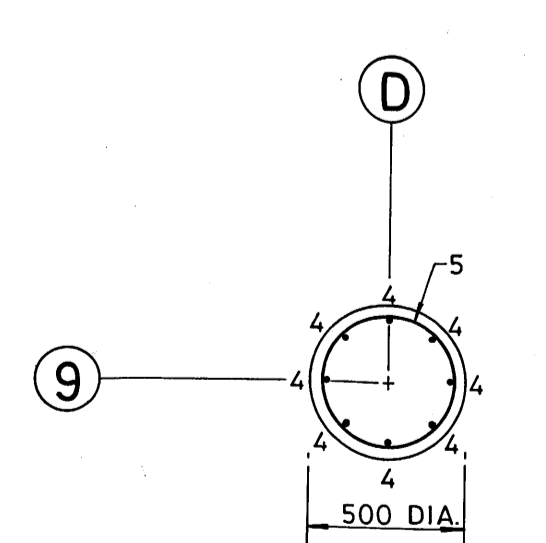

SECTION 3-3

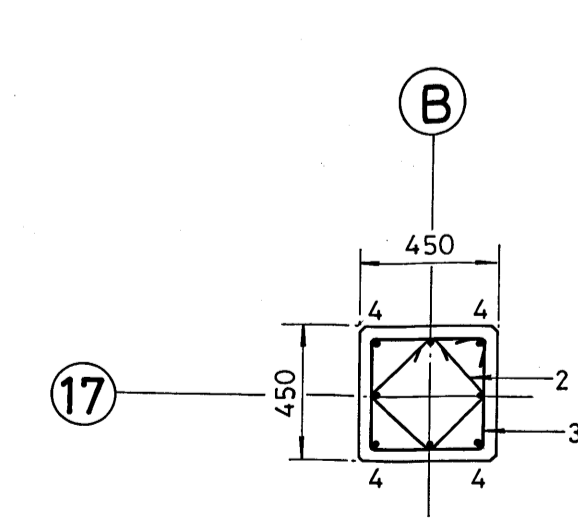

SECTION 4-4

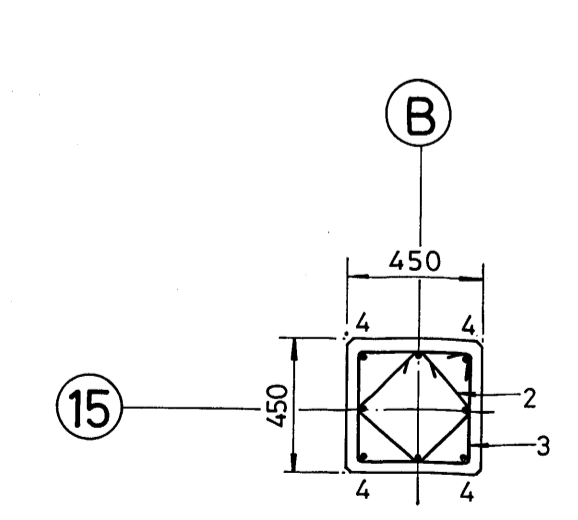

SECTION 5-5

AS CONSTRUCTED

A	4.93	PREPARED: (I.O.W.)	T. N. TSUI	
		CERTIFIED: (ENGINEER)	M. C. LEE	
no.	date	description	Initial	
REVISION				
		name		date
designed		T. K. CHEUNG	<i>TKC</i>	17-9-87
drawn		C. Y. LAI	<i>Lai</i>	19-10-87
traced		C. Y. LAI	<i>Lai</i>	20-10-87
checked		W. TSUI	<i>WTS</i>	6-1-88
approved			<i>W. Tsui</i>	13-1-88

contract no. CV / 87 / 08
file no. P.W.O. CV / 87 / 08
project no. 228 CL

contract
HUNG HOM BAY RECLAMATION PHASE II CONSTRUCTION OF FERRY PIERS AND SEAWALL STAGE I

drawing title
PIER B— R. C. DETAILS OF COLUMNS (SHEET 2 OF 4)

drawing no. **P16100A** scale 1 : 25

office
PORT WORKS DIVISION CIVIL ENGINEERING OFFICE

