

APPENDICES

- Appendix I** The Accepted Drainage Proposal of the Previous Application No. A/HSK/424
- Appendix II** Revised Drainage Proposal
- Appendix III** The Accepted Fire Service Installations Proposal of the Previous Application No. A/HSK/424
- Appendix IV** Revised Fire Service Installations Proposal

Appendix I

The Accepted Drainage Proposal of the Previous Application No. A/HSK/424

規 劃 署

屯門及元朗西規劃處
香港新界沙田上禾輦路1號
沙田政府合署14樓

**By Fax (2323 3662) and Post****Planning Department**

Tuen Mun and Yuen Long West
District Planning Office
14/F, Sha Tin Government Offices,
1 Sheung Wo Che Road, Sha Tin,
N.T. Hong Kong

29 May 2024

來函檔號 Your Reference
本署檔號 Out Reference () in TPB/A/HSK/424
電話號碼 Tel. No.: 2158 6294
傳真機號碼 Fax No.: 2489 9711

Dear Sir/ Madam,

Compliance with Approval Condition (a)
Planning Application No. A/HSK/424

I refer to your submission dated 3.5.2024 regarding the submission of a drainage proposal for compliance with captioned approval condition. The relevant department has been consulted on your submission. Your submission is considered:

- Acceptable. The captioned condition has been complied with.
- Acceptable. Since the captioned condition requires both the submission and implementation of the proposal, it has not been fully complied with. Please proceed to implement the accepted proposal for full compliance with the approval condition.
- Not acceptable. The captioned condition has not been complied with.

Should you have any queries, please contact Ms. Vicky SY (Tel: 2300 1347) of the Drainage Services Department direct.

Yours faithfully,

(Ms. Charlotte LAM)
for District Planning Officer/
Tuen Mun and Yuen Long West
Planning Department

c.c

CE/MN, DSD (Attn: Ms. Vicky SY)

Internal

CTP/TPB2

Our Ref. : DD124 Lot 25 & VL
Your Ref. : TPB/A/HSK/424

The Secretary,
Town Planning Board,
15/F, North Point Government Offices,
333 Java Road,
North Point, Hong Kong

By Email

3 May 2024

Dear Sir,

Compliance with Approval Condition (a)

**Proposed Temporary Warehouse (Excluding Dangerous Goods Godown) with Ancillary Facilities
for a Period of 3 Years in "Village Type Development" and "Open Space" Zones,
Various Lots in D.D. 124 and Adjoining Government Land, Ha Tsuen, Yuen Long, New Territories**

(S.16 Planning Application No. A/HSK/424)

We are writing to submit a response-to-comments table and a revised drainage proposal for compliance with approval condition (a) of the subject application, i.e. *the submission of a drainage proposal (Appendices I and II)*.

Should you require more information regarding the application, please contact our Mr. Louis TSE at (852) [REDACTED] or the undersigned at your convenience. Thank you for your kind attention.

Yours faithfully,

For and on behalf of
R-riches Property Consultants Limited

Matthew NG
Planning and Development Manager

Appendix I – Response to comments of the Chief Engineer/Mainland North, Drainage Services Department (CE/MN,DSD)

Comments of the CE/MN, DSD (Contact Person: Ms. Vicky SY; Tel: 2300 1347)		
(i)	<p>The U channel at the eastern side of the application site proposed on the submission dated 28.2.2024 is deleted in this submission. Please clarify on the reason for this change. Please note that peripheral surface channels shall be provided along the site boundary to collect the surface runoff accrued on the application site and to intercept the overland flow from the adjacent lands.</p>	<p>Peripheral channel is provided (i.e. UC is provided at the eastern side of the application site) as shown at the revised drainage proposal (Appendix II).</p>



Site Area 9293 m²
 B1 Area 7163 m²

CP1 CP11
 Coverage Area 9293.7163/2130 m²
 0.278/0.95/250/2130/1000000/0.141 m³/0.8438 m/m

Provide 375UC(1:200) 0

Gutter
 Coverage Area B1/2 3581.5 m²
 0.278/0.95/250/3581.5/1000000/0.236 m³/0.14188 m/m

Provide 500(W):275(D) (1:150) 0 (refer to sheet 3)


CP11 CP14
 8438/14188/22626 m/m

Provide 525UC(1:150) 0

Flood Defence for CP14
 Coverage Area 9293 m²
 0.278/0.95/250/9293/1000000/0.614 m³/0.36814 m/m

Provide 600e(1:100) 0 (refer to sheet 4)

APPLICATION SITE

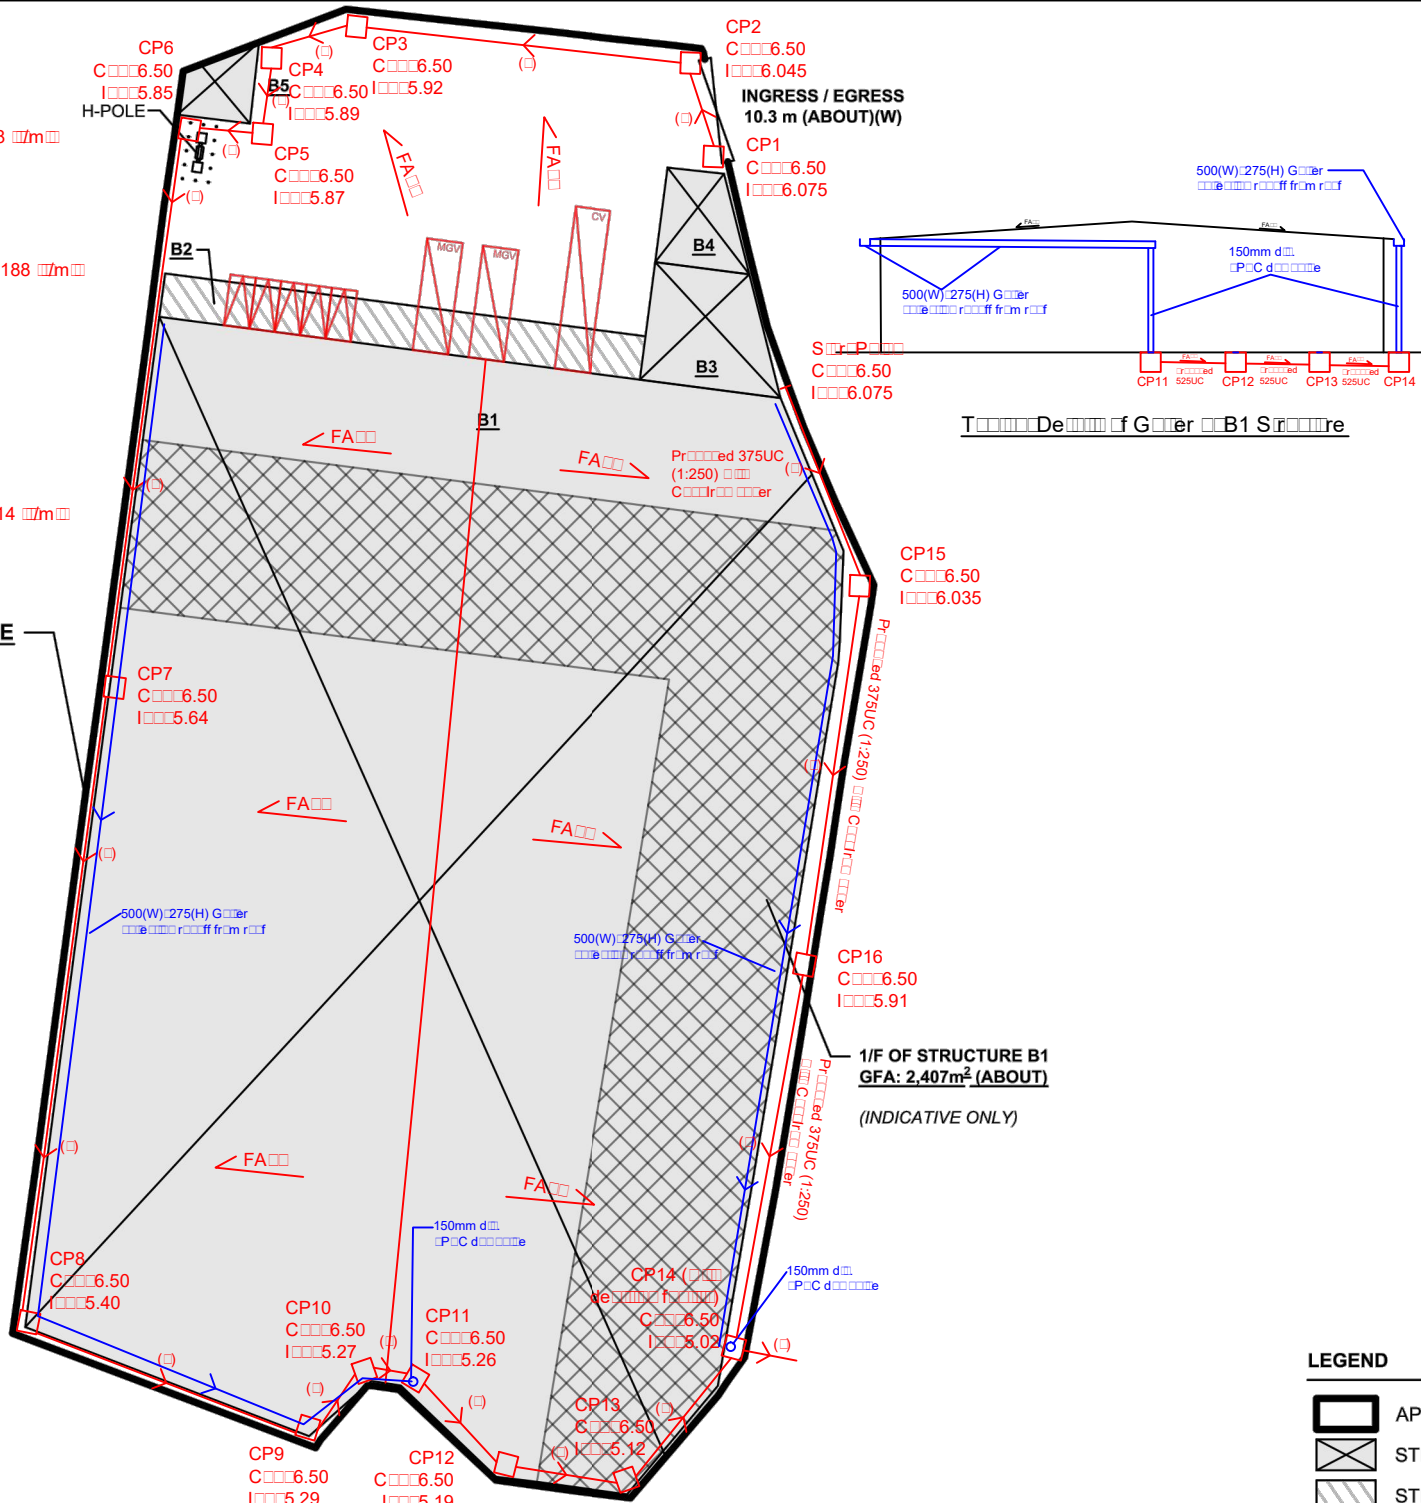

LEGEND

()	Provide 375UC (1:250) 0
()	Provide 525UC (1:150) 0
()	Provide 600(1:100) 0
□	Provide Column
◆	Provide Formwork Detail
◆	Existing Ground Detail

正宏工程顧問公司
 Ching Wan Engineering
 Consultants Company

PROJECT:

 Good) and A
 For Period of
 3 to 25
 (Part) 26 (Part) 27
 (Part) 28 (Part) 29/30
 31/32 (Part) 33 (Part)
 34 (Part) 36 (Part) 70
 (Part) 76 (Part) 77
 (Part) 78 S.A (Part) 80
 (Part) 82 (Part)
 D.D. 124 and Ad
 Gutter and H
 Terrace

(A/H/S/424)

TITLE:
 Coverage P

File:	DWG NO.
Scale:	HS/424/D02
Date:	25/4/2024



LEGEND

□	APP
▨	STR
▧	STR


PROVISIONS

5
 5 m (L) X 2.5 m (W)

VEHICLE - 2

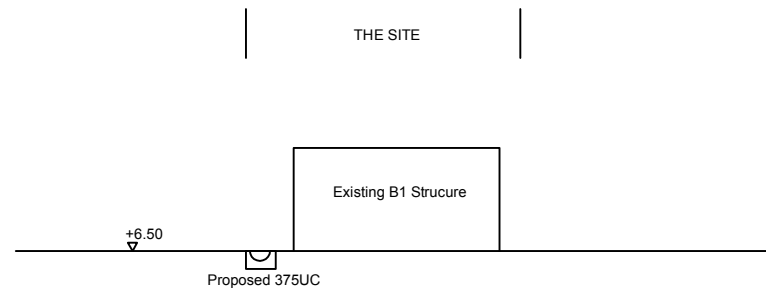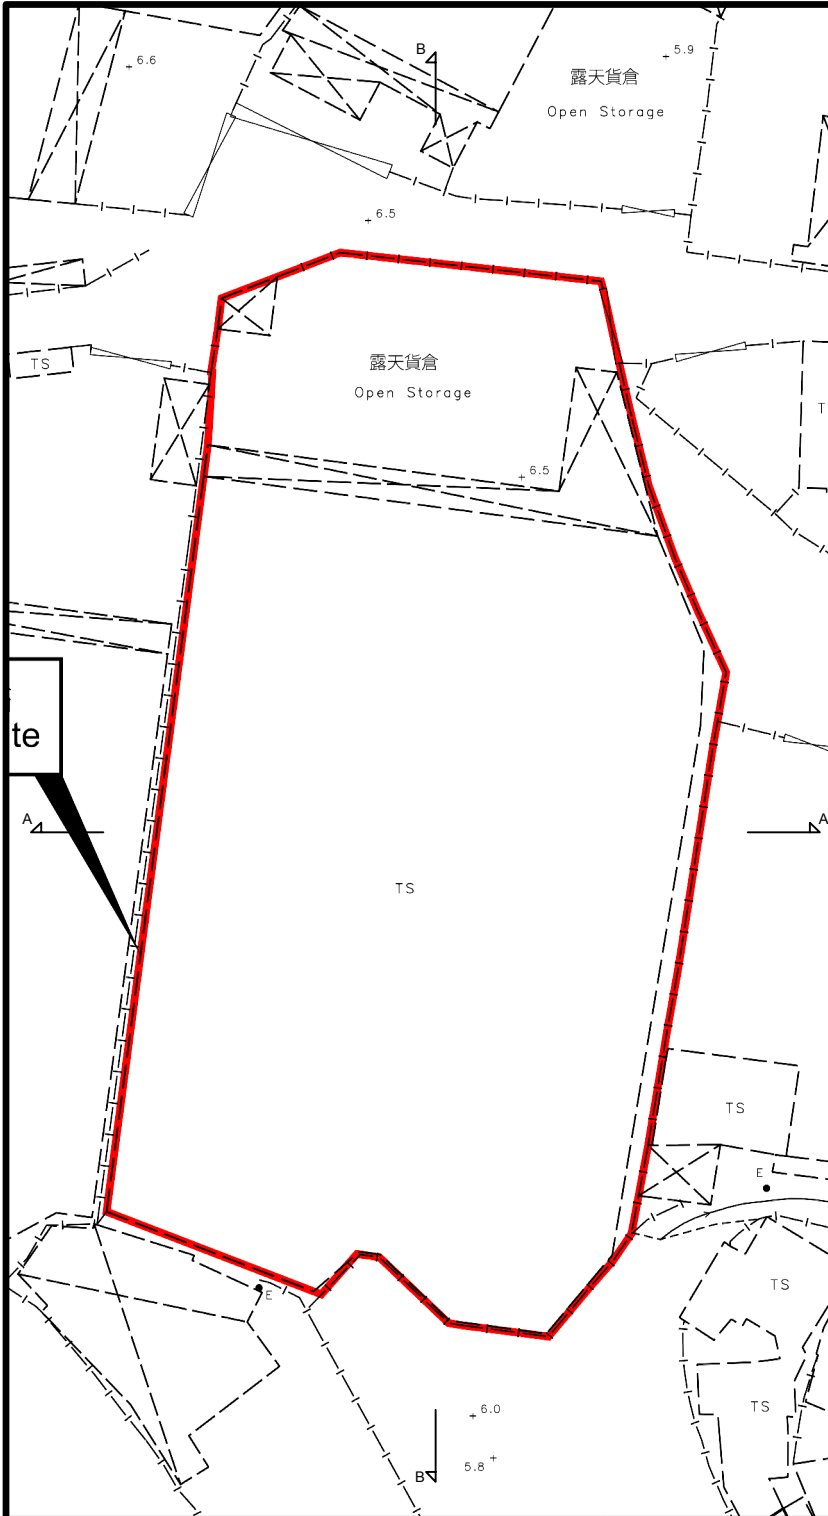

SECTION A-A

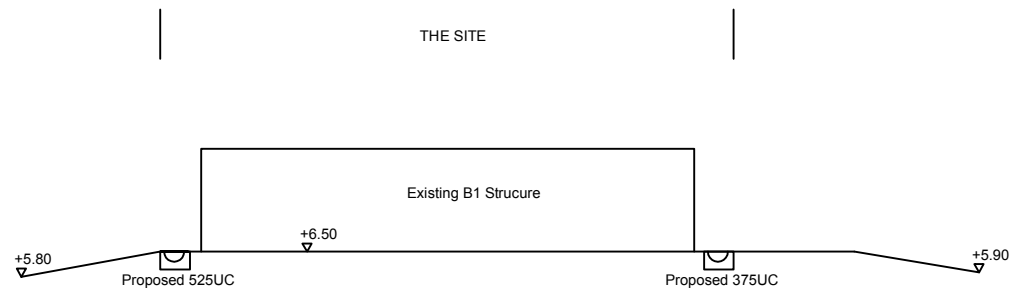

SECTION B-B

LEGEND

- (a) Proposed 375UC (1:250) with Cast Iron cover
- (b) Proposed 525UC (1:150) with Cast Iron cover
- (c) Proposed 600(1:100) concrete pipe
- Proposed Catchpit
- ◆+18.50 Proposed Formation Level
- ◆+18.20 Existing Ground Level

Company:

正宏工程顧問公司
Ching Wan Engineering
Consultants Company

PROJECT:

Proposed Temporary Warehouse (Excluding Dangerous Goods Godown) with Ancillary Facilities for a Period of 3 Years at Lots 25 (Part), 26 (Part), 27 (Part), 28 (Part), 29, 30, 31, 32 (Part), 33 (Part), 34 (Part), 36 (Part), 70 (Part), 76 (Part), 77 (Part), 78 S.A (Part), 80 (Part) and 82 (Part) in D.D. 124 and Adjoining Government Land, Ha Tsuen, Yuen Long, New Territories

(A/HSK/424)

TITLE:

SECTIONS

File:


DWG NO.

Scale:

HSK424-D03

Date:

15-3-2024

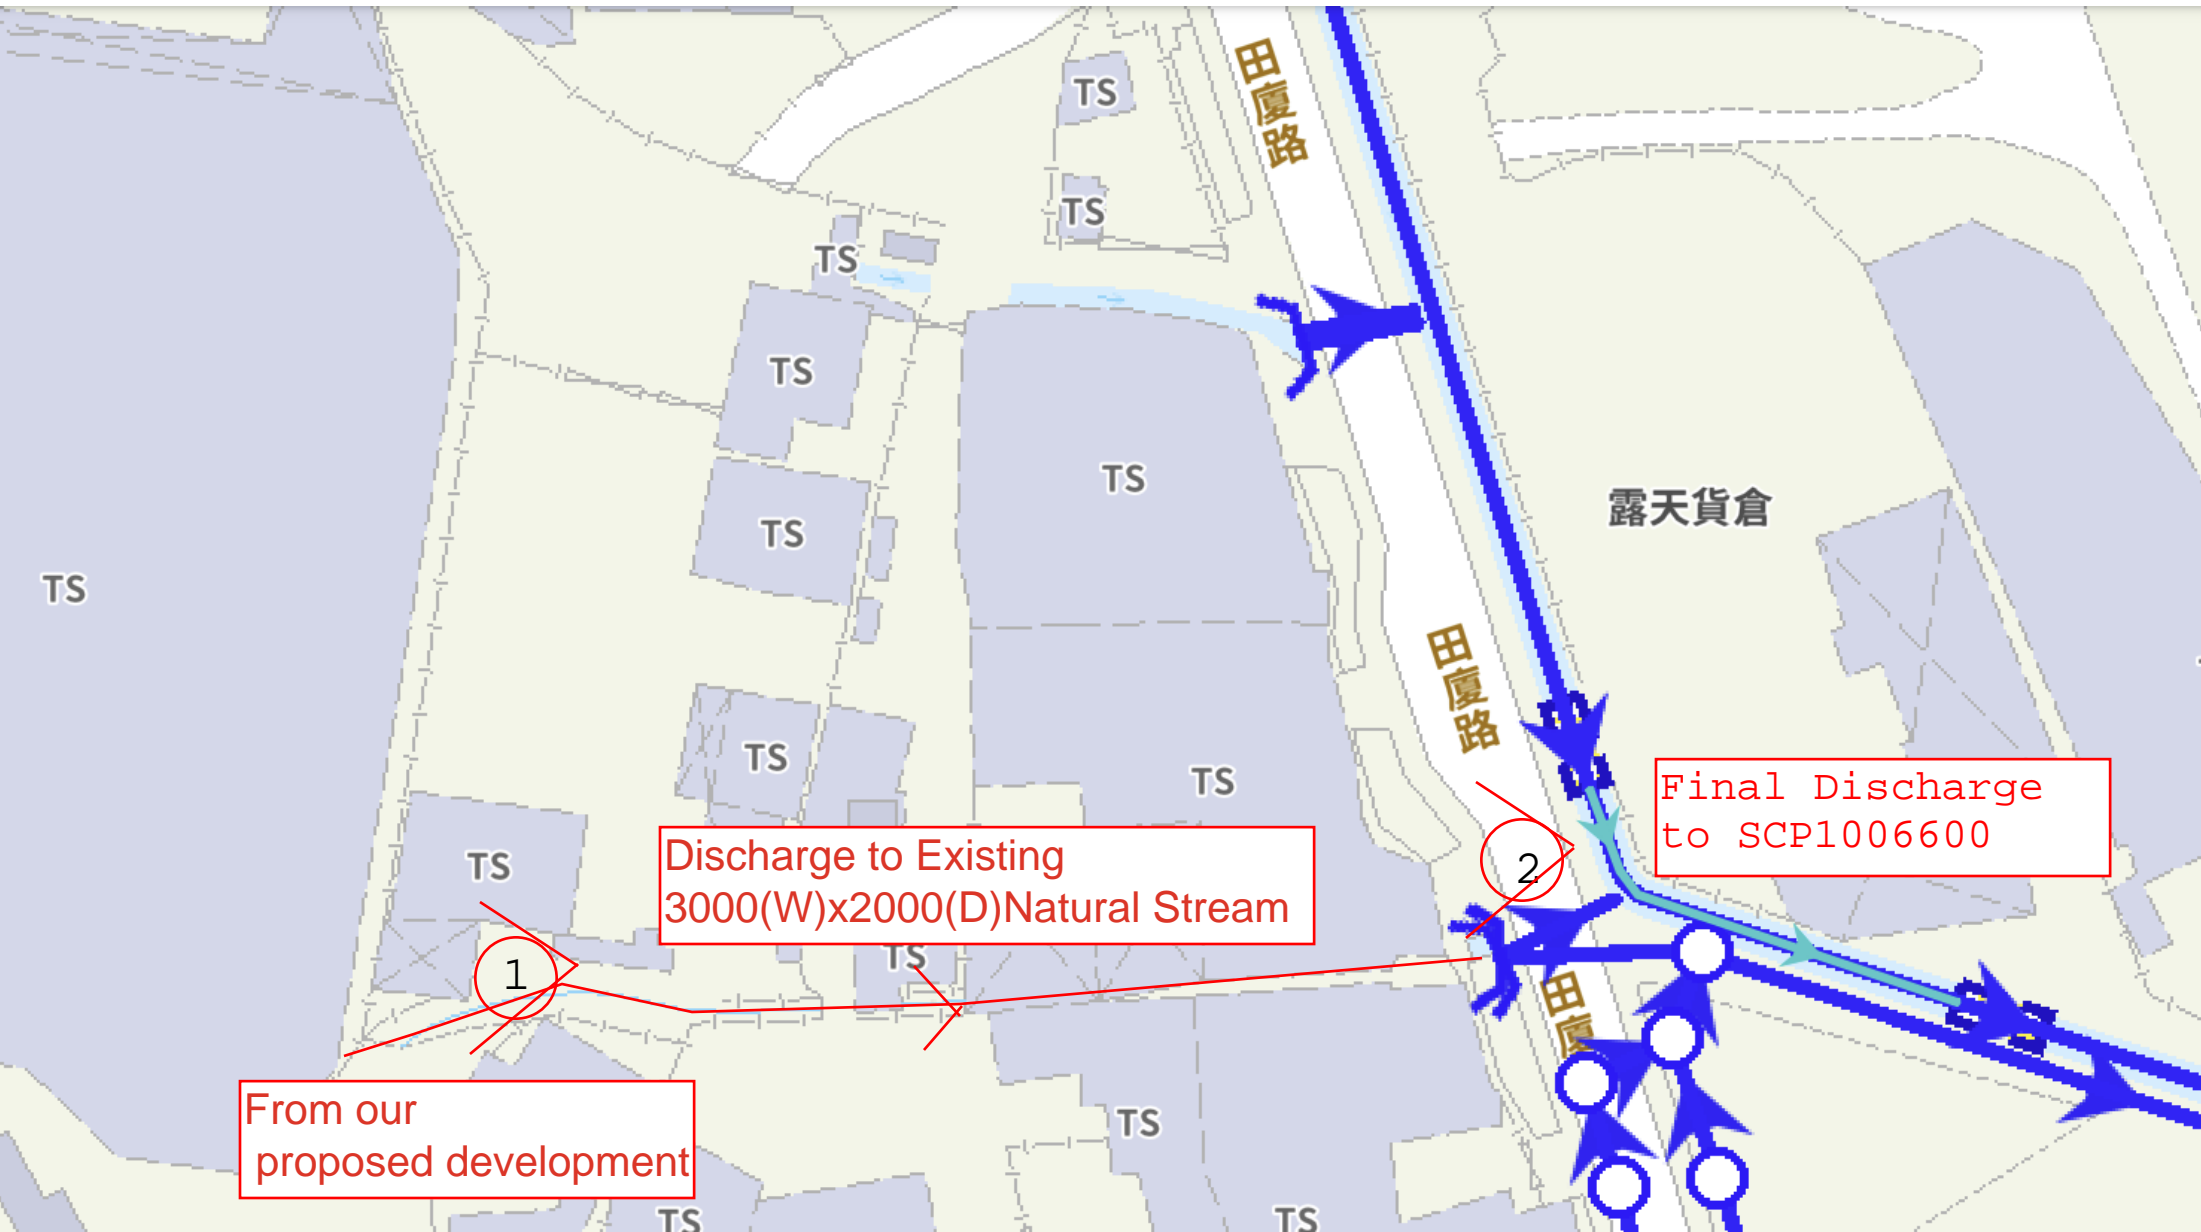

From our proposed development

Discharge to Existing 3000(W)x2000(D) Natural Stream

Final Discharge to SCP1006600



VIEW 1: Existing 3000(W)x2000(D)Natural Stream



VIEW 2: FINAL DISCHARGE POINT SCP1006600

Calculation of Runoff from the Proposed Development,

$$Q = 0.278 C i A$$

$$C = 0.95 \quad (\text{P.42 of Stormwater Drainage Manual})$$

$$A = 3581.5 \quad \text{m}^2$$

$$= 0.0035815 \quad \text{km}^2$$

$$\text{take } i = 250 \quad \text{mm/hr}$$

$$\text{Therefore, } Q = 0.278 * 0.95 * 250 * 0.0035815$$

$$= 0.236 \quad \text{m}^3/\text{sec}$$

$$= \underline{\underline{14188}} \quad \text{lit/min}$$

Calculation Maximum Capacity of Proposed 500(W)x275(D) Gutter

$$\text{Manning Equation } V = R^{2/3} * S_f^{0.5} / n$$

$$\text{where } R = (W * D) / (2D + W) \quad W = 0.5 \text{ m}$$

$$= 0.131 \quad D = 0.275 \text{ m}$$

$$n = 0.012 \quad \text{s/m}^{1/3} \quad (\text{Table 13 of Stormwater Drainage Manual})$$

$$1/150 \quad S_f = 0.0067$$

$$\text{Therefore, } V = 0.131^{2/3} * 0.0067^{0.5} / 0.012$$

$$= 1.755 \quad \text{m/sec}$$

$$\text{Maximum Capacity (Q}_{\text{max}}) = V * A$$

$$= 1.755 * 0.5 * 0.275$$

$$= 0.241 \quad \text{m}^3/\text{sec}$$

$$1 \text{ nos of Gutter} = 0.241 \quad \text{m}^3/\text{sec}$$

$$= 14476 \quad \text{lit/min}$$

$$> 14188 \quad \text{lit/min}$$

Provide 500(W)x275(D) Gutter (1:150) is OK

Calculation of Runoff from the Proposed Development,

$$Q = 0.278 C i A$$

$$C = 0.95 \quad (\text{P.42 of Stormwater Drainage Manual})$$

$$A = 9293 \quad \text{m}^2$$

$$= 0.009293 \quad \text{km}^2$$

$$\text{take } i = 250 \quad \text{mm/hr}$$

$$\text{Therefore, } Q = 0.278 * 0.95 * 250 * 0.009293$$

$$= 0.614 \quad \text{m}^3/\text{sec}$$

$$= \underline{\underline{36814}} \quad \text{lit/min}$$

Calculation Maximum Capacity of Proposed 600mm dia. Underground pipe.

$$\text{Manning Equation } V = R^{2/3} * S_f^{0.5} / n$$

$$\text{where } R = \frac{\pi r^2}{2 \pi r} \quad \text{dia } 600 \text{ mm}$$

$$= r/2 \quad r = 0.3 \text{ m}$$

$$= 0.15 \quad \text{m}$$

$$n = 0.012 \quad \text{s/m}^{1/3} \quad (\text{Table 13 of Stormwater Drainage Manual})$$

$$1/100 \quad S_f = 0.01$$

$$\text{Therefore, } V = 0.15^{2/3} * 0.01^{0.5} / 0.012$$

$$= 2.353 \quad \text{m/sec}$$

$$\text{Maximum Capacity (Q}_{\text{max}}) = V * A$$

$$= 2.353 * \pi r^2$$

$$= 0.665 \quad \text{m}^3/\text{sec}$$

$$1 \text{ nos of pipe } = 0.665 \quad \text{m}^3/\text{sec}$$

$$= 39911 \quad \text{lit/min}$$

$$> 36814 \quad \text{lit/min}$$

Provide 600mm dia underground pipe (1:100) is OK


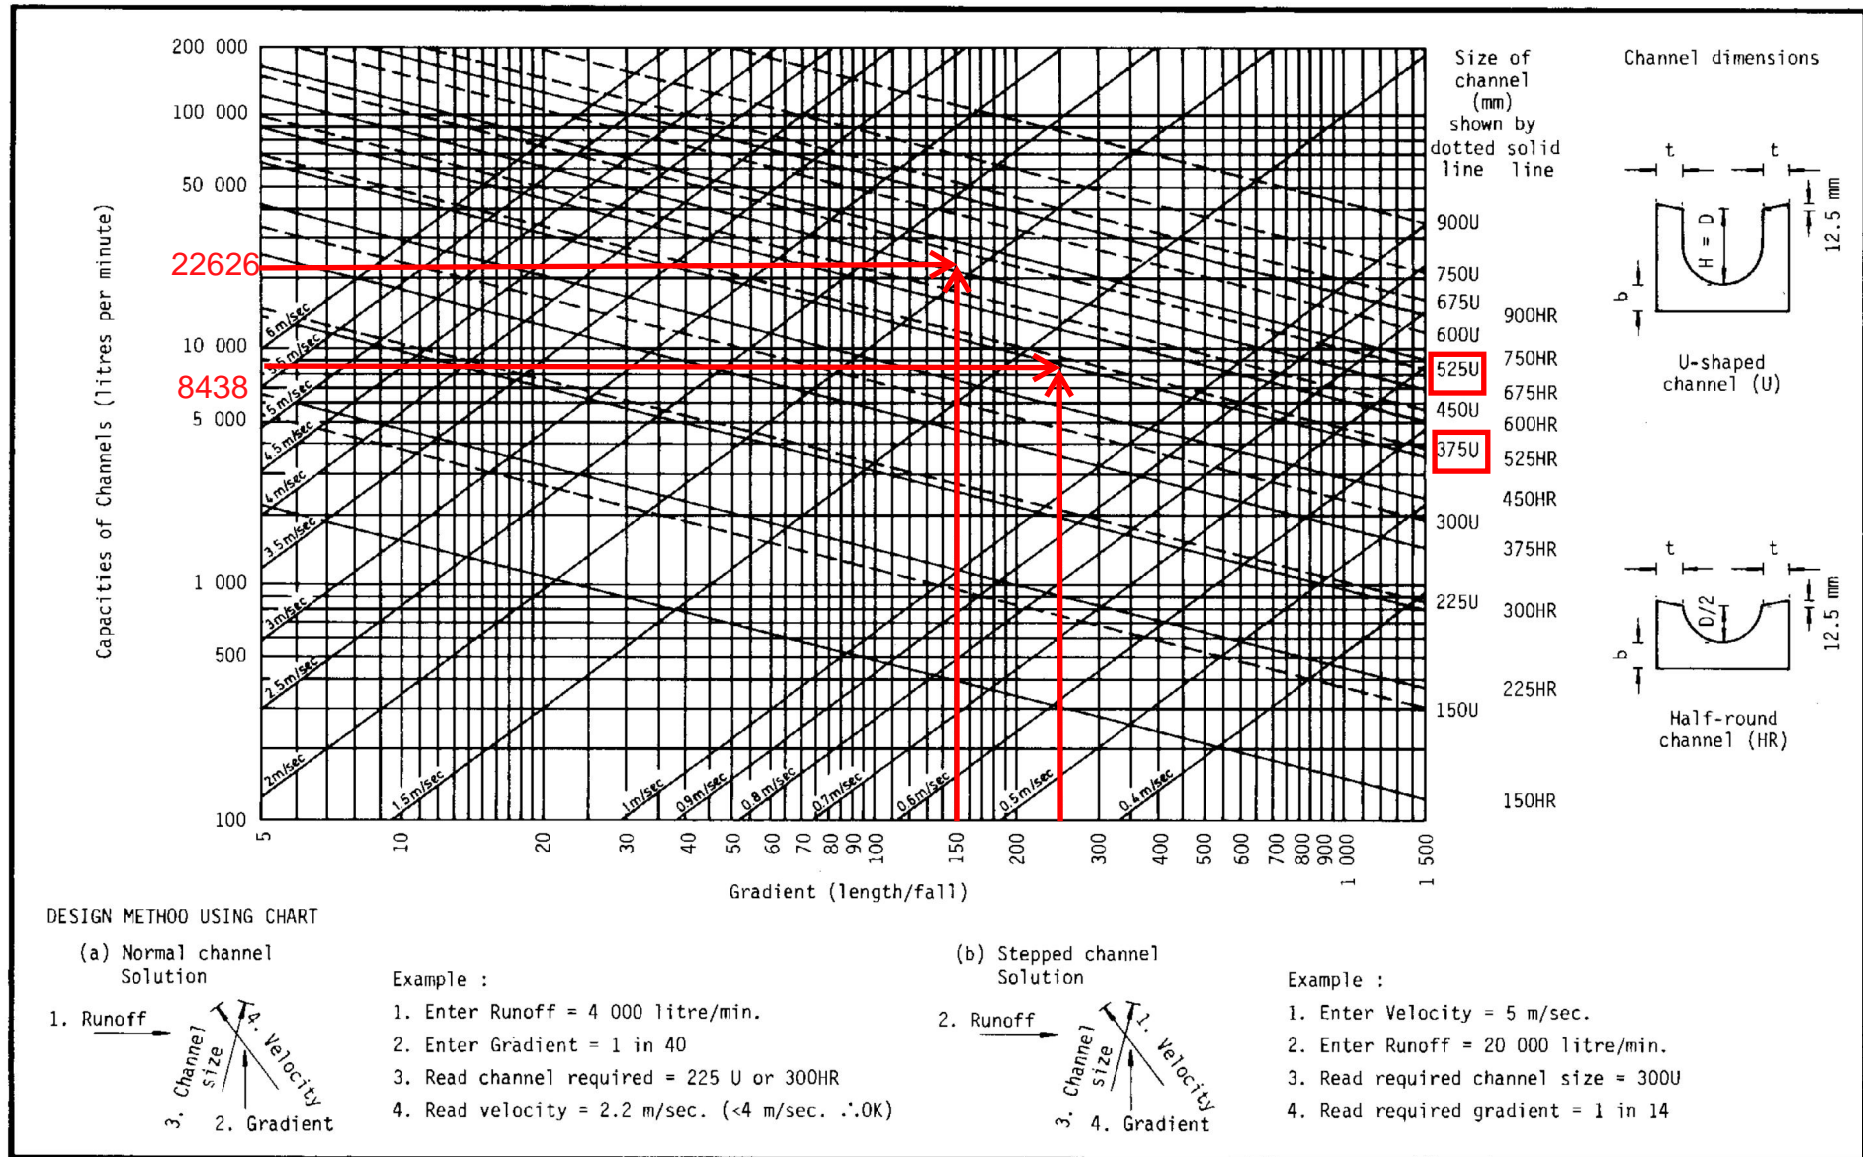


Figure 8.7 - Chart for the Rapid Design of Channels

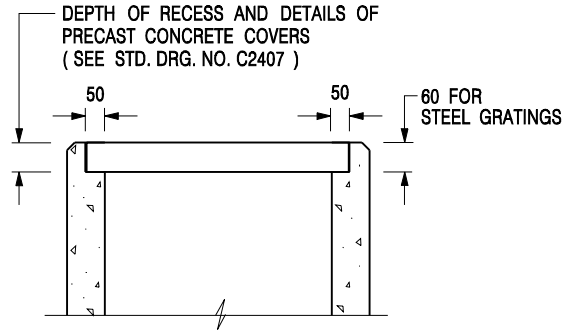


**ALTERNATIVE TOP SECTION
FOR PRECAST CONCRETE COVERS / GRATINGS**

NOTES:

1. ALL DIMENSIONS ARE IN MILLIMETRES.
2. ALL CONCRETE SHALL BE GRADE 20 /20.
3. CONCRETE SURFACE FINISH SHALL BE CLASS U2 OR F2 AS APPROPRIATE.
4. FOR DETAILS OF JOINT, REFER TO STD. DRG. NO. C2413.
5. CONCRETE TO BE COLOURED AS SPECIFIED.
6. UNLESS REQUESTED BY THE MAINTENANCE PARTY AND AS DIRECTED BY THE ENGINEER, CATCHPIT WITH TRAP IS NORMALLY NOT PREFERRED DUE TO PONDING PROBLEM.
7. UPON THE REQUEST FROM MAINTENANCE PARTY, DRAIN PIPES AT CATCHPIT BASE CAN BE USED BUT THIS IS FOR CATCHPITS LOCATED AT SLOPE TOE ONLY AND AS DIRECTED BY THE ENGINEER.
8. FOR CATCHPITS CONSTRUCTED ON OR ADJACENT TO A FOOTPATH, STEEL GRATINGS (SEE DETAIL 'A' ON STD. DRG. NO. C2405) OR CONCRETE COVERS (SEE STD. DRG. NO. C2407) SHALL BE PROVIDED AS DIRECTED BY THE ENGINEER.
9. IF INSTRUCTED BY THE ENGINEER, HANDRAILING (SEE DETAIL 'G' ON STD. DRG. NO. C2405; EXCEPT ON THE UPSLOPE SIDE) IN LIEU OF STEEL GRATINGS OR CONCRETE COVERS CAN BE ACCEPTED AS AN ALTERNATIVE SAFETY MEASURE FOR CATCHPITS NOT ON A FOOTPATH NOR ADJACENT TO IT. TOP OF THE HANDRAILING SHALL BE 1 000 mm MIN. MEASURED FROM THE ADJACENT GROUND LEVEL.
10. MINIMUM INTERNAL CATCHPIT WIDTH SHALL BE 1 000 mm FOR CATCHPITS WITH A HEIGHT EXCEEDING 1 000 mm MEASURED FROM THE INVERT LEVEL TO THE ADJACENT GROUND LEVEL. AND, STEP IRONS (SEE DSD STD. DRG. NO. DS1043) AT 300 c/c STAGGERED SHALL BE PROVIDED. THICKNESS OF CATCHPIT WALL FOR INSTALLATION OF STEP IRONS SHALL BE INCREASED TO 150 mm.
11. FOR RETROFITTING AN EXISTING CATCHPIT WITH STEEL GRATING, SEE DETAIL 'F' ON STD. DRG. NO. C2405.
12. SUBJECT TO THE APPROVAL OF THE ENGINEER, OTHER MATERIALS CAN ALSO BE USED AS COVERS / GRATINGS.

-	FORMER DRG. NO. C2406J.	Original Signed	03.2015
REF.	REVISION	SIGNATURE	DATE

**CATCHPIT WITH TRAP
(SHEET 2 OF 2)**

 CIVIL ENGINEERING AND DEVELOPMENT DEPARTMENT	
SCALE 1 : 20	DRAWING NO.
DATE JAN 1991	C2406 /2


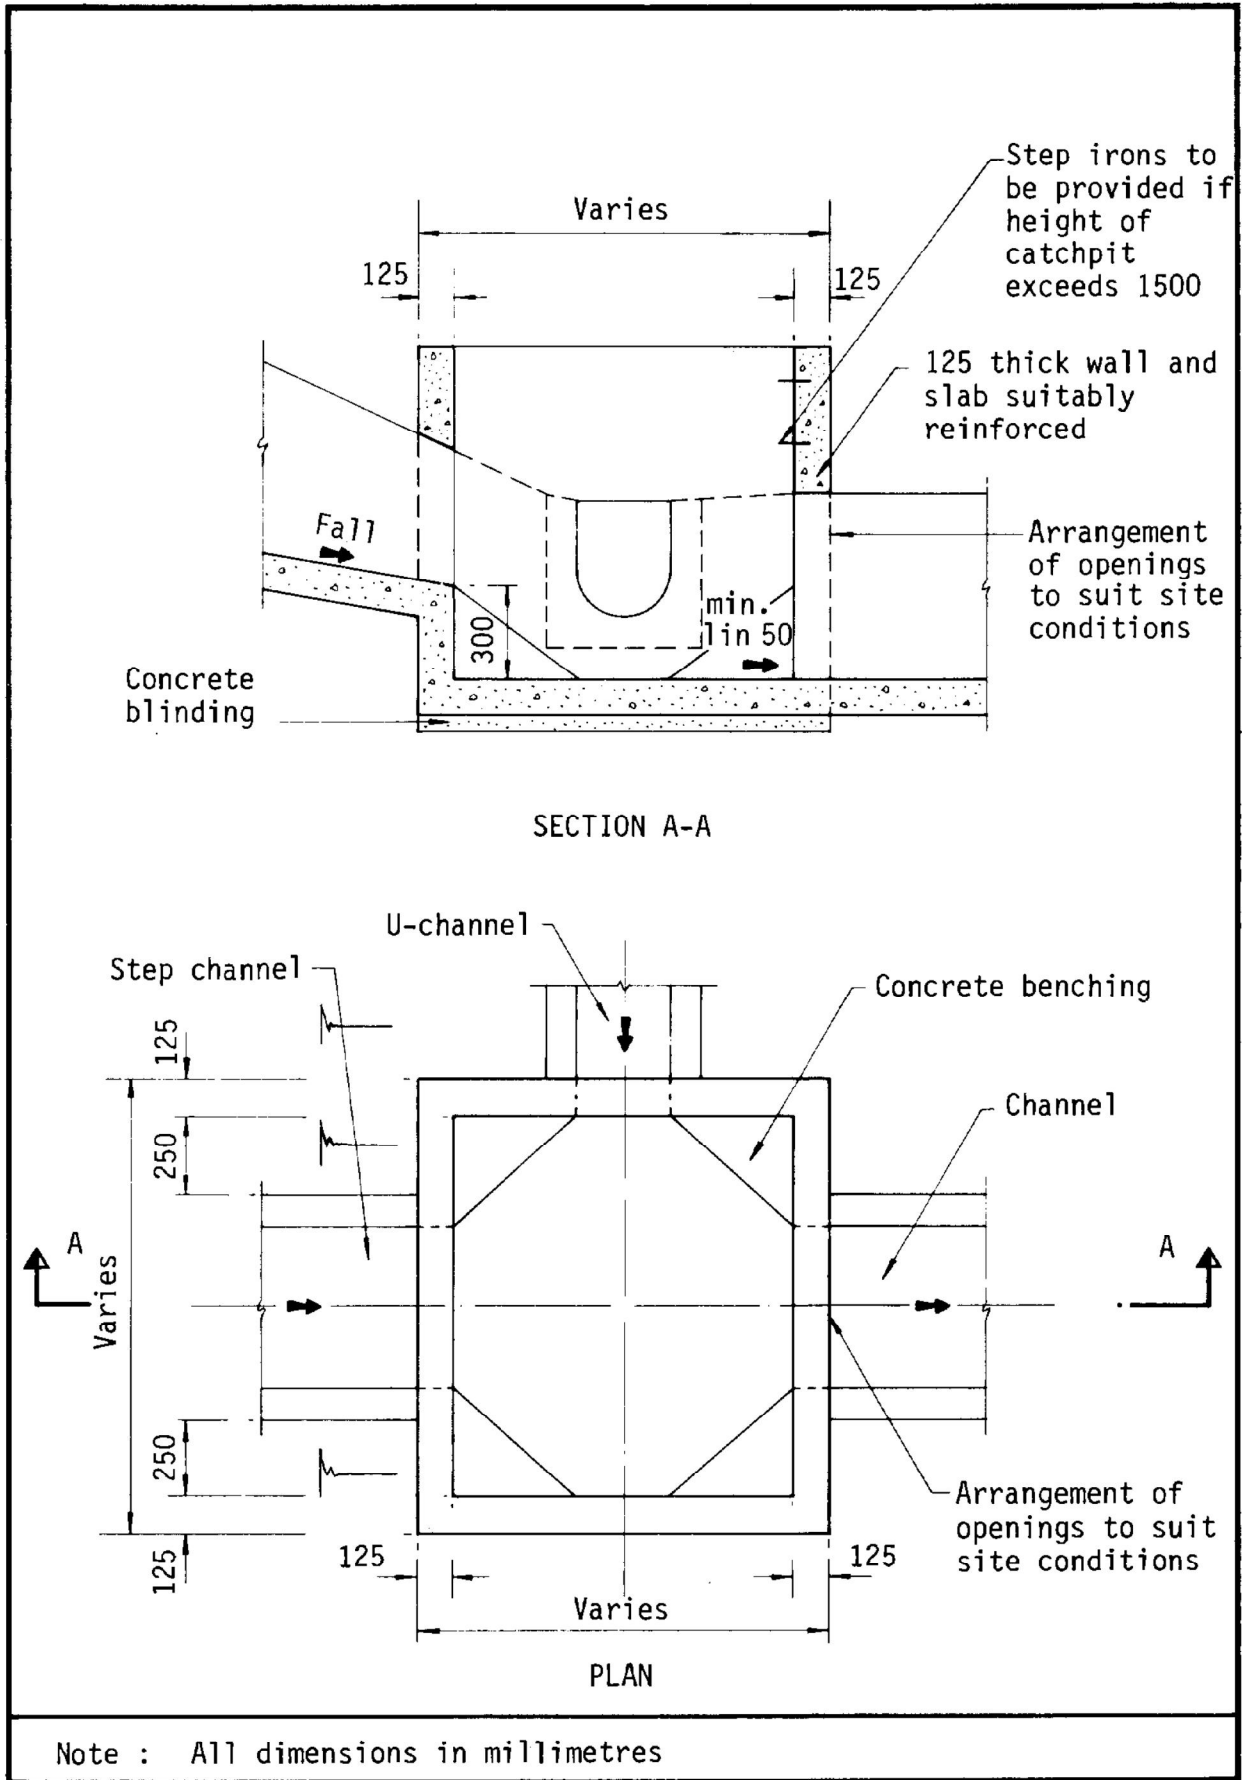


Figure 8.10 - Typical Details of Catchpits

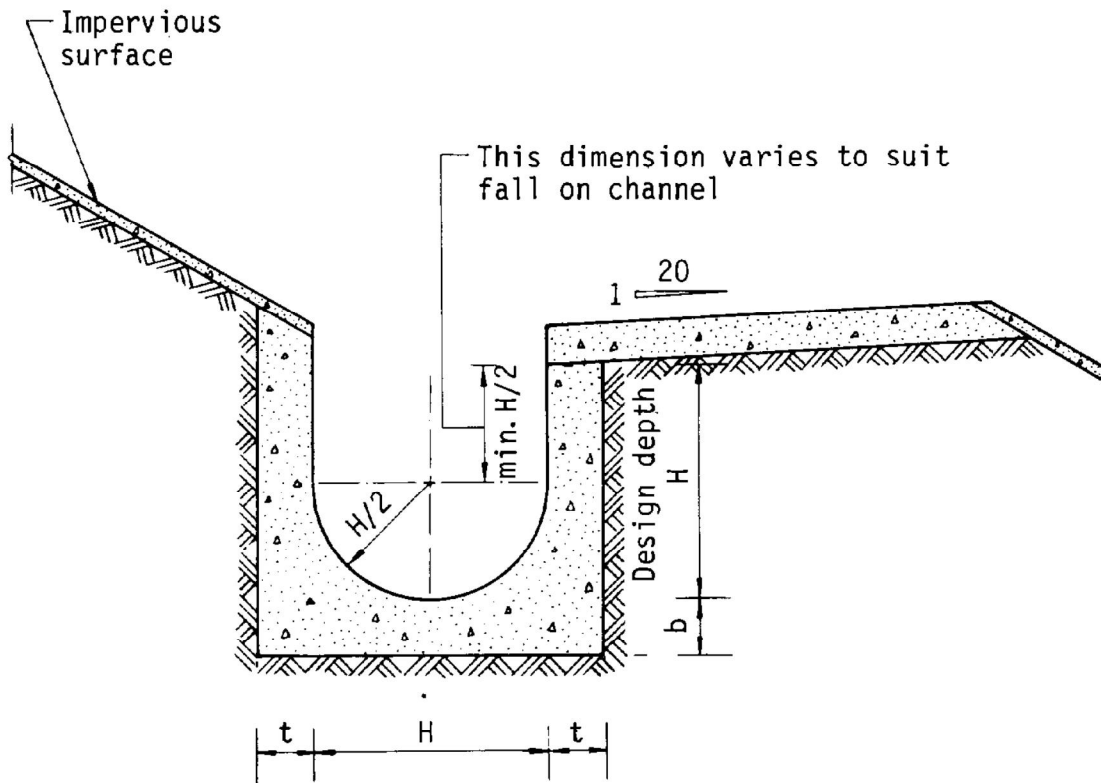

Dimensions of U - channel

Nominal size of channel H (mm)	Thickness t (mm)	Thickness b (mm)
225 to 600	150	150
675 to 1200	175	225

Figure 8.11 - Typical U-channel Details


Appendix II
Revised Drainage Proposal

舊李屋村
Kau Lee
Uk-Tsuen

露天貨倉
Open Storage

申請地點
Application Site

- NOTE:**
1. The surrounding area of the site has its own stormwater collection system.
 2. Catchpit (CP15) with desilting facility shall follow CEDD standard drawing No. C2406I, which act as silt trap.
 3. Catchpit and UC follows Typical Details of Geotechnical Manual for Slope Fig.8.10 and Fig.8.11 respectively.
 4. All UCs are covered by cast iron grating

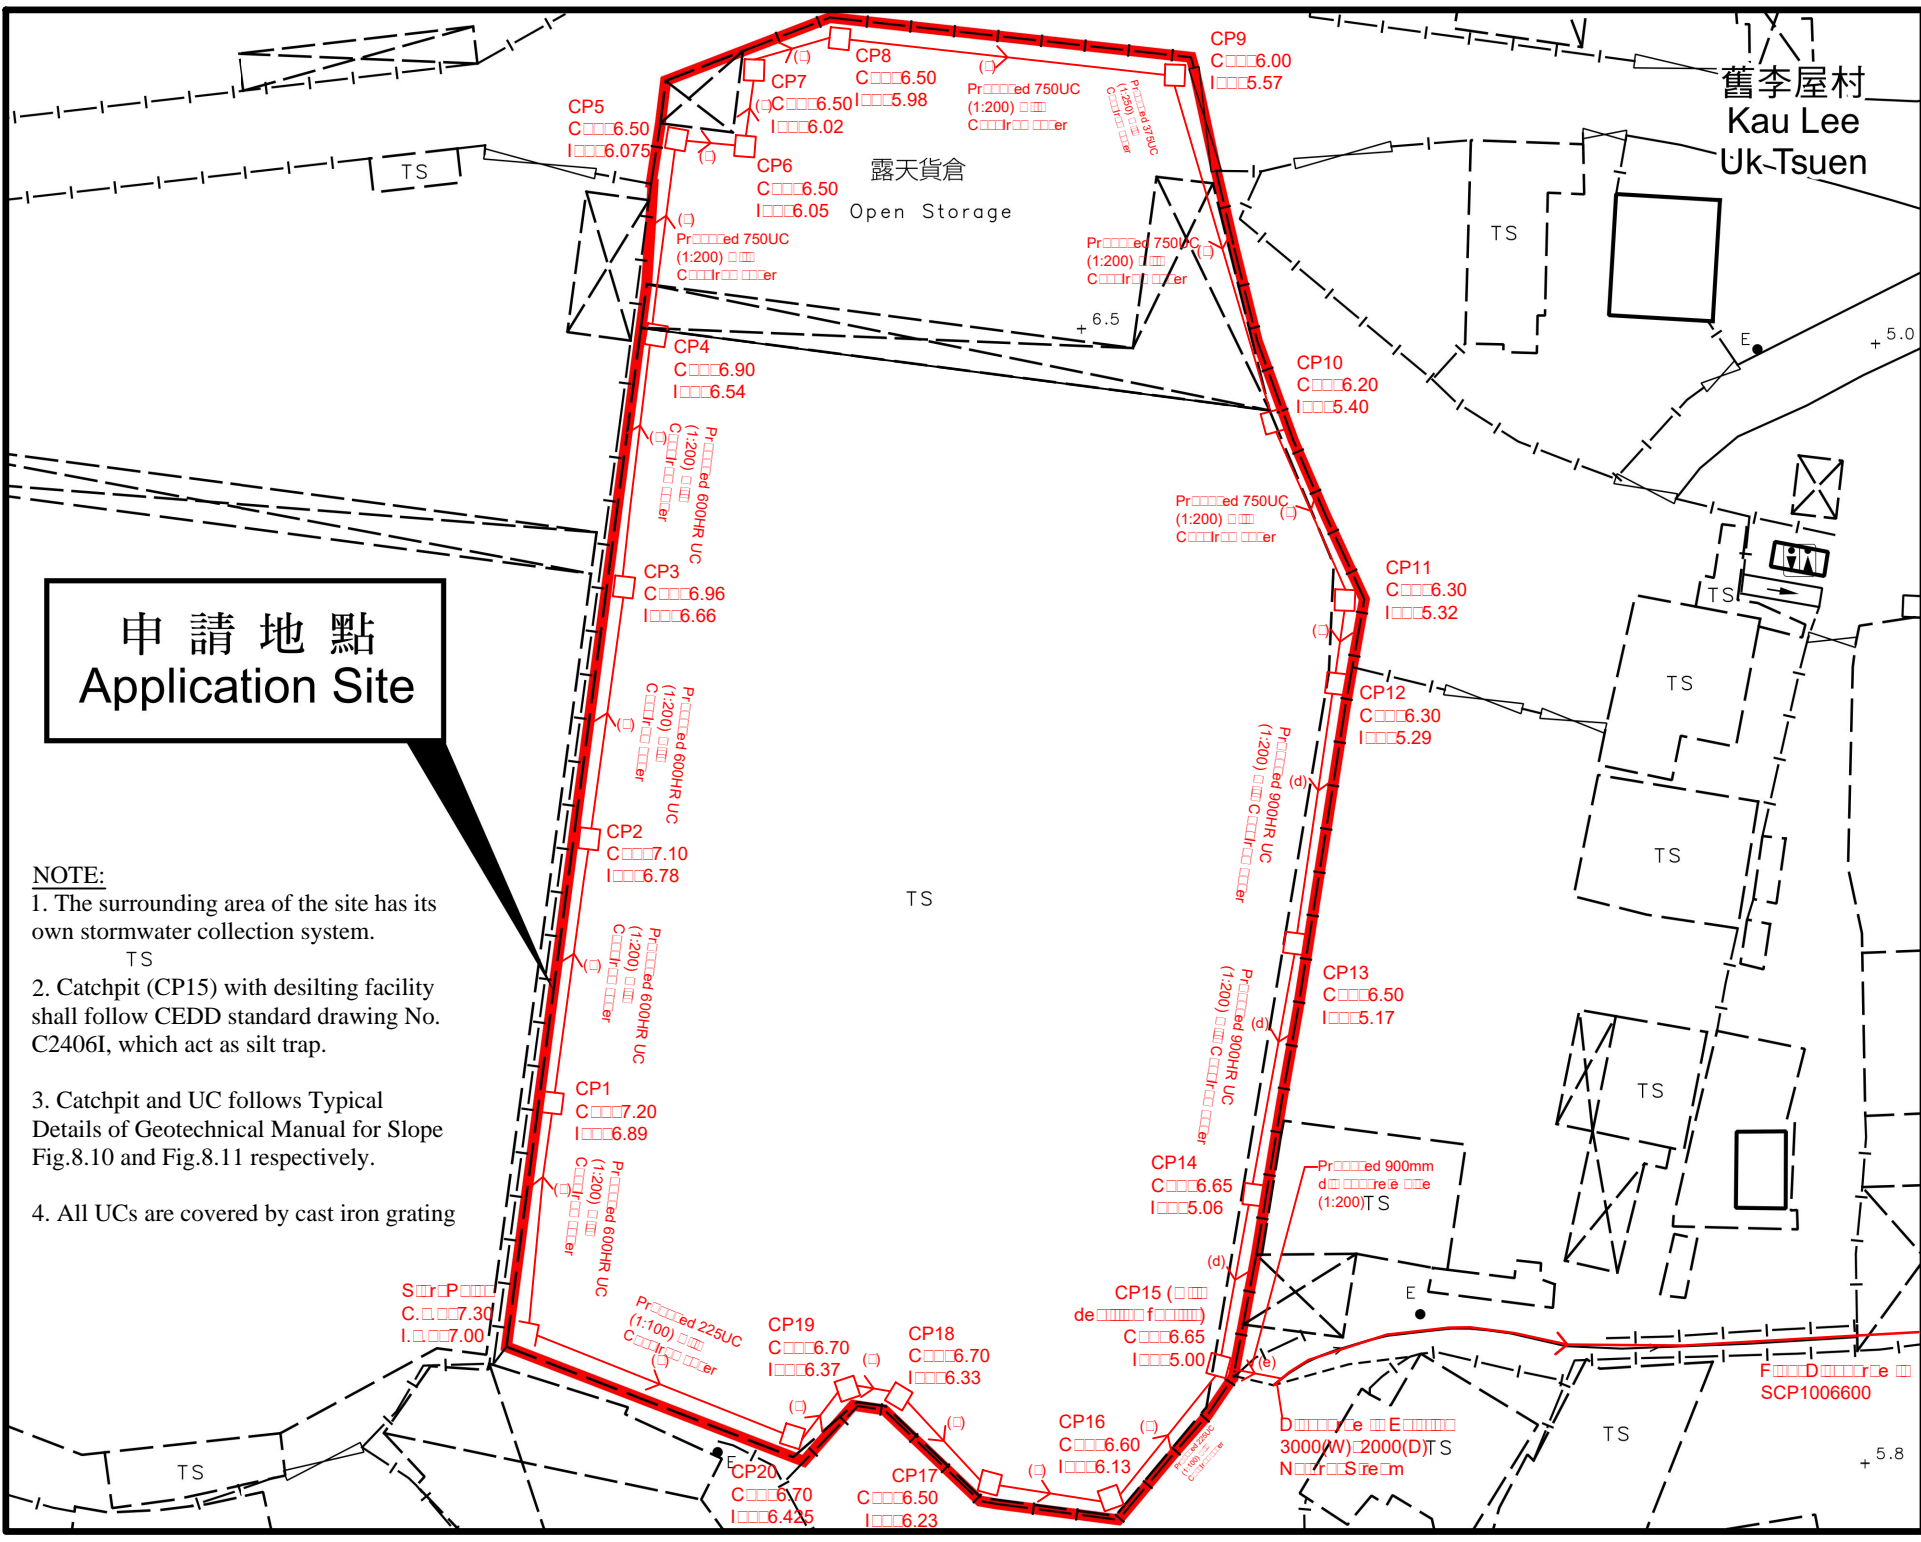

LEGEND

(a)	Pre-cast 225UC (1:100)
(b)	Pre-cast 600 HR UC (1:200)
(c)	Pre-cast 750 HR UC (1:200)
(d)	Pre-cast 900 HR UC (1:200)
(e)	Pre-cast 900 mm diameter
□	Pre-cast Channel

正宏工程顧問公司
Ching Wan Engineering
Consultants Company

PROJECT:

Pre-cast Tem...
W... (E...)
D... G...
G... A...
F... for P... of
3... 25
(P... 26 (P... 27
(P... 28 (P... 29 30
31 32 (P... 33 (P...
34 (P... 36 (P... 70
(P... 76 (P... 77
(P... 78 S.A (P... 80
(P... 82 (P...
D.D. 124 Ad...
G... H...
T... Ne...
Terr...ie

TITLE:

Dr... Pr...

File:

DWG NO.


Scale:

HS-424:D01

Date:

16/8/2024

S Area 9293 m²
 B1 Area 7163 m²

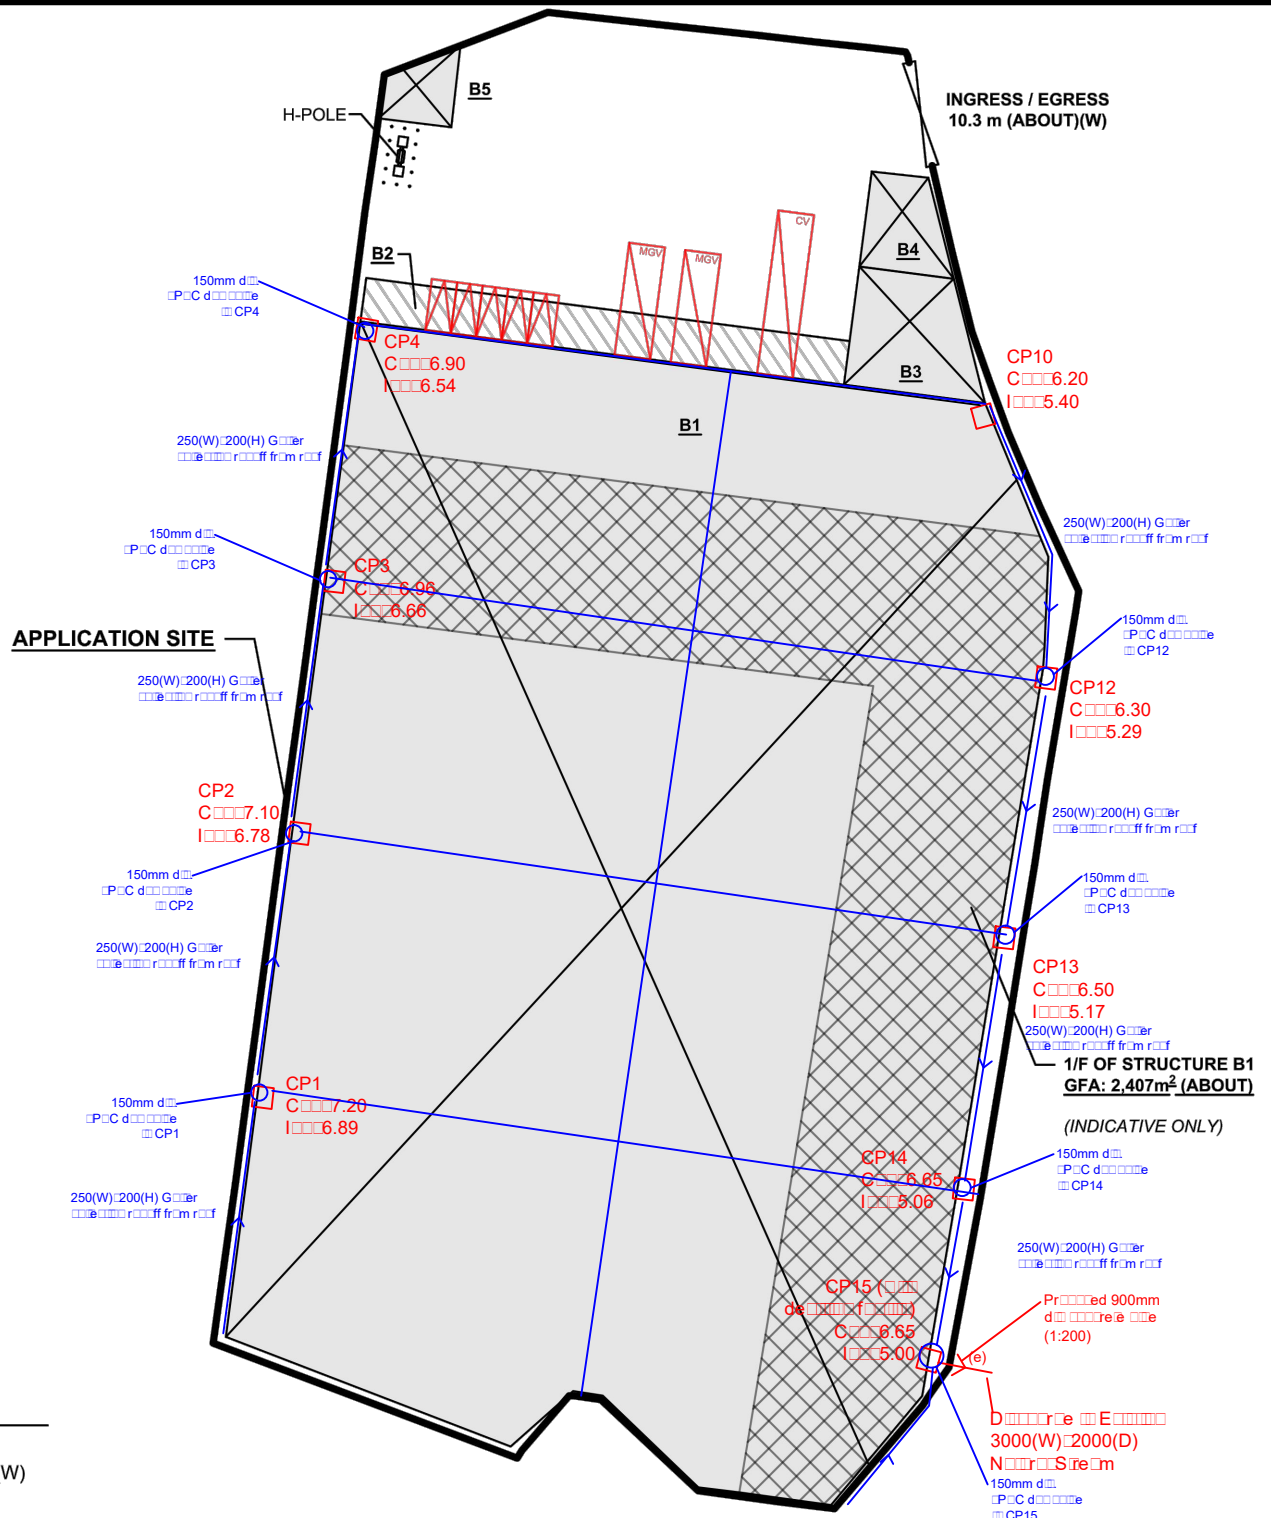

Company
 正宏工程顧問公司
 Ching Wan Engineering
 Consultants Company

PROJECT:
 Proposed Temporary
 Warehouse (Erection and
 Dismantling) of
 Girders for Period of
 3 Months from 25
 (Part) 26 (Part) 27
 (Part) 28 (Part) 29 30
 31 32 (Part) 33 (Part)
 34 (Part) 36 (Part) 70
 (Part) 76 (Part) 77
 (Part) 78 S.A (Part) 80
 (Part) 82 (Part)
 D.D. 124 and Adm
 Girders and
 Temporary
 Terrace



TITLE:
 Column Plan

File:	DWG NO.
Scale:	HS424.D02

LEGEND

- APP
- STR
- STR

Date:
16/8/2024

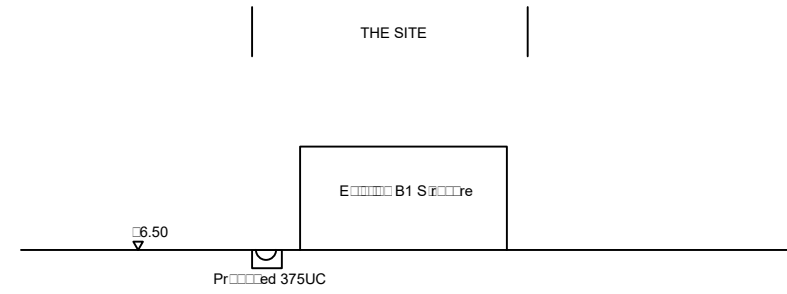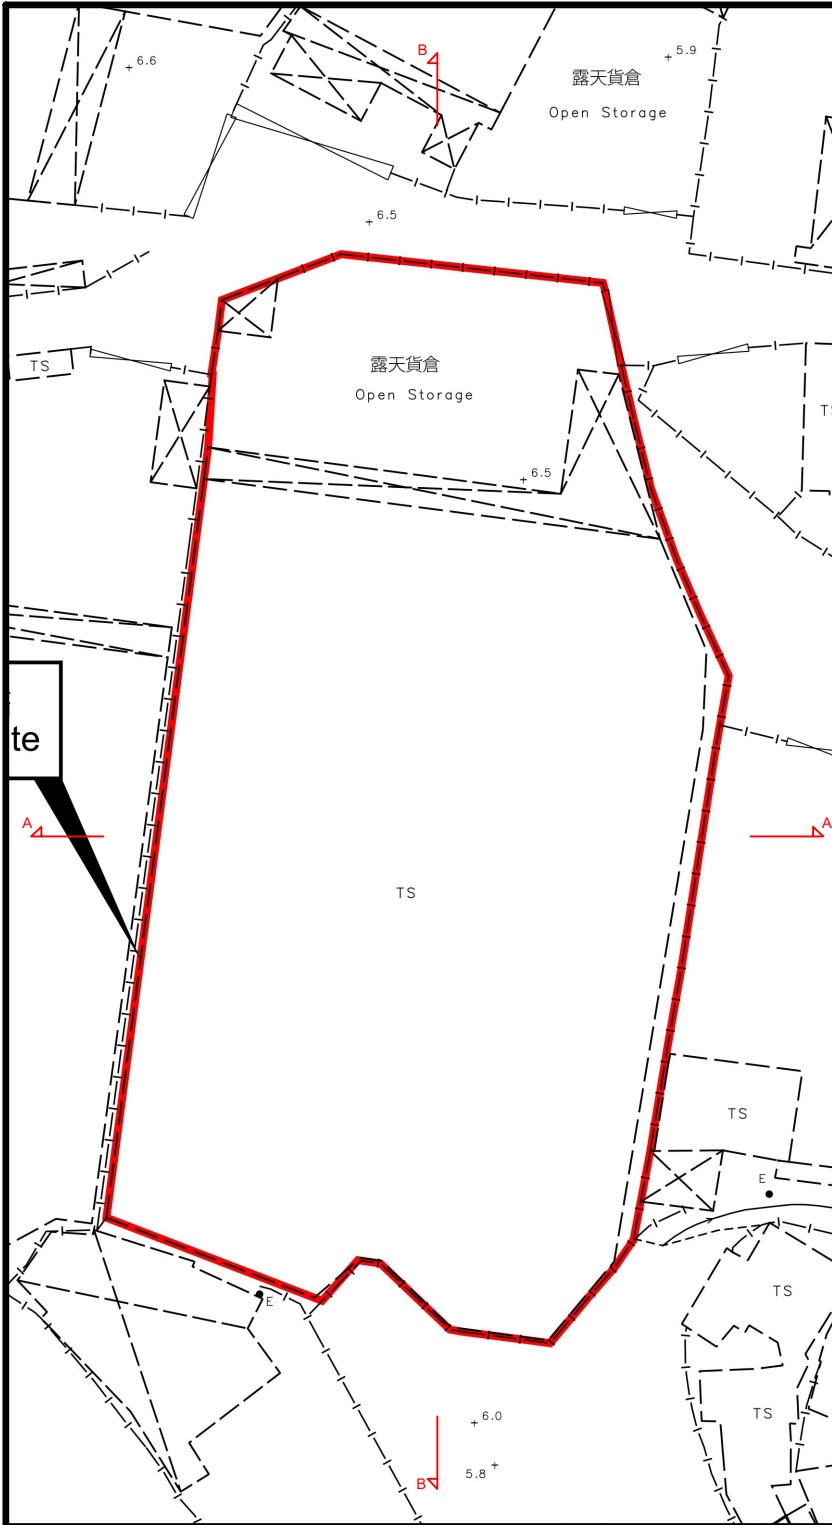


Company
 正宏工程顧問公司
 Ching Wan Engineering
 Consultants Company

PROJECT:
 Proposed Temporary
 3 years (2025
 (P)26 (P)27
 (P)28 (P)29 (P)30
 31 (P)32 (P)33 (P)34
 34 (P)36 (P)70
 (P)76 (P)77
 (P)78 S.A (P)80
 (P) 82 (P) 8
 D.D. 124 and Ad
 Gearing and H
 Trench and Ne
 Territory

TITLE:
SECTIONS

File:	DWG NO.
Scale:	HS424.D03
Date:	16/8/2024

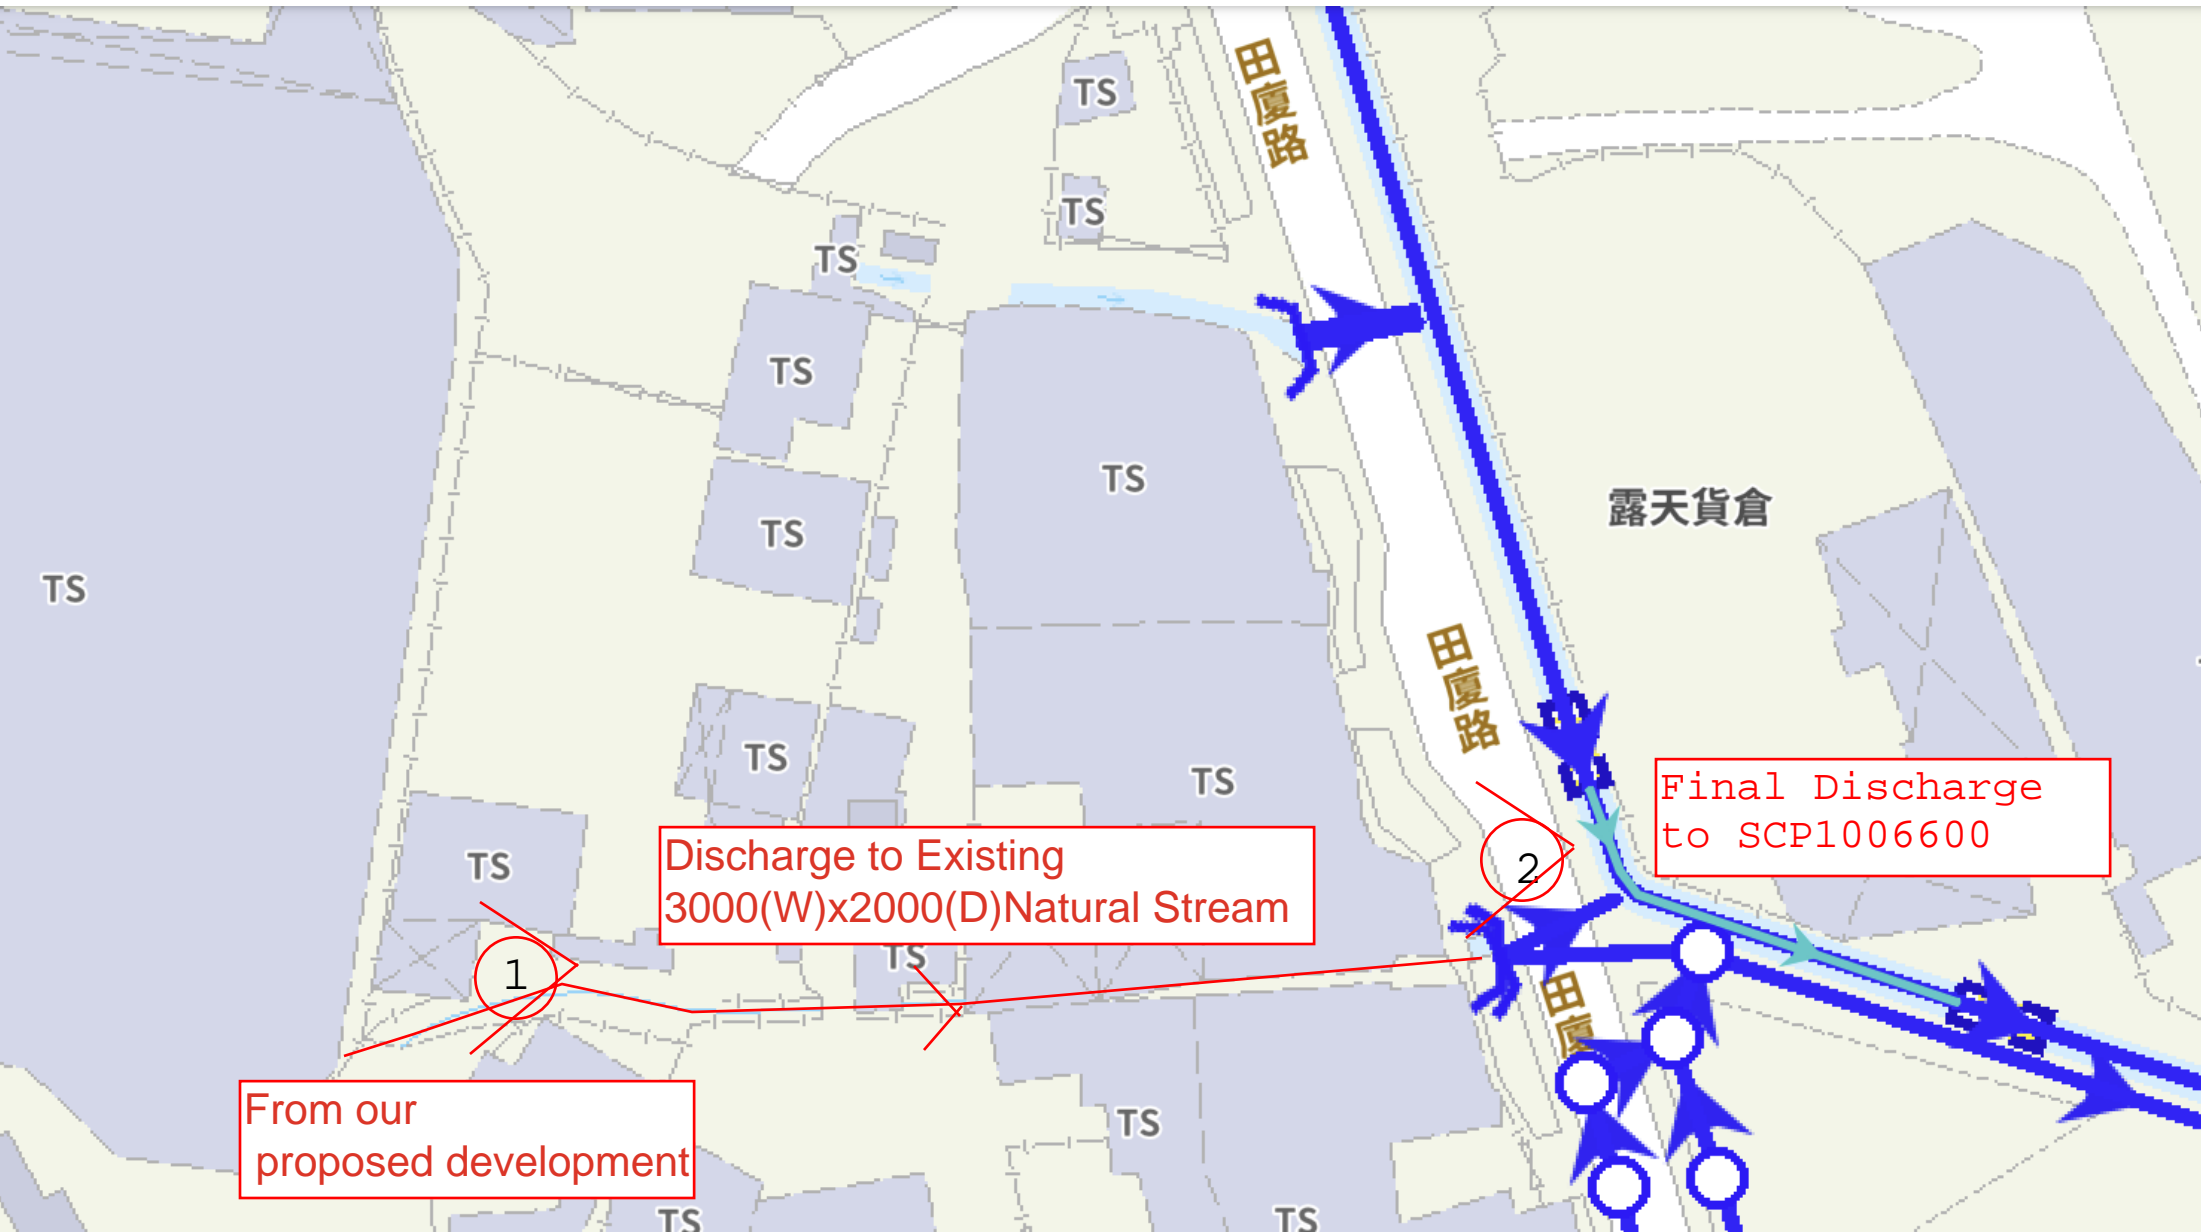

From our proposed development

Discharge to Existing 3000(W)x2000(D) Natural Stream

Final Discharge to SCP1006600



VIEW 1: Existing 3000(W)x2000(D)Natural Stream



VIEW 2: FINAL DISCHARGE POINT SCP1006600

Site Area = 9293 m²
Warehouse Area = 7163 m²

From Start Point to CP15

Provide nominal 225UC (1:100) is Ok

From Start Point to CP4

Collect 3/8 warehouse catchment area

Calculation of Runoff from the Proposed Development

$$\begin{aligned} Q &= 0.278 C i A \\ C &= 0.95 && \text{(P.42 of Stormwater Drainage Manual)} \\ A &= 2686.125 \text{ m}^2 \\ &= 0.0026861 \text{ km}^2 \\ \text{take } i &= 250 \text{ mm/hr} \\ \text{Therefore, } Q &= 0.278 * 0.95 * 250 * 0.0026861 \\ &= 0.177 \text{ m}^3/\text{sec} \\ &= 10641 \text{ lit/min} \end{aligned}$$

Provide 600HR UC (1:200) is Ok

From CP4 to CP12

Collect 4/8 warehouse catchment area + vacant area (9293-7163)

Calculation of Runoff from the Proposed Development

$$\begin{aligned} Q &= 0.278 C i A \\ C &= 0.95 && \text{(P.42 of Stormwater Drainage Manual)} \\ A &= 5711.5 \text{ m}^2 \\ &= 0.0057115 \text{ km}^2 \\ \text{take } i &= 250 \text{ mm/hr} \\ \text{Therefore, } Q &= 0.278 * 0.95 * 250 * 0.0057115 \\ &= 0.377 \text{ m}^3/\text{sec} \\ &= 22626 \text{ lit/min} \end{aligned}$$

Provide 750 HRUC (1:200) is Ok

From CP12 to CP15

Collect 7/8 warehouse catchment area + vacant area (9293-7163)

Calculation of Runoff from the Proposed Development

$$\begin{aligned} Q &= 0.278 C i A \\ C &= 0.95 && \text{(P.42 of Stormwater Drainage Manual)} \\ A &= 8397.625 \text{ m}^2 \\ &= 0.0083976 \text{ km}^2 \\ \text{take } i &= 250 \text{ mm/hr} \\ \text{Therefore, } Q &= 0.278 * 0.95 * 250 * 0.0083976 \\ &= 0.554 \text{ m}^3/\text{sec} \\ &= 33267 \text{ lit/min} \end{aligned}$$

Provide 900 HR UC (1:100) is Ok

Outfall

Catchment Area = Site Area

Calculation of Runoff from the Proposed Development

$$Q = 0.278 C i A$$

$$C = 0.95 \quad \text{(P.42 of Stormwater Drainage Manual)}$$

$$A = 9293 \quad \text{m}^2$$

$$= 0.009293 \quad \text{km}^2$$

take $i = 250 \quad \text{mm/hr}$

Therefore, $Q = 0.278 * 0.95 * 250 * 0.009293$

$$= 0.614 \quad \text{m}^3/\text{sec}$$

$$= \mathbf{36814} \quad \text{lit/min}$$

Calculation Maximum Capacity of Proposed 900mm dia. Underground pipe.

Manning Equation $V = R^{2/3} * S_f^{0.5} / n$

where $R = \frac{\pi r^2}{2 \pi r} \quad \text{dia} = 900 \text{ mm}$

$$= r/2 \quad r = 0.45 \text{ m}$$

$$= 0.225 \quad \text{m}$$

$n = 0.012 \quad \text{s/m}^{1/3} \quad \text{(Table 13 of Stormwater Drainage Manual)}$

1/ 200 $S_f = 0.005$

Therefore, $V = \frac{0.225^{2/3} * 0.005^{0.5}}{0.012}$

$$= 2.180 \quad \text{m/sec}$$

Maximum Capacity (Q_{max}) $= V * A$

$$= 2.18 * \pi r^2$$

$$= 1.387 \quad \text{m}^3/\text{sec}$$

1 nos of pipe $= 1.387 \quad \text{m}^3/\text{sec}$

$$= 83205 \quad \text{lit/min}$$

$$> 36814 \quad \text{lit/min}$$

Provide 900mm dia underground pipe (1:100) is OK

Calculation Maximum Capacity of Proposed 250(W)x200(D) Gutter

Manning Equation $V = R^{2/3} * S_f^{0.5} / n$

where $R = \frac{W * D}{(2D + W)} \quad W = 0.25 \text{ m}$

$$= 0.077 \quad D = 0.2 \text{ m}$$

$n = 0.012 \quad \text{s/m}^{1/3} \quad \text{(Table 13 of Stormwater Drainage Manual)}$

1/ 100 $S_f = 0.0100$

Therefore, $V = \frac{0.077^{2/3} * 0.01^{0.5}}{0.012}$

$$= 1.507 \quad \text{m/sec}$$

Maximum Capacity (Q_{max}) $= V * A$

$$= 1.507 * 0.25 * 0.2$$

$$= 0.075 \quad \text{m}^3/\text{sec}$$

1 nos of Gutter $= 0.075 \quad \text{m}^3/\text{sec}$

$$= 4522 \quad \text{lit/min}$$

$$> \#REF! \quad \text{lit/min}$$

Provide 250(W)x200(D) Gutter (1:100) is OK



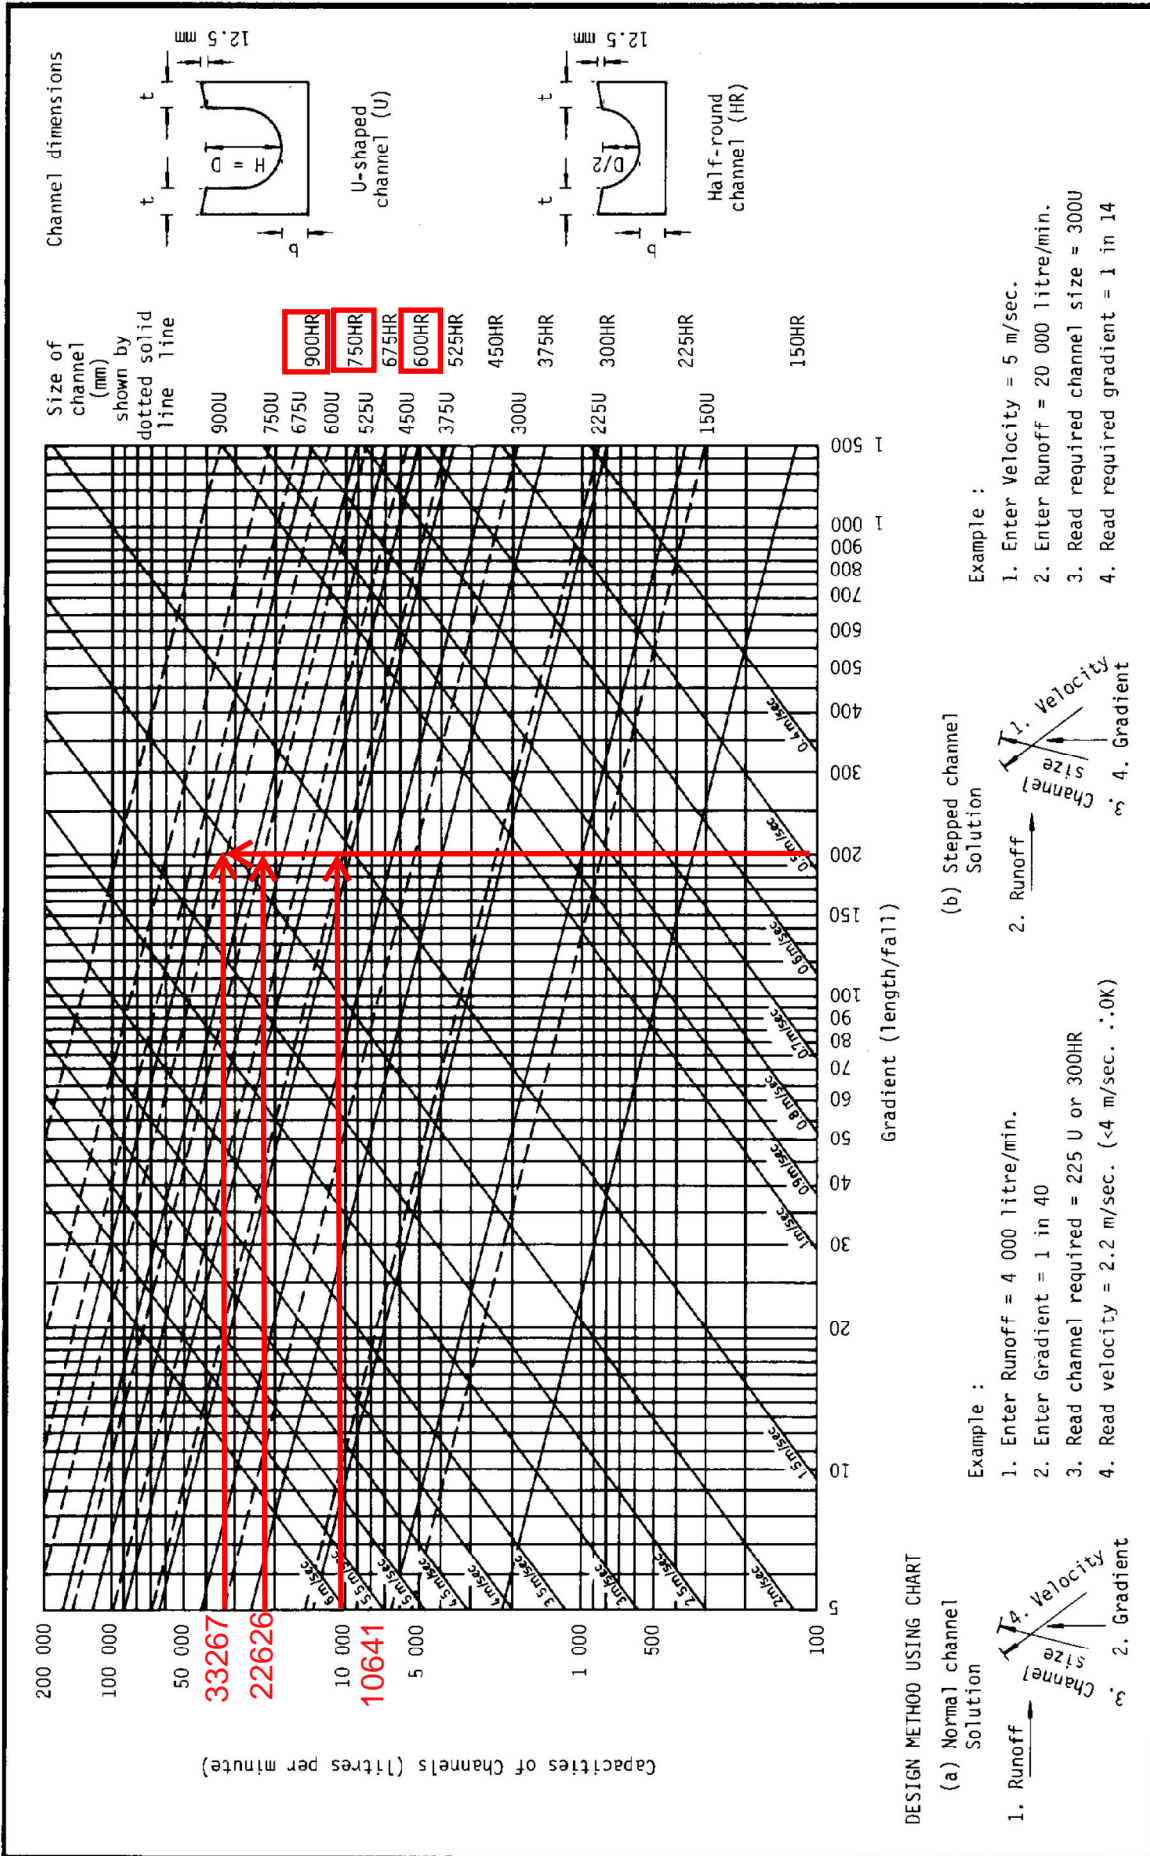


Figure 8.7 - Chart for the Rapid Design of Channels

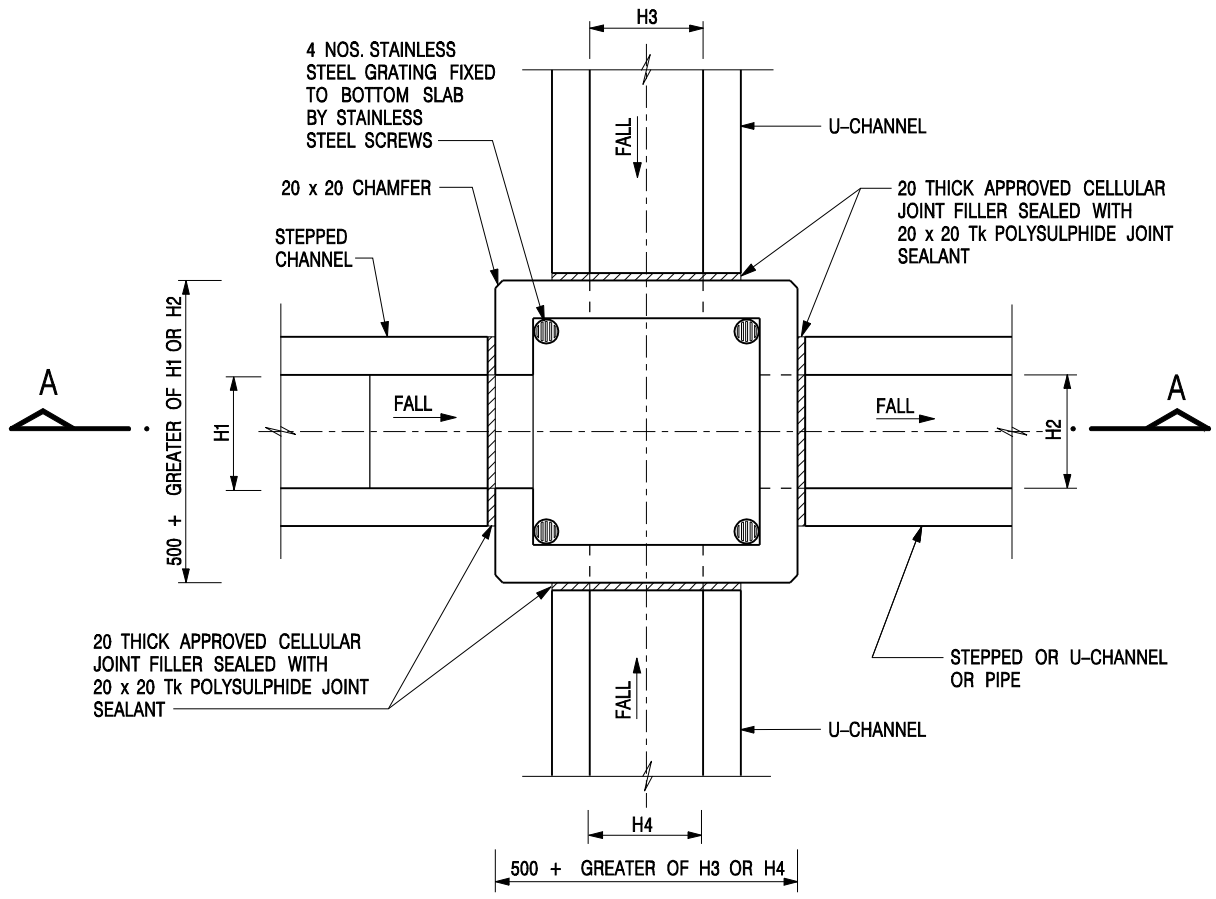

NOMINAL SIZE (LARGEST OF H1, H2, H3 & H4)	B
300 - 600	150
675 - 900	175

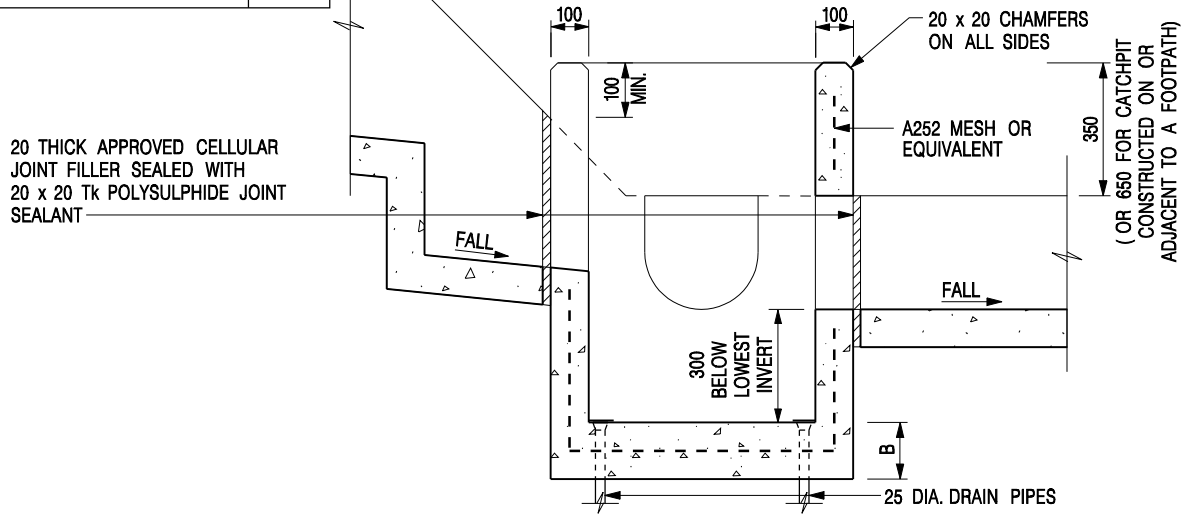


- NOTES:**
1. ALL DIMENSIONS ARE IN MILLIMETRES.
 2. REFER TO SHEET 2 FOR OTHER NOTES.

-	FORMER DRG. NO. C2406J.	Original Signed	03.2015
REF.	REVISION	SIGNATURE	DATE

CATCHPIT WITH TRAP
(SHEET 1 OF 2)

CEDD **CIVIL ENGINEERING AND DEVELOPMENT DEPARTMENT**

SCALE 1 : 20 **DRAWING NO.** C2406 /1
DATE JAN 1991

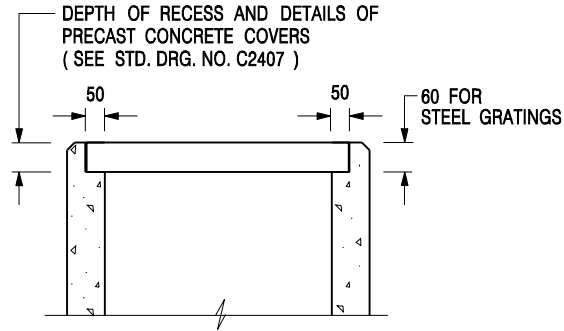


**ALTERNATIVE TOP SECTION
FOR PRECAST CONCRETE COVERS / GRATINGS**

NOTES:

1. ALL DIMENSIONS ARE IN MILLIMETRES.
2. ALL CONCRETE SHALL BE GRADE 20 /20.
3. CONCRETE SURFACE FINISH SHALL BE CLASS U2 OR F2 AS APPROPRIATE.
4. FOR DETAILS OF JOINT, REFER TO STD. DRG. NO. C2413.
5. CONCRETE TO BE COLOURED AS SPECIFIED.
6. UNLESS REQUESTED BY THE MAINTENANCE PARTY AND AS DIRECTED BY THE ENGINEER, CATCHPIT WITH TRAP IS NORMALLY NOT PREFERRED DUE TO PONDING PROBLEM.
7. UPON THE REQUEST FROM MAINTENANCE PARTY, DRAIN PIPES AT CATCHPIT BASE CAN BE USED BUT THIS IS FOR CATCHPITS LOCATED AT SLOPE TOE ONLY AND AS DIRECTED BY THE ENGINEER.
8. FOR CATCHPITS CONSTRUCTED ON OR ADJACENT TO A FOOTPATH, STEEL GRATINGS (SEE DETAIL 'A' ON STD. DRG. NO. C2405) OR CONCRETE COVERS (SEE STD. DRG. NO. C2407) SHALL BE PROVIDED AS DIRECTED BY THE ENGINEER.
9. IF INSTRUCTED BY THE ENGINEER, HANDRAILING (SEE DETAIL 'G' ON STD. DRG. NO. C2405; EXCEPT ON THE UPSLOPE SIDE) IN LIEU OF STEEL GRATINGS OR CONCRETE COVERS CAN BE ACCEPTED AS AN ALTERNATIVE SAFETY MEASURE FOR CATCHPITS NOT ON A FOOTPATH NOR ADJACENT TO IT. TOP OF THE HANDRAILING SHALL BE 1 000 mm MIN. MEASURED FROM THE ADJACENT GROUND LEVEL.
10. MINIMUM INTERNAL CATCHPIT WIDTH SHALL BE 1 000 mm FOR CATCHPITS WITH A HEIGHT EXCEEDING 1 000 mm MEASURED FROM THE INVERT LEVEL TO THE ADJACENT GROUND LEVEL. AND, STEP IRONS (SEE DSD STD. DRG. NO. DS1043) AT 300 c/c STAGGERED SHALL BE PROVIDED. THICKNESS OF CATCHPIT WALL FOR INSTALLATION OF STEP IRONS SHALL BE INCREASED TO 150 mm.
11. FOR RETROFITTING AN EXISTING CATCHPIT WITH STEEL GRATING, SEE DETAIL 'F' ON STD. DRG. NO. C2405.
12. SUBJECT TO THE APPROVAL OF THE ENGINEER, OTHER MATERIALS CAN ALSO BE USED AS COVERS / GRATINGS.

-	FORMER DRG. NO. C2406J.	Original Signed	03.2015
REF.	REVISION	SIGNATURE	DATE

**CATCHPIT WITH TRAP
(SHEET 2 OF 2)**

 CIVIL ENGINEERING AND DEVELOPMENT DEPARTMENT	
SCALE 1 : 20	DRAWING NO.
DATE JAN 1991	C2406 /2


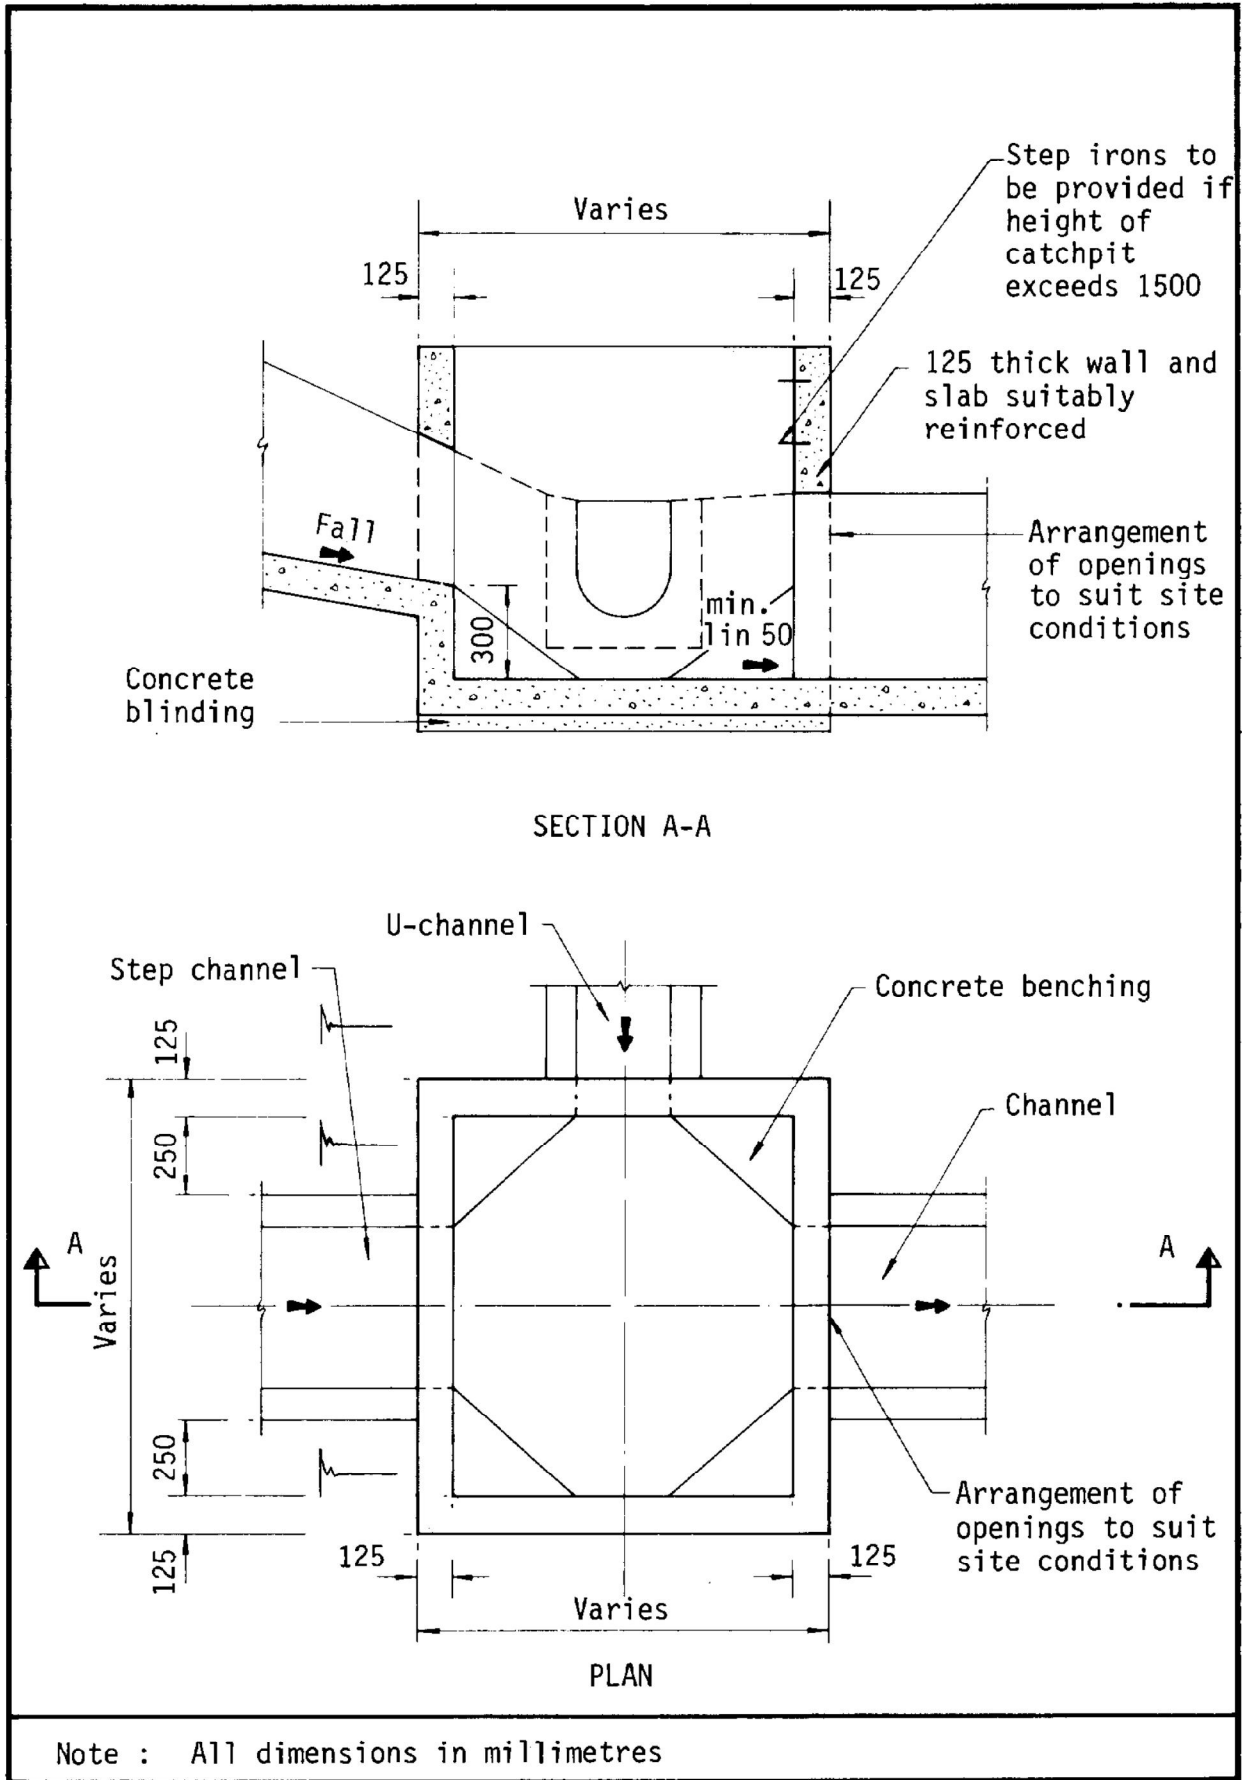


Figure 8.10 - Typical Details of Catchpits

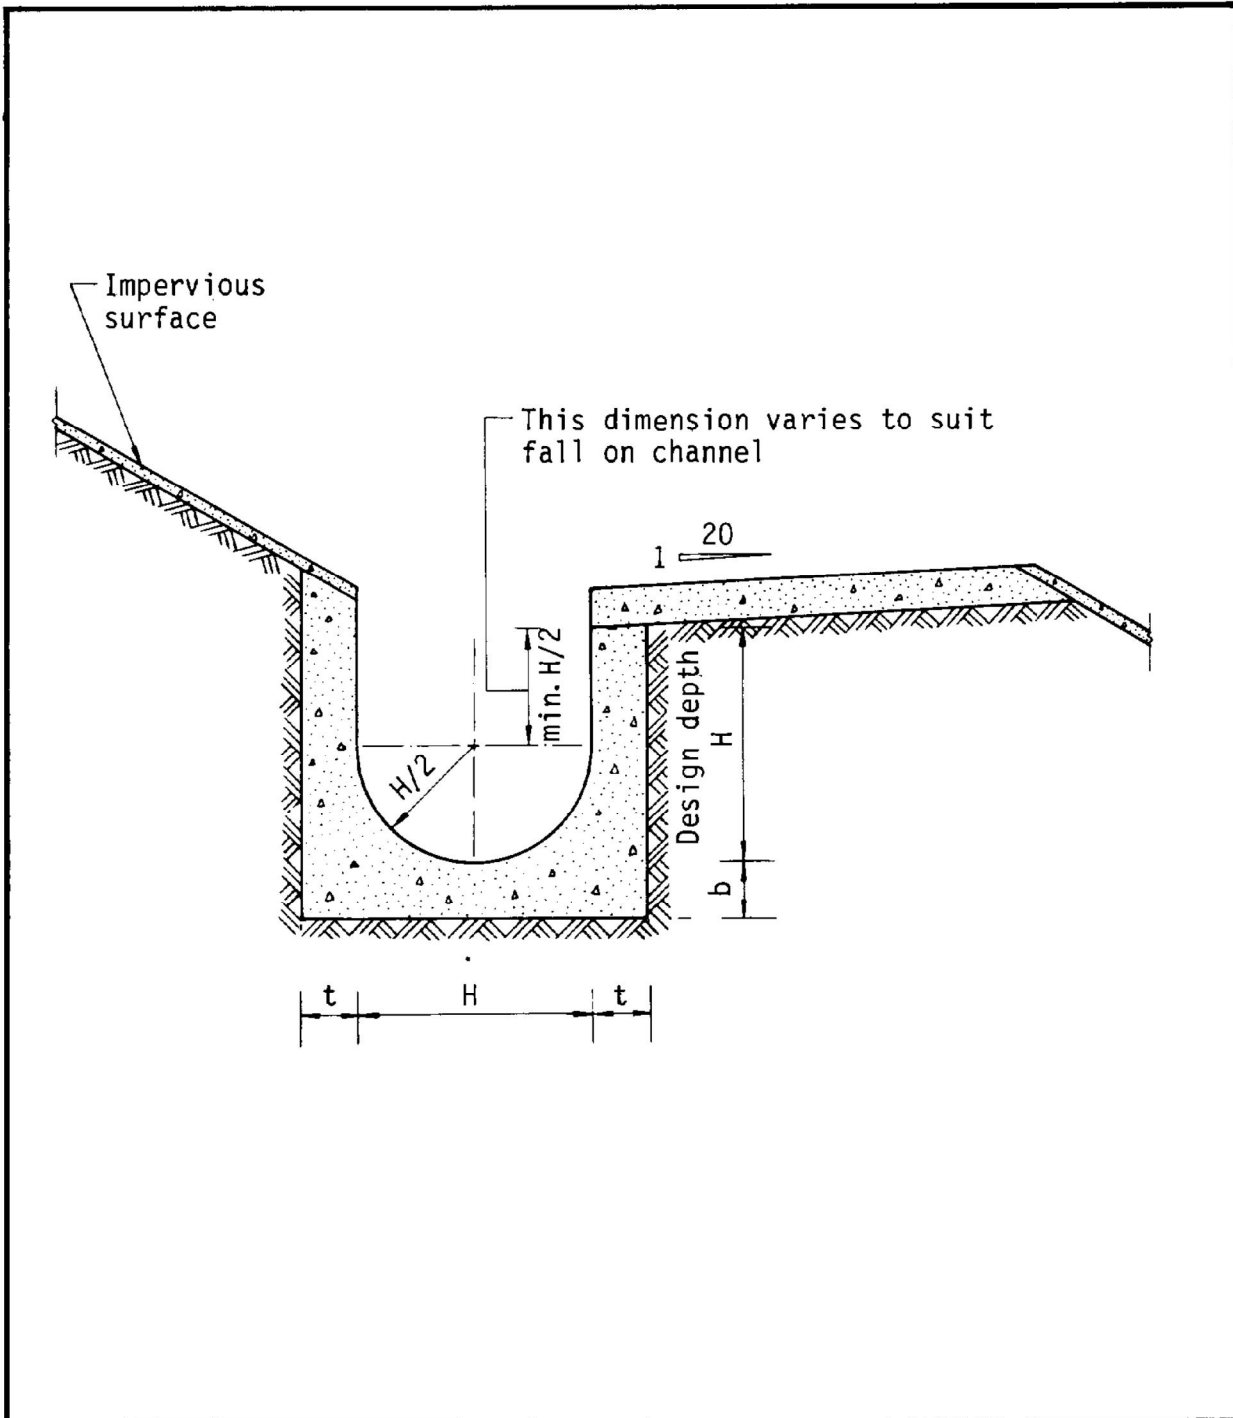

Dimensions of U - channel

Nominal size of channel H (mm)	Thickness t (mm)	Thickness b (mm)
225 to 600	150	150
675 to 1200	175	225

Figure 8.11 - Typical U-channel Details

Appendix III

The Accepted Fire Service Installations Proposal of the Previous Application No. A/HSK/424

規 劃 署


屯門及元朗西規劃處
香港新界沙田上禾輋路1號
沙田政府合署14樓

**By Fax (2323 3662) and Post****Planning Department**

Tuen Mun and Yuen Long West
District Planning Office
14/F, Sha Tin Government Offices,
1 Sheung Wo Che Road, Sha Tin,
N.T., Hong Kong

26 April 2024

來函檔號 Your Reference
本署檔號 Our Reference () in TPB/A/HSK/424
電話號碼 Tel. No.: 2158 6294
傳真機號碼 Fax No.: 2489 9711

 

Dear Sir/ Madam,

Compliance with Approval Condition (d)
Planning Application No. A/HSK/424

I refer to your submission dated 15.4.2024 regarding the submission of a fire service installations proposal for compliance with captioned approval condition. The relevant department has been consulted on your submission. Your submission is considered:

- Acceptable. The captioned condition has been complied with. Detailed departmental comments are at **Appendix I**.
- Acceptable. Since the captioned condition requires both the submission and implementation of the proposal, it has not been fully complied with. Please proceed to implement the accepted proposal for full compliance with the approval condition.
- Not acceptable. The captioned condition has not been complied with.

Should you have any queries on the departmental comments, please contact Mr. YUEN Tsz-fung (Tel: 2733 7781) of the Fire Services Department direct.

Yours faithfully,

(Ms. Charlotte LAM)
for District Planning Officer/
Tuen Mun and Yuen Long West
Planning Department

c.c.

D of FS (Attn: Mr. CHEUNG Wing Hei)

Internal

CTP/TPB2

Appendix I

A/HSK/424 – Compliance with Approval Condition (d)

Comments from the Fire Services Department:

- (i) Please be advised that the installation/maintenance/modification/repair work of Fire Service Installations shall be undertaken by a Registered Fire Service Installation Contractor (RFSIC). The RFSIC shall after completion of the installation/maintenance/modification/repair work issue to the person on whose instruction the work was undertaken a certificate (F.S. 251) and forward a copy of the certificate to the Director of Fire Services.

Our Ref. : DD124 Lot 25 & VL
Your Ref. : TPB/A/HSK/424

The Secretary
Town Planning Board
15/F, North Point Government office
333 Java Road
North Point, Hong Kong

By Email

15 April 2024

Dear Sir,

Compliance with Approval Condition (d)

Proposed Temporary Warehouse (Excluding Dangerous Goods Godown) with Ancillary Facilities for a Period of 3 Years in "Village Type Development" and "Open Space" Zone, Various Lots in D.D. 124 and Adjoining Government Land, Ha Tsuen, Yuen Long, New Territories

(S.16 Planning Application No. A/HSK/424)

We are writing to submit a revised fire service installations (FSIs) proposal for compliance with approval condition (d) of the subject application, i.e. *the submission of a FSIs proposal (Appendix I)*.

Should you require more information regarding the application, please contact our Ms. Ron LEUNG at (852) [REDACTED] or the undersigned at your convenience. Thank you for your kind attention.

Yours faithfully,

For and on behalf of
R-riches Property Consultants Limited




Matthew NG
Planning and Development Manager

F.S.NOTES:

1. GENERAL
 - 1.1 FIRE SERVICE INSTALLATIONS SHALL BE PROVIDED IN ACCORDANCE WITH THE CODES OF PRACTICE FOR MINIMUM FIRE SERVICE INSTALLATIONS AND EQUIPMENT AND INSPECTION, TESTING AND MAINTENANCE OF INSTALLATIONS AND EQUIPMENT 2022 (COP 2022), FSD CIRCULAR LETTERS AND THE HONG KONG WATERWORKS STANDARD REQUIREMENTS.
 - 1.2 ALL TUBES AND FITTINGS SHALL BE G.M.S. TO BS1387 MEDIUM GRADE WHERE PIPEWORK UP TO ø150mm.
 - 1.3 ALL TUBES AND FITTINGS SHALL BE DUCTILE IRON TO BS EN545 K12 WHERE PIPEWORK ABOVE ø150mm.
 - 1.4 ALL DRAIN PIPES SHALL BE DISCHARGED TO A CONSPICUOUS POSITION WITHOUT THE POSSIBILITY OF BEING SUBMERGED.
 - 1.5 ALL PUDDLE FLANGES SHALL BE MADE OF DUCTILE IRON
 - 1.6 THE AGGREGATE AREA OF OPENABLE WINDOWS NOT LESS THAN 6.25% OF THE FLOOR AREA OF THE STRUCTURE
 - 1.7 VENTILATION/AIR CONDITIONING SYSTEM NOT TO BE PROVIDED.

2. HOSE REEL SYSTEM

- 2.1 NEW FIRE HOSE REEL SHALL BE PROVIDED AS INDICATED ON PLAN TO ENSURE THAT EVERY PART OF THE BUILDING CAN BE REACHED BY A LENGTH OF NOT MORE THAN 30m HOSE REEL TUBING.
- 2.2 THE WATER SUPPLY FOR HOSE REEL SYSTEM WILL BE FED FROM A NEW 2m³ F.S. FIBREGLOSS WATER TANK VIA TWO HOSE REEL PUMPS (DUTY/STANDBY) LOCATED INSIDE FS PUMP ROOM AT EXTERNAL AREA.
- 2.3 HOSE REEL PUMPS SHALL BE STARTED BY ACTUATION OF ANY BREAKGLASS UNIT FITTED ASIDE EACH HOSE REEL SETS
- 2.4 ALL FIRE HOSE REEL OUTLETS SHOULD BE HOUSED IN GLASS FRONTED CABINET SECURED UNDER LOCK & KEY.
- 2.5 ALL FIRE HOSE REEL SHOULD BE PROVIDED WITH FSD APPROVED TYPE INSTRUCTION PLATE & WSD WARNING PLATE
- 2.6 SECONDARY ELECTRICITY SUPPLY DIRECTLY TEE OFF BEFORE CLP'S INCOMING MAIN SWITCH SHALL BE PROVIDED FOR THE FS PUMPS.

3. AUTOMATIC SPRINKLER SYSTEM

- 3.1 NEW AUTOMATIC SPRINKLER SYSTEM SHALL BE PROVIDED AND INSTALLED IN ACCORDANCE WITH LPC RULES FOR AUTOMATIC SPRINKLER INSTALLATIONS INCORPORATING BS EN 12845: 2015 (INCLUDING TECHNICAL BULLETINS, NOTES, COMMENTARY AND RECOMMENDATIONS) AND FSD CIRCULAR LETTER NO. 5/2020. THE CLASSIFICATION OF THE OCCUPANCIES WILL BE ORDINARY HAZARD GROUP III.
- 3.2 ONE NEW 135m³ SPRINKLER WATER TANK WILL BE PROVIDED AS INDICATED ON PLAN. THE TOWN MAIN WATER SUPPLY WILL BE FED FROM SINGLE END.
- 3.3 TWO NEW SPRINKLER PUMPS (DUTY/STANDBY) AND ONE JOCKEY PUMP SHALL BE PROVIDED IN FS PUMP ROOM LOCATED AT EXTERNAL AREA.
- 3.4 NEW SPRINKLER CONTROL VALVE SET AND SPRINKLER INLET SHALL BE PROVIDED AS INDICATED ON PLAN.
- 3.5 A TEST VALVE SHALL BE PROVIDED FOR EACH ZONE OF SPRINKLER PIPE. THIS VALVE SHALL BE AT A CONSPICUOUS POSITION THAT WATER CAN BE DRAINED AWAY EASILY.
- 3.6 ALL SUBSIDIARY STOP VALVES TO BE ELECTRIC MONITORING TYPE.
- 3.7 ALL ELECTRIC TYPE VALVES SHOULD GIVE VISUAL SIGNALS TO FIRE SERVICE MAIN SUPERVISORY CONTROL PANEL TO INDICATE THE STATUS (OPEN/CLOSE) OF THE VALVES.
- 3.8 SECONDARY ELECTRICITY SUPPLY DIRECTLY TEE OFF BEFORE CLP'S INCOMING MAIN SWITCH SHALL BE PROVIDED FOR THE SPRINKLER PUMPS.
- 3.9 THE SPRINKLER SYSTEM DESIGN IS BASED ON THE FOLLOWINGS:
 HAZARD CLASS : ORDINARY HAZARD GROUP III
 TYPE OF STORAGE : POST-PALLET (ST2)
 STORAGE CATEGORY : CATEGORY I
 MAXIMUM STORAGE HEIGHT : 3.5m
 SPRINKLER PROTECTION : CEILING PROTECTION ONLY
 MAXIMUM STORAGE AREA : 50m²
 MINIMUM CLEARANCE AROUND : 2.4m

4. FIRE ALARM SYSTEM

- 4.1 NEW FIRE ALARM SYSTEM SHALL BE PROVIDED IN ACCORDANCE WITH BS 5839-1:2017 +A2:2008 AND FSD CIRCULAR LETTERS NO. 6/2021.
- 4.2 NEW BREAKGLASS UNITS AND FIRE ALARM BELLS SHALL BE PROVIDED AT ALL NEW FIRE HOSE REEL POINTS. THE FIRE ALARM INTALLATION WILL BE INTEGRATED WITH THE HOSE REEL SYSTEM.

5. EMERGENCY LIGHTING

- 5.1 EMERGENCY LIGHTING SHALL BE PROVIDED IN ACCORDANCE WITH 'BS 5266-1 :2016 AND BS EN 1838 :2013", AND FSD CIRCULAR LETTERS NO. 4/2021. COVERING ALL AREA. EMERGENCY LIGHTINGS SHALL BE BACKED UP BY BUILT-IN BATTERY AND CAPABLE OF MAINTAINING FUNCTION OF NOT LESS THAN 2 HOURS IN CASE OF POWER FAILURE

6. EXIT SIGN


- 6.1 ALL EXIT SIGNS/DIRECTIONAL EXIT SIGNS SHALL BE PROVIDED IN ACCORDANCE WITH 'BS 5266-1 :2016 AND FSD CIRCULAR LETTER NO. 5/2008, FOR THE BUILDING. EXIT SIGNS/DIRECTIONAL EXIT SIGNS SHALL BE BACKED UP BY BUILT-IN BATTERY AND CAPABLE OF MAINTAINING FUNCTION OF NOT LESS THAN 2 HOURS IN CASE OF POWER FAILURE.

7. PORTABLE APPLIANCES

- 7.1 PORTABLE HAND OPERATED APPLIANCES SHALL BE PROVIDED AS INDICATED ON PLAN.

LEGEND

- | | | | |
|------------------|--------------------------------|-----------------------------|----------------------------------|
| HOSE REEL | EMERGENCY LIGHT | 5KG CO2 FIRE EXTINGUISHER | 5KG DRY POWDER FIRE EXTINGUISHER |
| BREAK GLASS UNIT | EXIT SIGN | SPRINKLER CONTROL VALVE SET | SPRINKLER HEAD (ON PLAN) |
| FIRE ALARM BELL | SUBSIDIARY VALVE / FLOW SWITCH | SPRINKLER INLET | PUMP SET |

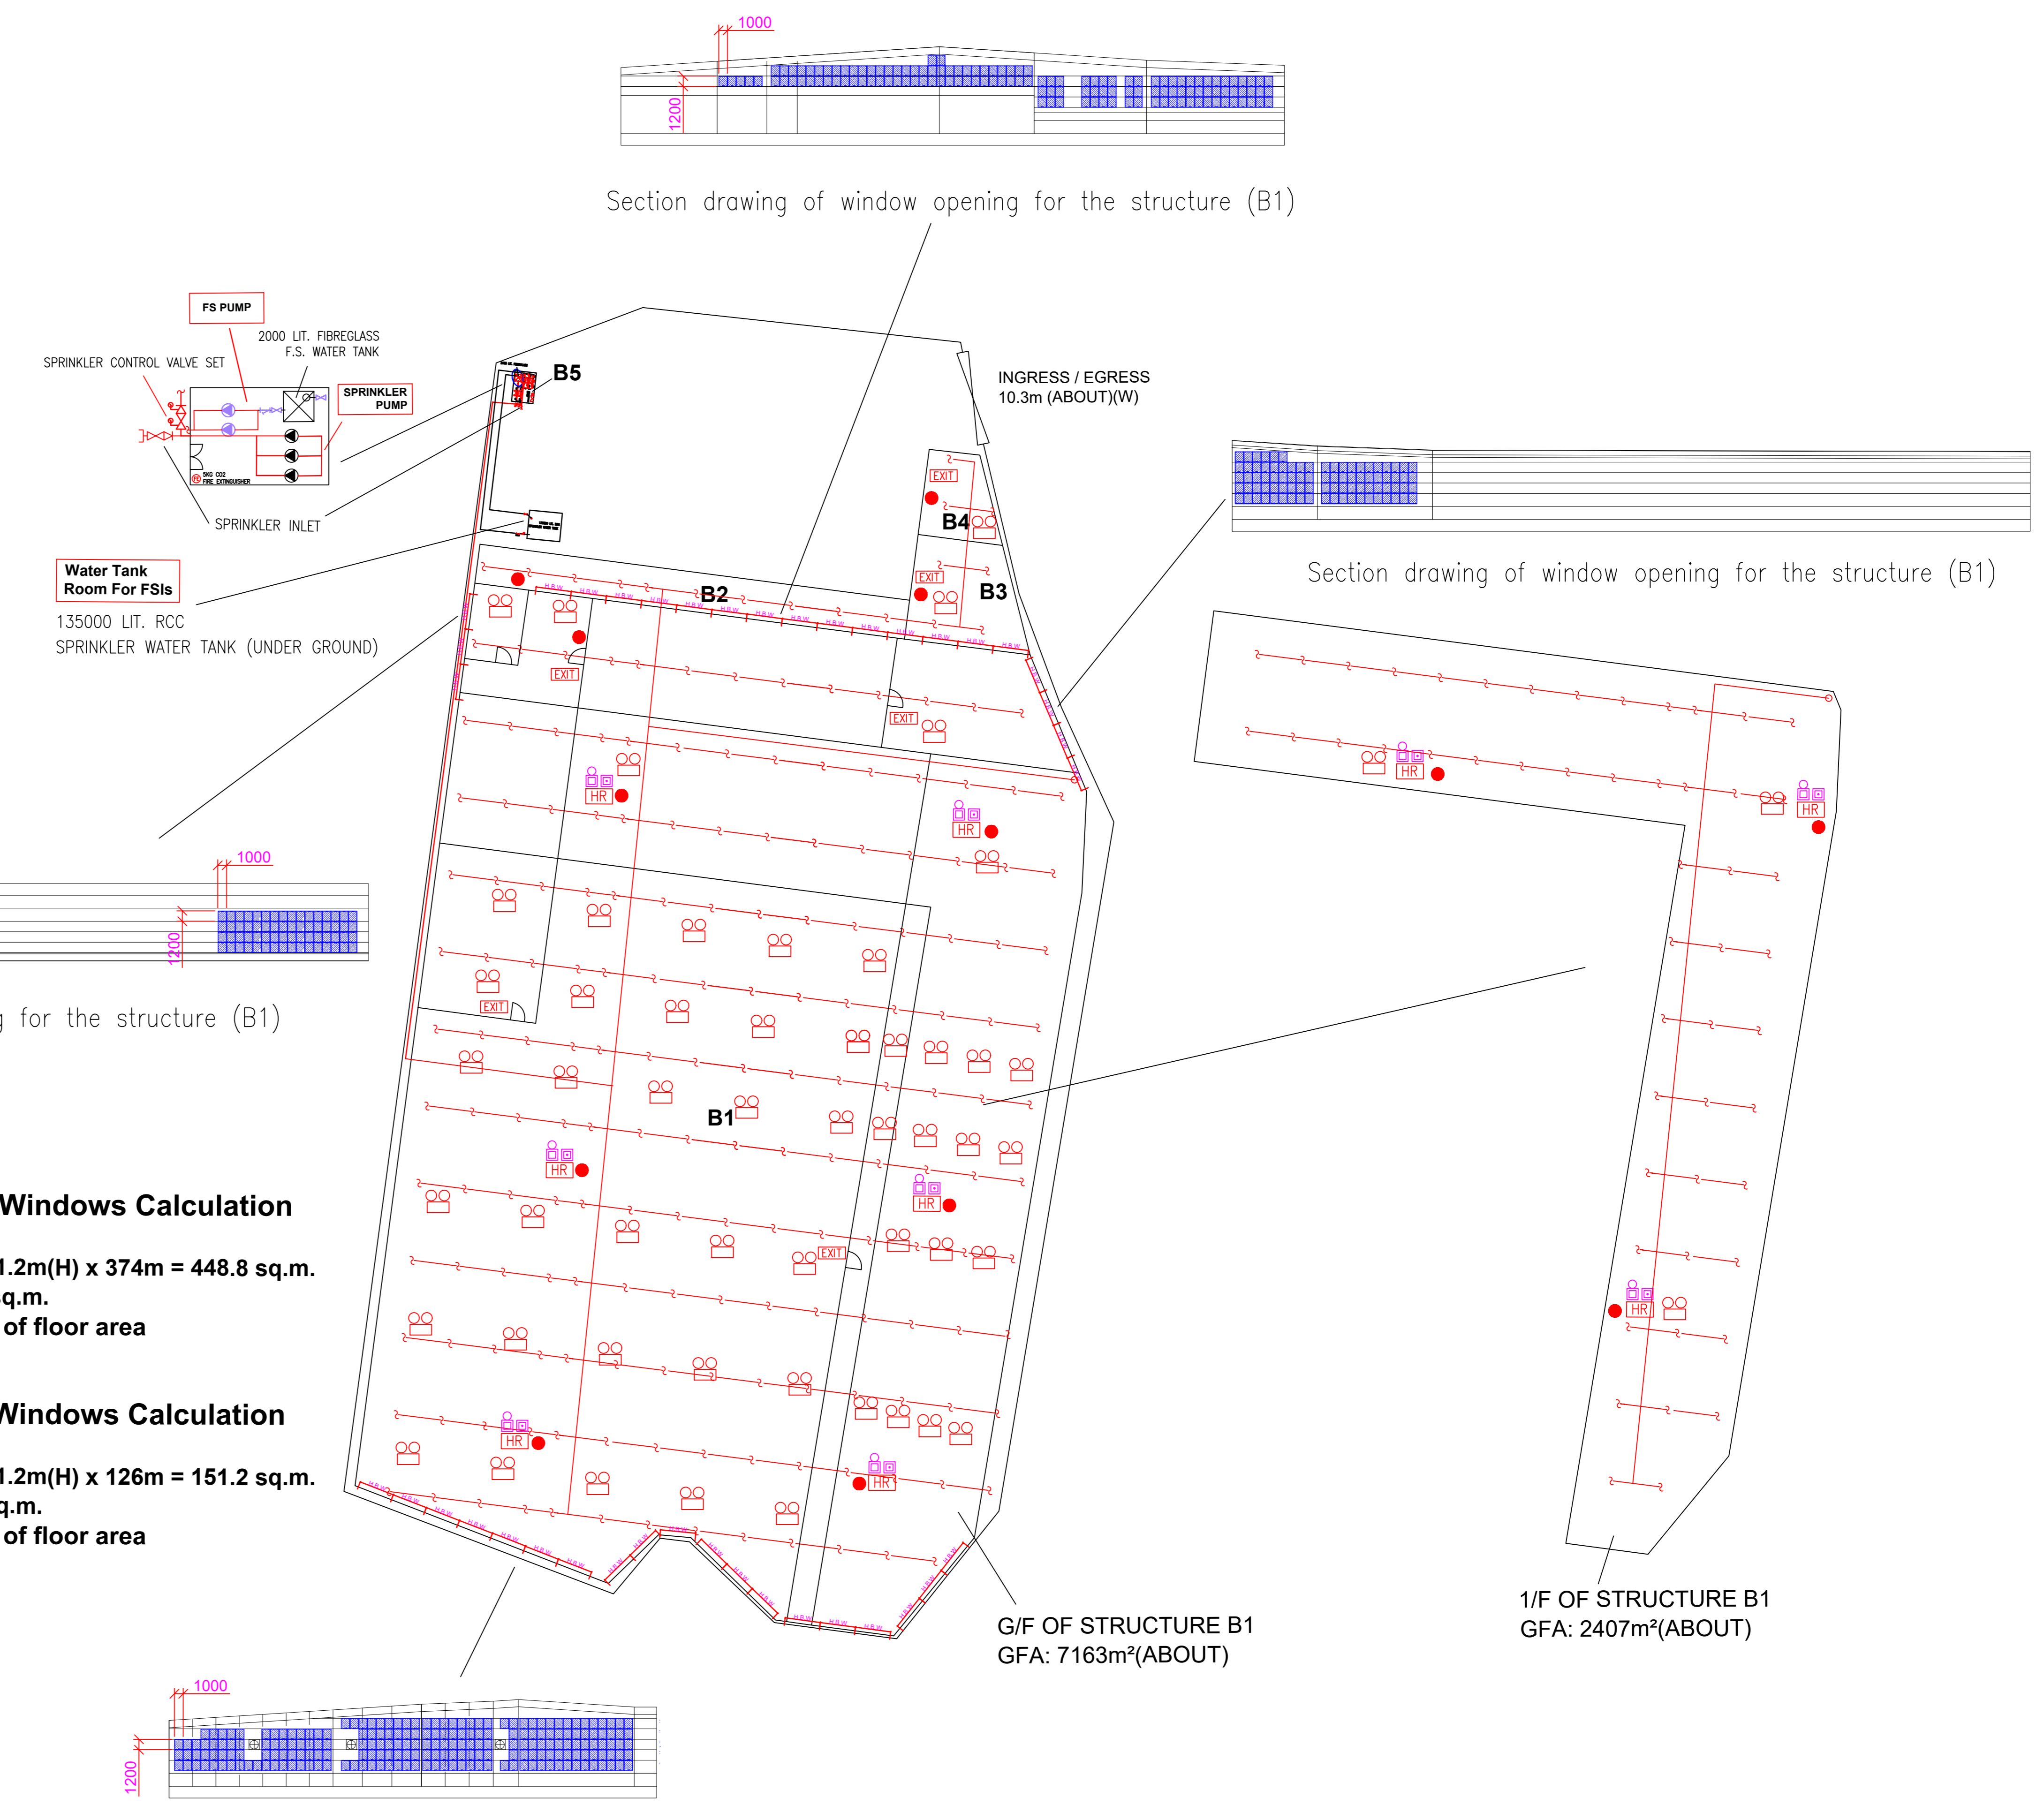

GF of Structure B1 Openable Windows Calculation
 Area of GF Structure B1 = 7163 sq.m.
 Area of High Bay Window (H.B.W.) = 1.2m(H) x 374m = 448.8 sq.m.
 Total openable window area = 448.8 sq.m.
 = 6.26% of floor area

1F of Structure B1 Openable Windows Calculation
 Area of 1F Structure B1 = 2407 sq.m.
 Area of High Bay Window (H.B.W.) = 1.2m(H) x 126m = 151.2 sq.m.
 Total openable window area = 151.2sq.m.
 = 6.28% of floor area

STRUCTURE	Uses	Covered Area	GFA	Building Height
B1	WAREHOUSE (EXCL. D.G.G.*)	7163m²	9570m²	11 m (ABOUT)(2-STOREY)
B2	RAIN SHELTER FOR L/UL	203m²	203m²	7 m (ABOUT)(1-STOREY)
B3	SITE OFFICE	134m²	268m²	8 m (ABOUT)(2-STOREY)
B4	CARETAKER OFFICE AND WASHROOM	71m²	71m²	5 m (ABOUT)(1-STOREY)
B5	PUMP ROOM	44m²	44m²	7 m (ABOUT)(1-STOREY)
	Total:	7615m²	10156m²	

*D.G.G.- DANGEROUS GOODS GODOWN

PROJECT : TEMPORARY WAREHOUSE (EXCLUDING DANGEROUS GOODS GODOWN) WITH ANCILLARY FACILITIES FOR A PERIOD OF 3 YEARS LOTS 25 (PART), 26 (PART), 27 (PART), 28 (PART), 29, 30, 31, 32 (PART), 33 (PART), 34 (PART),36 (PART), 70 (PART), 76 (PART), 77 (PART), 78 S.A (PART), 80 (PART) AND 82 (PART) IN D.D.124 AND ADJOINING GOVERNMENT LAND, HA TSUEN, YUEN LONG, NEW TERRITORIES	DRAWING TITLE : F.S. Notes, Legend, Fire Service Installation Layout Plan	ARCHITECT :	CONSULTANT :	FIRE SERVICE CONTRACTOR : Century Fire Service Engineering Co., Ltd.	NAME : C.K.NG	DATE : 13 Apr 2024	DRAWING NO : FS-01	REV. : 0
REV				DESCRIPTION		DATE		

Appendix IV

Revised Fire Service Installations Proposal

F.S.NOTES:

1. GENERAL

- 1.1 FIRE SERVICE INSTALLATIONS SHALL BE PROVIDED IN ACCORDANCE WITH THE CODES OF PRACTICE FOR MINIMUM FIRE SERVICE INSTALLATIONS AND EQUIPMENT AND INSPECTION, TESTING AND MAINTENANCE OF INSTALLATIONS AND EQUIPMENT 2022 (COP 2022), FSD CIRCULAR LETTERS AND THE HONG KONG WATERWORKS STANDARD REQUIREMENTS.
- 1.2 ALL TUBES AND FITTINGS SHALL BE G.M.S. TO BS1387 MEDIUM GRADE WHERE PIPEWORK UP TO ø150mm.
- 1.3 ALL TUBES AND FITTINGS SHALL BE DUCTILE IRON TO BS EN545 K12 WHERE PIPEWORK ABOVE ø150mm.
- 1.4 ALL DRAIN PIPES SHALL BE DISCHARGED TO A CONSPICUOUS POSITION WITHOUT THE POSSIBILITY OF BEING SUBMERGED.
- 1.5 ALL PUDDLE FLANGES SHALL BE MADE OF DUCTILE IRON
- 1.6 THE AGGREGATE AREA OF OPENABLE WINDOWS NOT LESS THAN 6.25% OF THE FLOOR AREA OF THE STRUCTURE
- 1.7 VENTILATION/AIR CONDITIONING SYSTEM NOT TO BE PROVIDED.

2. HOSE REEL SYSTEM

- 2.1 NEW FIRE HOSE REEL SHALL BE PROVIDED AS INDICATED ON PLAN TO ENSURE THAT EVERY PART OF THE BUILDING CAN BE REACHED BY A LENGTH OF NOT MORE THAN 30m HOSE REEL TUBING.
- 2.2 THE WATER SUPPLY FOR HOSE REEL SYSTEM WILL BE FED FROM A NEW 2m³ F.S. FIBREGLOSS WATER TANK VIA TWO HOSE REEL PUMPS (DUTY/STANDBY) LOCATED INSIDE FS PUMP ROOM AT EXTERNAL AREA.
- 2.3 HOSE REEL PUMPS SHALL BE STARTED BY ACTUATION OF ANY BREAKGLASS UNIT FITTED ASIDE EACH HOSE REEL SETS
- 2.4 ALL FIRE HOSE REEL OUTLETS SHOULD BE HOUSED IN GLASS FRONTED CABINET SECURED UNDER LOCK & KEY.
- 2.5 ALL FIRE HOSE REEL SHOULD BE PROVIDED WITH FSD APPROVED TYPE INSTRUCTION PLATE & WSD WARNING PLATE
- 2.6 SECONDARY ELECTRICITY SUPPLY DIRECTLY TEE OFF BEFORE CLP'S INCOMING MAIN SWITCH SHALL BE PROVIDED FOR THE FS PUMPS.

3. AUTOMATIC SPRINKLER SYSTEM

- 3.1 NEW AUTOMATIC SPRINKLER SYSTEM SHALL BE PROVIDED AND INSTALLED IN ACCORDANCE WITH LPC RULES FOR AUTOMATIC SPRINKLER INSTALLATIONS INCORPORATING BS EN 12845: 2015 (INCLUDING TECHNICAL BULLETINS, NOTES, COMMENTARY AND RECOMMENDATIONS) AND FSD CIRCULAR LETTER NO. 5/2020. THE CLASSIFICATION OF THE OCCUPANCIES WILL BE ORDINARY HAZARD GROUP III.
- 3.2 ONE NEW 135m³ SPRINKLER WATER TANK WILL BE PROVIDED AS INDICATED ON PLAN. THE TOWN MAIN WATER SUPPLY WILL BE FED FROM SINGLE END.
- 3.3 TWO NEW SPRINKLER PUMPS (DUTY/STANDBY) AND ONE JOCKEY PUMP SHALL BE PROVIDED IN FS PUMP ROOM LOCATED AT EXTERNAL AREA.
- 3.4 NEW SPRINKLER CONTROL VALVE SET AND SPRINKLER INLET SHALL BE PROVIDED AS INDICATED ON PLAN.
- 3.5 A TEST VALVE SHALL BE PROVIDED FOR EACH ZONE OF SPRINKLER PIPE. THIS VALVE SHALL BE AT A CONSPICUOUS POSITION THAT WATER CAN BE DRAINED AWAY EASILY.
- 3.6 ALL SUBSIDIARY STOP VALVES TO BE ELECTRIC MONITORING TYPE.
- 3.7 ALL ELECTRIC TYPE VALVES SHOULD GIVE VISUAL SIGNALS TO FIRE SERVICE MAIN SUPERVISORY CONTROL PANEL TO INDICATE THE STATUS (OPEN/CLOSE) OF THE VALVES.
- 3.8 SECONDARY ELECTRICITY SUPPLY DIRECTLY TEE OFF BEFORE CLP'S INCOMING MAIN SWITCH SHALL BE PROVIDED FOR THE SPRINKLER PUMPS.
- 3.9 THE SPRINKLER SYSTEM DESIGN IS BASED ON THE FOLLOWINGS:
 HAZARD CLASS : ORDINARY HAZARD GROUP III
 TYPE OF STORAGE : POST-PALLET (ST2)
 STORAGE CATEGORY : CATEGORY I
 MAXIMUM STORAGE HEIGHT : 3.5m
 SPRINKLER PROTECTION : CEILING PROTECTION ONLY
 MAXIMUM STORAGE AREA : 50m²
 MINIMUM CLEARANCE AROUND : 2.4m

4. FIRE ALARM SYSTEM

- 4.1 NEW FIRE ALARM SYSTEM SHALL BE PROVIDED IN ACCORDANCE WITH BS 5839-1:2017 +A2:2008 AND FSD CIRCULAR LETTERS NO. 6/2021.
- 4.2 NEW BREAKGLASS UNITS AND FIRE ALARM BELLS SHALL BE PROVIDED AT ALL NEW FIRE HOSE REEL POINTS. THE FIRE ALARM INTALLATION WILL BE INTEGRATED WITH THE HOSE REEL SYSTEM.

5. EMERGENCY LIGHTING

- 5.1 EMERGENCY LIGHTING SHALL BE PROVIDED IN ACCORDANCE WITH 'BS 5266-1 :2016 AND BS EN 1838 :2013', AND FSD CIRCULAR LETTERS NO. 4/2021. COVERING ALL AREA. EMERGENCY LIGHTINGS SHALL BE BACKED UP BY BUILT-IN BATTERY AND CAPABLE OF MAINTAINING FUNCTION OF NOT LESS THAN 2 HOURS IN CASE OF POWER FAILURE

6. EXIT SIGN


- 6.1 ALL EXIT SIGNS/DIRECTIONAL EXIT SIGNS SHALL BE PROVIDED IN ACCORDANCE WITH 'BS 5266-1 :2016 AND FSD CIRCULAR LETTER NO. 5/2008, FOR THE BUILDING. EXIT SIGNS/DIRECTIONAL EXIT SIGNS SHALL BE BACKED UP BY BUILT-IN BATTERY AND CAPABLE OF MAINTAINING FUNCTION OF NOT LESS THAN 2 HOURS IN CASE OF POWER FAILURE.

7. PORTABLE APPLIANCES

- 7.1 PORTABLE HAND OPERATED APPLIANCES SHALL BE PROVIDED AS INDICATED ON PLAN.

LEGEND

HOSE REEL	EMERGENCY LIGHT	5KG CO2 FIRE EXTINGUISHER	5KG DRY POWDER FIRE EXTINGUISHER
BREAK GLASS UNIT	EXIT SIGN	SPRINKLER CONTROL VALVE SET	SPRINKLER HEAD (ON PLAN)
FIRE ALARM BELL	SUBSIDIARY VALVE / FLOW SWITCH	SPRINKLER INLET	PUMP SET

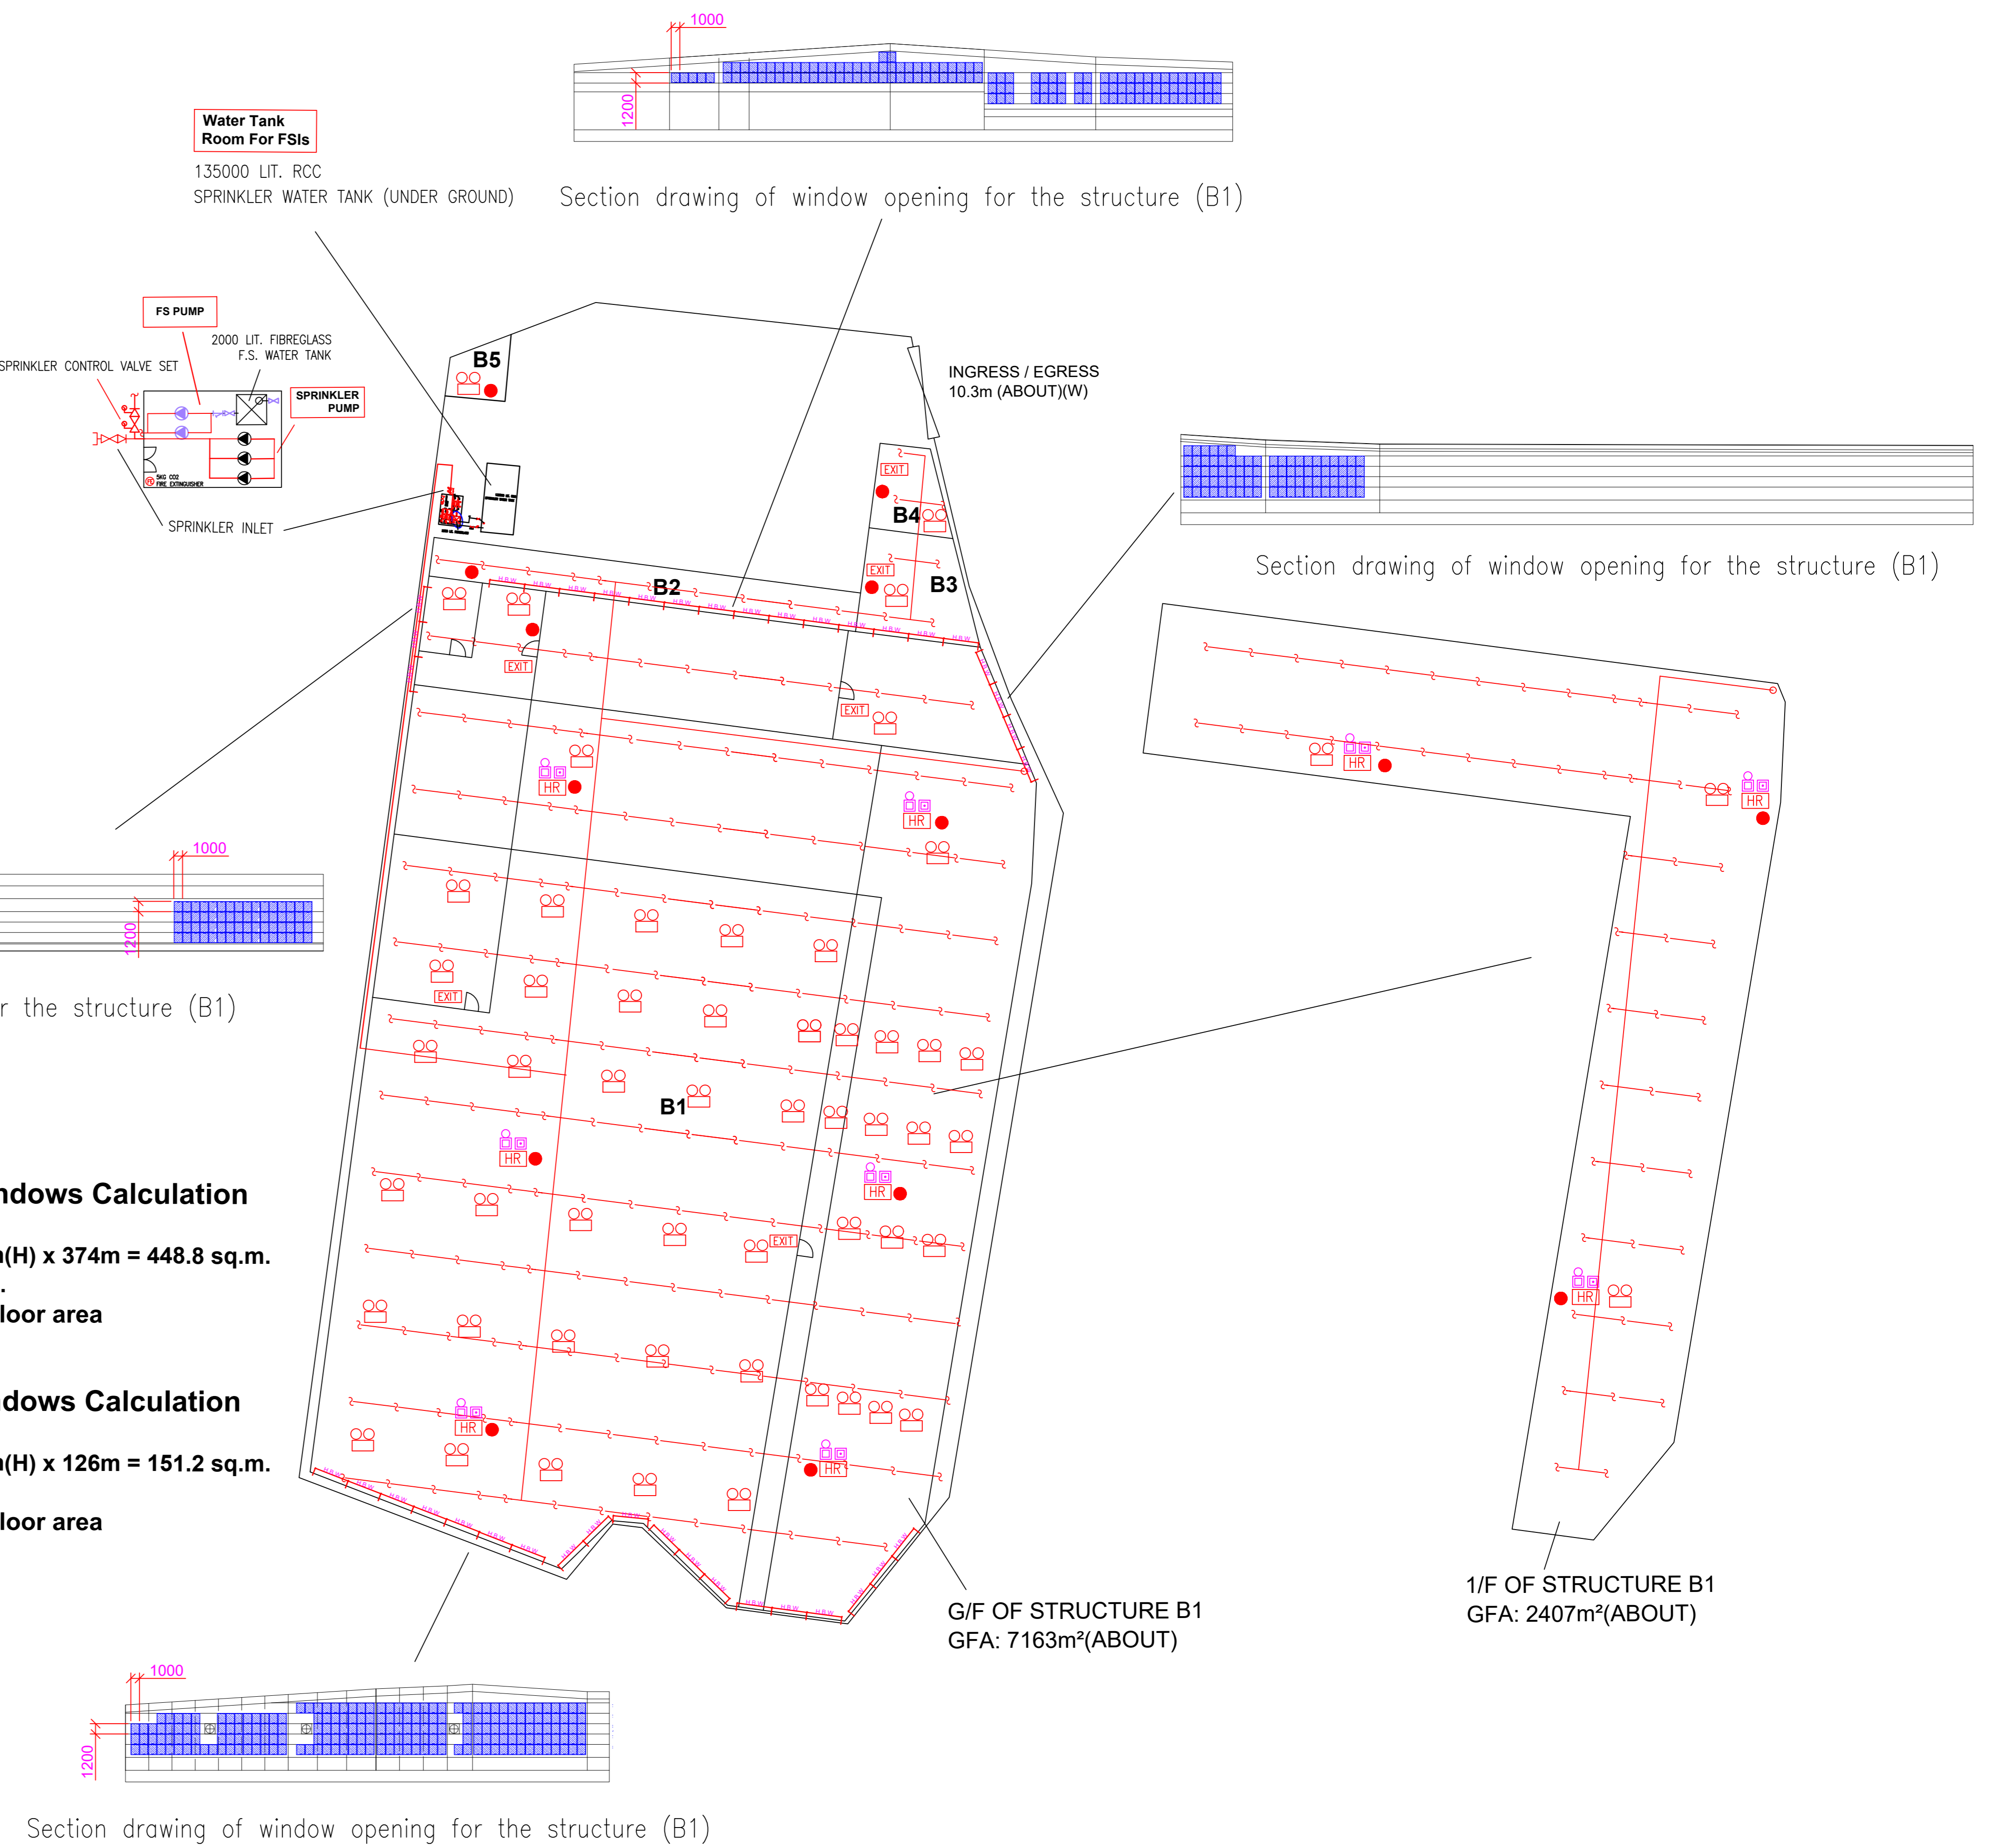

GF of Structure B1 Openable Windows Calculation
 Area of GF Structure B1 = 7163 sq.m.
 Area of High Bay Window (H.B.W.) = 1.2m(H) x 374m = 448.8 sq.m.
 Total openable window area = 448.8 sq.m.
 = 6.26% of floor area

1F of Structure B1 Openable Windows Calculation
 Area of 1F Structure B1 = 2407 sq.m.
 Area of High Bay Window (H.B.W.) = 1.2m(H) x 126m = 151.2 sq.m.
 Total openable window area = 151.2sq.m.
 = 6.28% of floor area

STRUCTURE	Uses	Covered Area	GFA	Building Height
B1	WAREHOUSE (EXCL. D.G.G.*)	7163m²	9570m²	11 m (ABOUT)(2-STOREY)
B2	RAIN SHELTER FOR L/UL	203m²	203m²	7 m (ABOUT)(1-STOREY)
B3	SITE OFFICE	134m²	268m²	8 m (ABOUT)(2-STOREY)
B4	CARETAKER OFFICE AND WASHROOM	71m²	71m²	5 m (ABOUT)(1-STOREY)
B5	METER ROOM	44m²	44m²	7 m (ABOUT)(1-STOREY)
Total:		7615m²	10156m²	

*D.G.G.- DANGEROUS GOODS GODOWN

PROJECT : TEMPORARY WAREHOUSE (EXCLUDING DANGEROUS GOODS GODOWN) WITH ANCILLARY FACILITIES FOR A PERIOD OF 3 YEARS LOTS 25 (PART), 26 (PART), 27 (PART), 28 (PART), 29, 30, 31, 32 (PART), 33 (PART), 34 (PART), 36 (PART), 70 (PART), 76 (PART), 77 (PART), 78 S.A (PART), 80 (PART) AND 82 (PART) IN D.D.124 AND ADJOINING GOVERNMENT LAND, HA TSUEN, YUEN LONG, NEW TERRITORIES	DRAWING TITLE : F.S. Notes, Legend, Fire Service Installation Layout Plan	ARCHITECT :	CONSULTANT :	FIRE SERVICE CONTRACTOR : Century Fire Service Engineering Co., Ltd.	NAME : C.K. NG	DATE : 11 SEP 2024	DRAWING NO : FS-01	REV. : 0
REV DESCRIPTION DATE		SCALE : 1 : 400 (A0)		SOURCE : B.O.O. Ref. BD		F.S.D. Ref. FP		