



<p>Project 項目名稱: Proposed Temporary Open Storage of Vehicles (Private Cars and Light Goods Vehicles), Container Vehicles and Trailers for a Period of 3 Years at Lots 1922 RP (Part), 1923 (Part), 1925 (Part), 1926 (Part), 1928 (Part), 1929 (Part), 1930 (Part), 1931 RP (Part), 1932 (Part) and 1933 (Part) in D.D.125, Ha Tsuen, Yuen Long</p>	<p>Drawing Title 圖目: Application Site</p> <p>Drawing No. 圖號: Figure 1</p>	<p>Remarks 備註: → Vehicular access leading from Ping Ha Road</p> <p>Scale 比例: 1:1000</p>
---	---------------------------------------------------------------------------------------------------	---

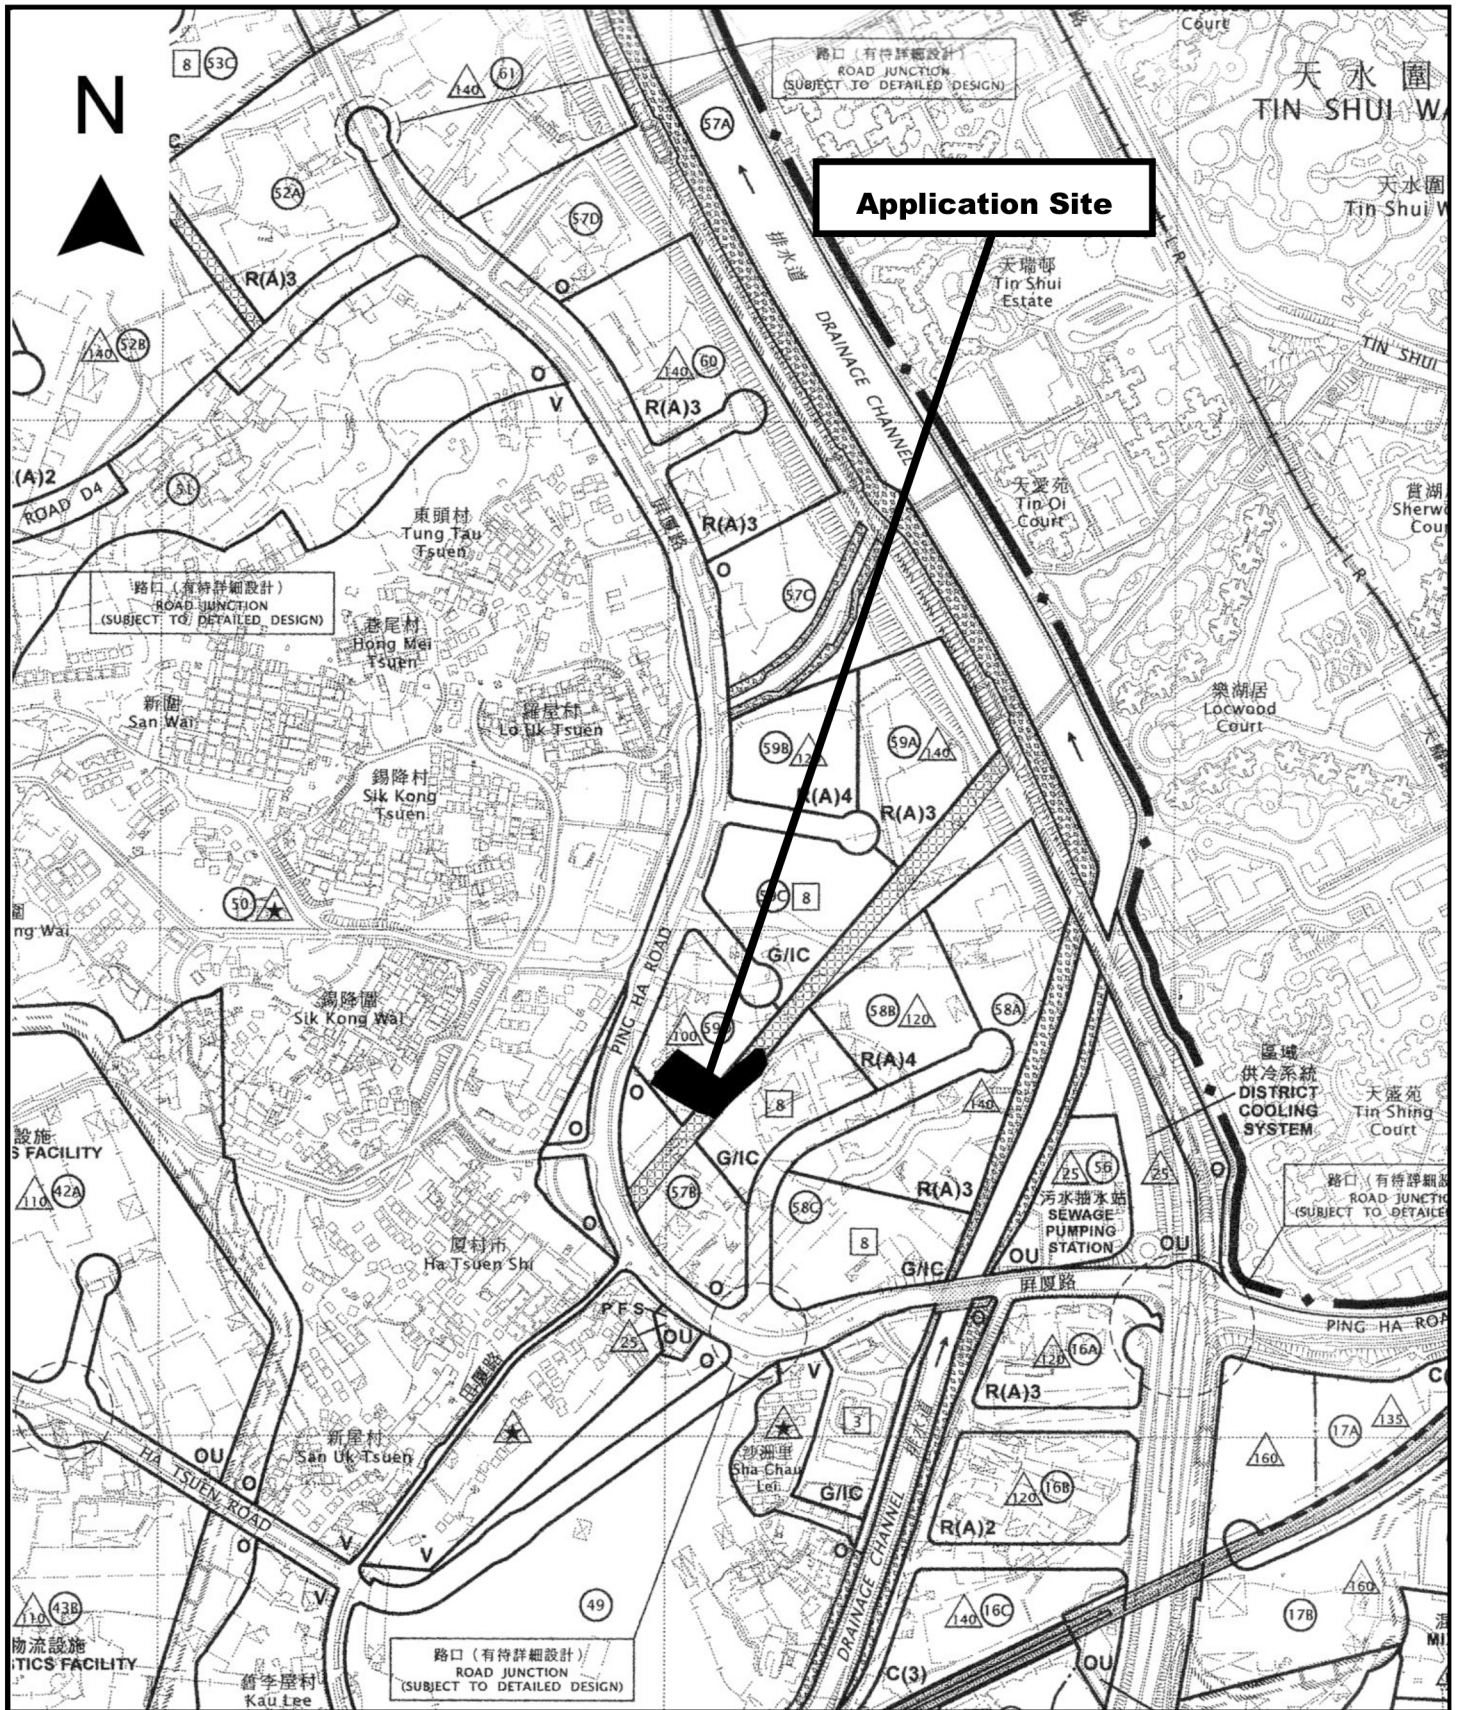

<p>Project 項目名稱: Proposed Temporary Open Storage of Vehicles (Private Cars and Light Goods Vehicles), Container Vehicles and Trailers for a Period of 3 Years at Lots 1922 RP (Part), 1923 (Part), 1925 (Part), 1926 (Part), 1928 (Part), 1929 (Part), 1930 (Part), 1931 RP (Part), 1932 (Part) and 1933 (Part) in D.D.125, Ha Tsuen, Yuen Long</p>	<p>Drawing Title 圖目: Location Plan</p> <p>Drawing No. 圖號: Figure 2</p>	<p>Remarks 備註:</p> <p>Scale 比例: 1:7500</p>
---	--------------------------------------------------------------------------------------------------	---------------------------------------------------------

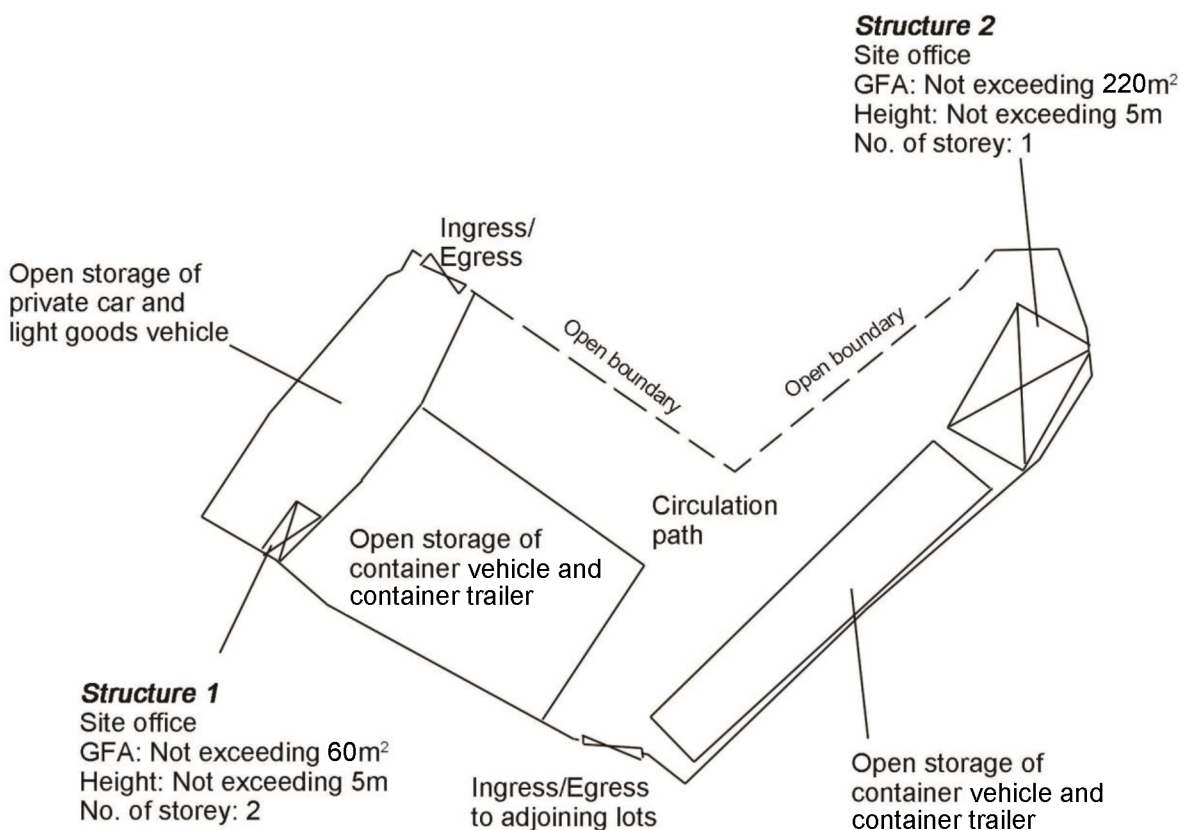

Project 項目名稱:

Proposed Temporary Open Storage of Vehicles (Private Cars and Light Goods Vehicles), Container Vehicles and Trailers for a Period of 3 Years at Lots 1922 RP (Part), 1923 (Part), 1925 (Part), 1926 (Part), 1928 (Part), 1929 (Part), 1930 (Part), 1931 RP (Part), 1932 (Part) and 1933 (Part) in D.D.125, Ha Tsuen, Yuen Long

Drawing Title 圖目:

Proposed Layout Plan


Drawing No. 圖號:

Figure 3

Remarks 備註:

Scale 比例:

1:1000

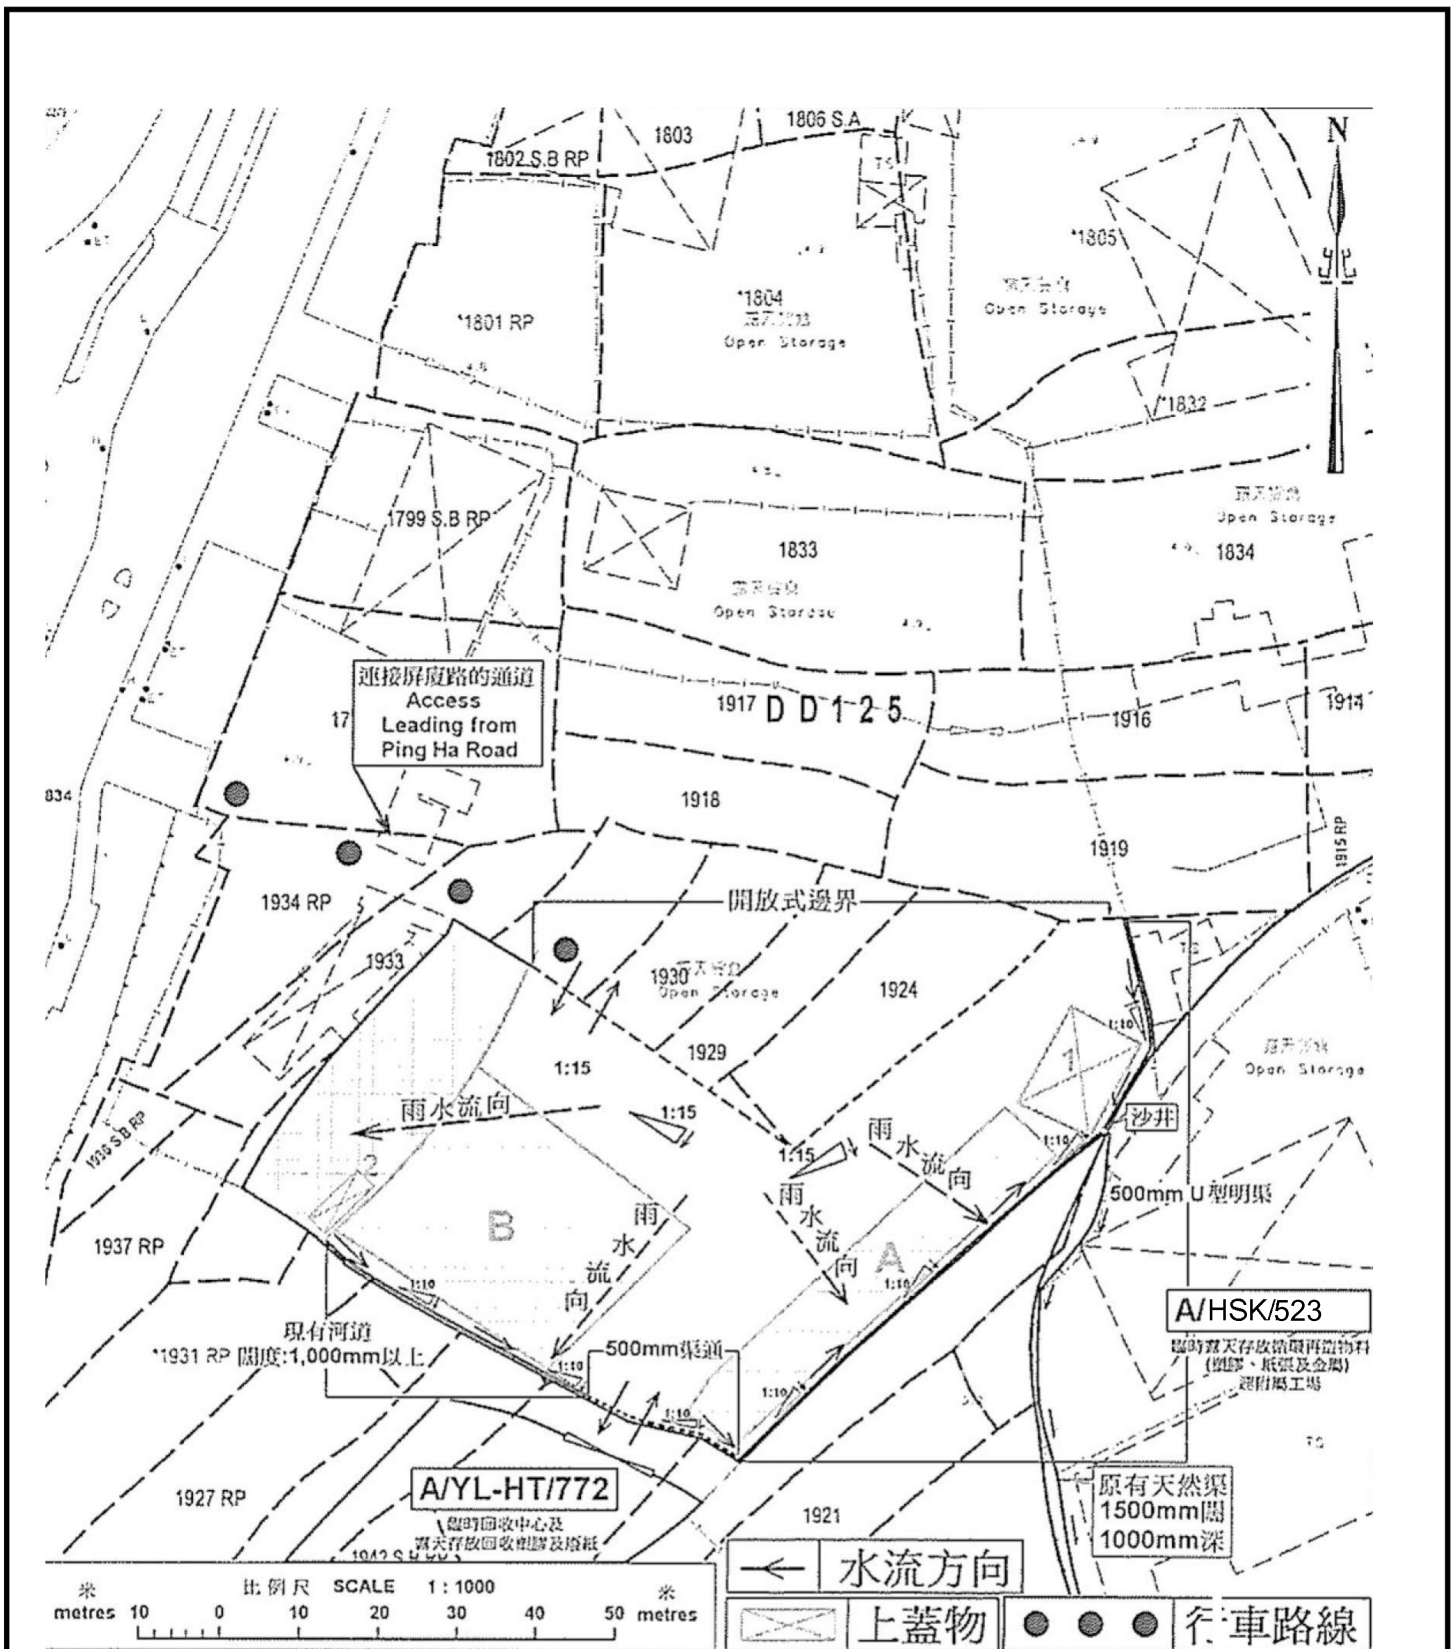

Project 項目名稱:
 Proposed Temporary Open Storage of Vehicles (Private Cars and Light Goods Vehicles), Container Vehicles and Trailers for a Period of 3 Years at Lots 1922 RP (Part), 1923 (Part), 1925 (Part), 1926 (Part), 1928 (Part), 1929 (Part), 1930 (Part), 1931 RP (Part), 1932 (Part) and 1933 (Part) in D.D.125, Ha Tsuen, Yuen Long

Drawing Title 圖目:
 As-built Drainage Plan

Drawing No. 圖號:
 Figure 4

Remarks 備註:

Scale 比例:
 As shown