


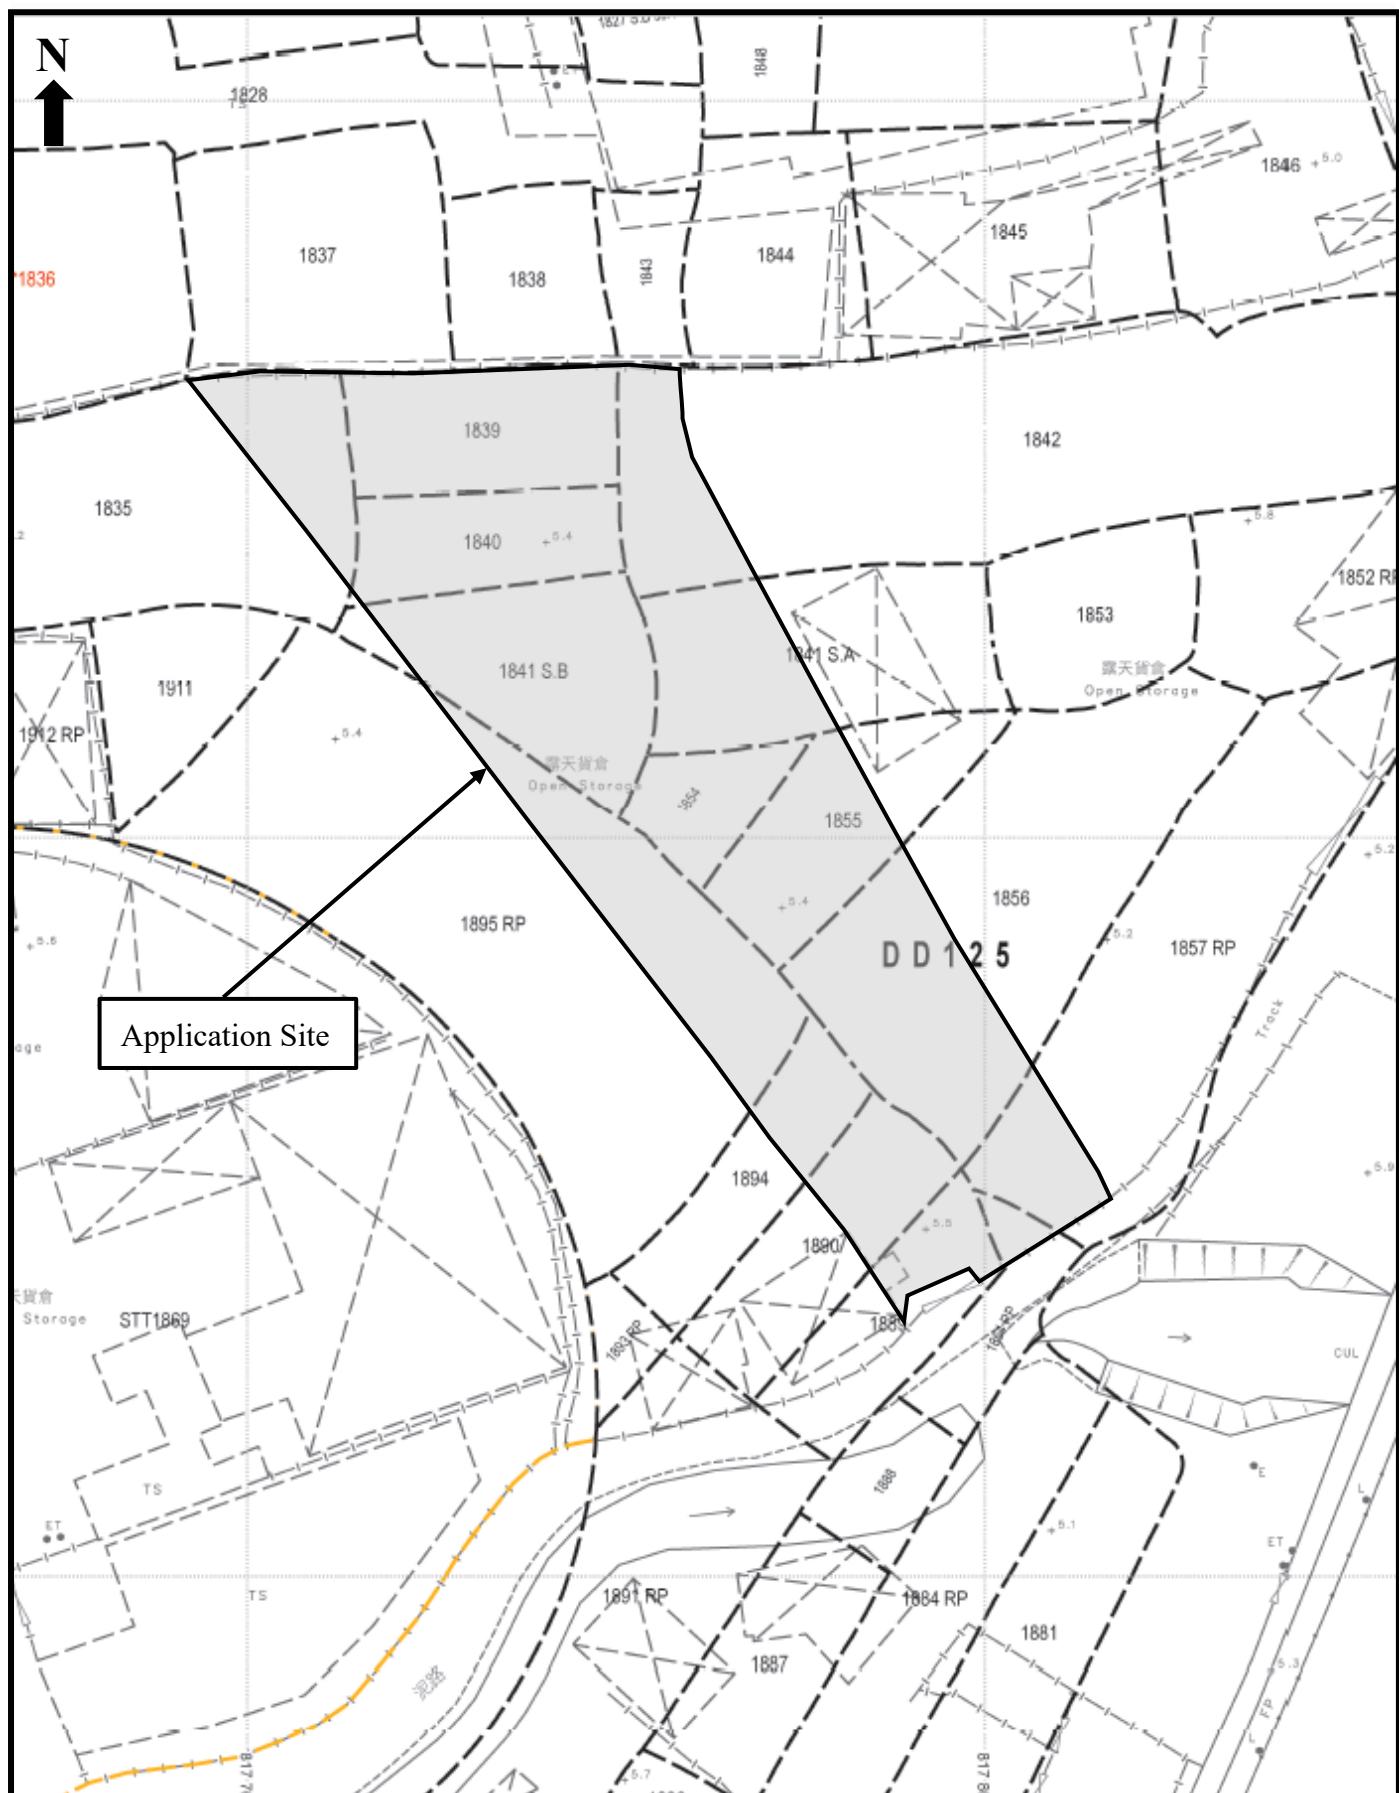


Proposed Development:

Proposed Temporary Warehouse for Storage of Electrical Appliances for a Period of 3 Years at Lots 1835 (Part), 1839, 1840 (Part), 1841 S.A (Part), 1841 S.B (Part), 1842 (Part), 1854, 1855 (Part), 1856 (Part), 1857 RP (Part), 1864 RP (Part), 1889 (Part), 1890 (Part), 1894 (Part) & 1895 RP (Part) in D.D. 125, Ha Tsuen, Yuen Long, N.T.

**Figure 1:
Site Plan**

Scale:
1:1000

Remarks:

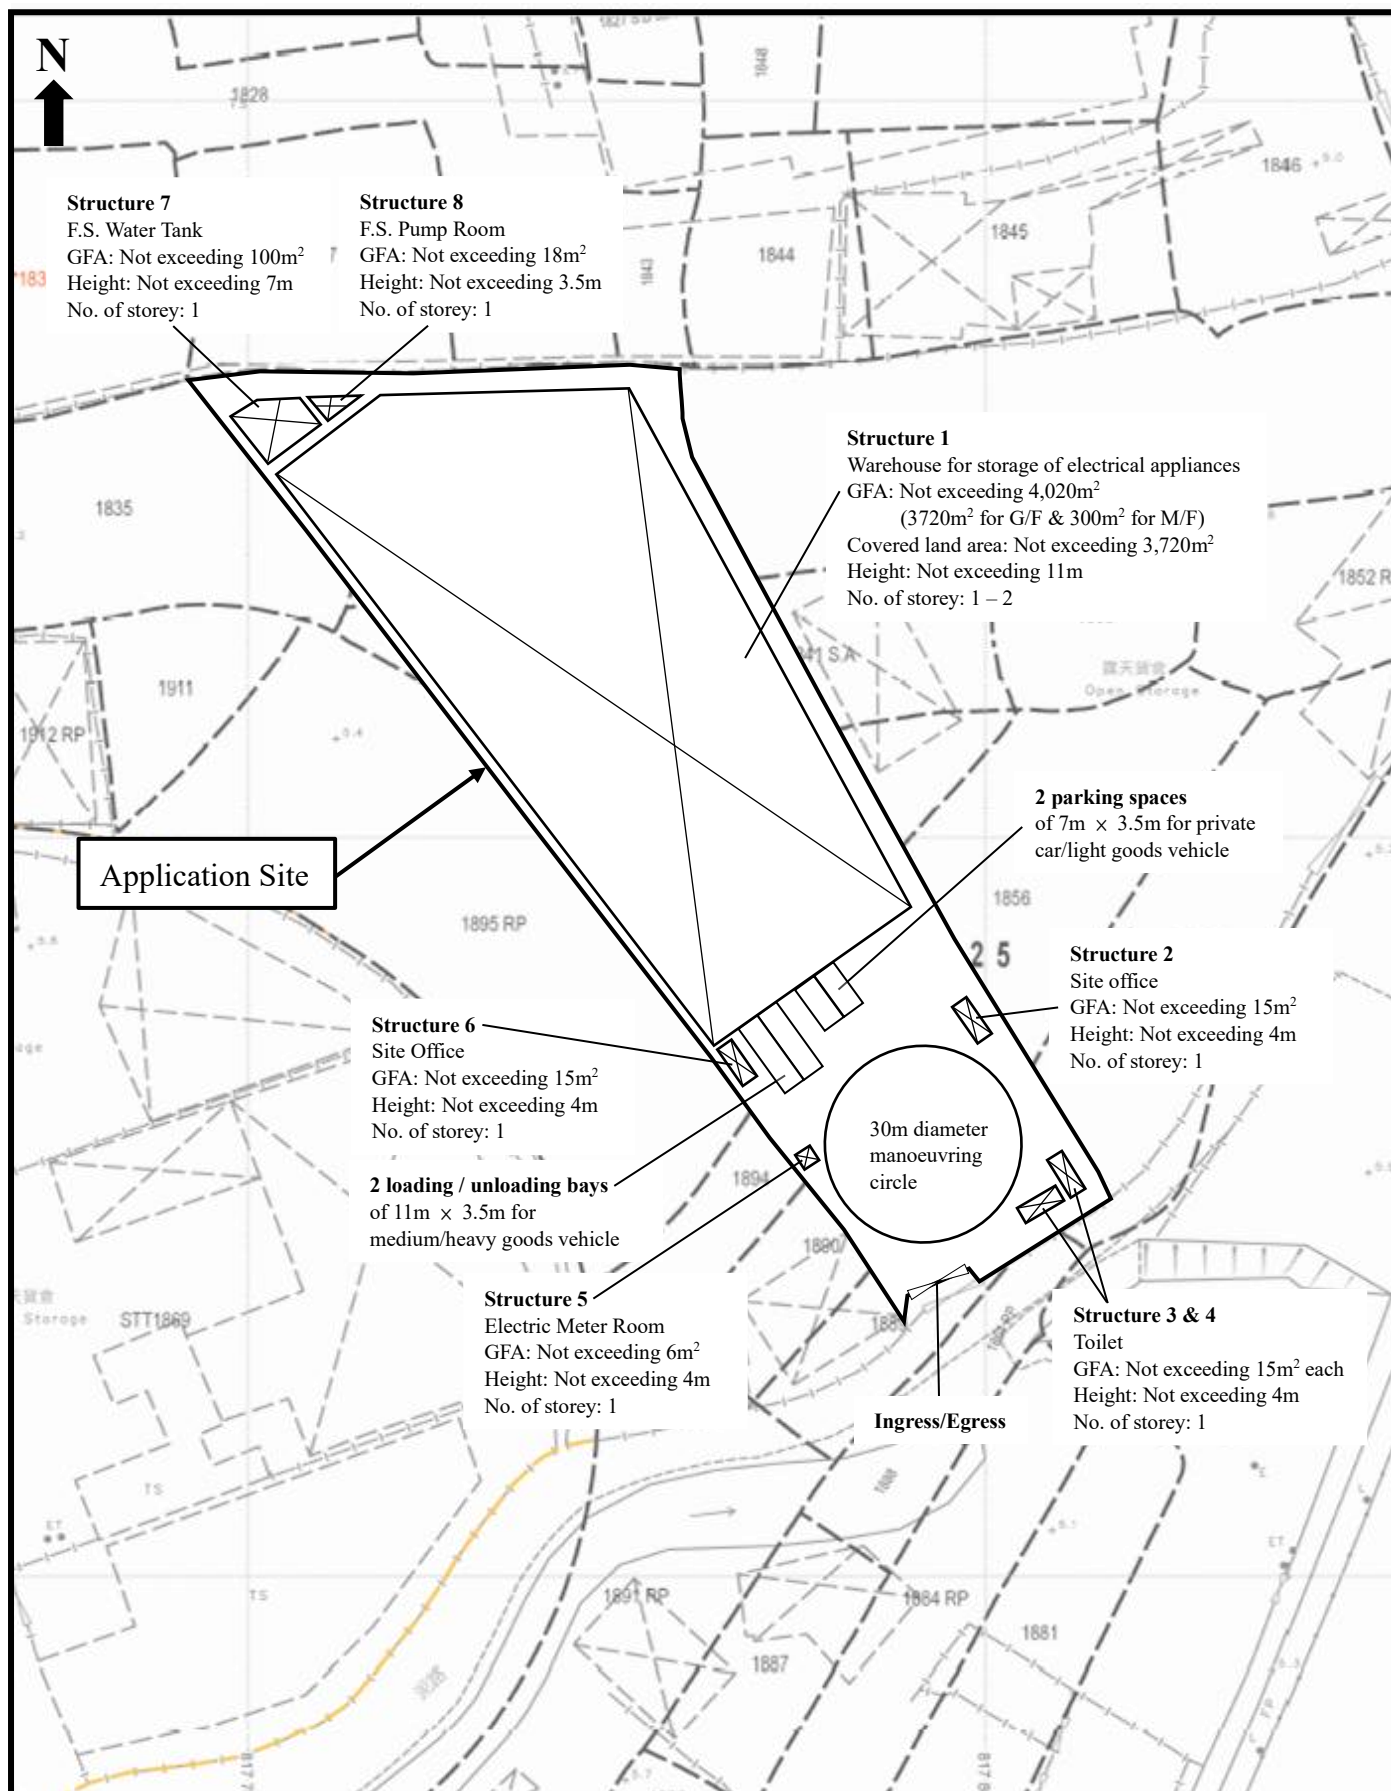

Proposed Development:

Proposed Temporary Warehouse for Storage of Electrical Appliances for a Period of 3 Years at Lots 1835 (Part), 1839, 1840 (Part), 1841 S.A (Part), 1841 S.B (Part), 1842 (Part), 1854, 1855 (Part), 1856 (Part), 1857 RP (Part), 1864 RP (Part), 1889 (Part), 1890 (Part), 1894 (Part) & 1895 RP (Part) in D.D. 125, Ha Tsuen, Yuen Long, N.T.


Figure 3:

Proposed Layout Plan

Scale:

1:1000

Remarks:

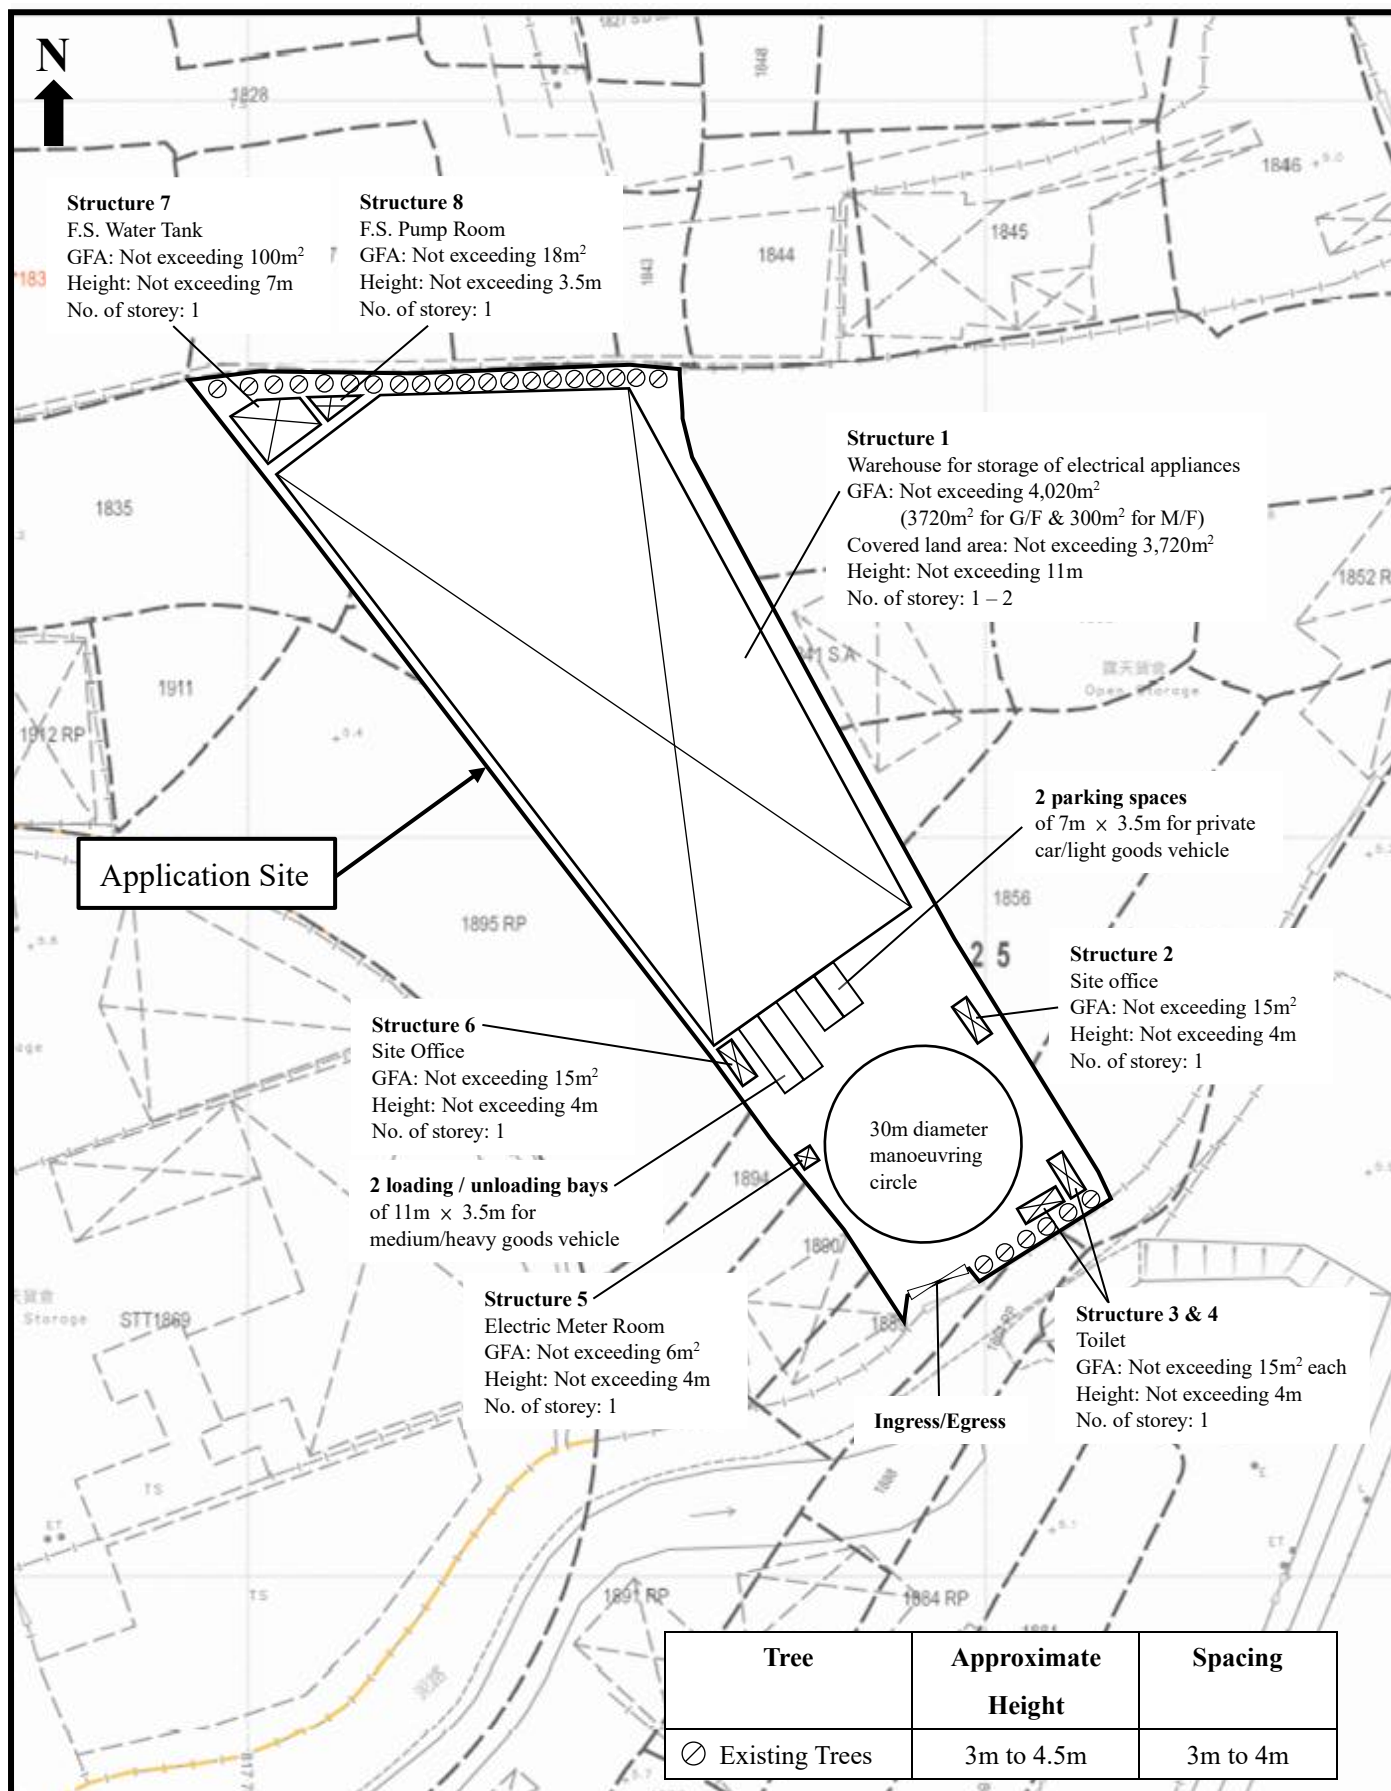

Proposed Development:

Proposed Temporary Warehouse for Storage of Electrical Appliances for a Period of 3 Years at Lots 1835 (Part), 1839, 1840 (Part), 1841 S.A (Part), 1841 S.B (Part), 1842 (Part), 1854, 1855 (Part), 1856 (Part), 1857 RP (Part), 1864 RP (Part), 1889 (Part), 1890 (Part), 1894 (Part) & 1895 RP (Part) in D.D. 125, Ha Tsuen, Yuen Long, N.T.


Figure 4:

As-planted Landscape & Tree Preservation Plan

Scale:

1:1000

Remarks:

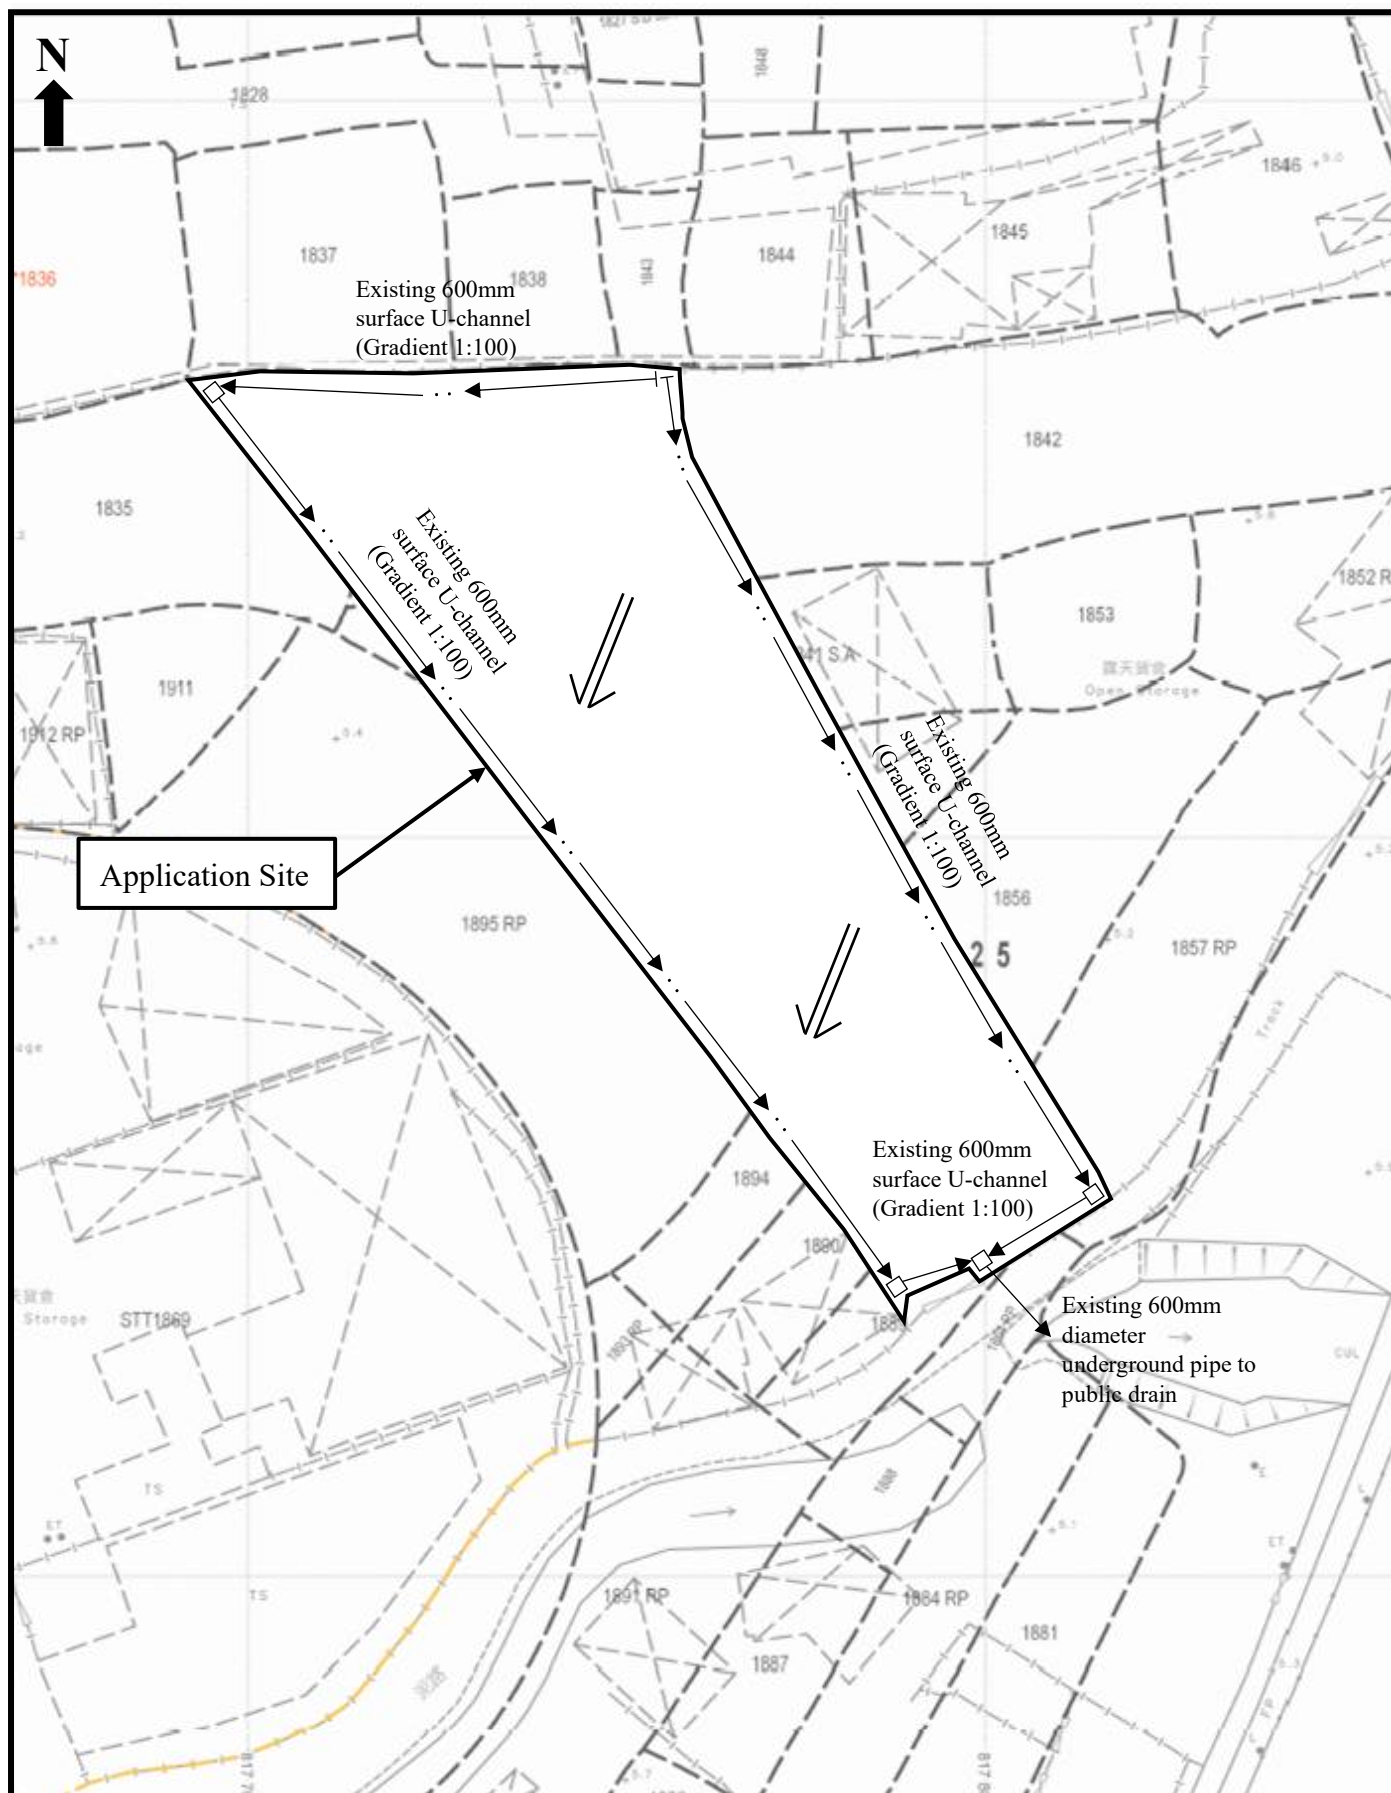

Proposed Development:

Proposed Temporary Warehouse for Storage of Electrical Appliances for a Period of 3 Years at Lots 1835 (Part), 1839, 1840 (Part), 1841 S.A (Part), 1841 S.B (Part), 1842 (Part), 1854, 1855 (Part), 1856 (Part), 1857 RP (Part), 1864 RP (Part), 1889 (Part), 1890 (Part), 1894 (Part) & 1895 RP (Part) in D.D. 125, Ha Tsuen, Yuen Long, N.T.

Figure 5:
As-built Drainage Plan

Scale:

1:1000

Remarks:

← Flow of surface runoff

□ Catchpit