


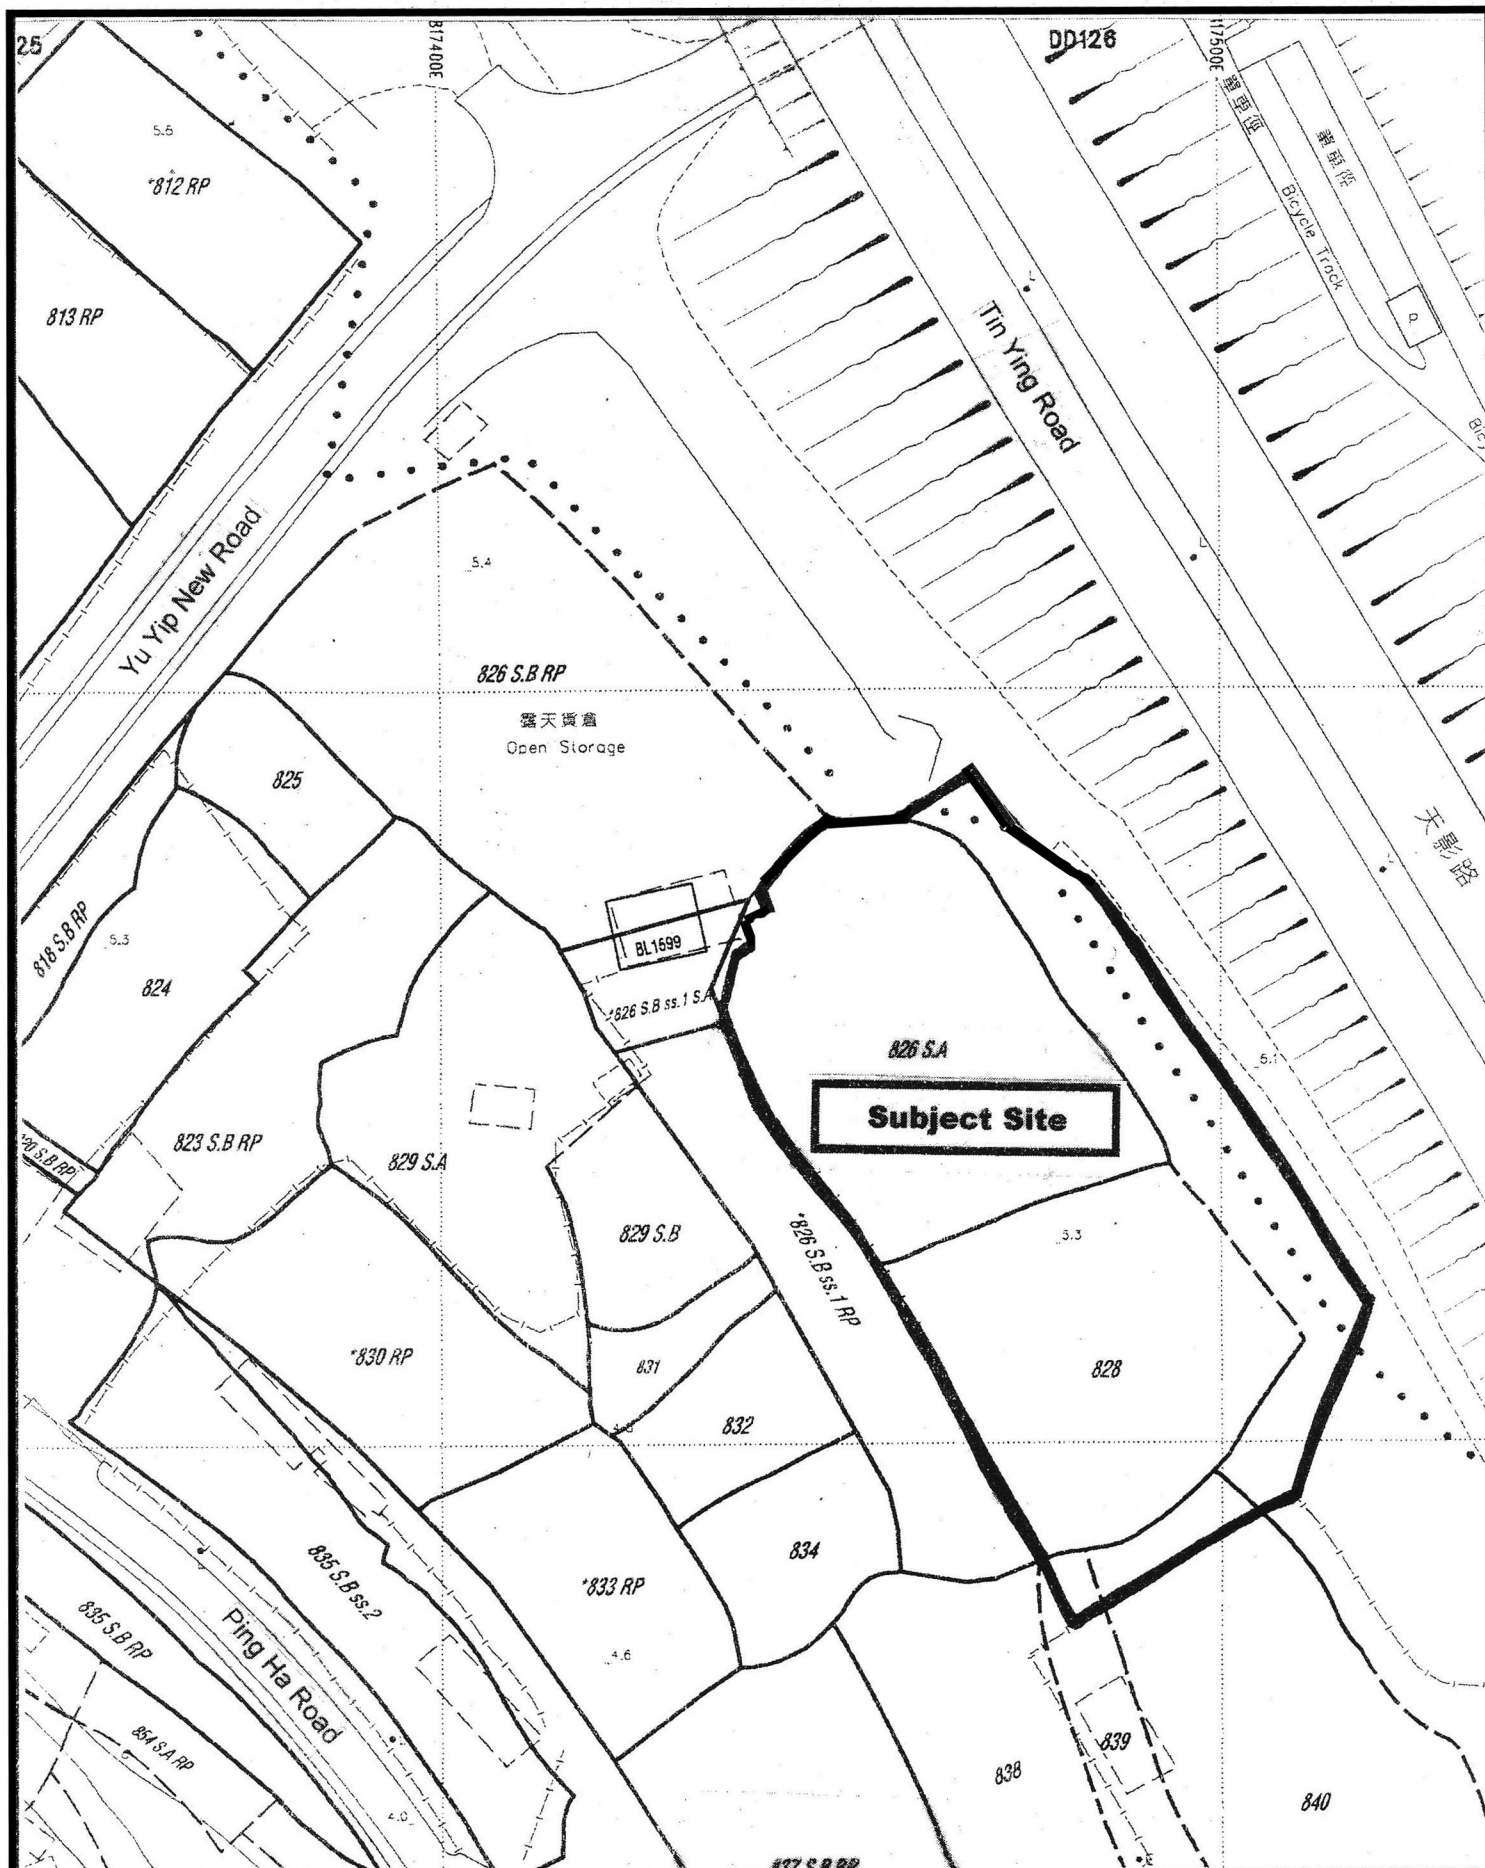

Project 項目名稱:

Proposed Temporary Public Vehicle Park for Private Cars, Light Goods Vehicles, Heavy Goods Vehicles & Container Trailers for a Period of 3 Years at Lots 826.S.A(Part), 828, 839(Part), 840(Part) & Adjoining Government Land in D.D. 125, Ha Tsuen, Yuen Long, N.T.

Drawing Title 圖則:

Site Plan


Drawing No. 圖號:

Figure 1

Remarks 備註:

Scale 比例:

1:1000

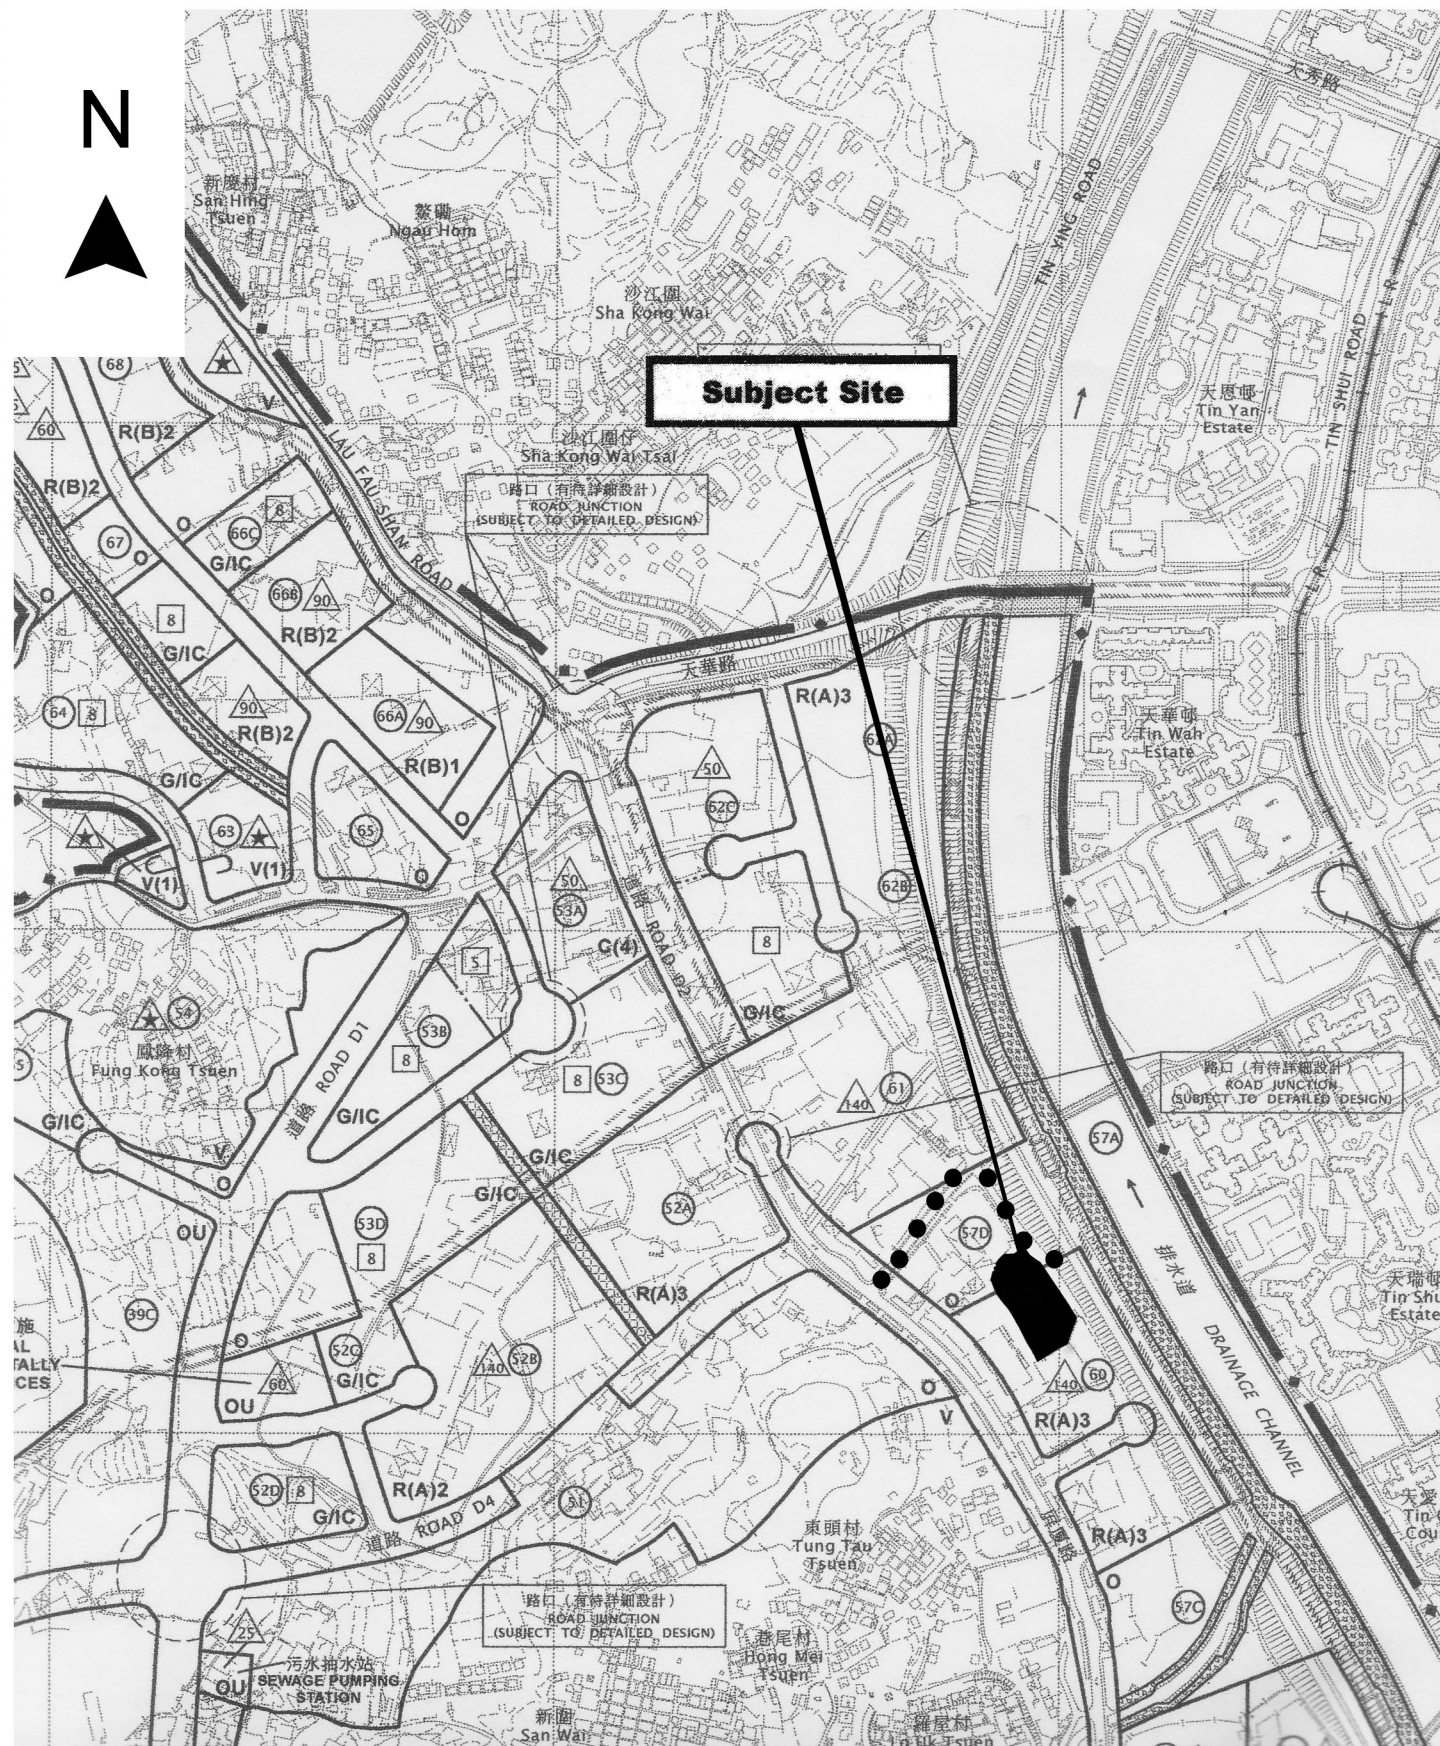

Project 項目名稱:

Proposed Temporary Public Vehicle Park for Private Cars, Light Goods Vehicles, Heavy Goods Vehicles & Container Trailers for a Period of 3 Years at Lots 826S.A(Part), 828, 839(Part), 840(Part) & Adjoining Government Land in D.D. 125, Ha Tsuen, Yuen Long, N.T.

Drawing Title 圖名:

Location Plan

Drawing No. 圖號:


Figure 2

Remarks 備註:

● ● ● Vehicular access leading to Ping Ha Road

Scale 比例:

1:7500

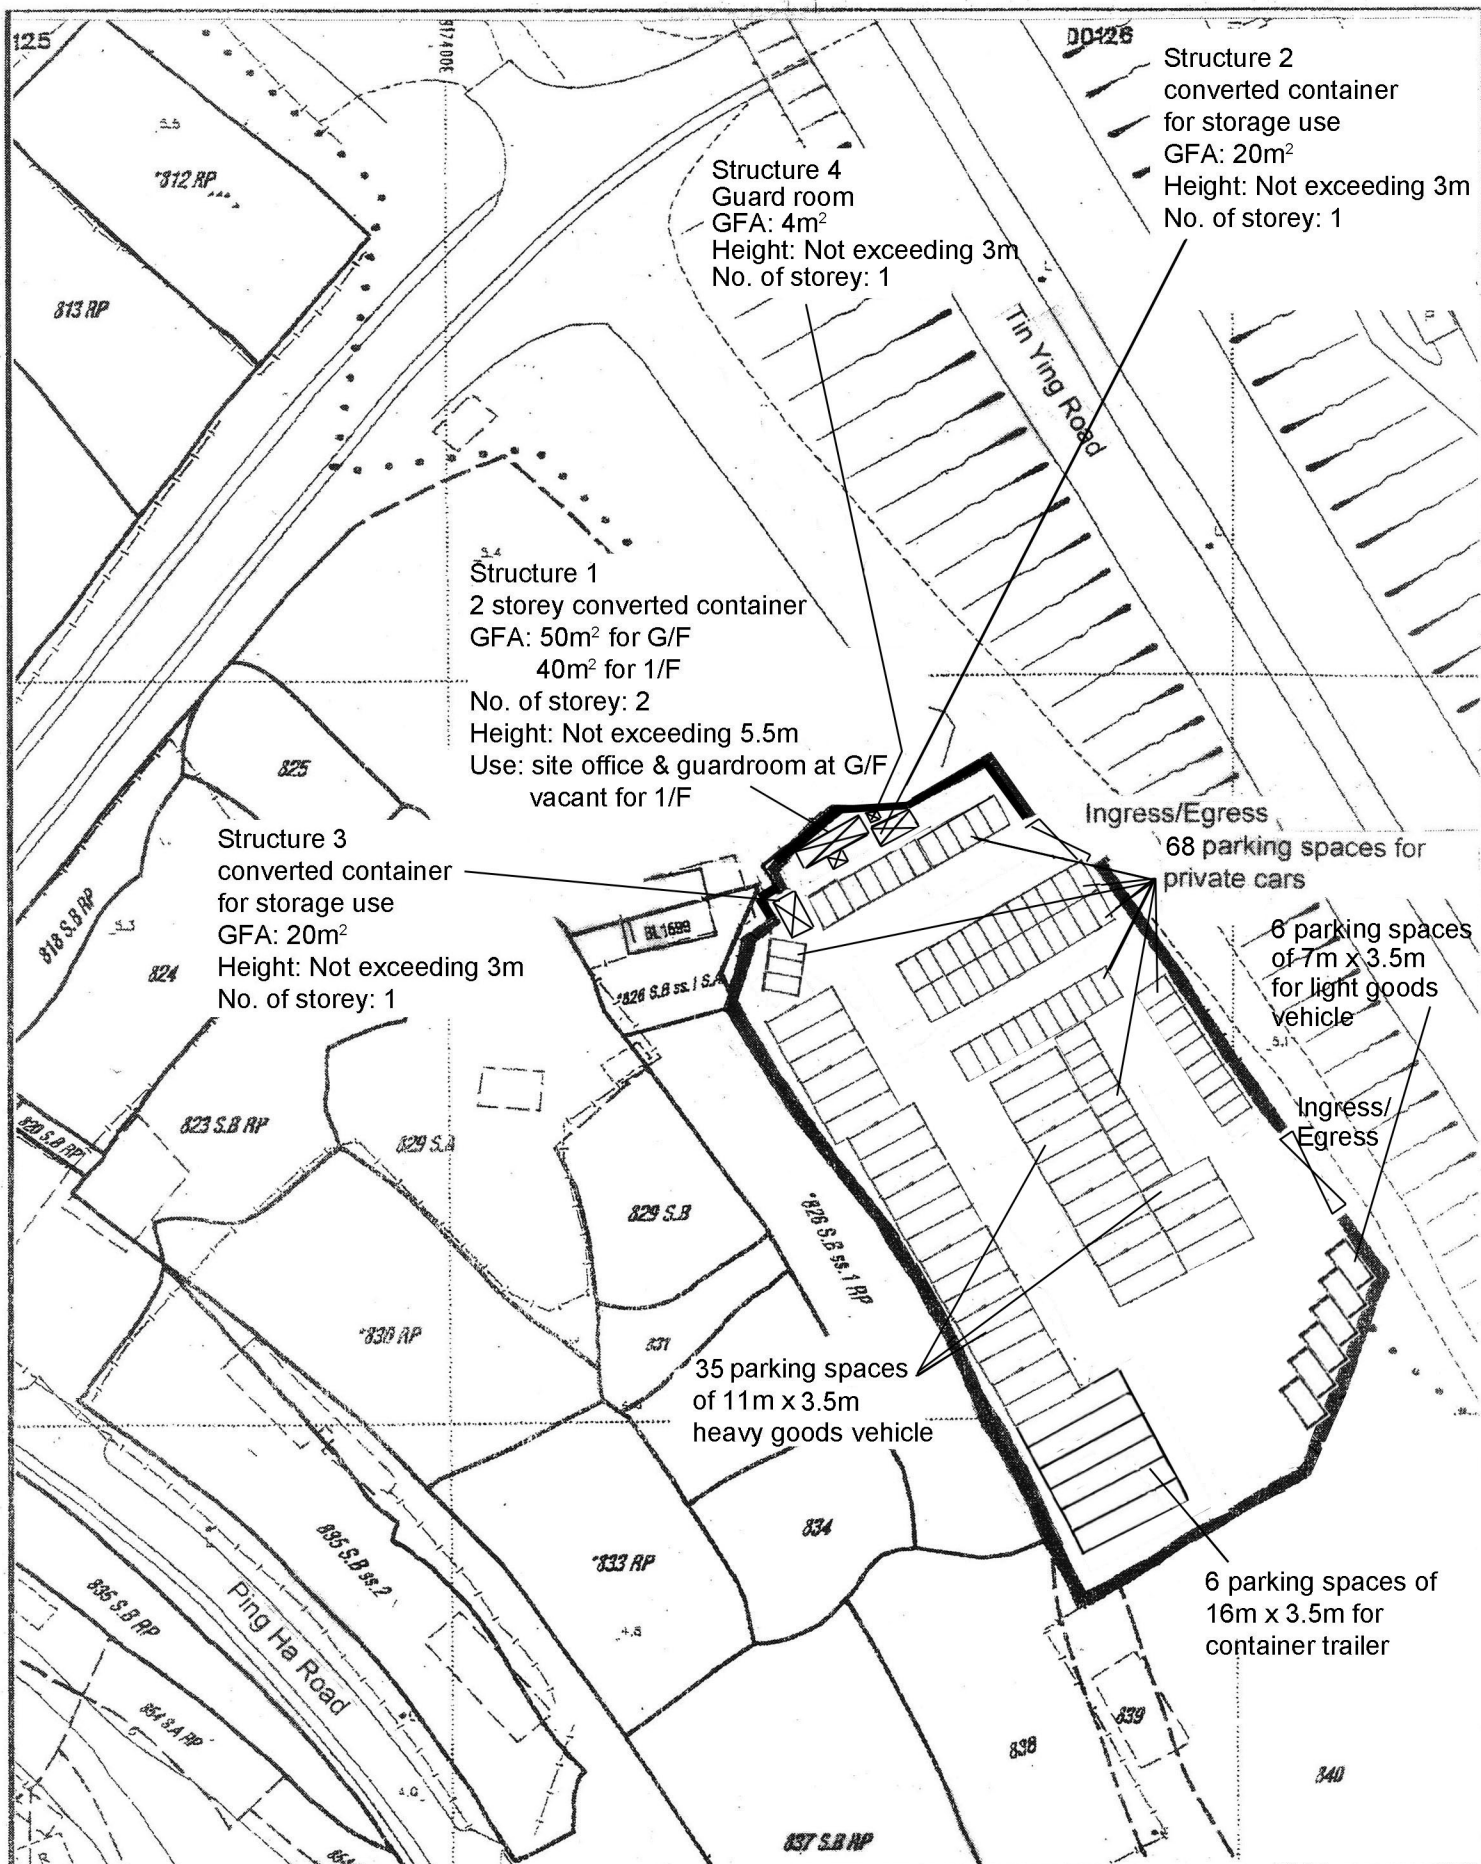

Project 項目名稱:

Proposed Temporary Public Vehicle Park for Private Cars, Light Goods Vehicles, Heavy Goods Vehicles & Container Trailers for a Period of 3 Years at Lots 826S.A(Part), 828, 839(Part), 840(Part) & Adjoining Government Land in D.D. 125, Ha Tsuen, Yuen Long, N.T.

Drawing Title 圖則:

Proposed Layout Plan


Drawing No. 圖號:

Figure 3

Remarks 備註:

Scale 比例:

1:1000

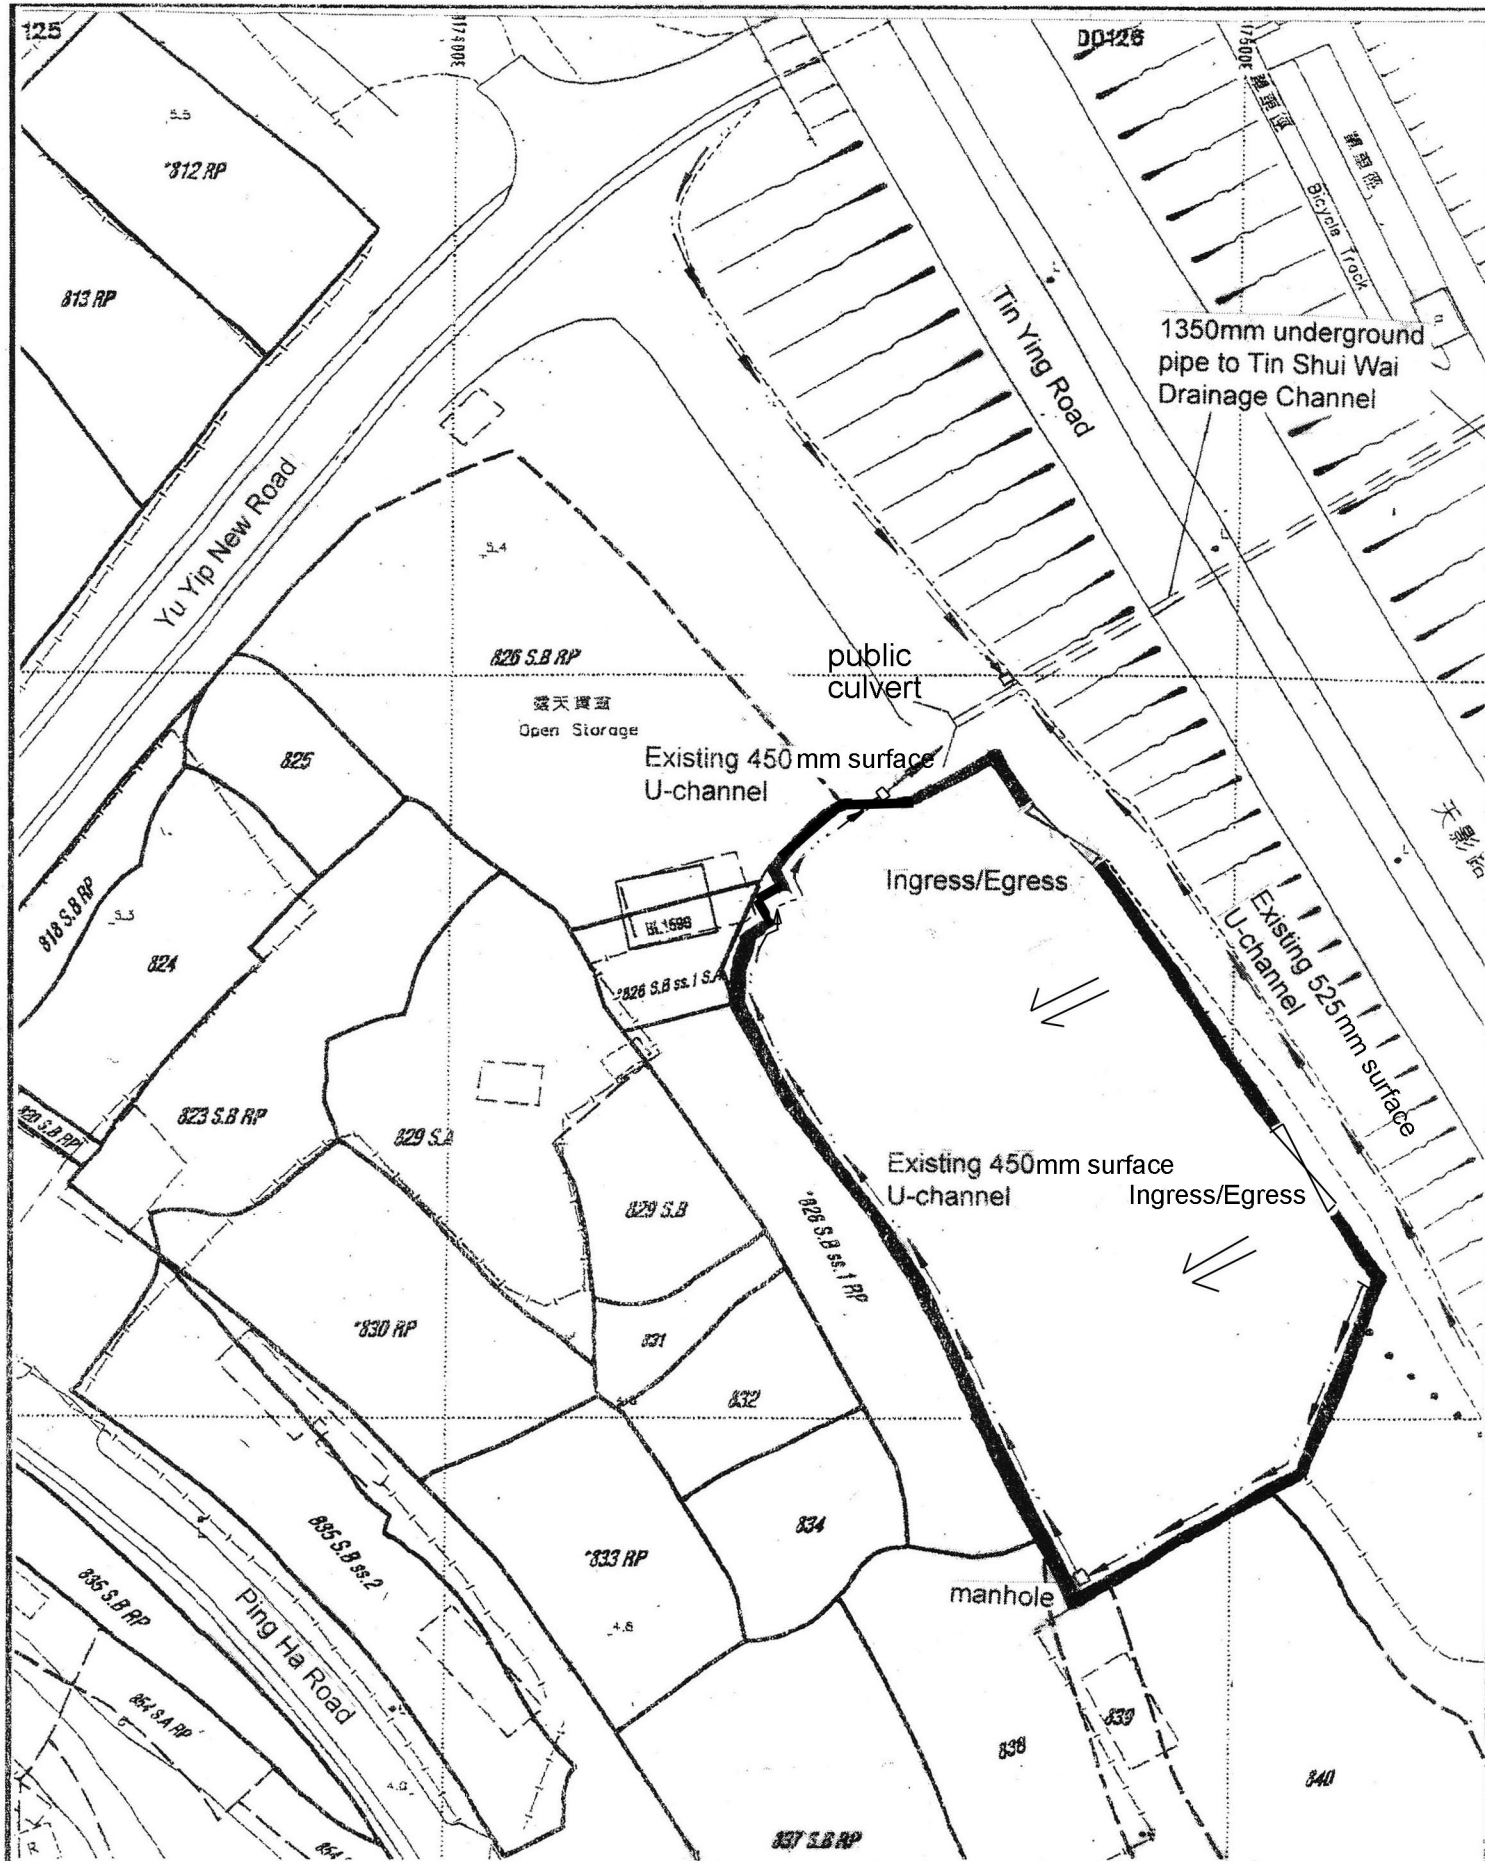

Project 項目名稱:

Proposed Temporary Public Vehicle Park for Private Cars, Light Goods Vehicles, Heavy Goods Vehicles & Container Trailers for a Period of 3 Years at Lots 826S.A(Part), 828, 839(Part), 840(Part) & Adjoining Government Land in D.D. 125, Ha Tsuen, Yuen Long, N.T.

Drawing Title 圖名:

As-built Drainage Plan

Drawing No. 圖號:

Figure 4

Remarks 備註:

Flow of Surface Runoff

Scale 比例:

1:1000