

## **Attachment 2**

# **Footbridge Design Checking Report**

Section 16 Planning Application for Proposed Minor  
Relaxation of Plot Ratio Restriction for Permitted  
Residential Development at Lot 94 in D.D. 388 and  
Adjoining Government Land in Castle Peak Road, Tsing Lung Tau

Residential Development at Lot 94 in  
D.D. 388 and Adjoining Government  
Land in Castle Peak Road, Tsing  
Lung Tau


Footbridge Design  
Checking Report

**AECOM**

Aug 2022

# Part A - Technical Drawings of Footbridge Modification

- NOTES:  
 1. THE RAMP STRUCTURAL ARRANGEMENT REFERS TO DRAWING SK 02  
 2. THE RAMP SECTIONS REFER TO DRAWING SK03

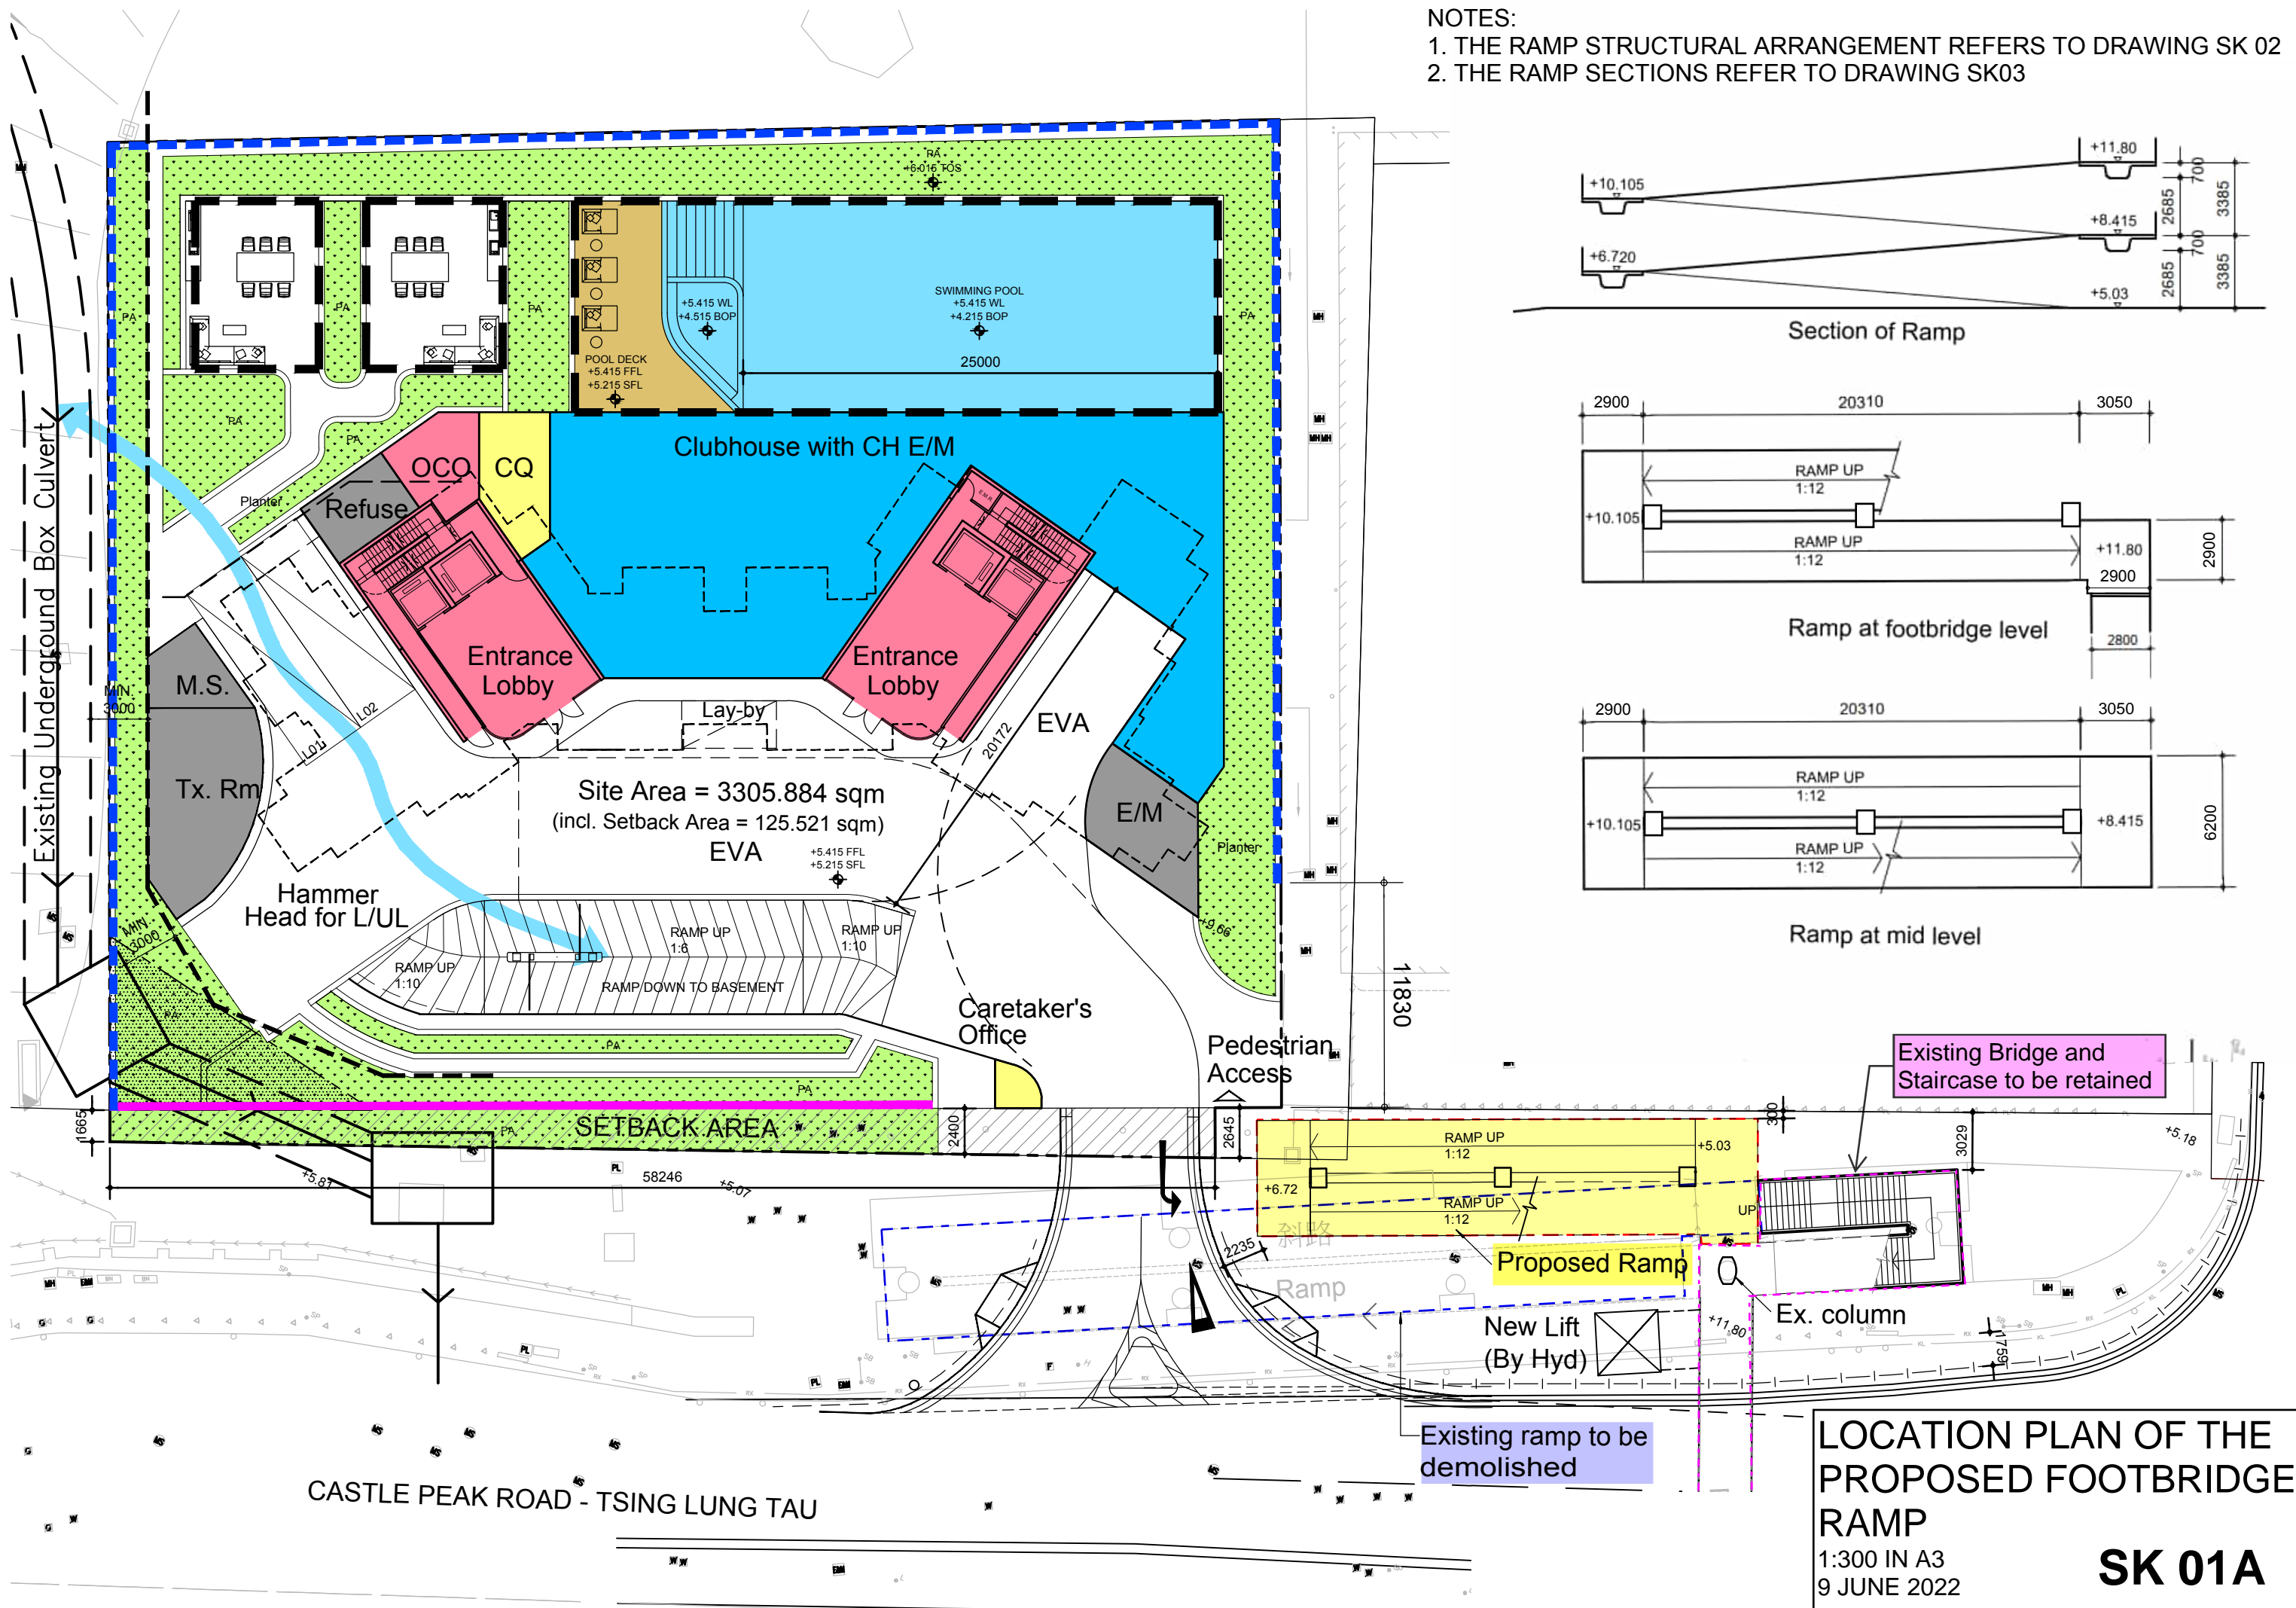

CASTLE PEAK ROAD - TSING LUNG TAU

**LOCATION PLAN OF THE PROPOSED FOOTBRIDGE RAMP**  
 1:300 IN A3  
 9 JUNE 2022  
**SK 01A**

**PROJECT**

DD388 LOT 94, CASTLE  
PEAK ROAD - TSING  
LUNG TAU

**CLIENT**

業主

**CONSULTANT**

AECOM Asia Company Ltd.  
www.aecom.com

**SUB-CONSULTANTS**

分判工程師/公司

**ISSUE/REVISION**

修改

I/R	DATE	DESCRIPTION	CHK.

I/R	DATE	DESCRIPTION	CHK.

**STATUS**

備註

**SCALE**      **DIMENSION UNIT**

A1 AS SHOWN      MILLIMETER

**KEY PLAN**

索引圖

**PROJECT NO.**

項目編號

**CONTRACT NO.**

合約編號

**SHEET TITLE**

FOOTBRIDGE RAMP STRUCTURAL  
ARRANGEMENT

**SHEET NUMBER**


圖紙編號

SK 02A


ISO A1 594mm x 841mm      Approved: SN      Checked: CY      Designer: IW      Project Management Initials:

PATH: C:\Users\Wong\OneDrive - AECOM\Desktop\Castle Peak Road\Study To Castle Peak Road\Study\1\Footbridge Framing Plan And Details V1.dwg


This drawing has been prepared for the use of AECOM's client. It may not be used, modified, reproduced or relied upon by third parties, except as agreed by AECOM or as required by law. AECOM accepts no responsibility, and denies any liability whatsoever, for any party that uses or relies on this drawing without AECOM's express written consent. Do not scale this document. All measurements must be obtained from the stated dimensions.

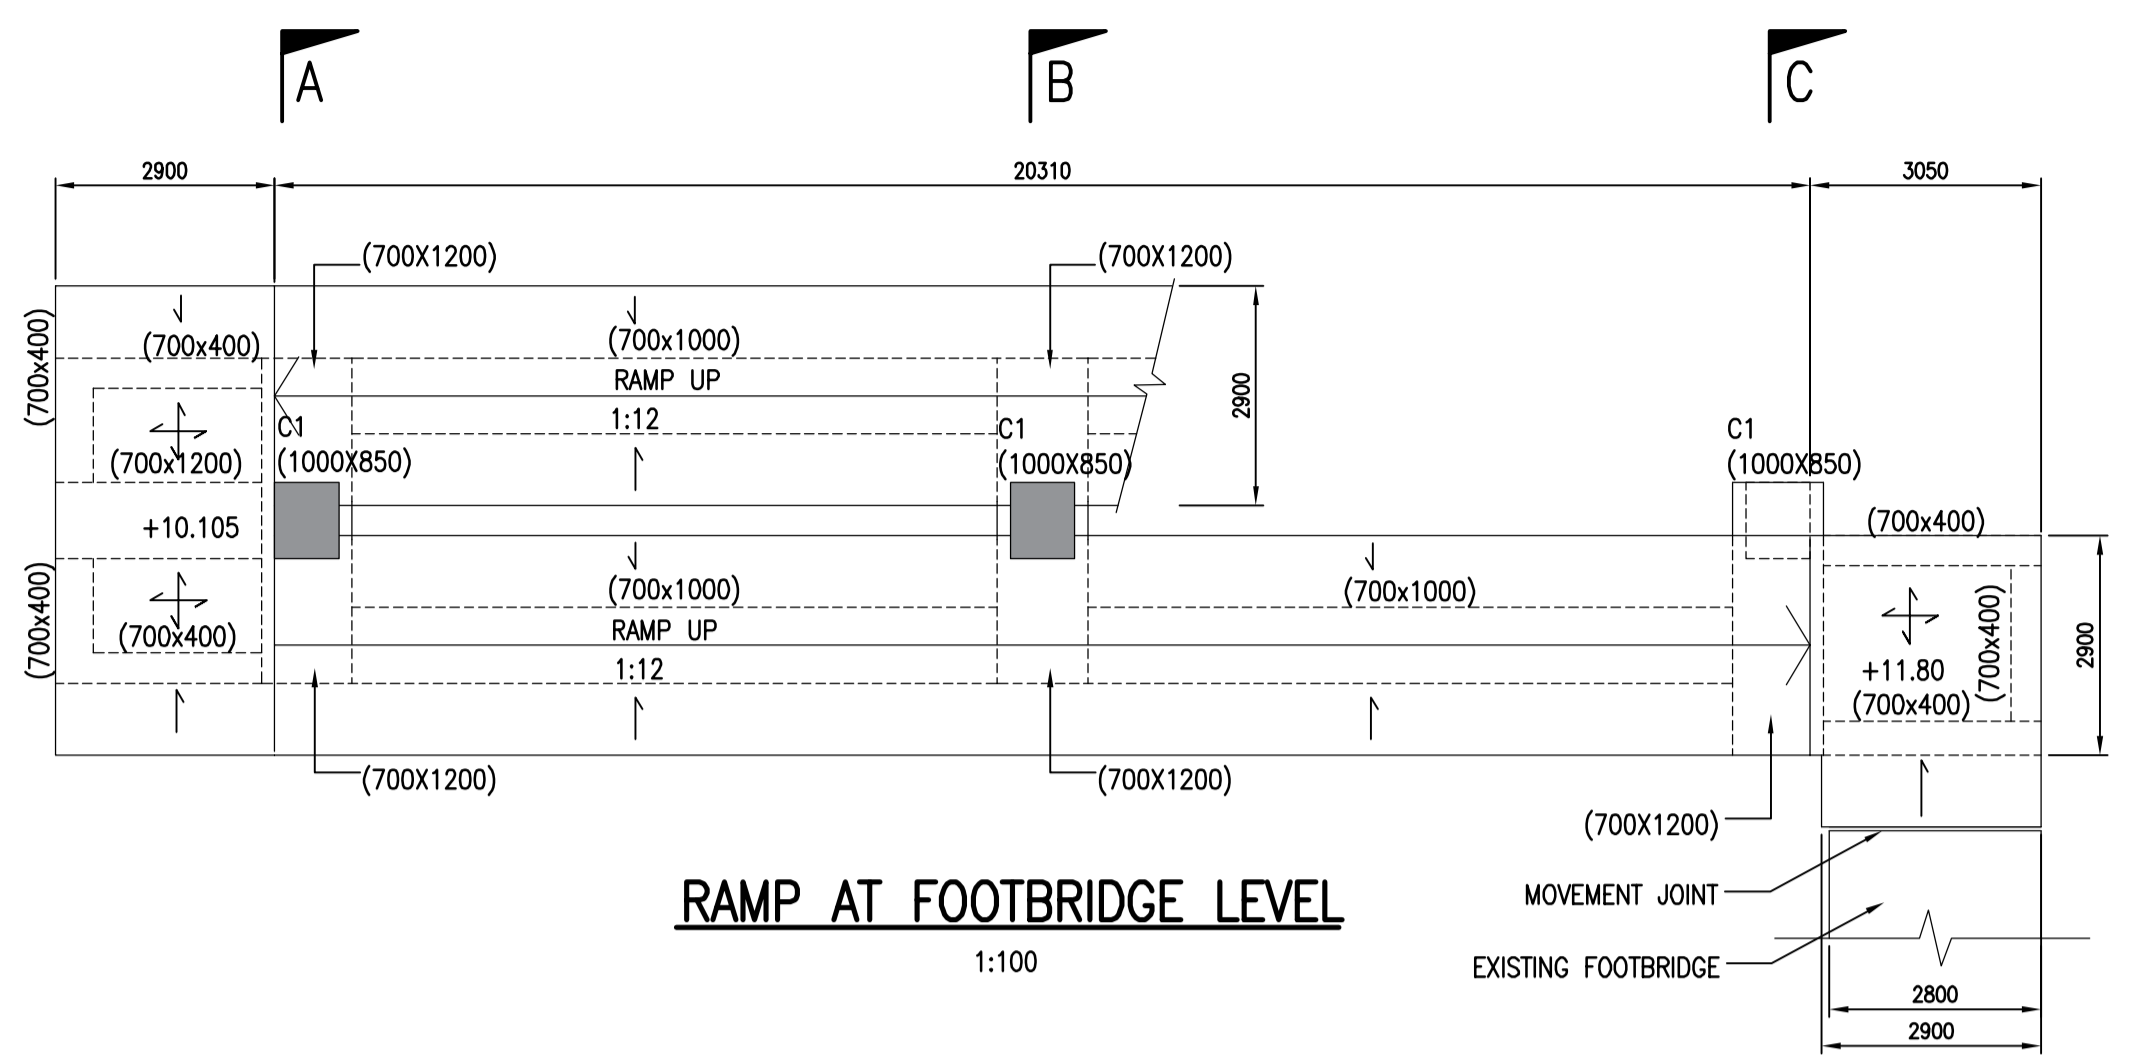

**RAMP AT FOOTBRIDGE LEVEL**  
1:100

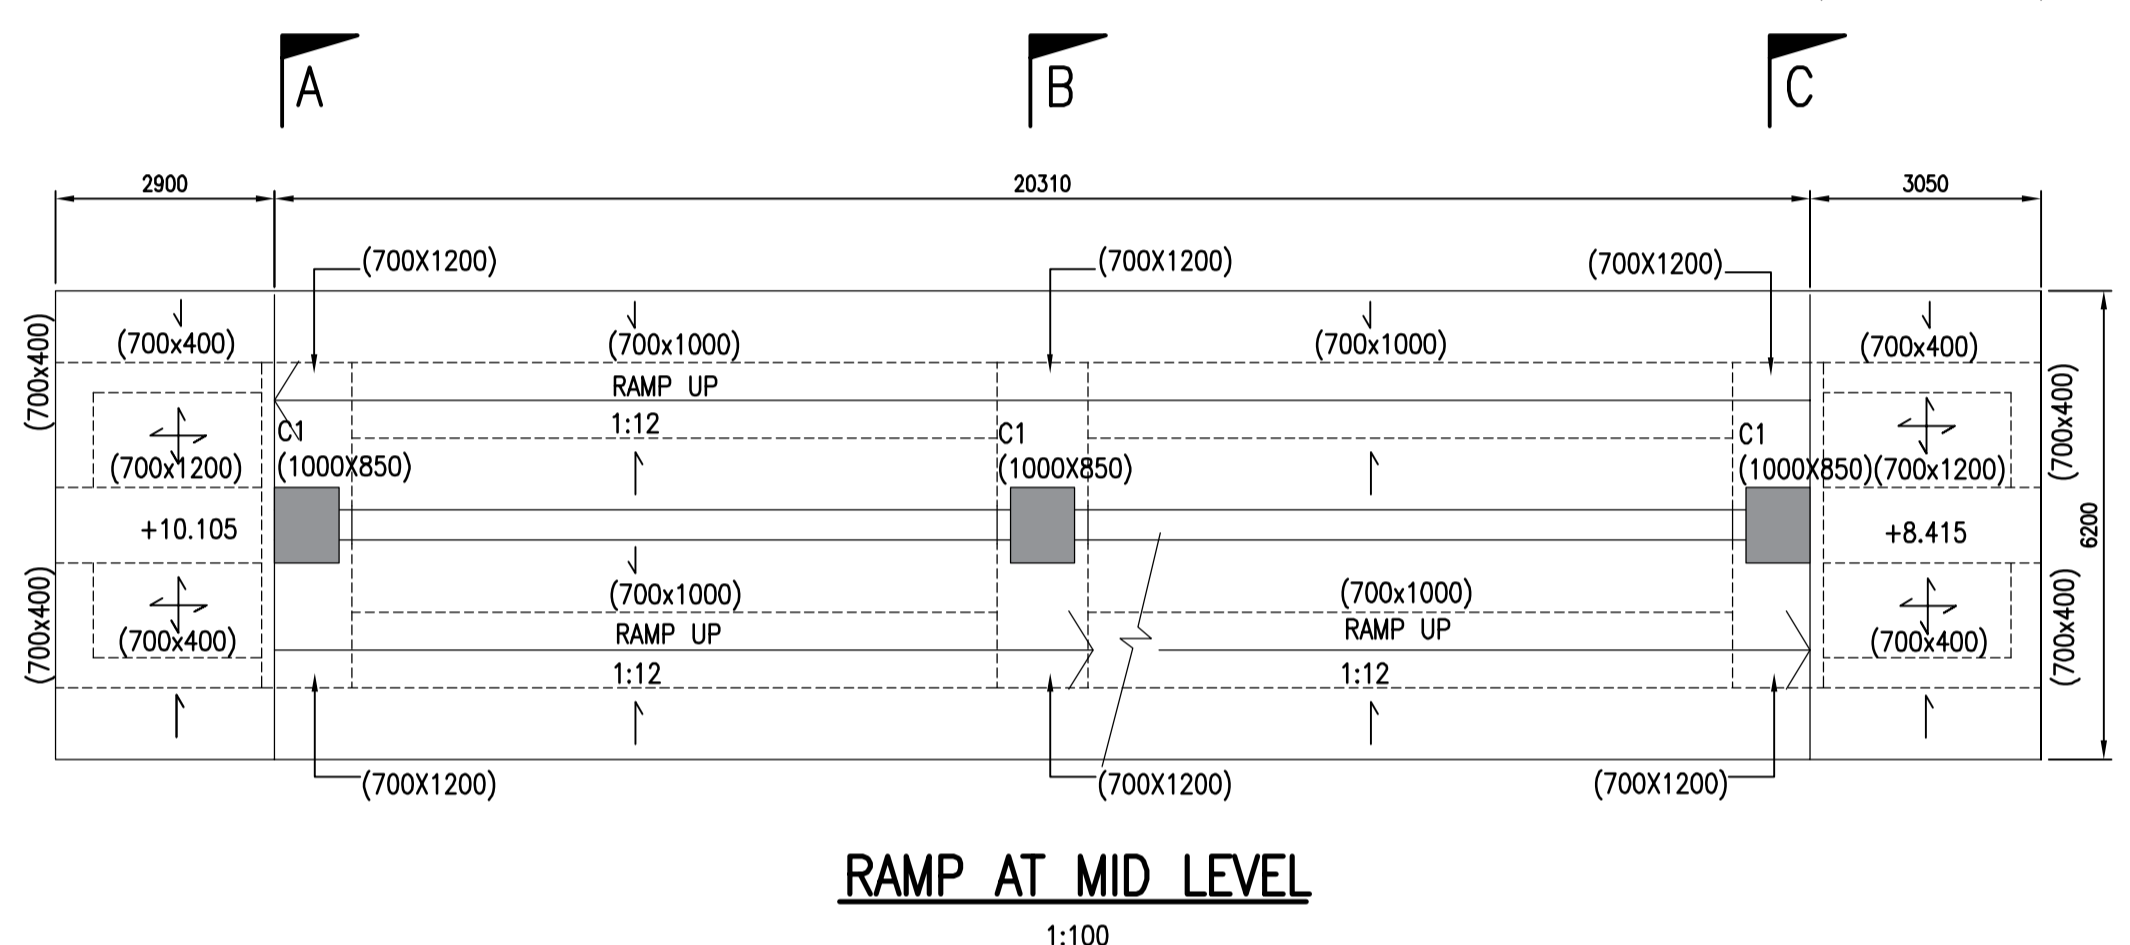


**RAMP AT MID LEVEL**  
1:100

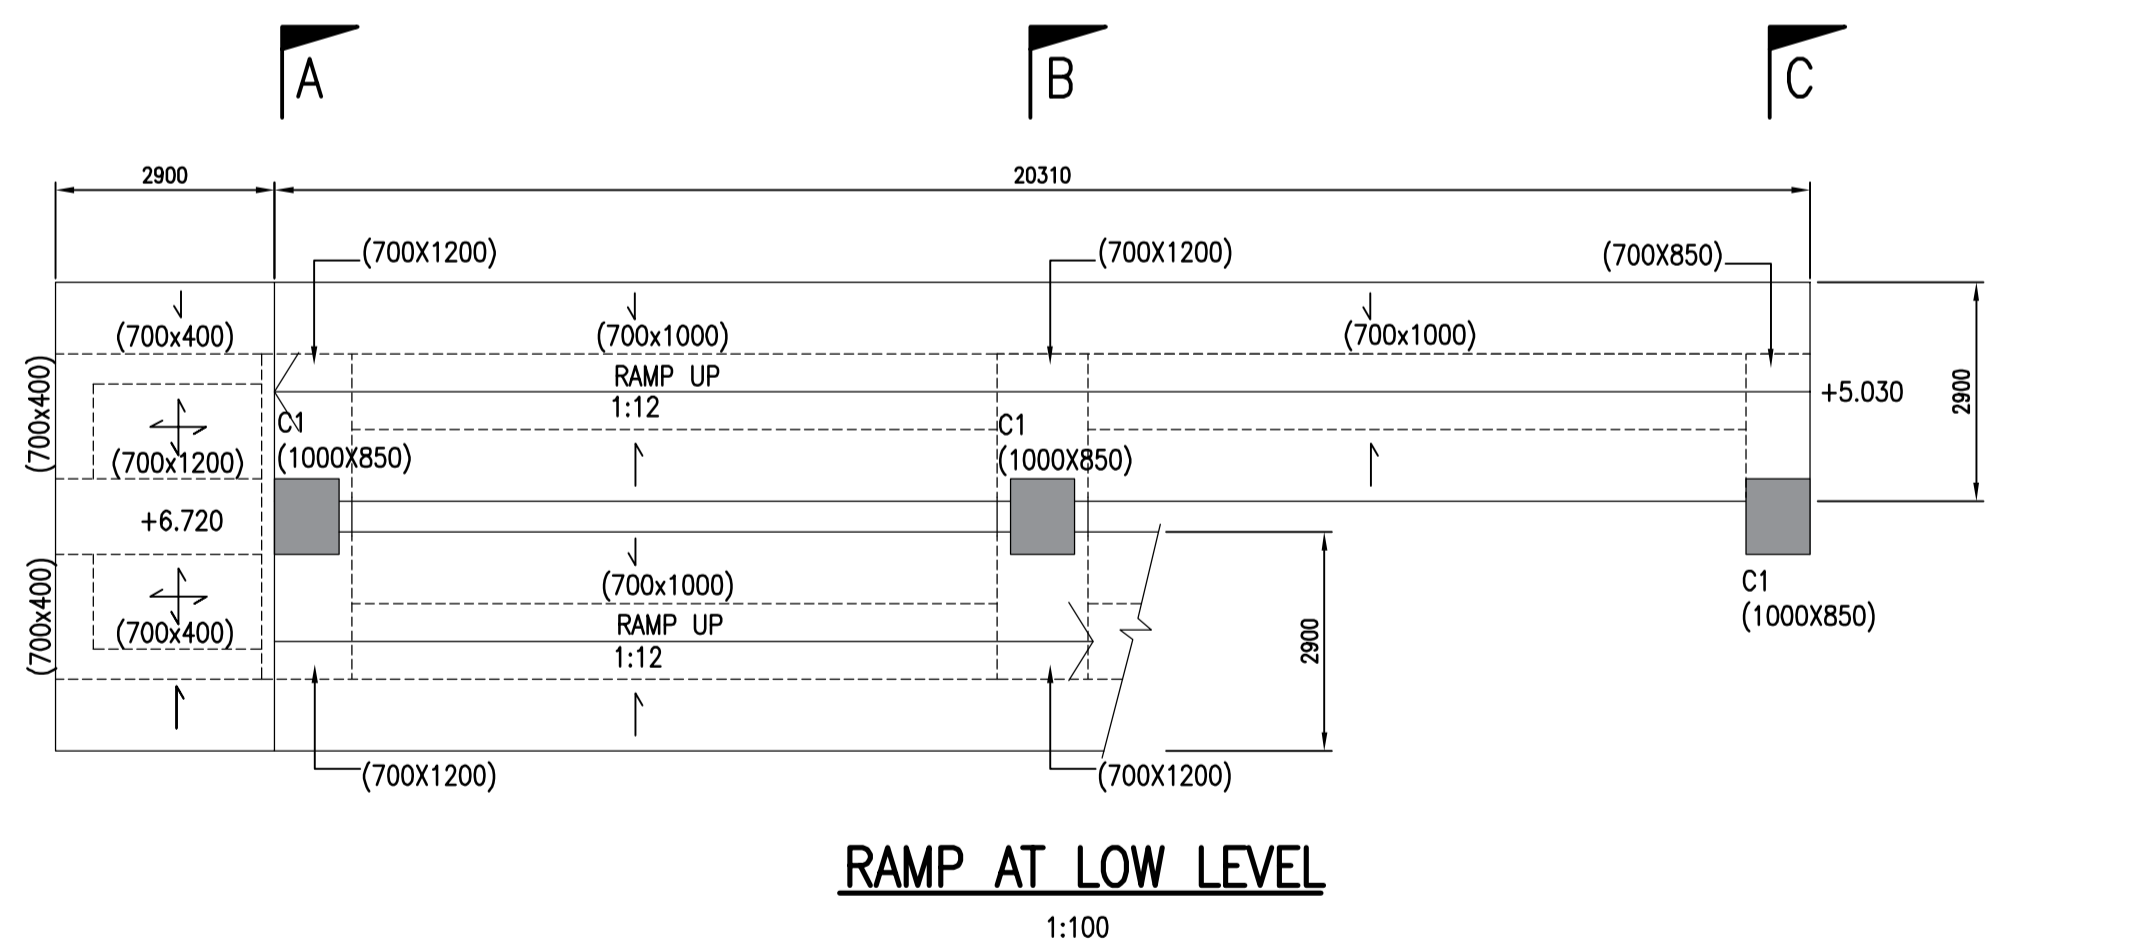


**RAMP AT LOW LEVEL**  
1:100


PATH: C:\Users\Wong\OneDrive - AECOM\Desktop\Castle Peak Road\Study To Castle Peak Road\Bridge Prelim Sketch\From Draft\1\Footbridge Framing Plan And Details V1.dwg  
 Project Management Initials: Designer: IW Checked: CY Approved: SN  
 ISO A1 594mm x 841mm

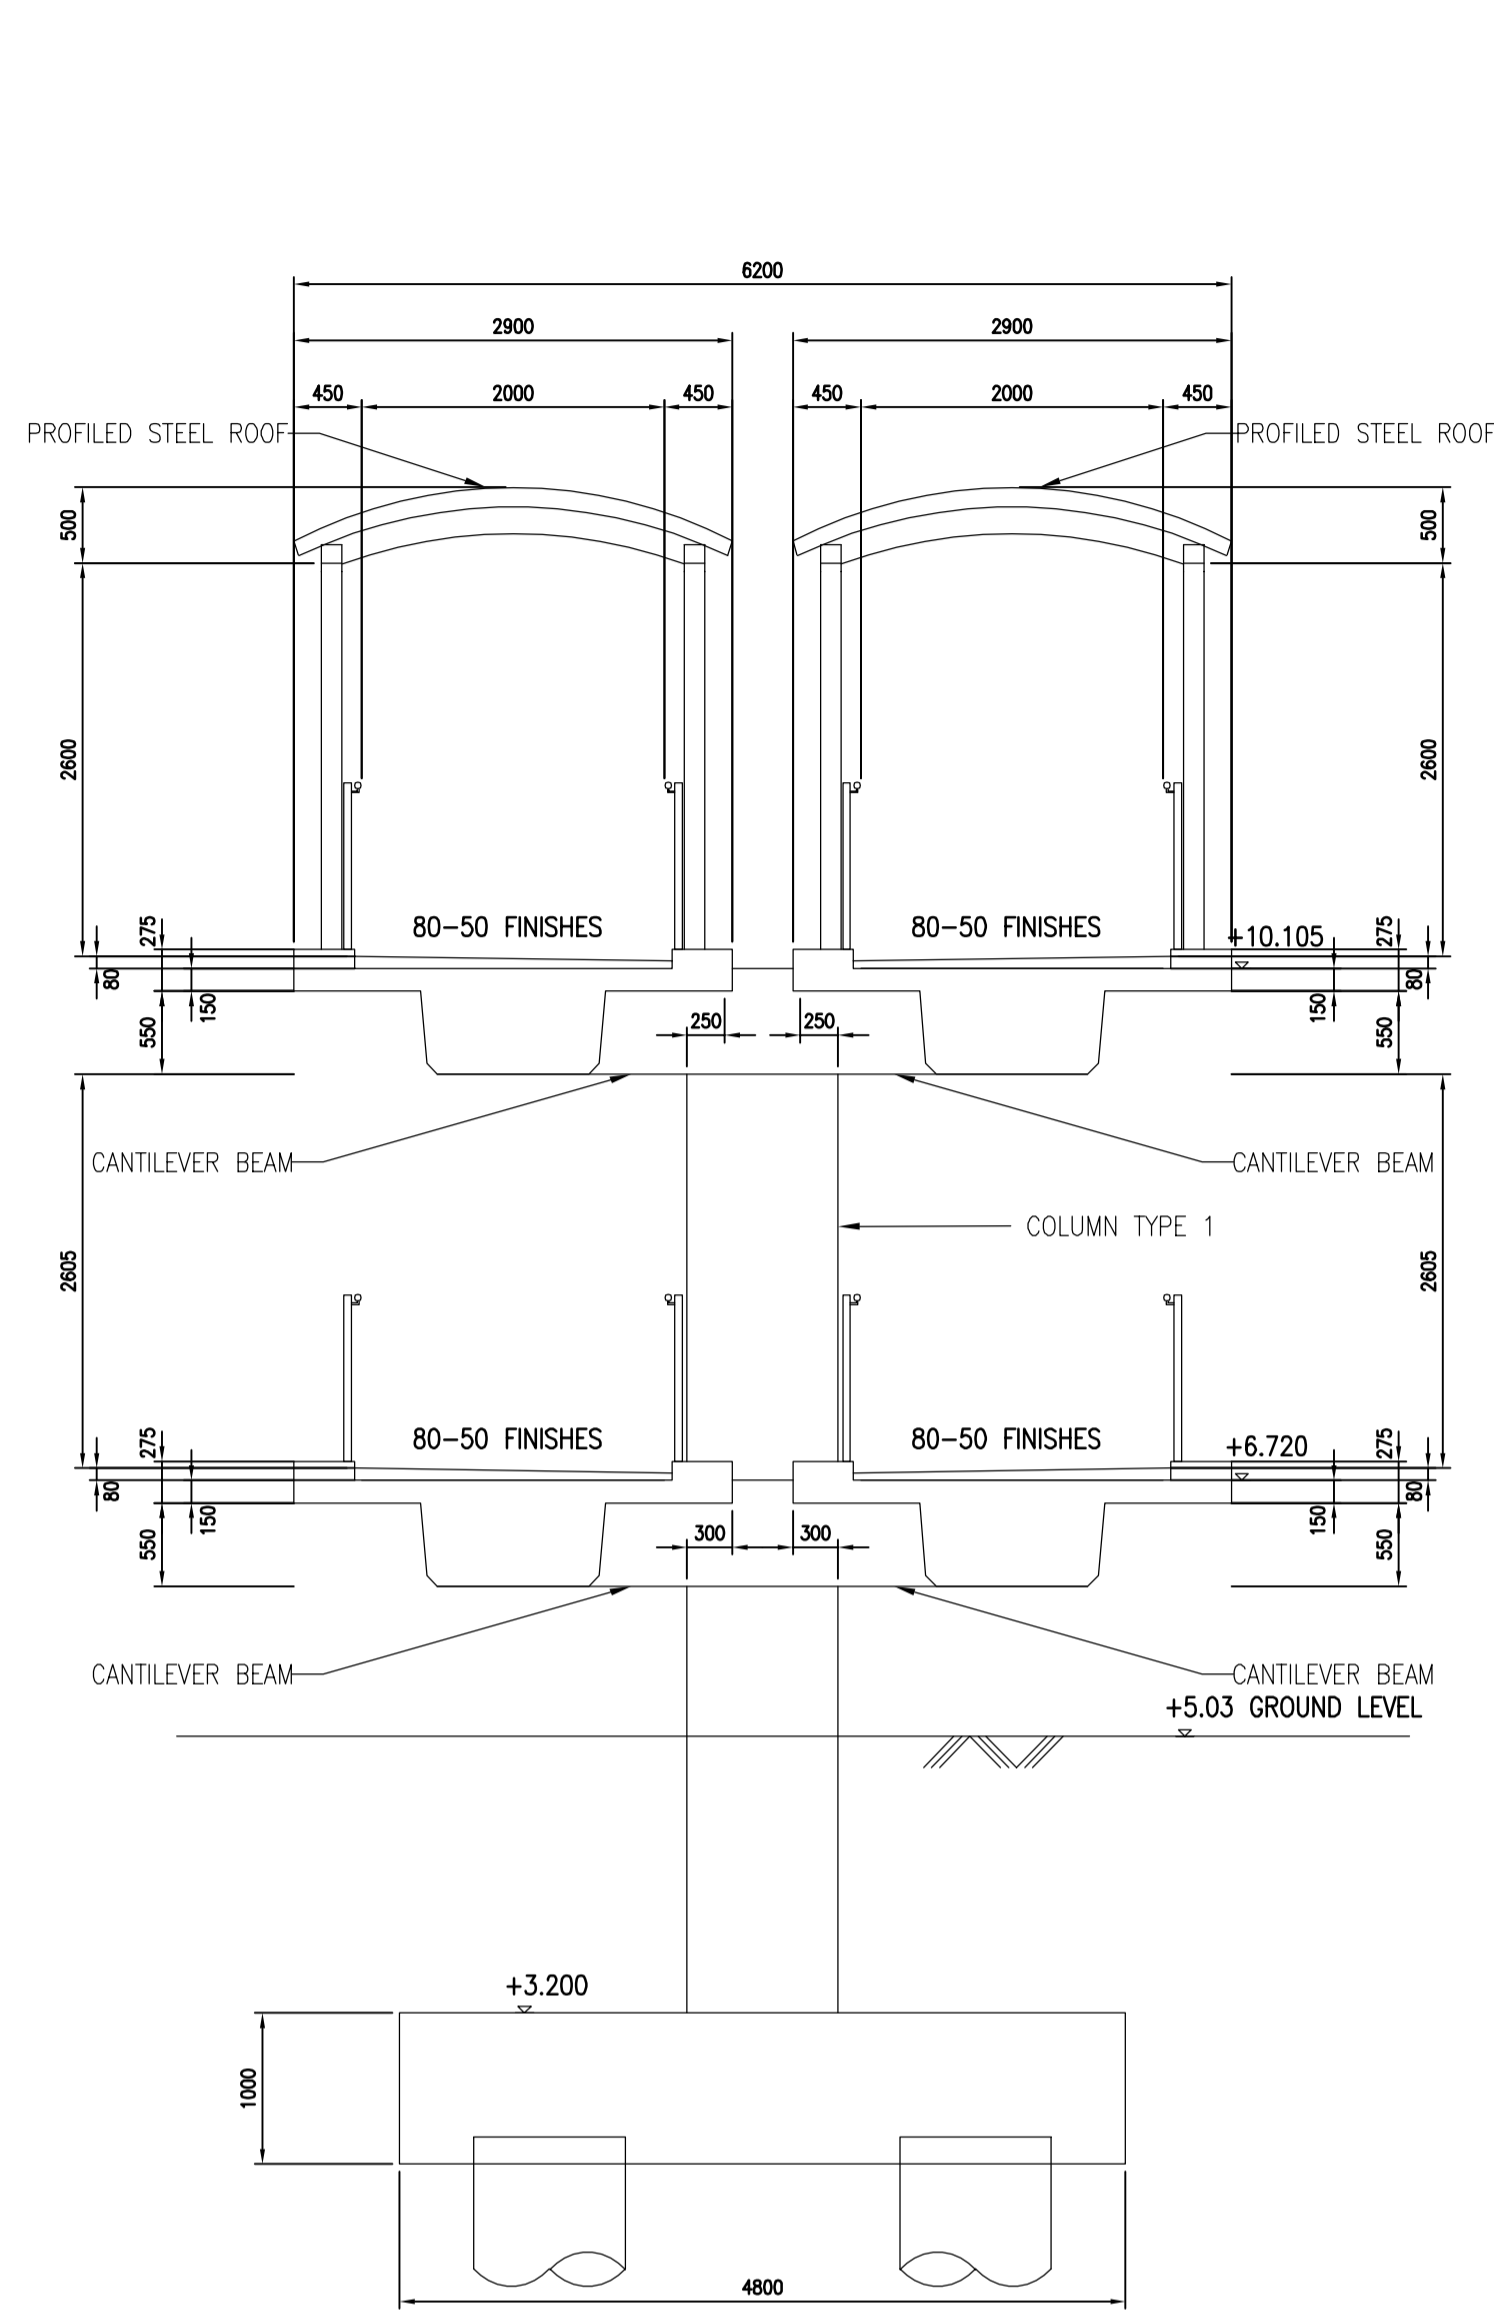


**SECTION A**  
1:50

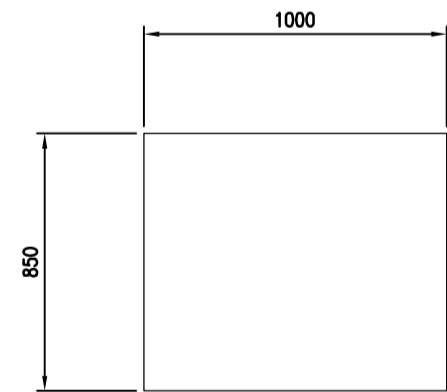

**COLUMN PROFILE TYPE 1 (C1)**  
1:25

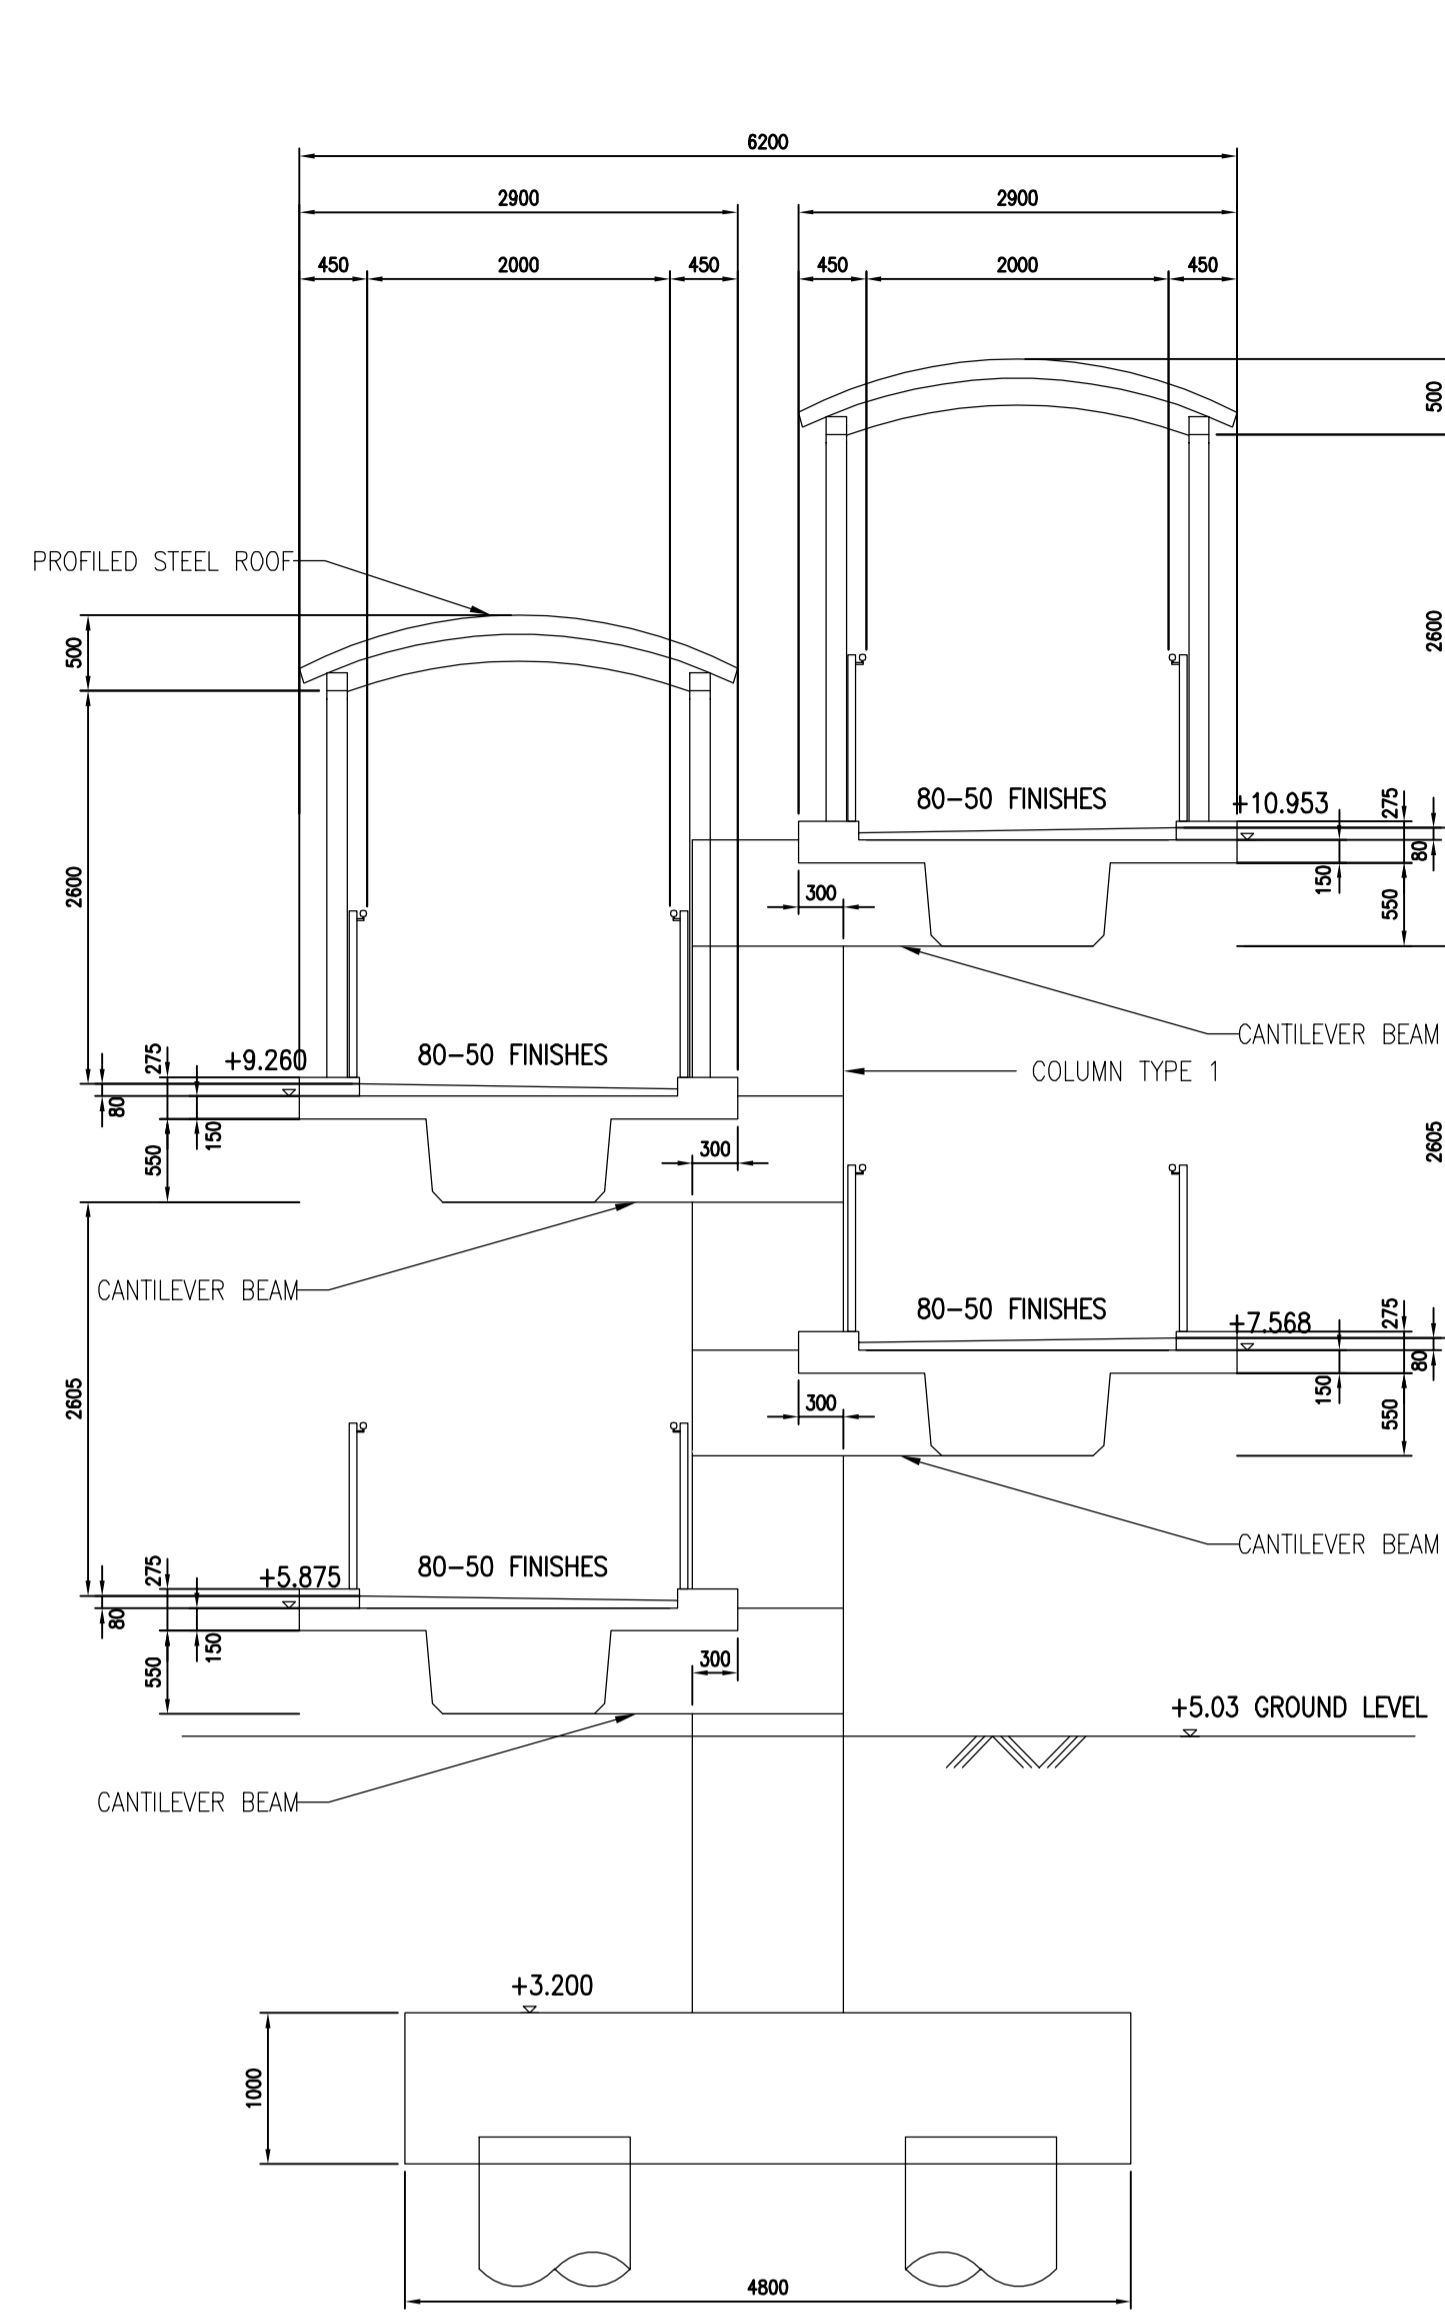

**SECTION B**  
1:50

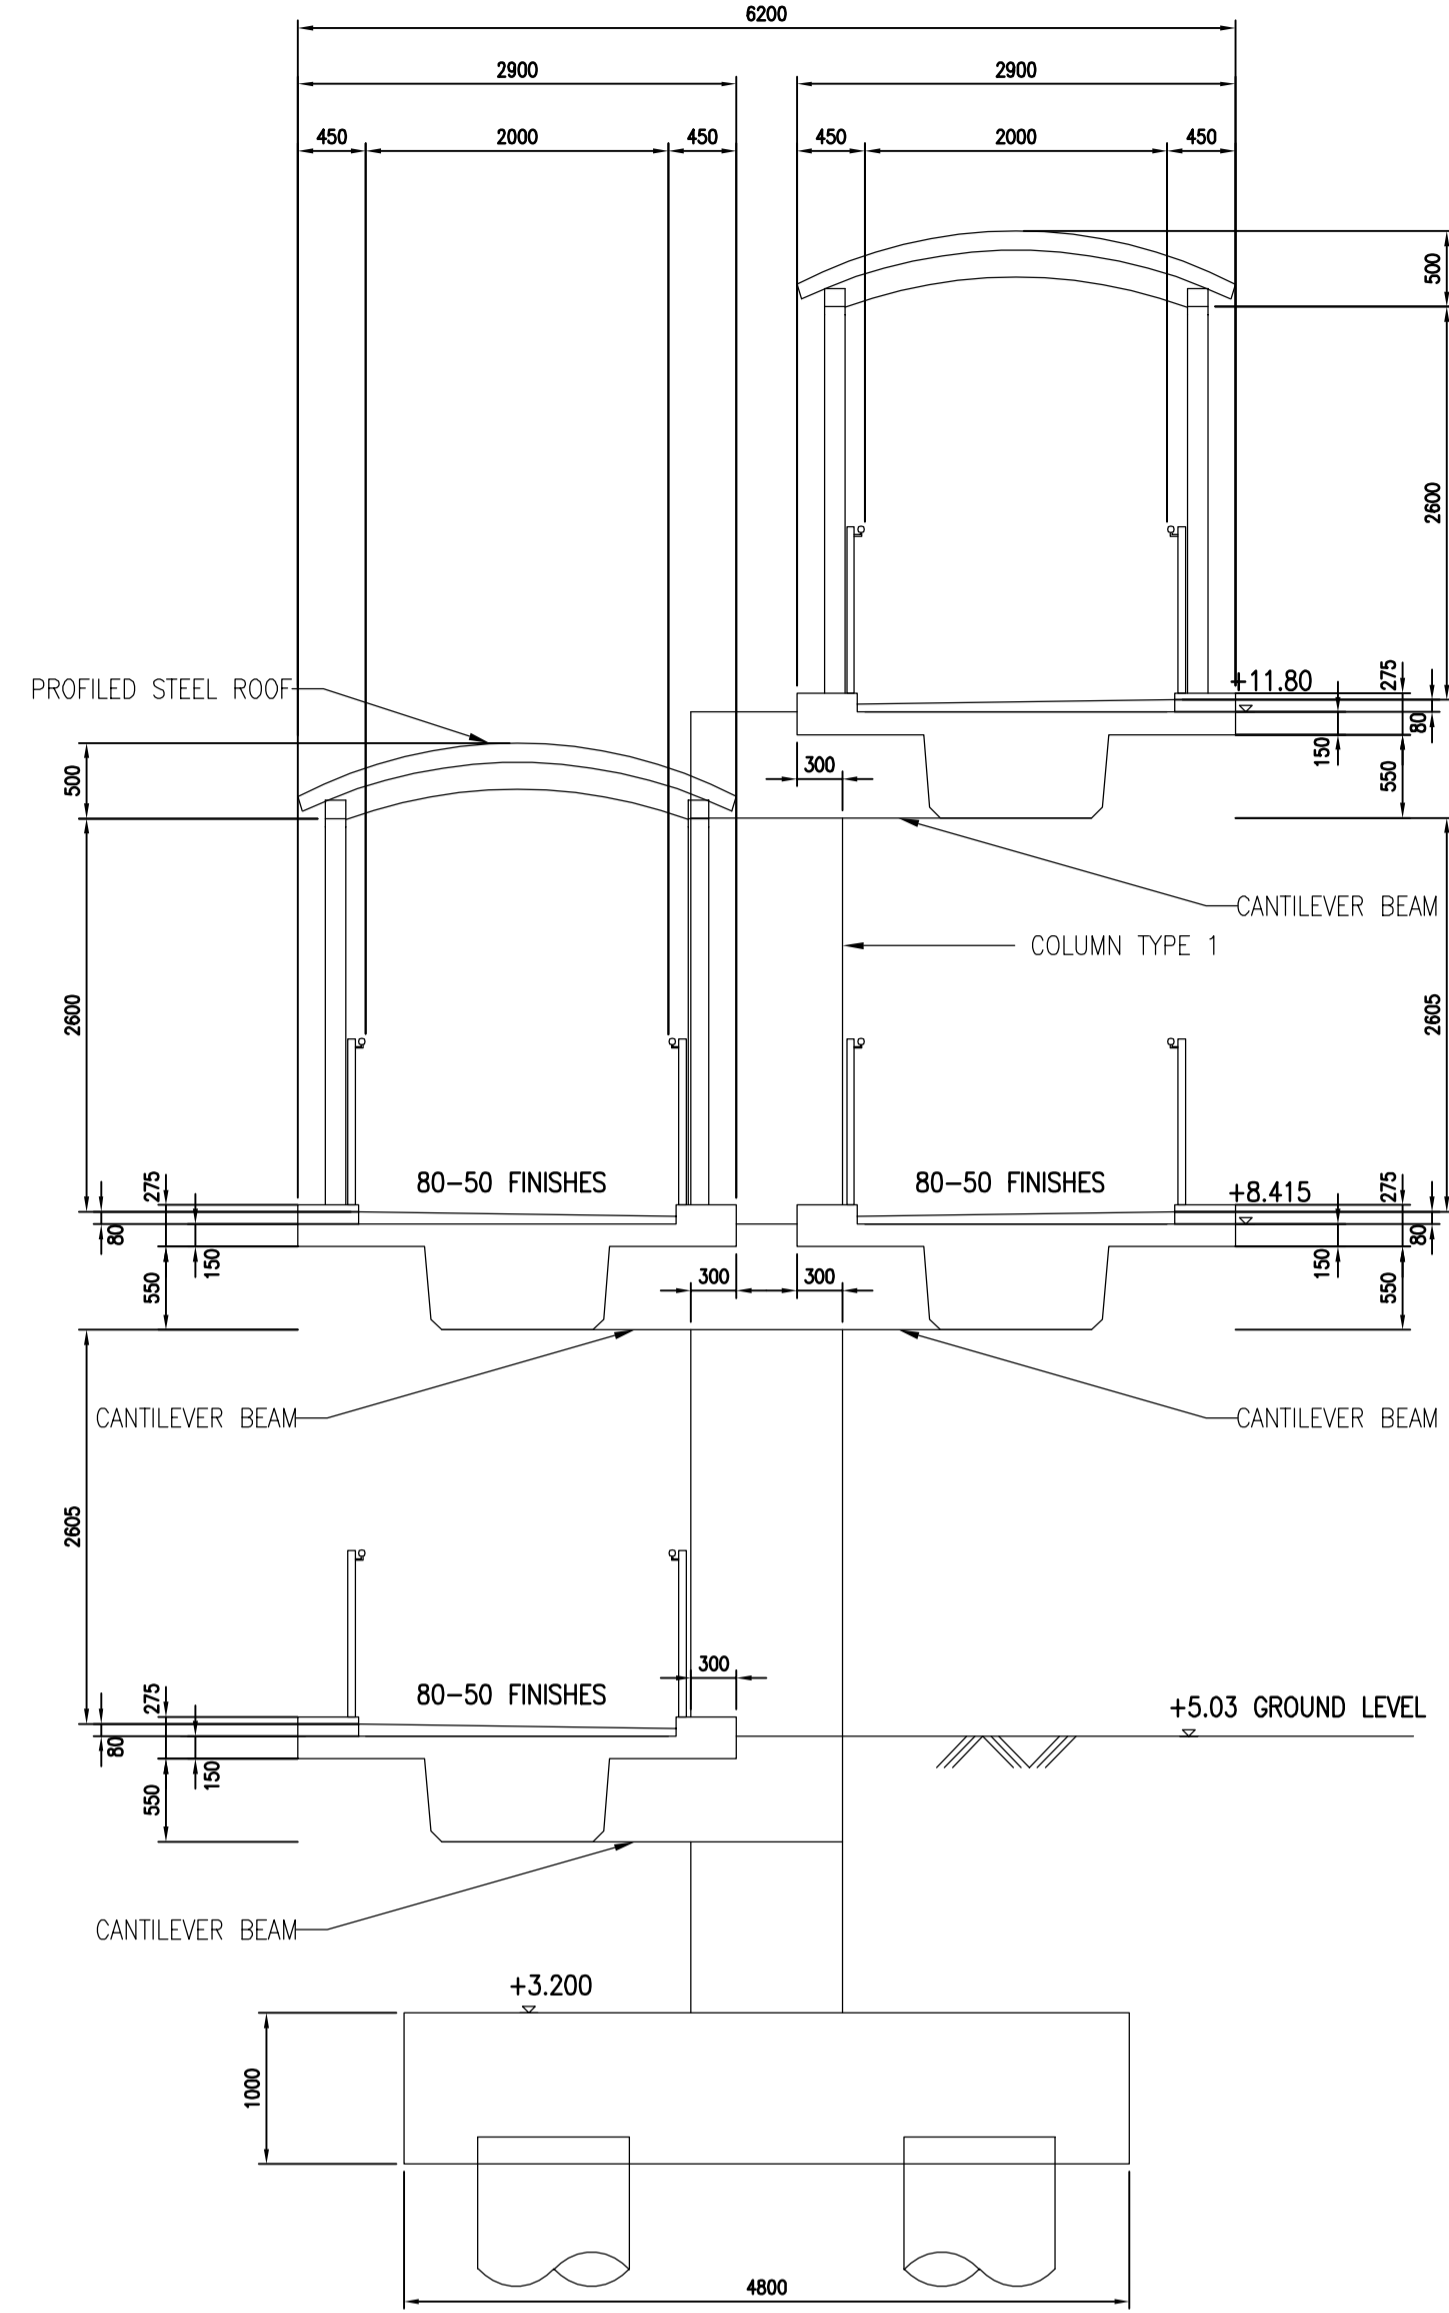

**SECTION C**  
1:50



I/R	DATE	DESCRIPTION	CHK.

This drawing has been prepared for the use of AECOM's client. It may not be used, modified, reproduced or relied upon by third parties, except as agreed by AECOM or as required by law. AECOM accepts no responsibility, and denies any liability whatsoever, to any party that uses or relies on this drawing without AECOM's express written consent. Do not scale this document. All measurements must be obtained from the stated dimensions.


# Part B - As-built Footbridge Drawings

Note


1. For General Notes see drg. 90612/T/FB/5100.

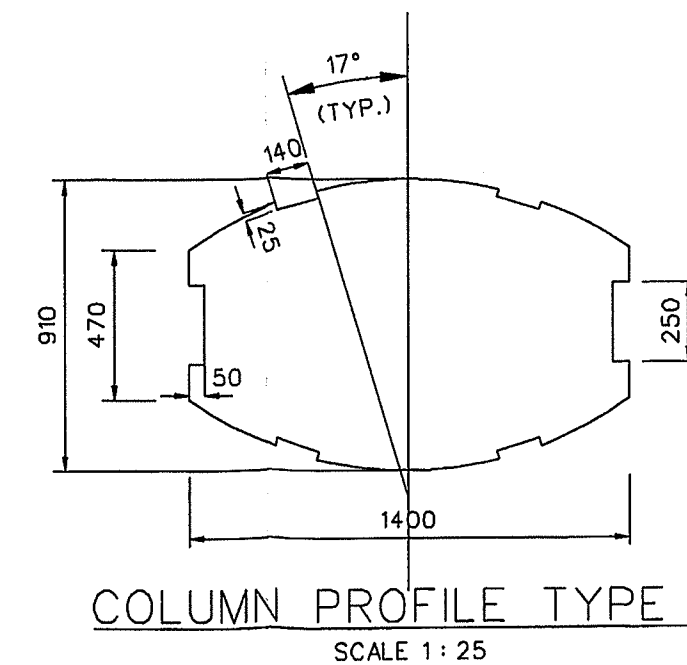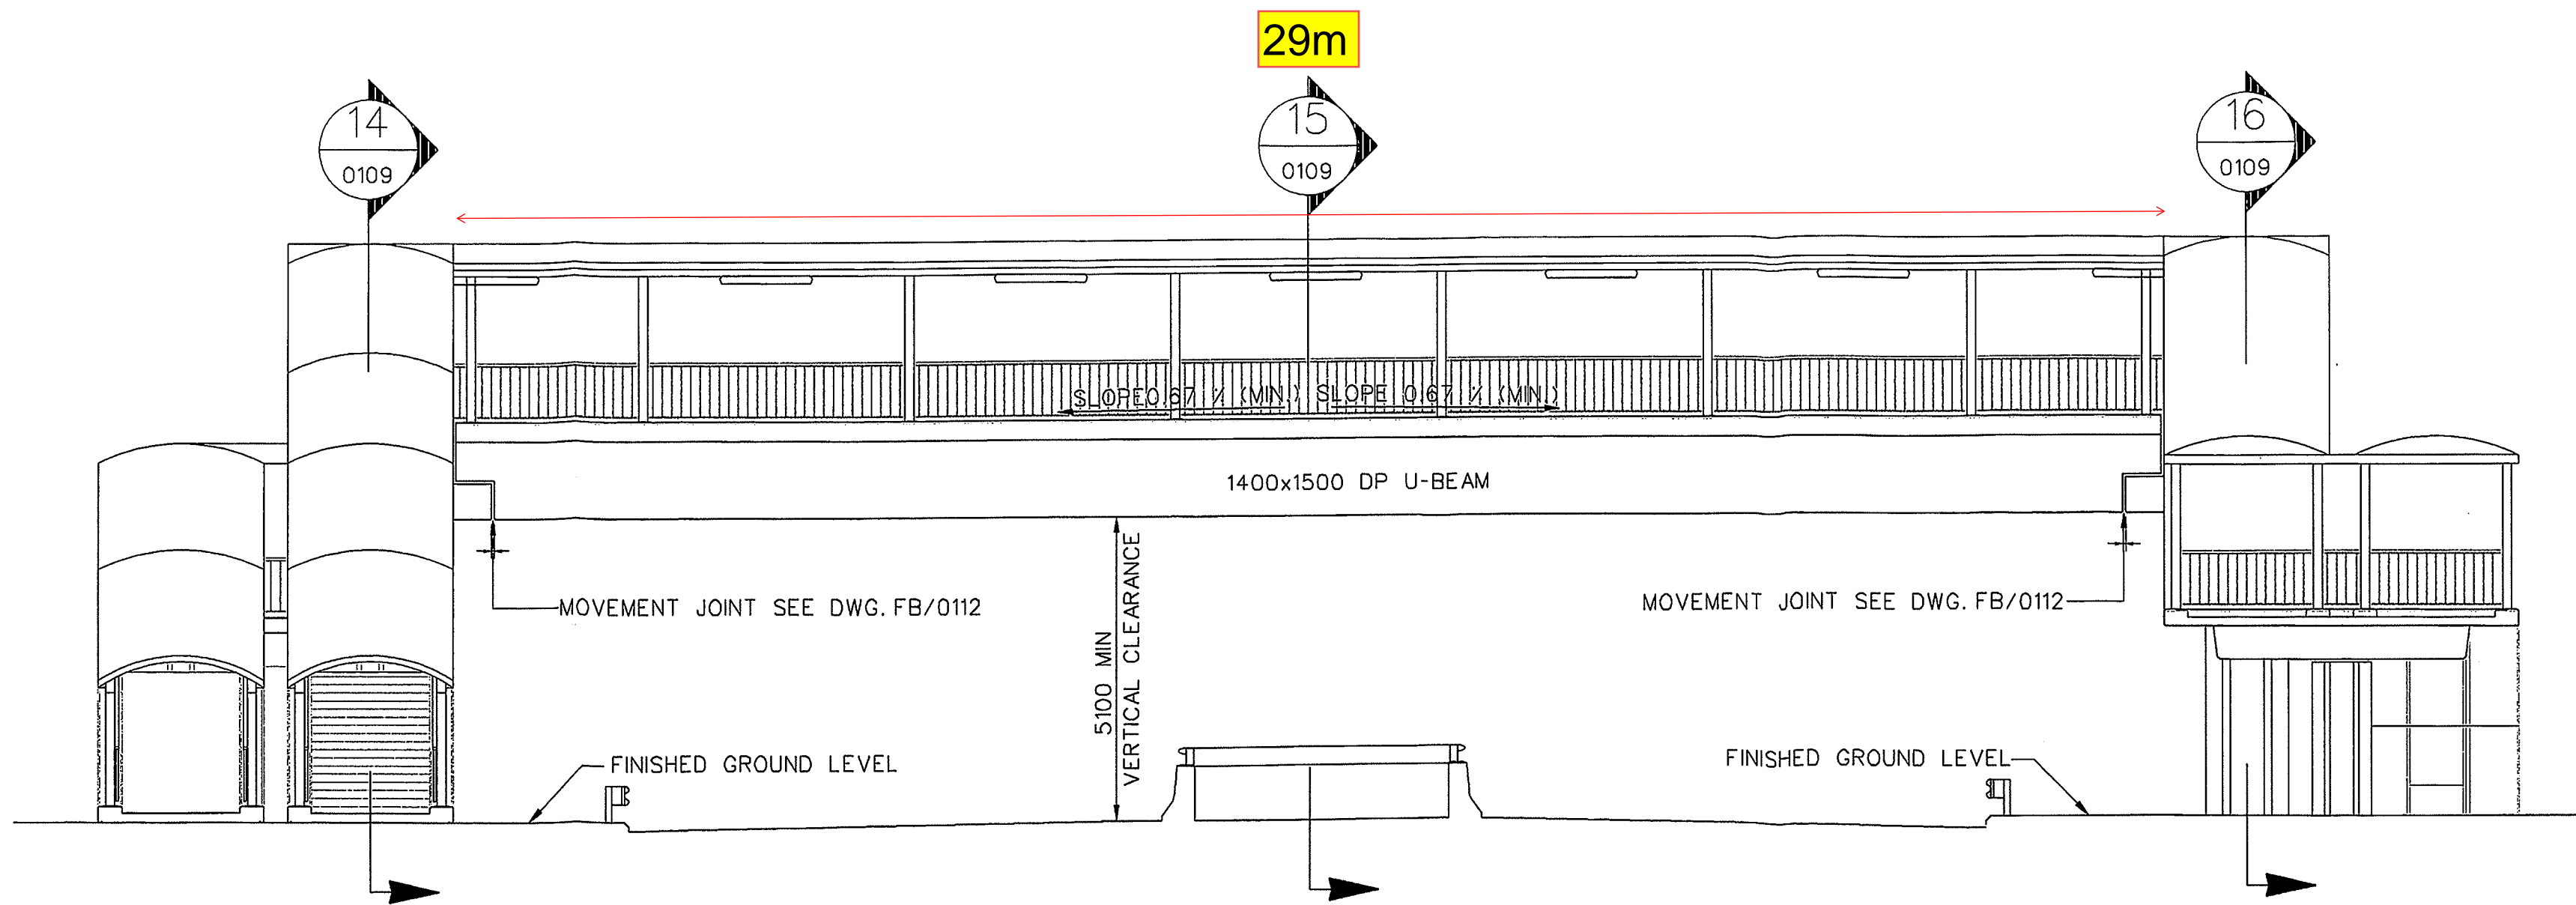


ELEVATION 13  
SCALE 1:50

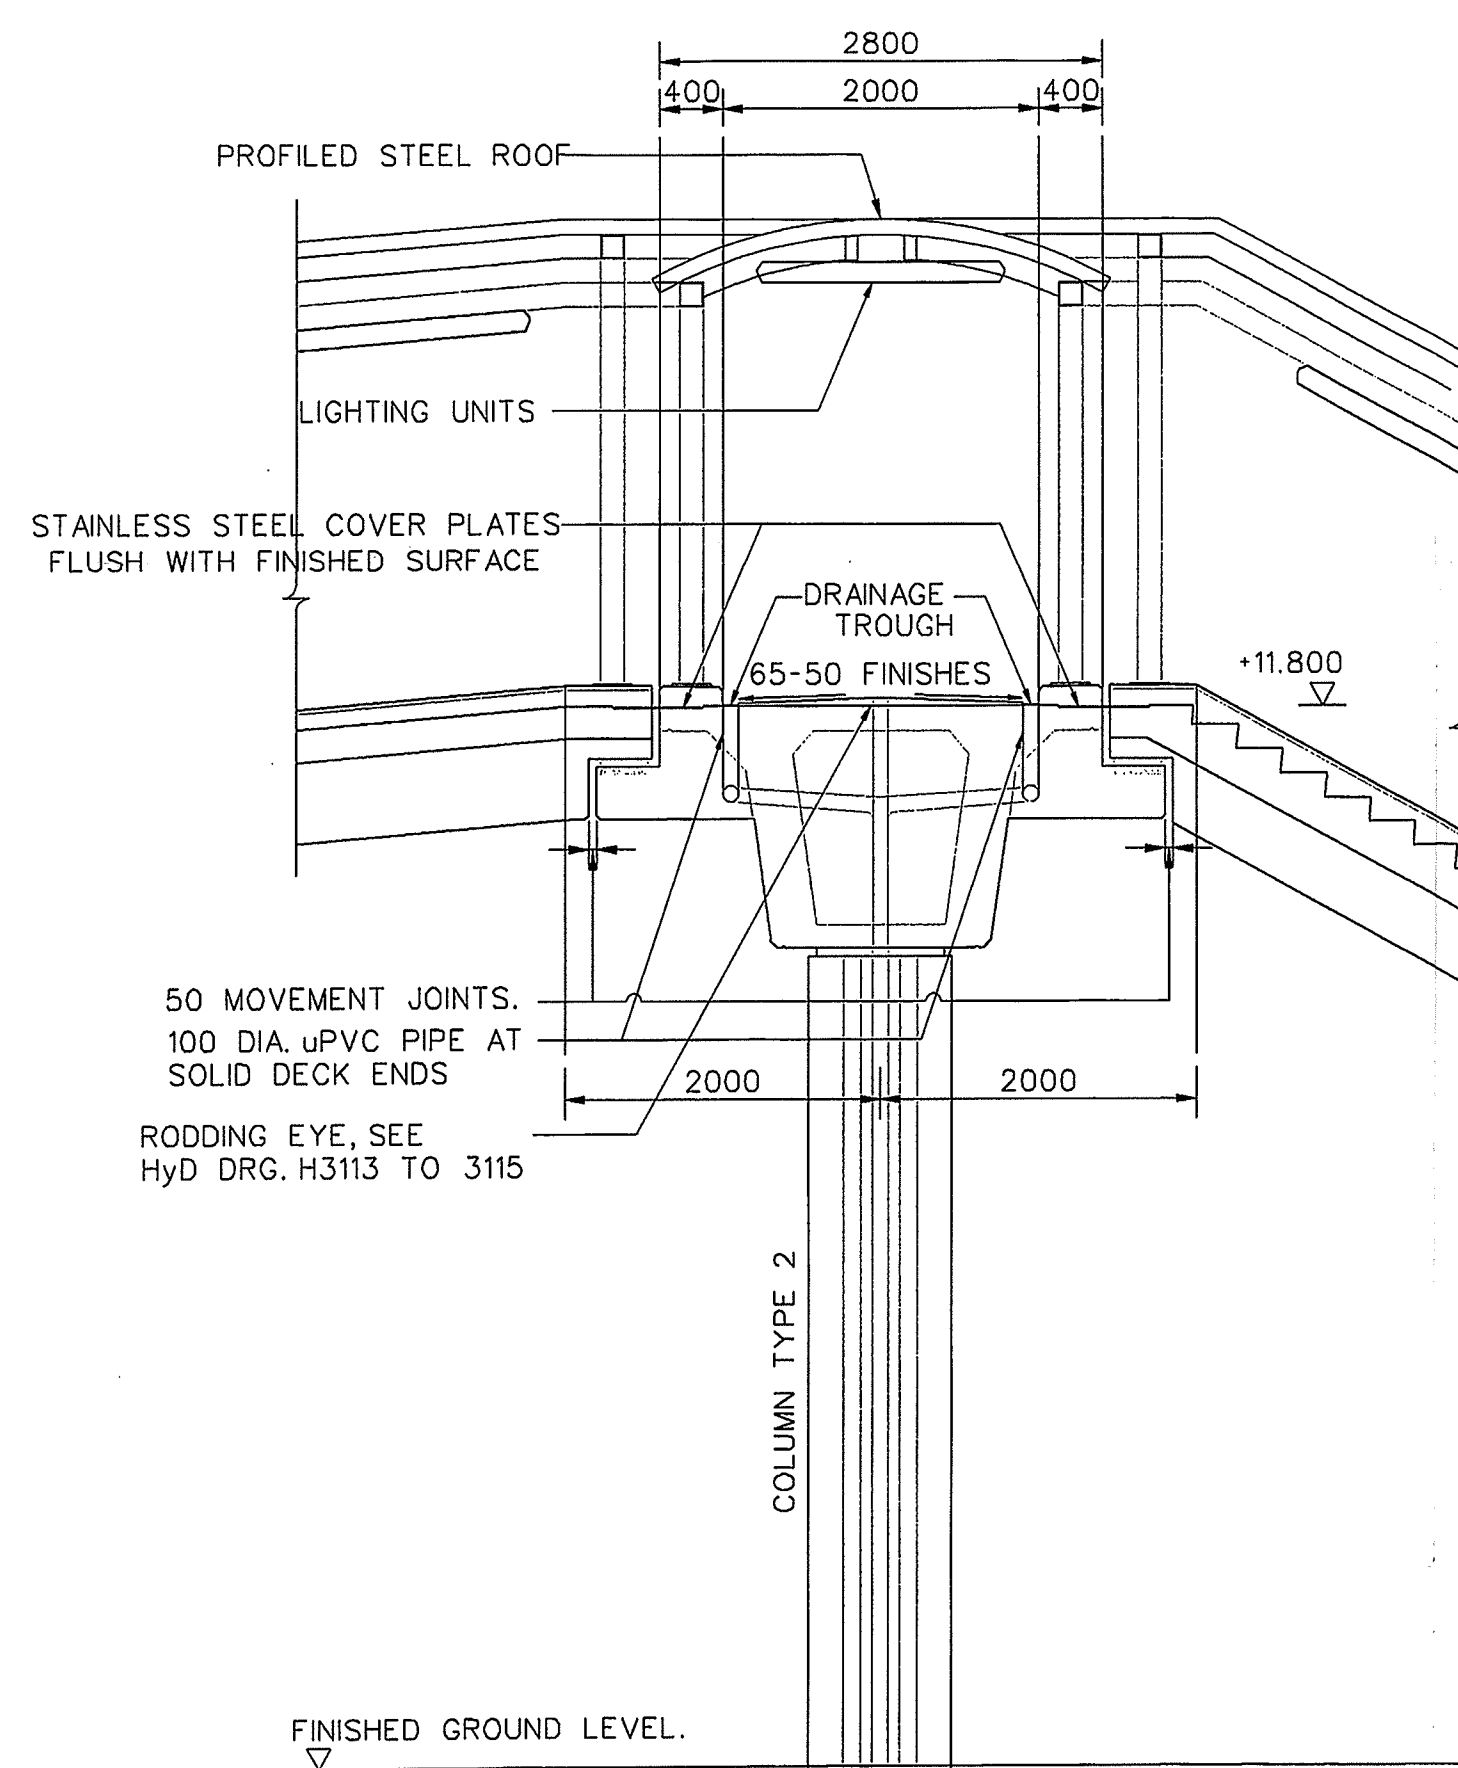



SECTION 14  
SCALE 1:50

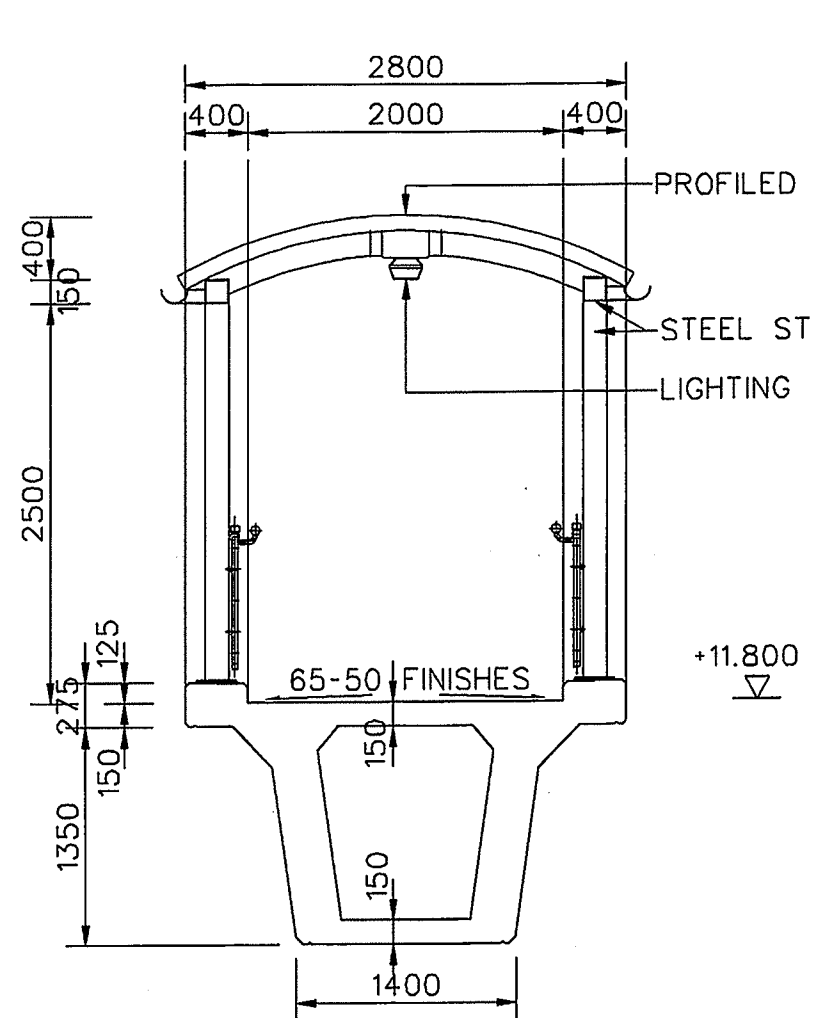

SECTION 15  
SCALE 1:50

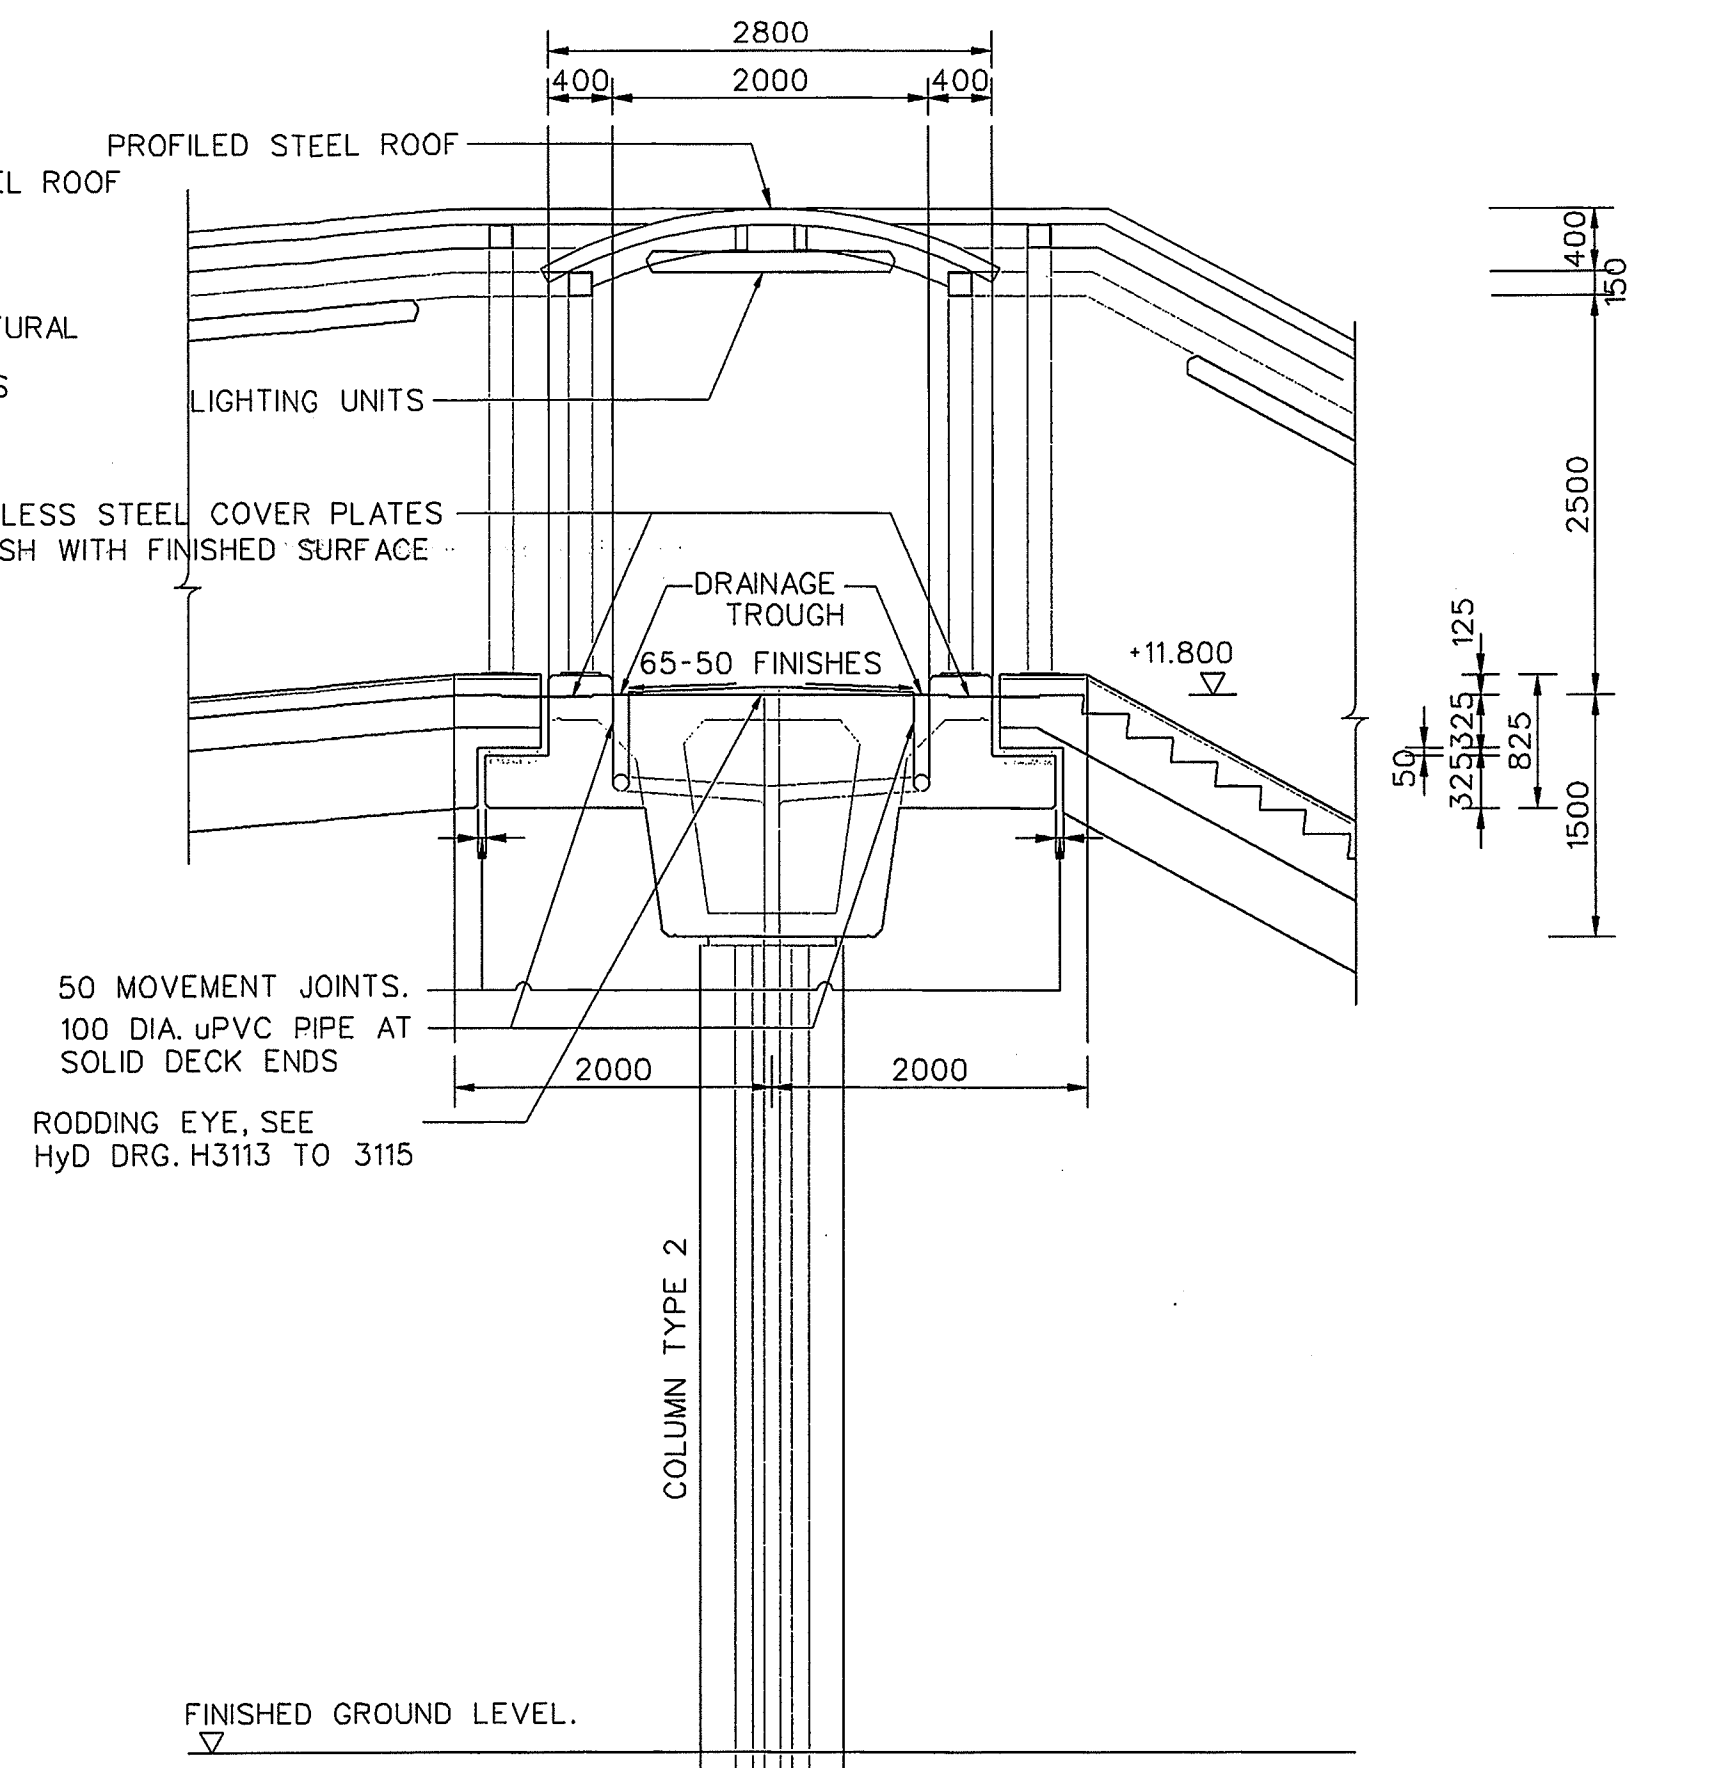

SECTION 16  
SCALE 1:50

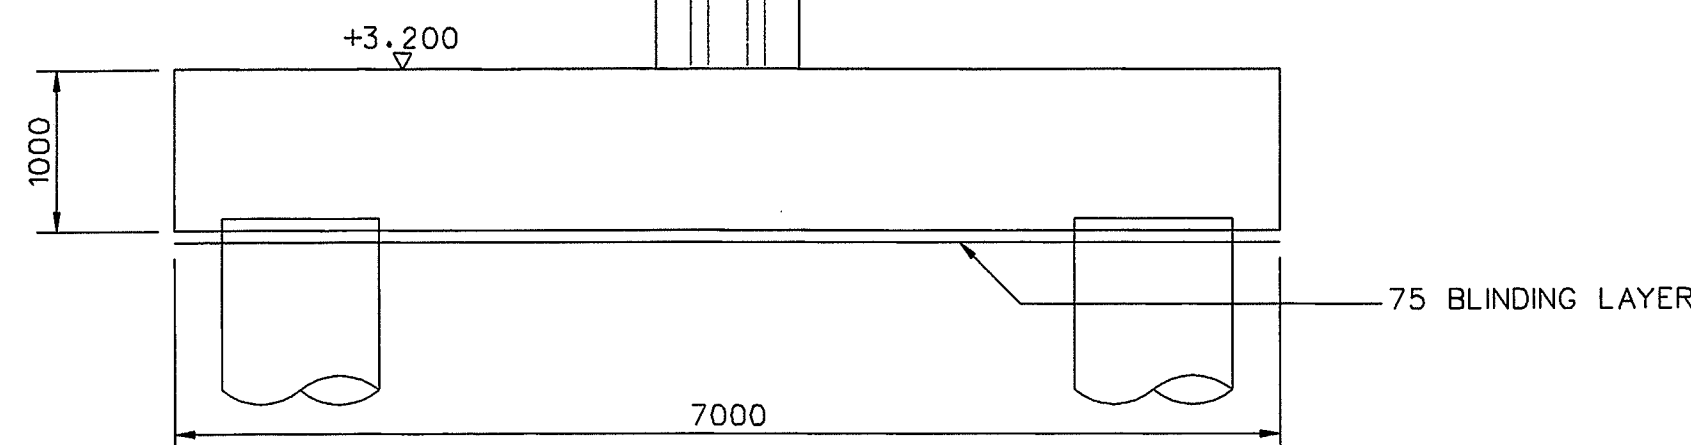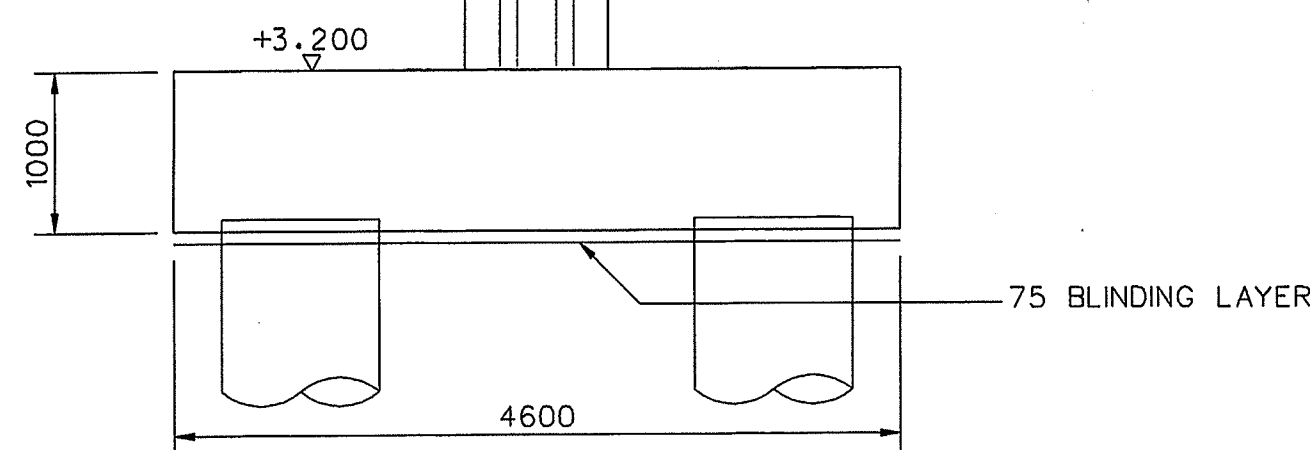

AS-CONSTRUCTED DRAWING

Major Works Project Management Office,  
Highways Department,  
Hong Kong

Project No. 6553TH Contract No. HY / 99 / 18

Meinhardt Halcrow JV  
Sub-Consultants

ACL Asia, MVA Asia Ltd.,  
Townland Consultants Ltd., Chesterton Petty Ltd.

Contract Title  
Castle Peak Road Improvement Between  
Sham Tseng and Ka Loon Tsuen, Tsuen Wan

Drawing Title  
FOOTBRIDGE No. 01  
MAIN SPAN  
ELEVATION AND SECTIONS

Drawn CPS	Checked LC	Approved HL
Scale 1:50	CAD File No. TFB0109	Date NOV 2007
Drawing No.	Rev.	


90612/T/FB/0109

Z



Note

1. For General Notes see drg. 90612/T/FB/5100.

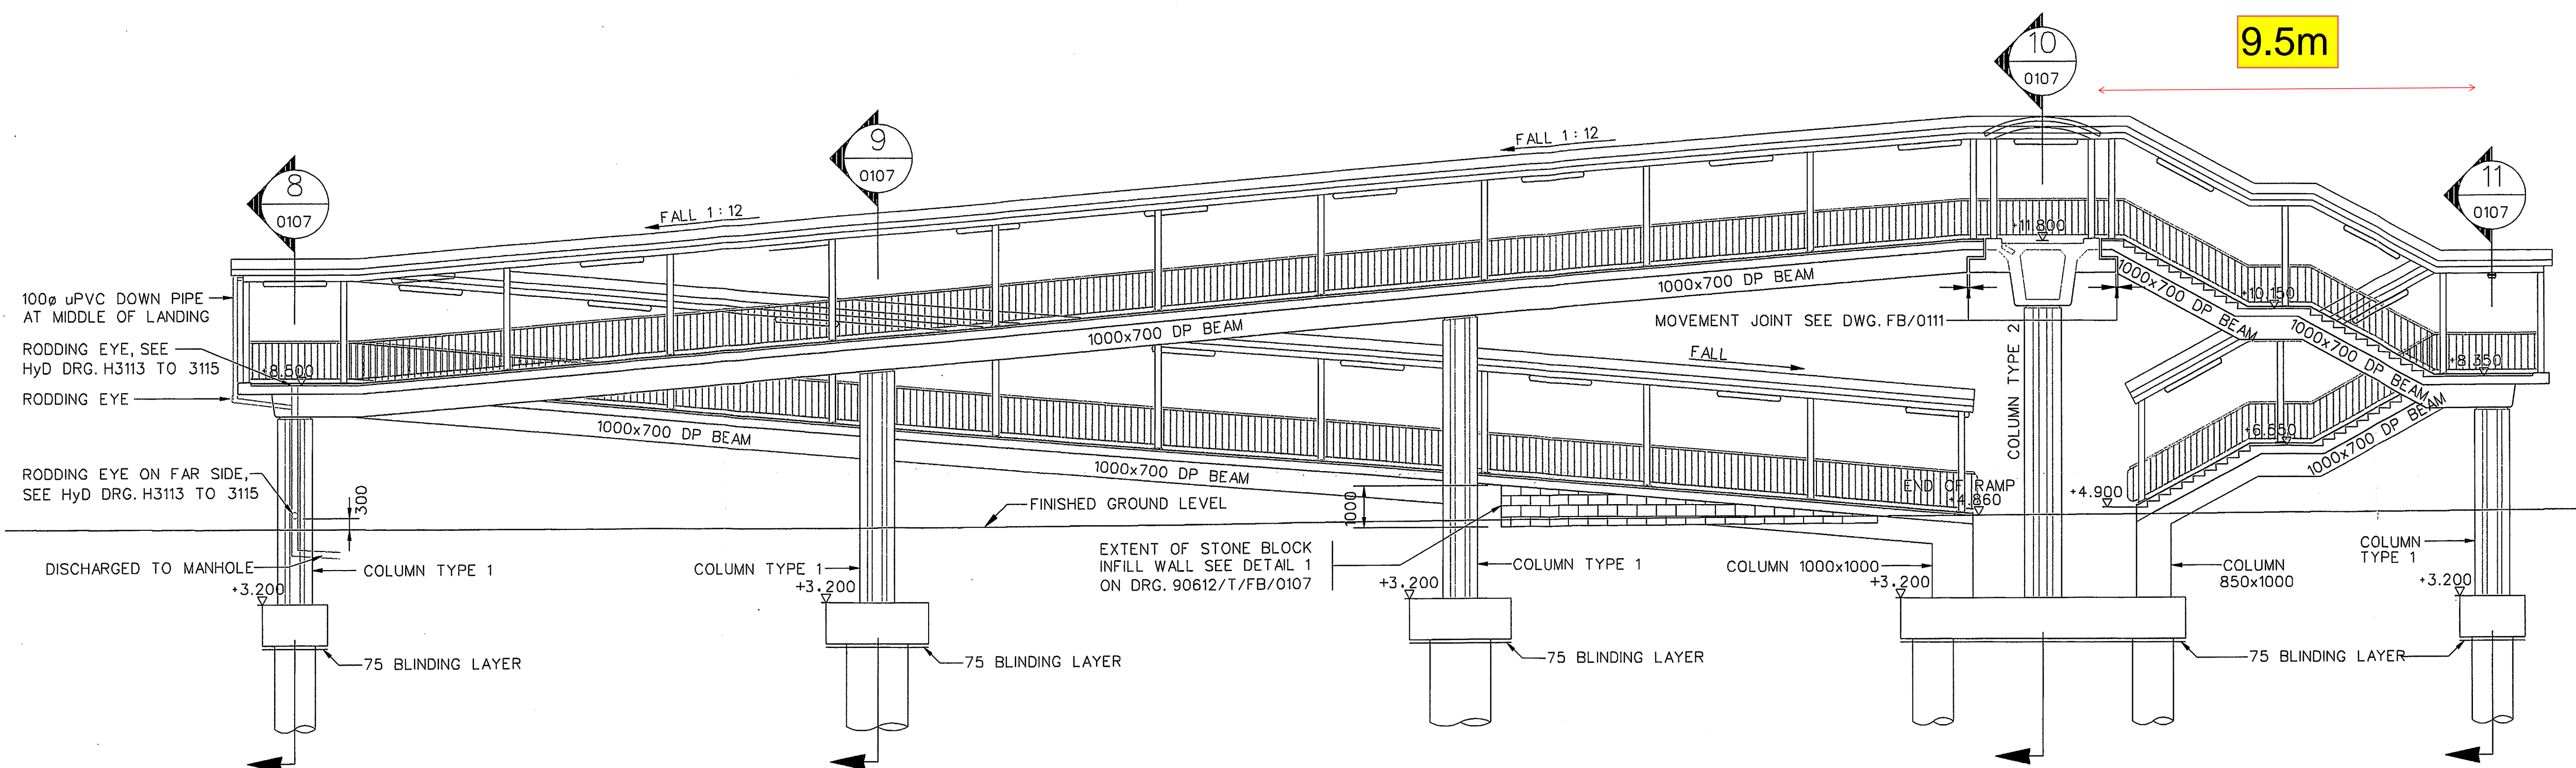

AS-CONSTRUCTED  
DRAWING

ELEVATION 12  
SCALE 1:100 0101

Major Works Project Management Office,  
Highways Department,  
Hong Kong

Project No. 6553TH Contract No. HY / 99 / 18

**Meinhardt Halcrow JV**  
Sub-Consultants  
ACL Asia, MVA Asia Ltd.,  
Townland Consultants Ltd., Chesterton Petty Ltd.

Contract Title  
Castle Peak Road Improvement Between  
Sham Tseng and Ka Loon Tsuen, Tsuen Wan




Drawing Title  
FOOTBRIDGE No. 01  
NORTH RAMP AND STAIRCASE  
ELEVATION

Drawn CPS	Checked LC	Approved HL
Scale 1:100 AT A1	CAD File No. TFB0108	Date NOV 2007



Drawing No. 90612/T/FB/0108 Rev. Z

Note



1. For General Notes see drg. 90612/T/FB/5100.

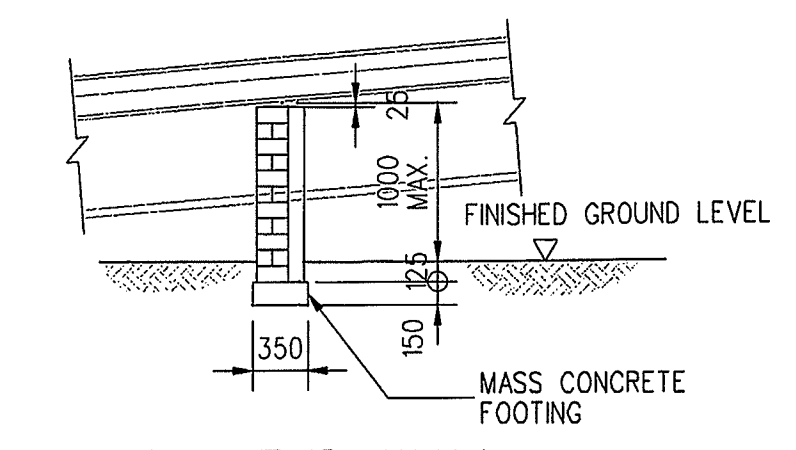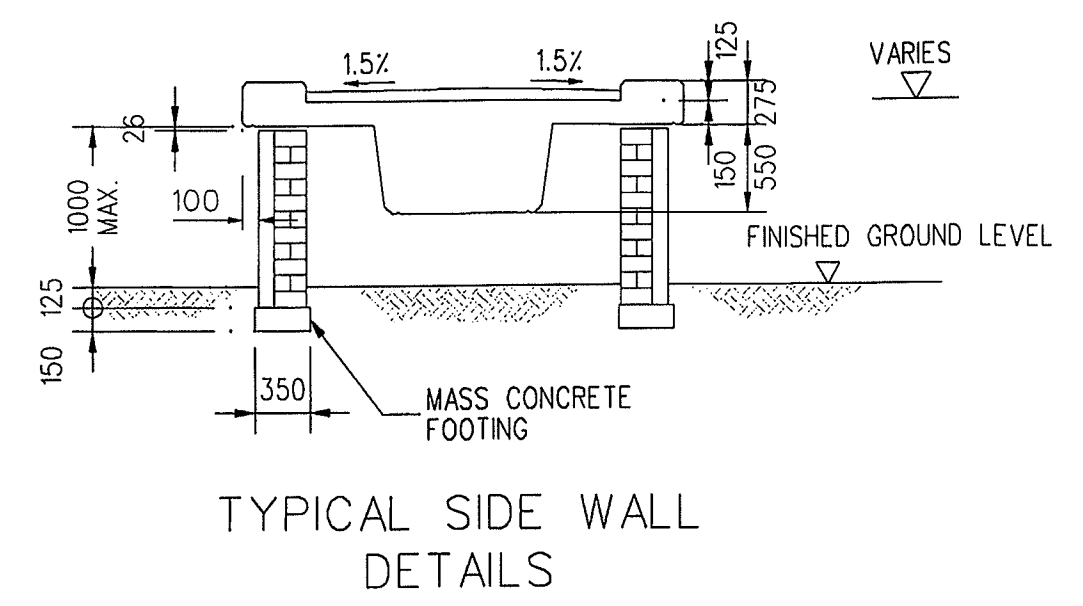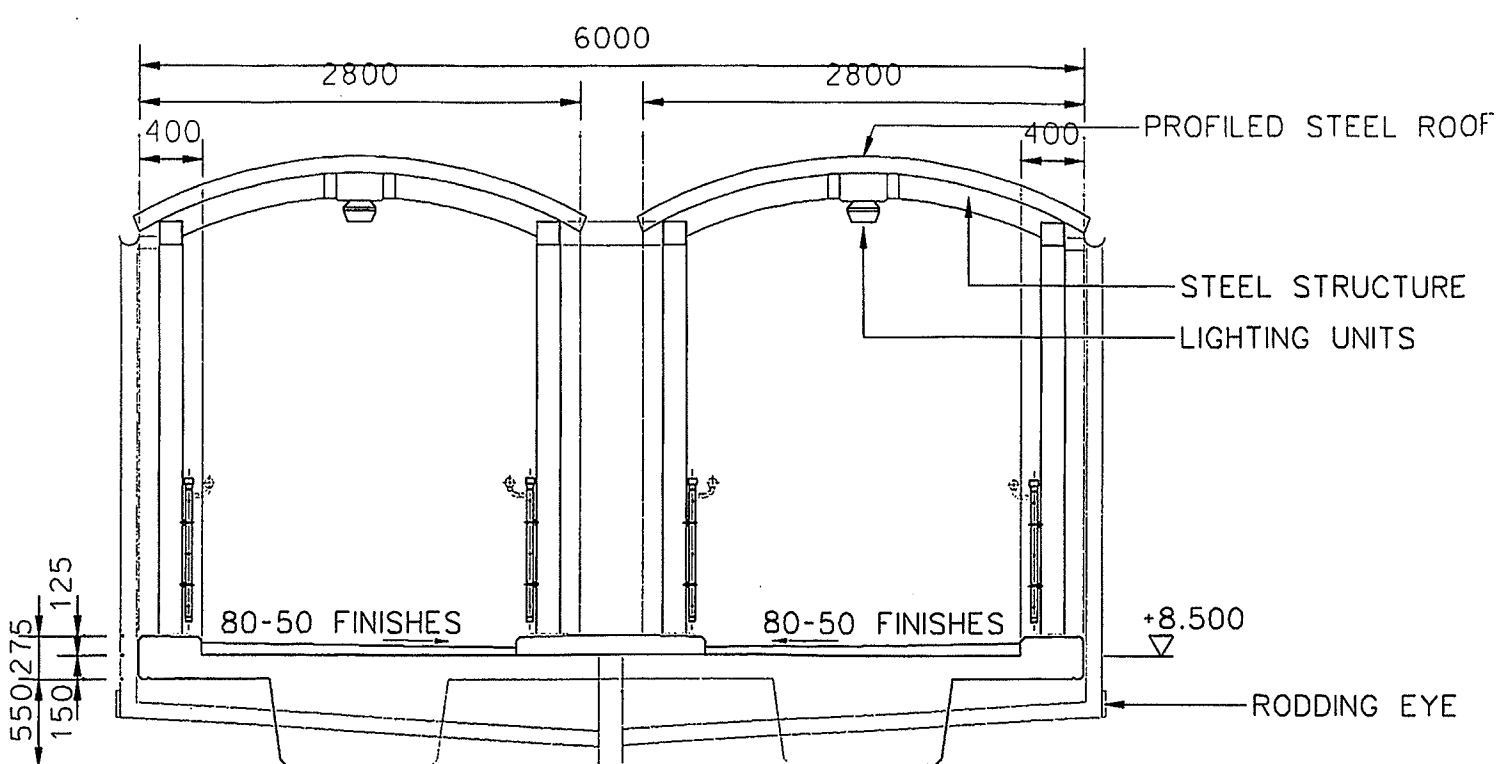


TYPICAL DETAIL FOR  
STONE BLOCK INFILL WALL  
DETAIL 1  
SCALE 1:50 0105/0108

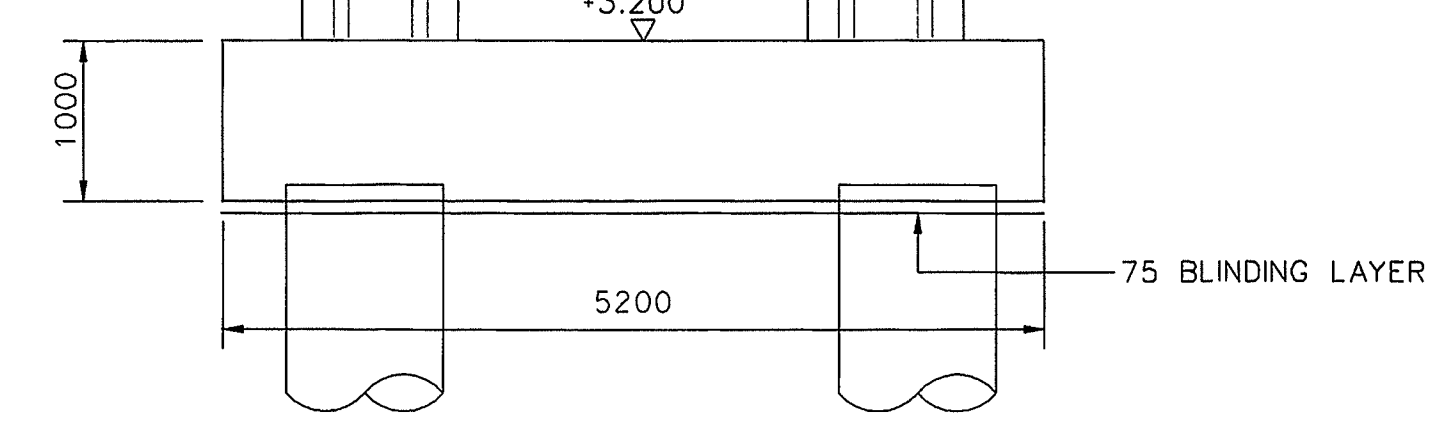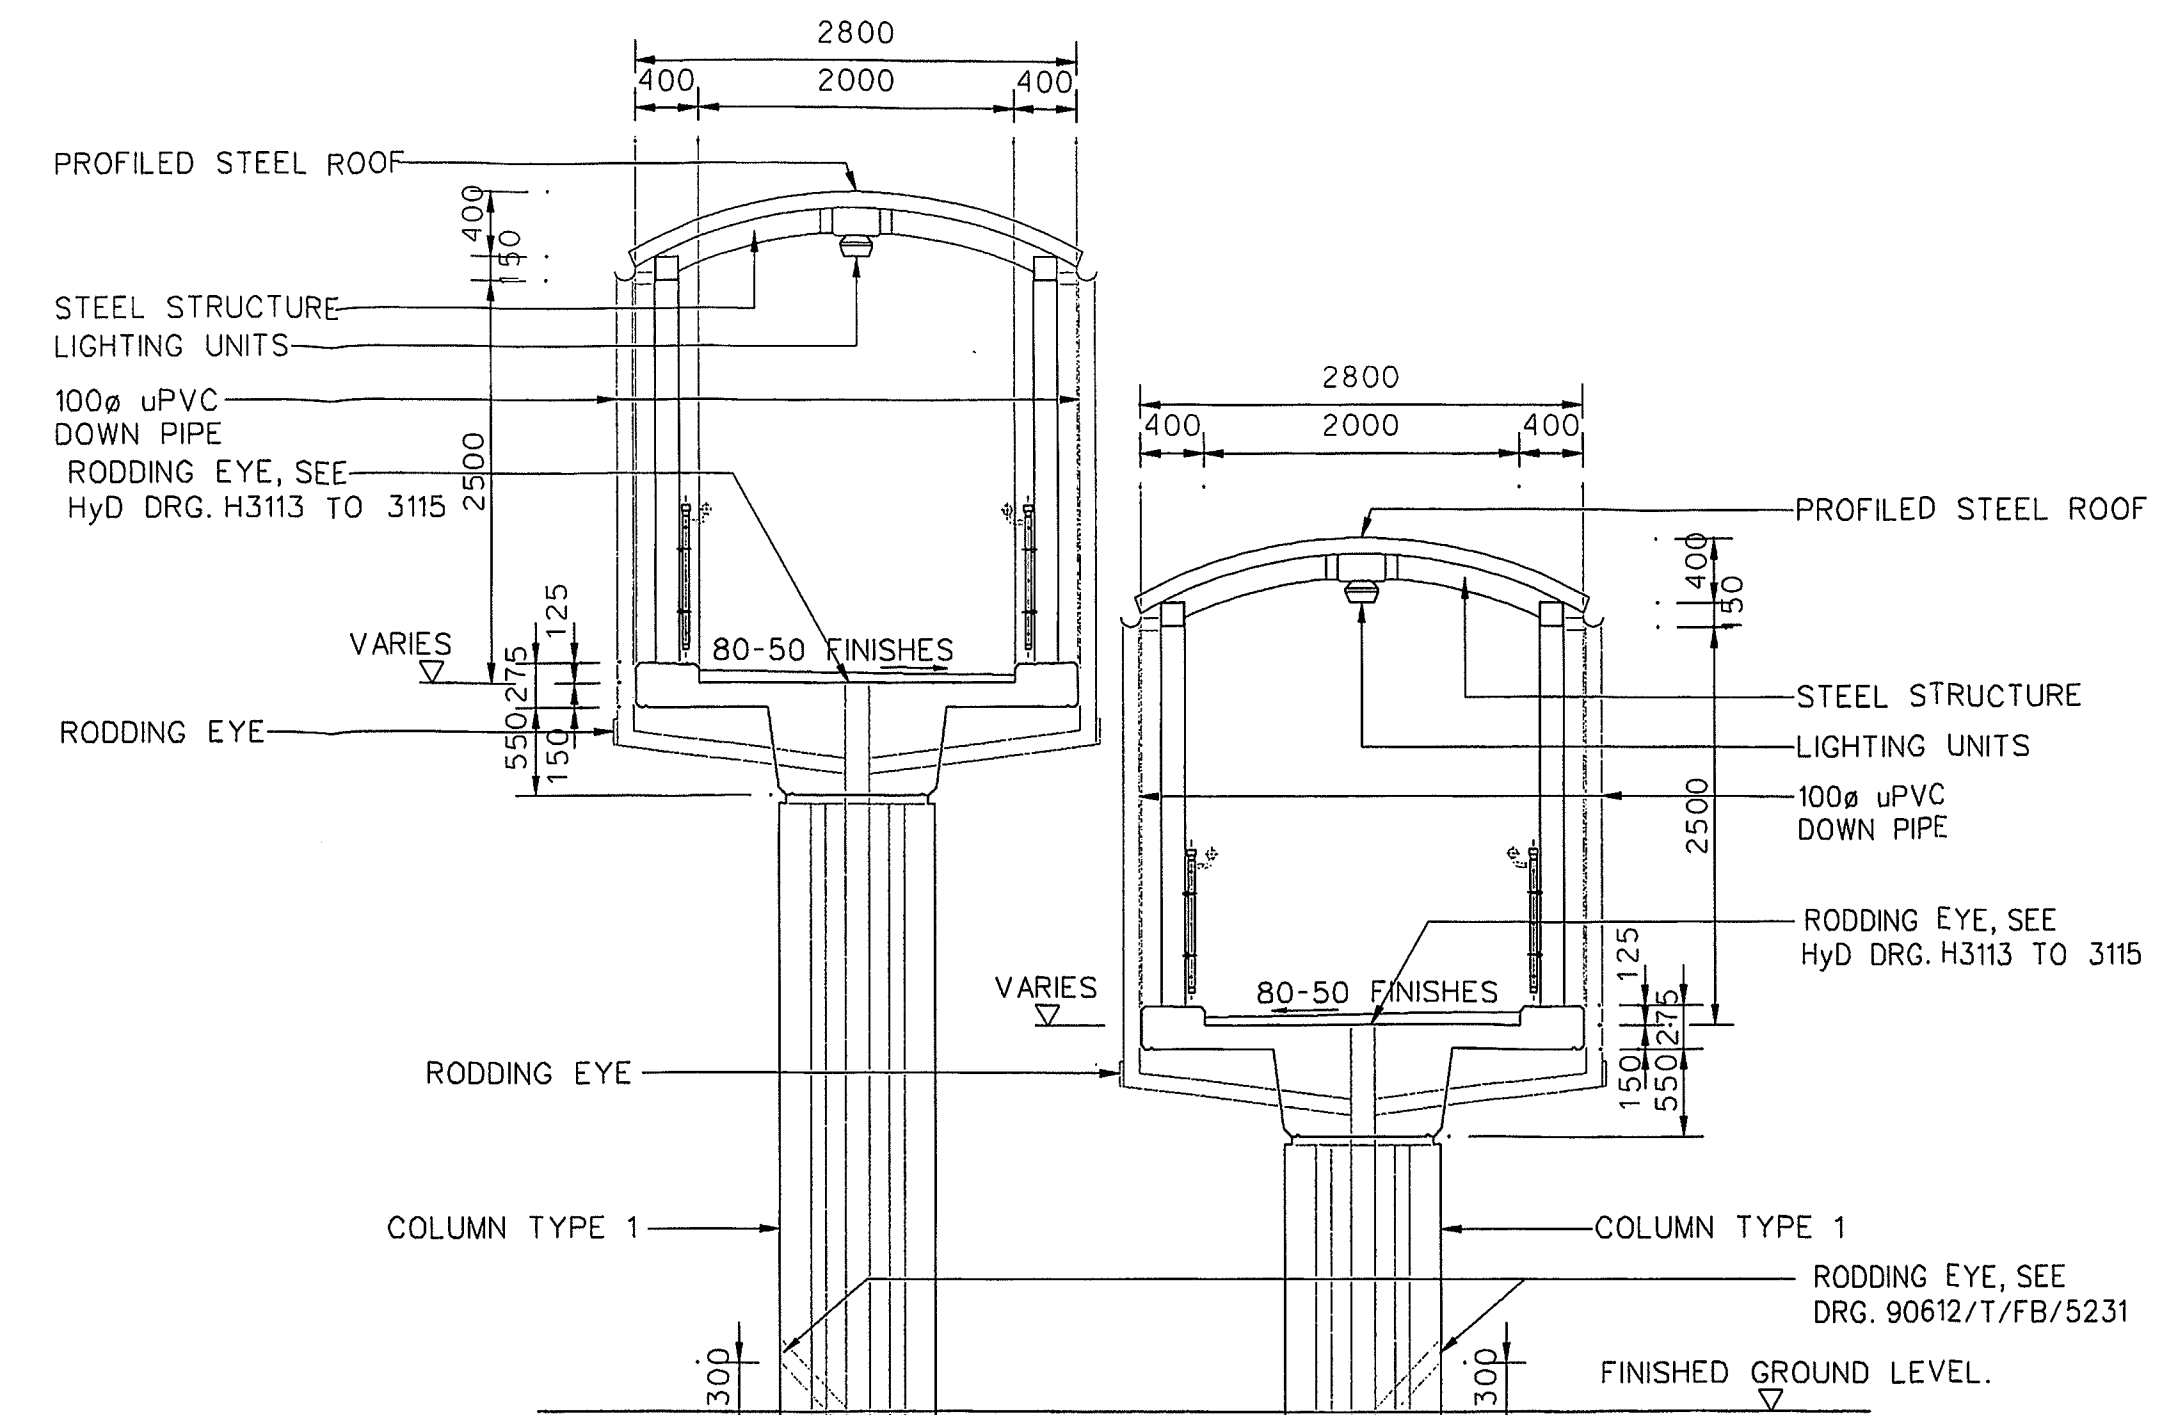


SECTION 9  
SCALE 1:50 0101

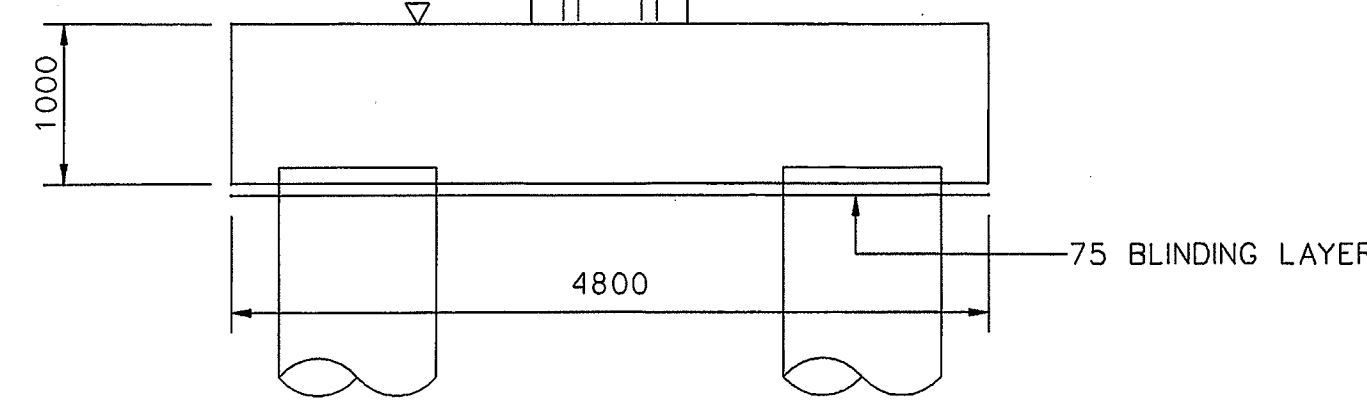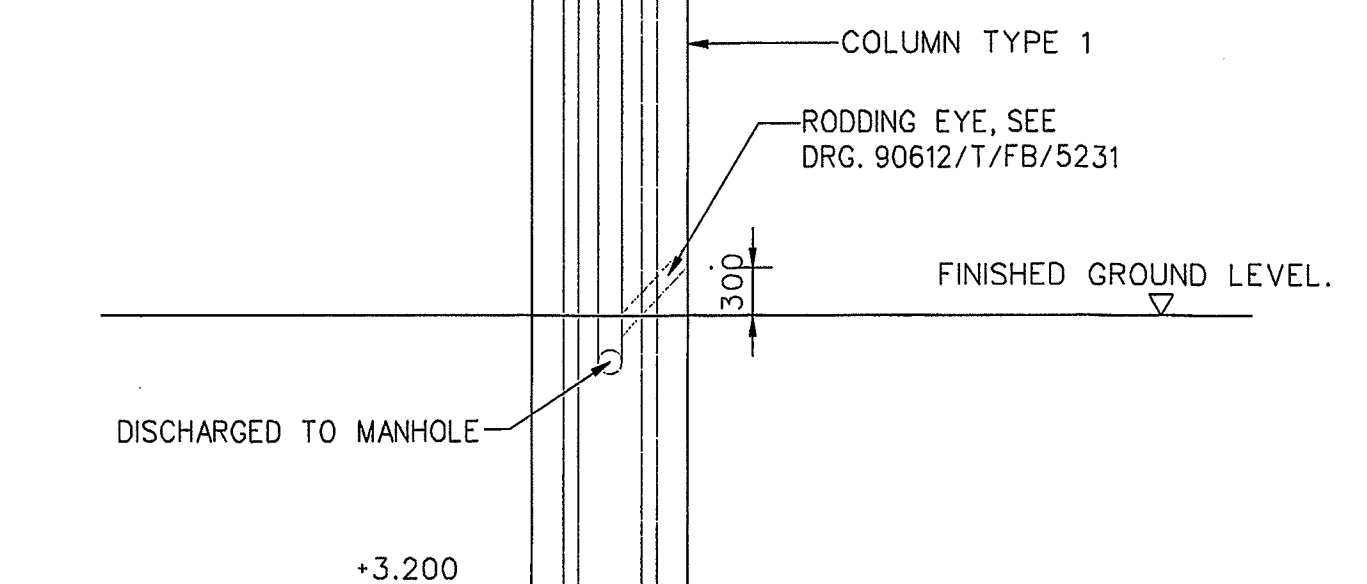


SECTION 8  
SCALE 1:50 0101

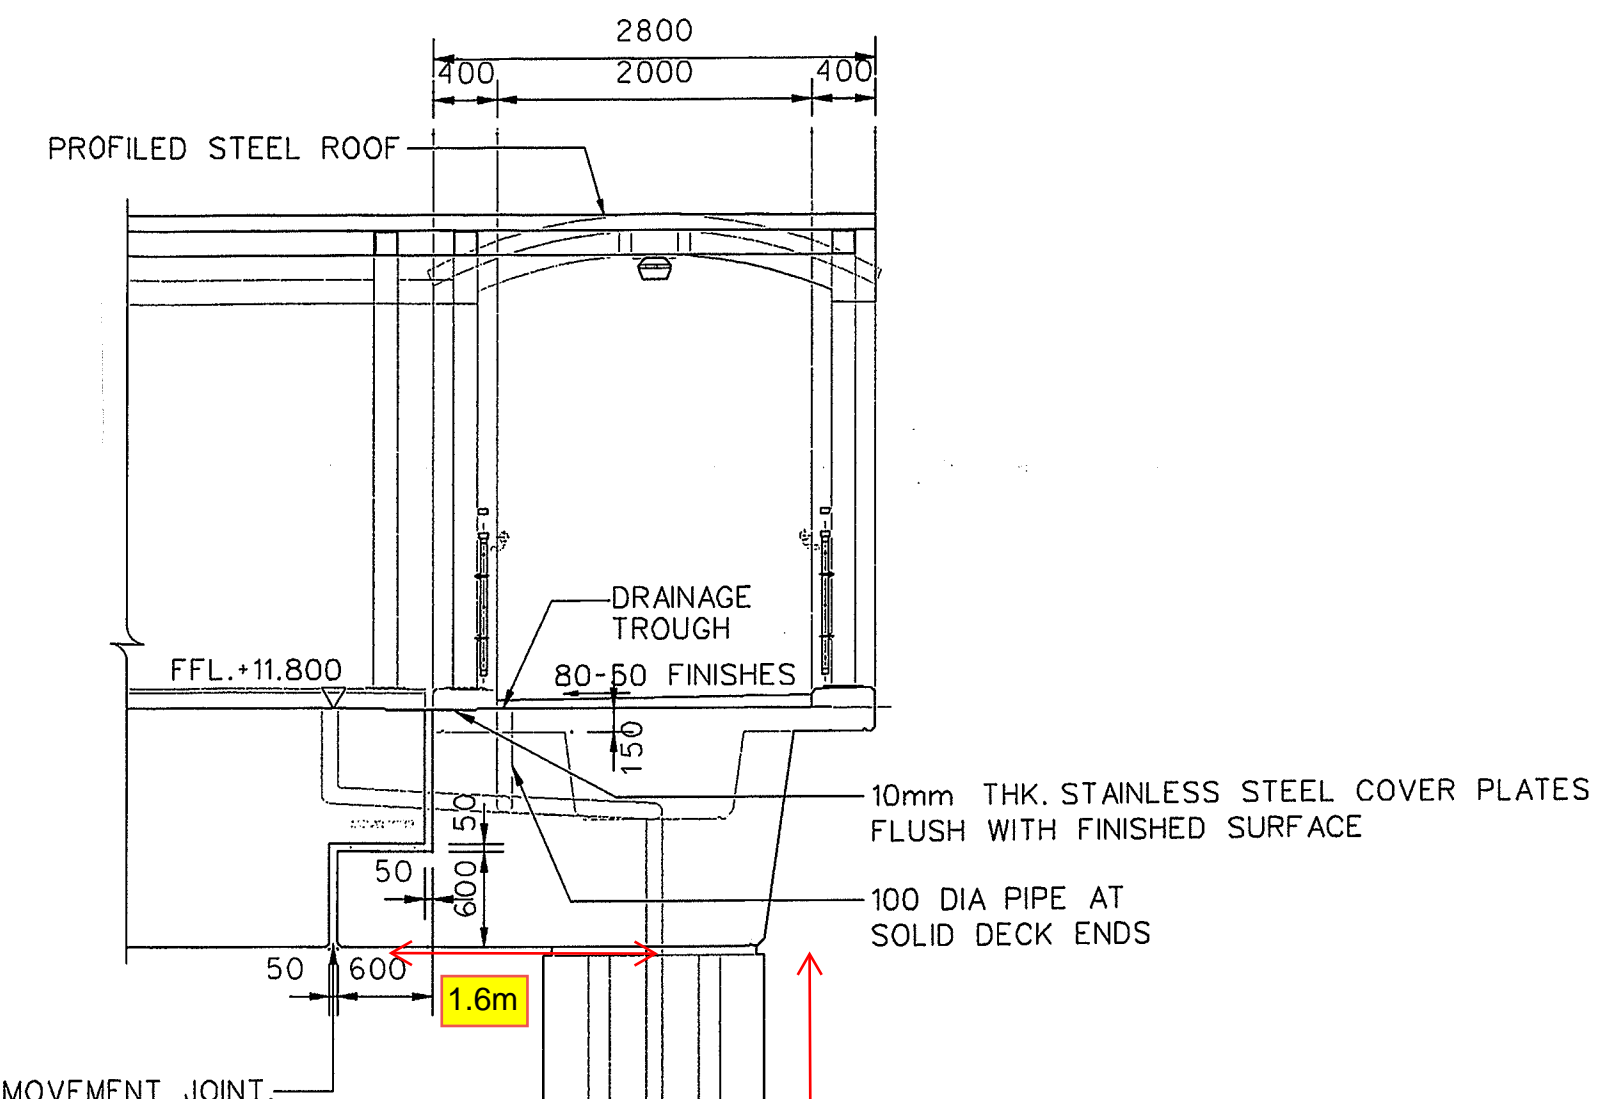


SECTION 10  
SCALE 1:50 0101

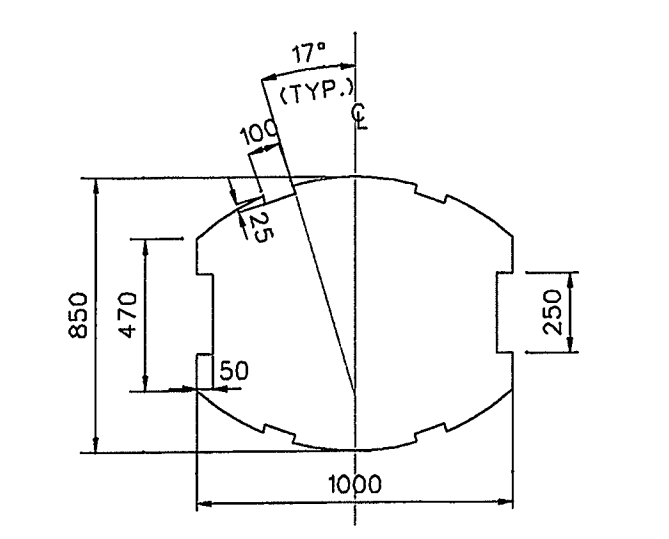



COLUMN PROFILE TYPE 1  
SCALE 1:25

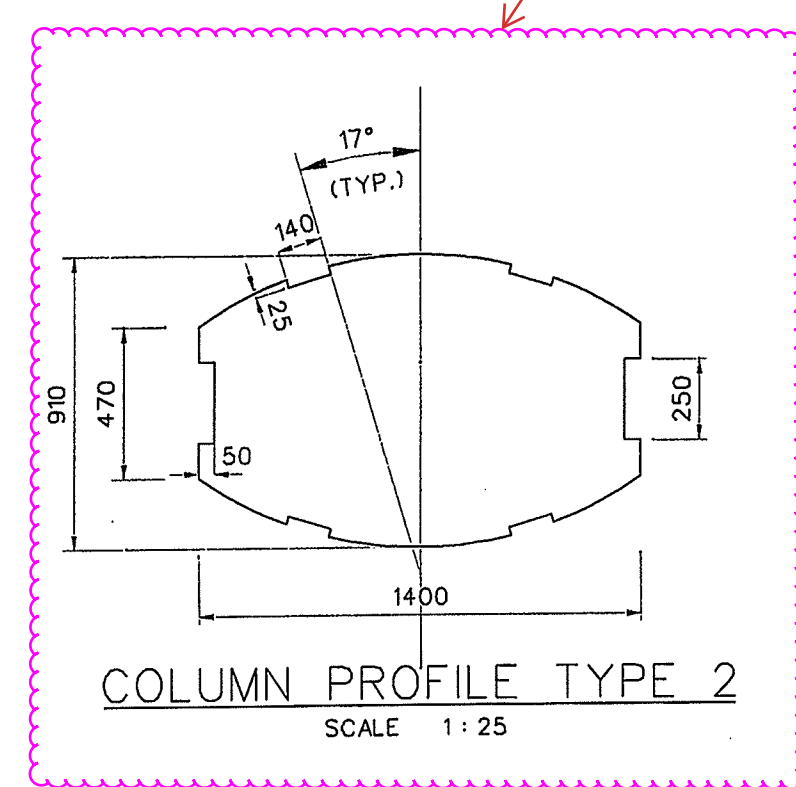

COLUMN PROFILE TYPE 2  
SCALE 1:25

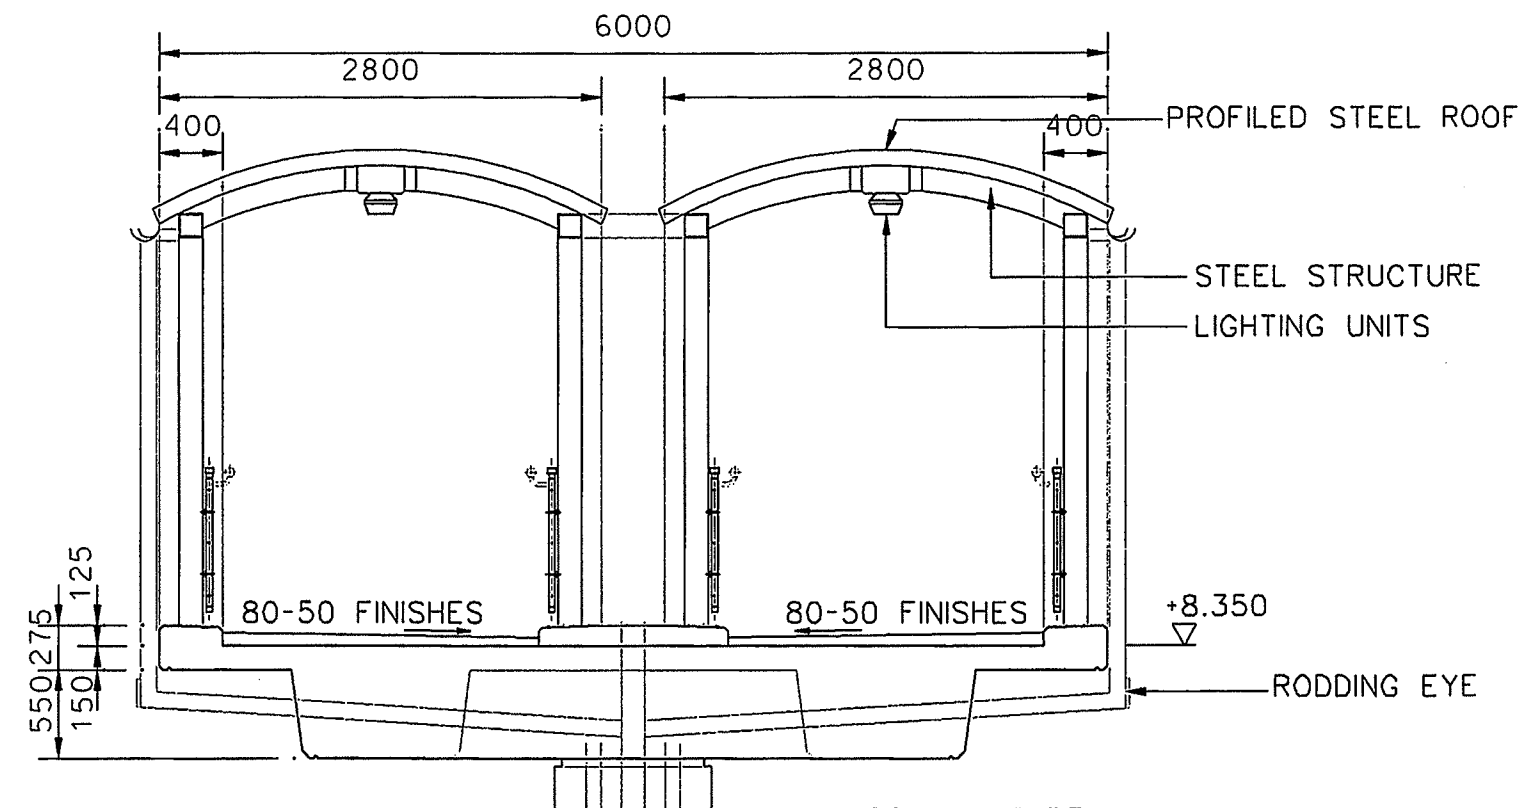

SECTION 11  
SCALE 1:50 0101

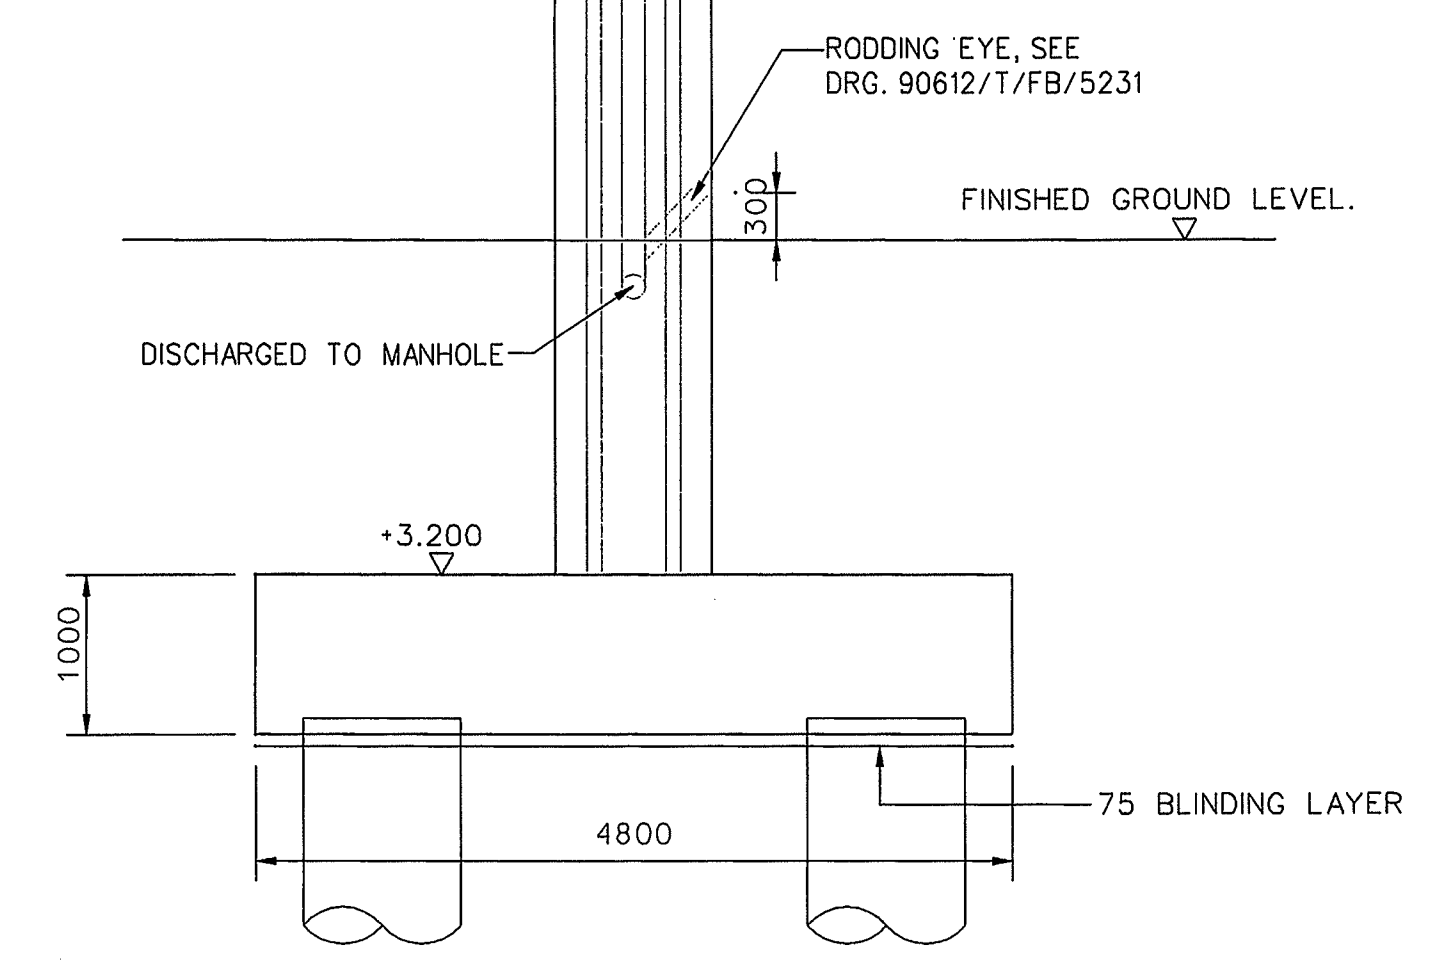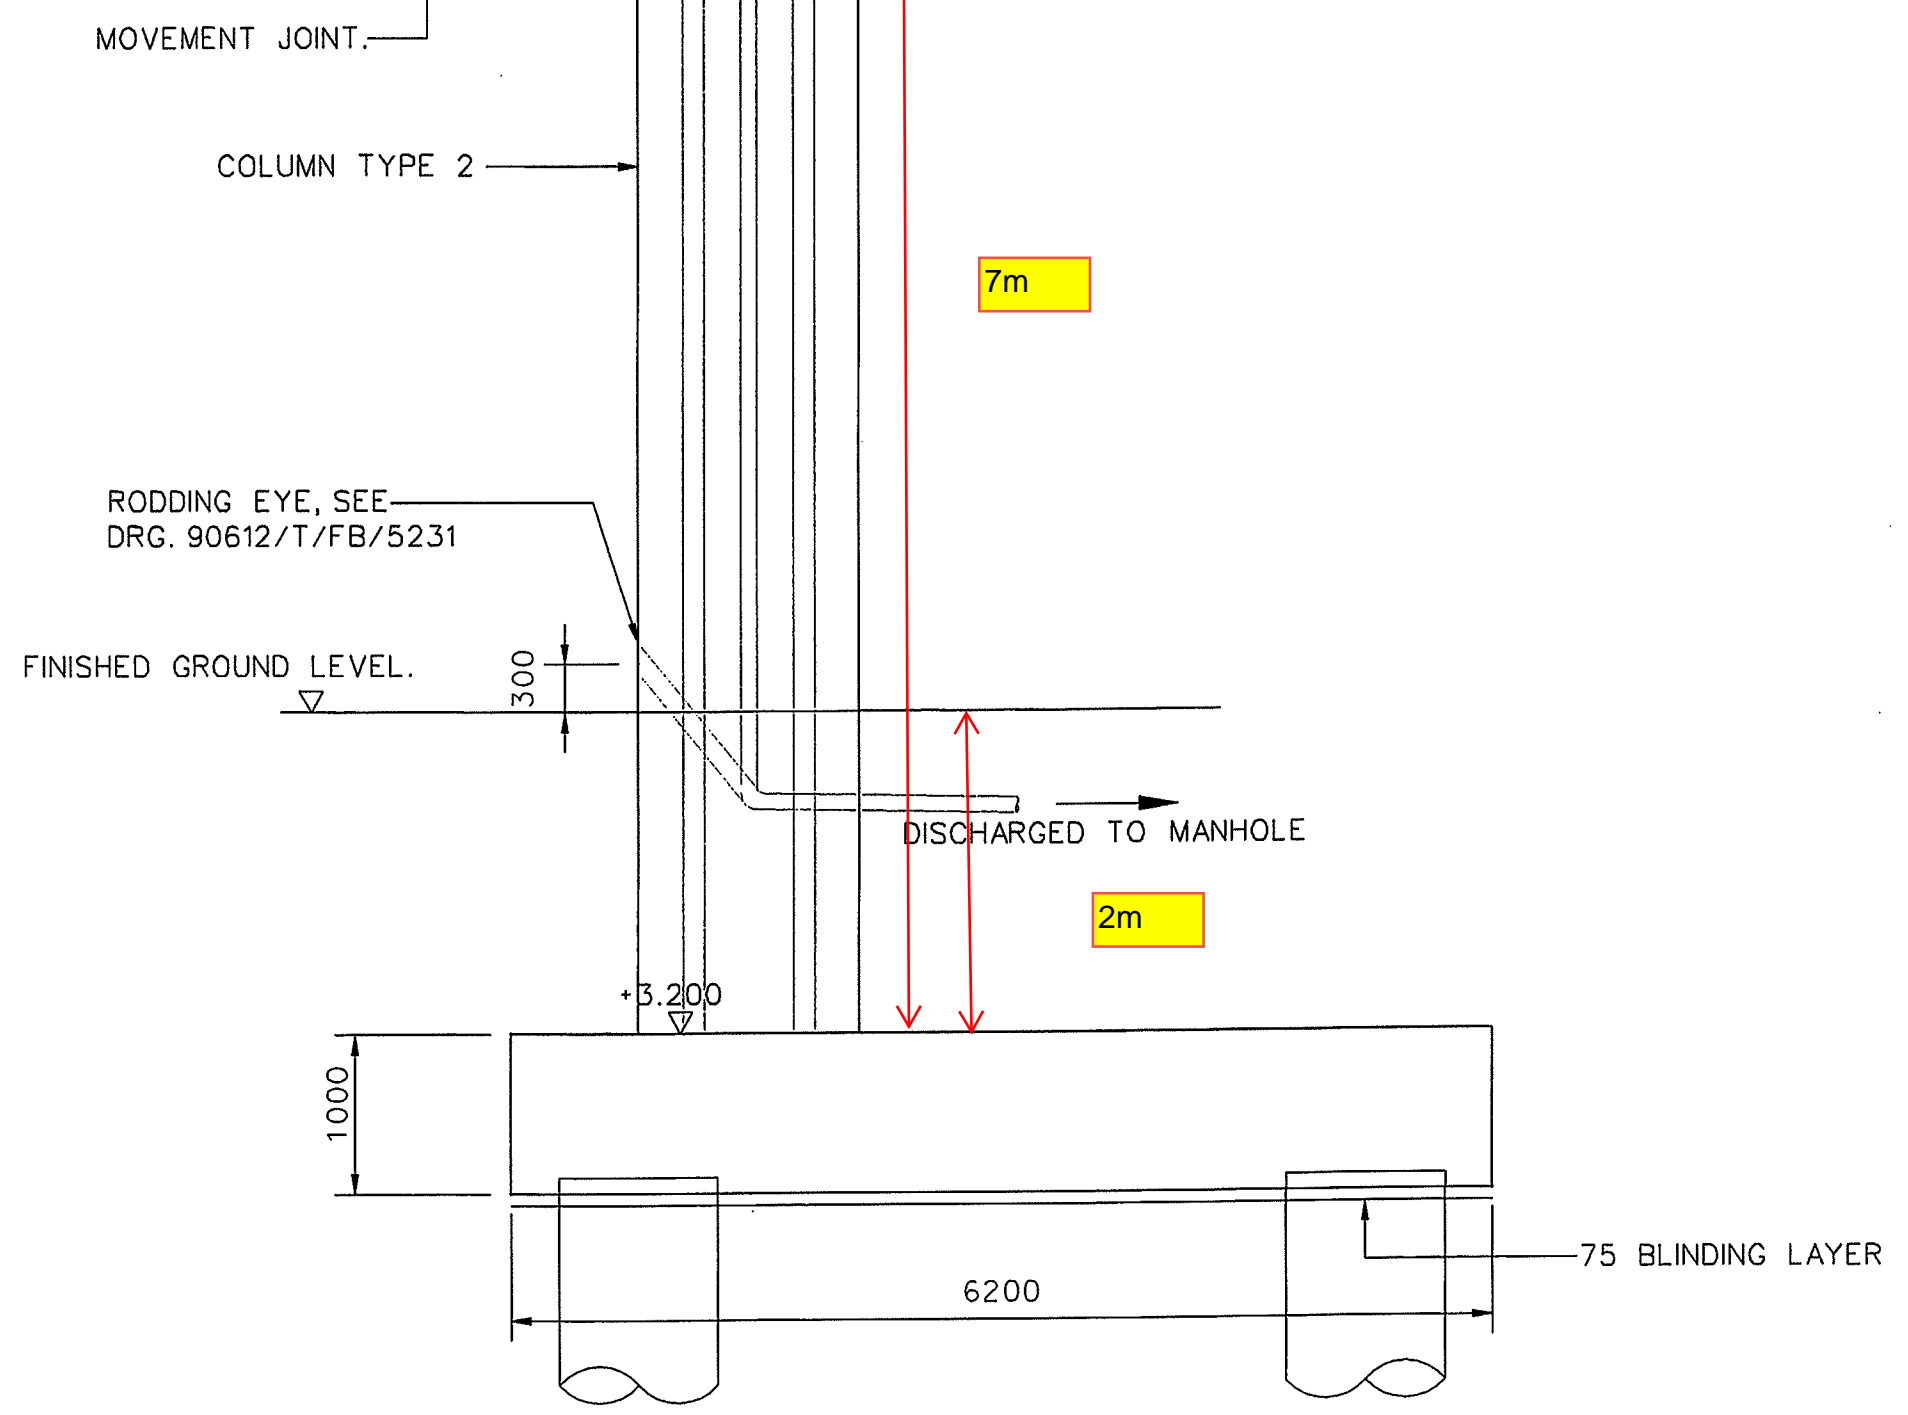

AS-CONSTRUCTED  
DRAWING

Major Works Project Management Office,  
Highways Department,  
Hong Kong

Project No. 6553TH Contract No. HY / 99 / 18

**Meinhardt Halcrow JV**  
Sub-Consultants  
ACL Asia, MVA Asia Ltd.,  
Townland Consultants Ltd., Chesterton Petty Ltd.


Contract Title  
Castle Peak Road Improvement Between  
Sham Tseng and Ka Loon Tsuen, Tsuen Wan

Drawing Title  
**FOOTBRIDGE No. 01  
NORTH RAMP AND STAIRCASE  
SECTIONS**

Drawn CPS	Checked LC	Approved HL
Scale 1:50 AT A1	CAD File No. TFB0107	Date NOV 2007


Drawing No. 90612/T/FB/0107 Rev. Z

Note  
 1. For General Notes see drg. no. 90612/T/FB/5100.

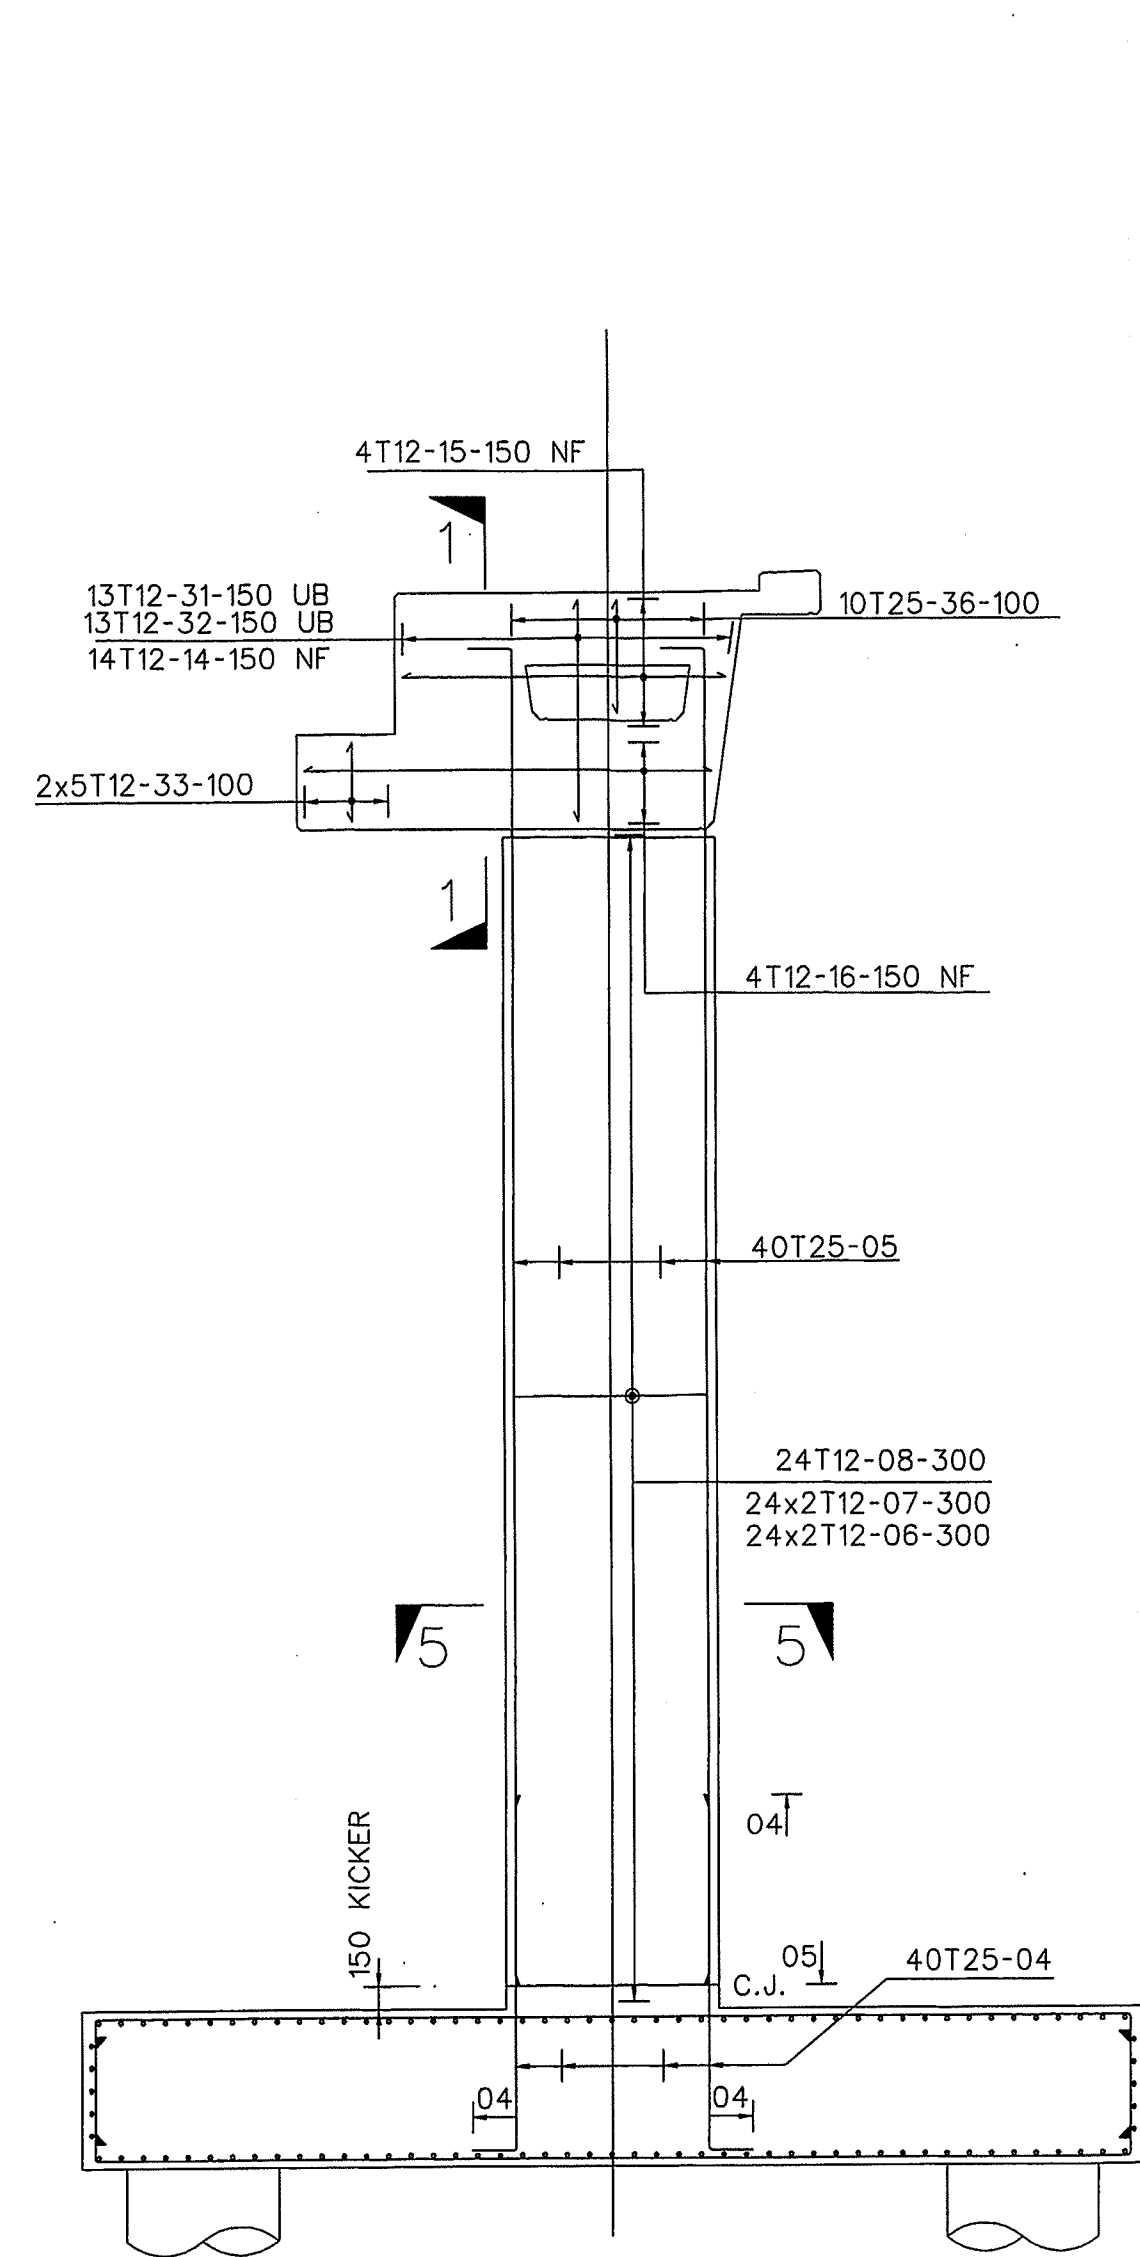


ELEVATION A  
 SCALE 1:50


FOR PILE CAP DETAILS,  
 SEE DRG. 90612/T/FB/0165 & 0166

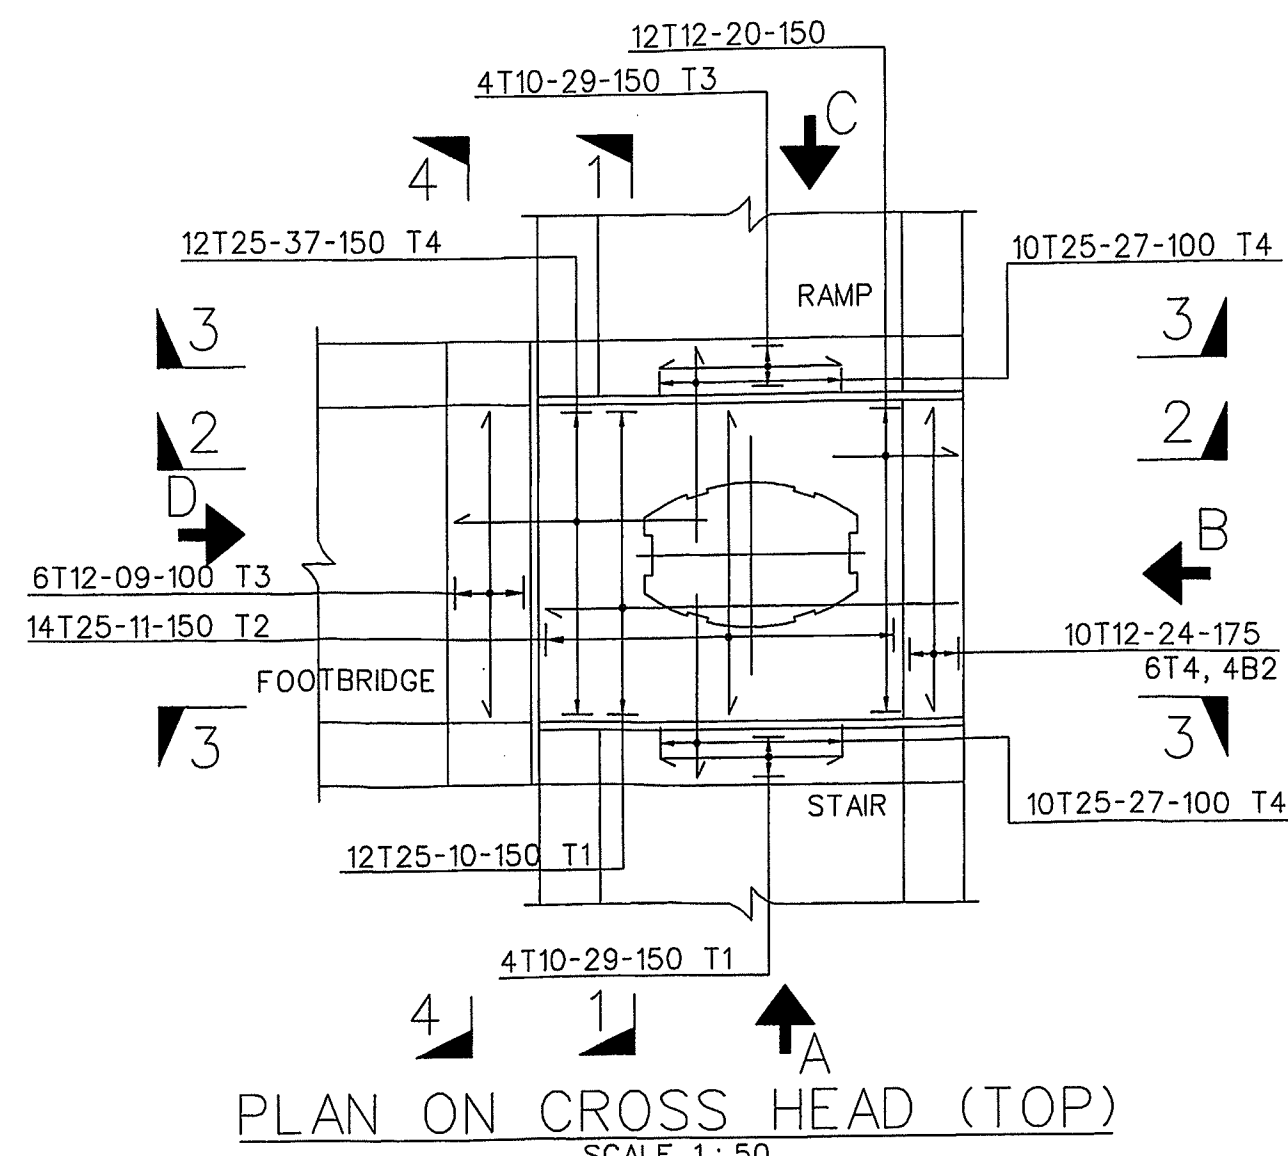


PLAN ON CROSS HEAD (TOP)  
 SCALE 1:50

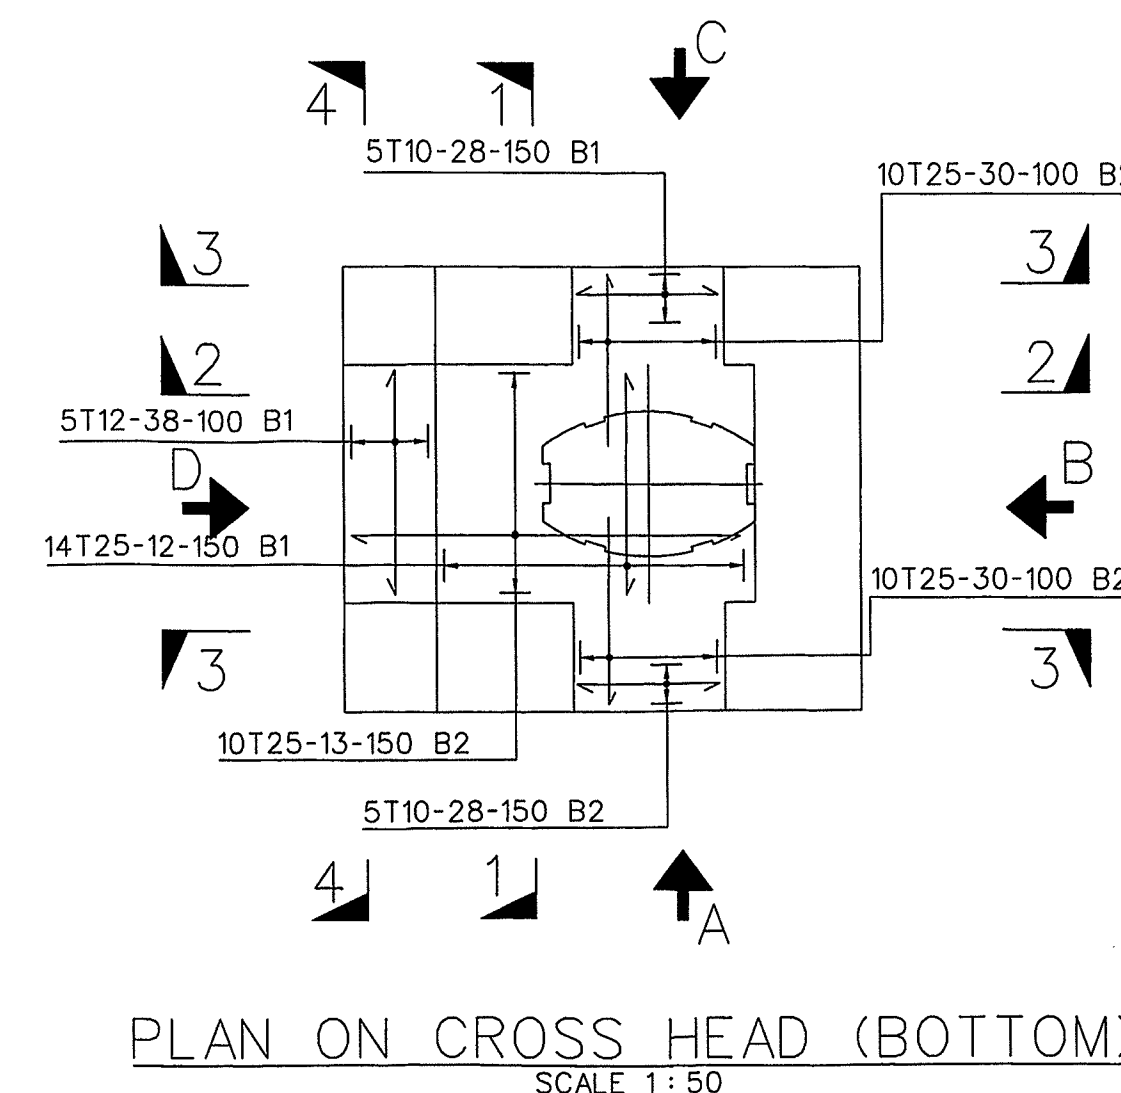


PLAN ON CROSS HEAD (BOTTOM)  
 SCALE 1:50

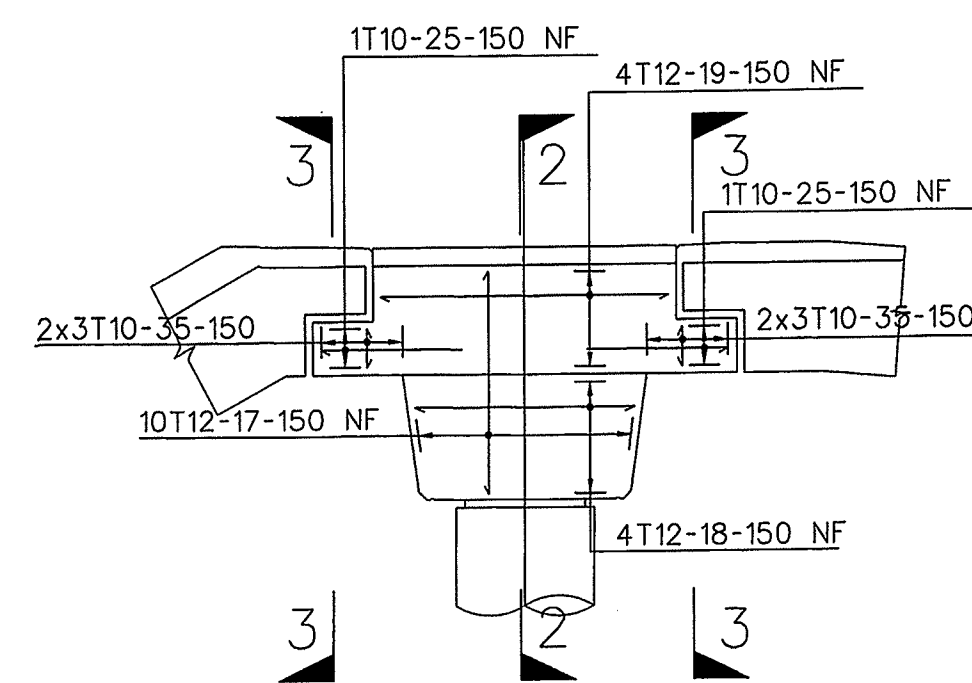


ELEVATION B  
 SCALE 1:50

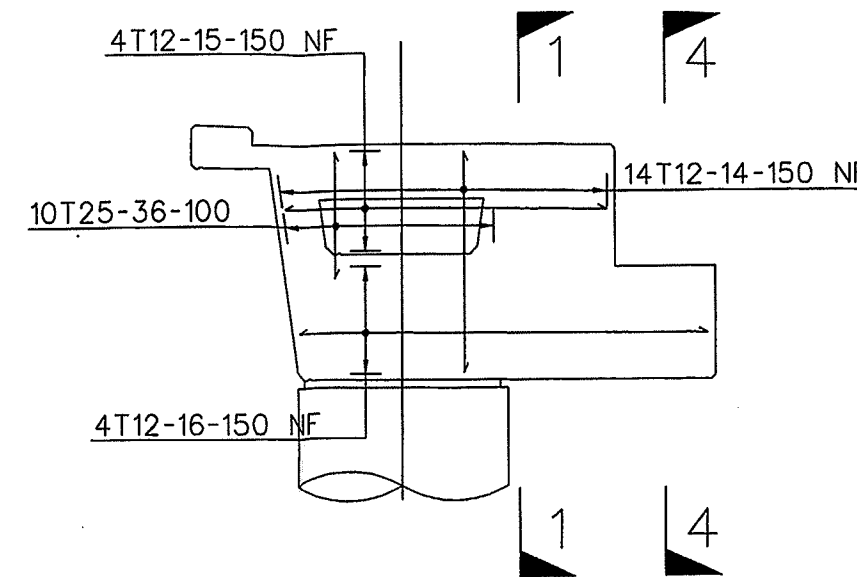


ELEVATION C  
 SCALE 1:50

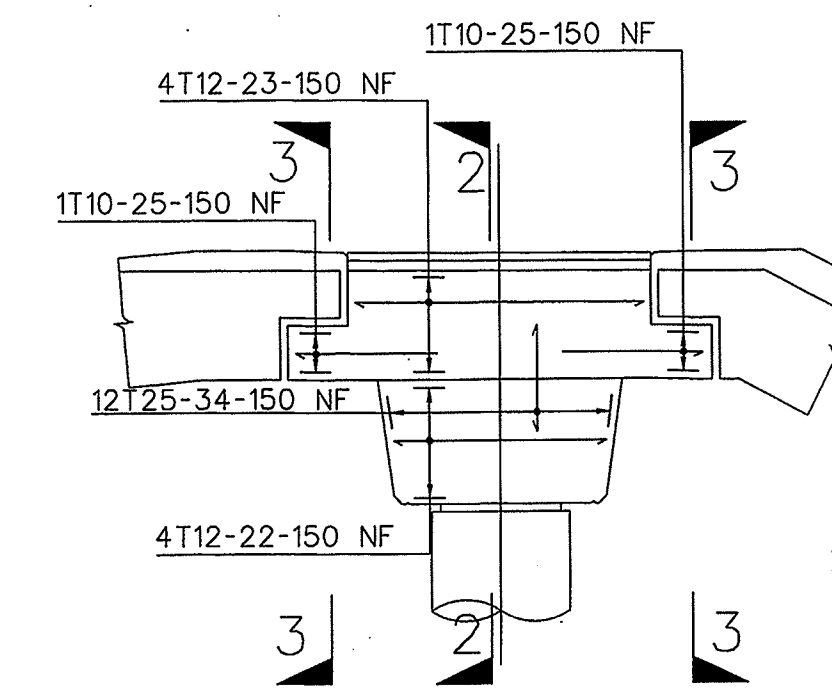


ELEVATION D  
 SCALE 1:50

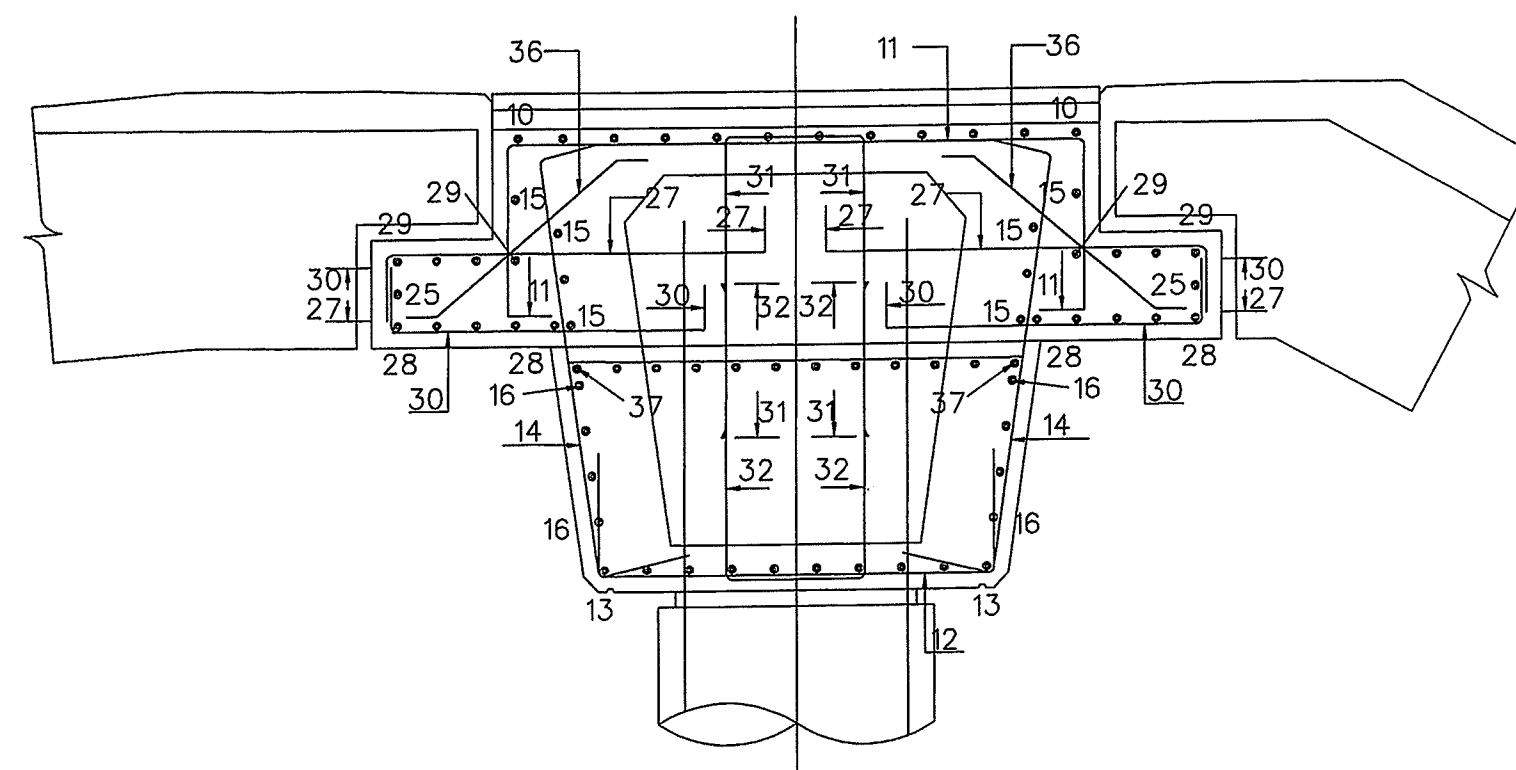


SECTION 1 - 1  
 SCALE 1:25

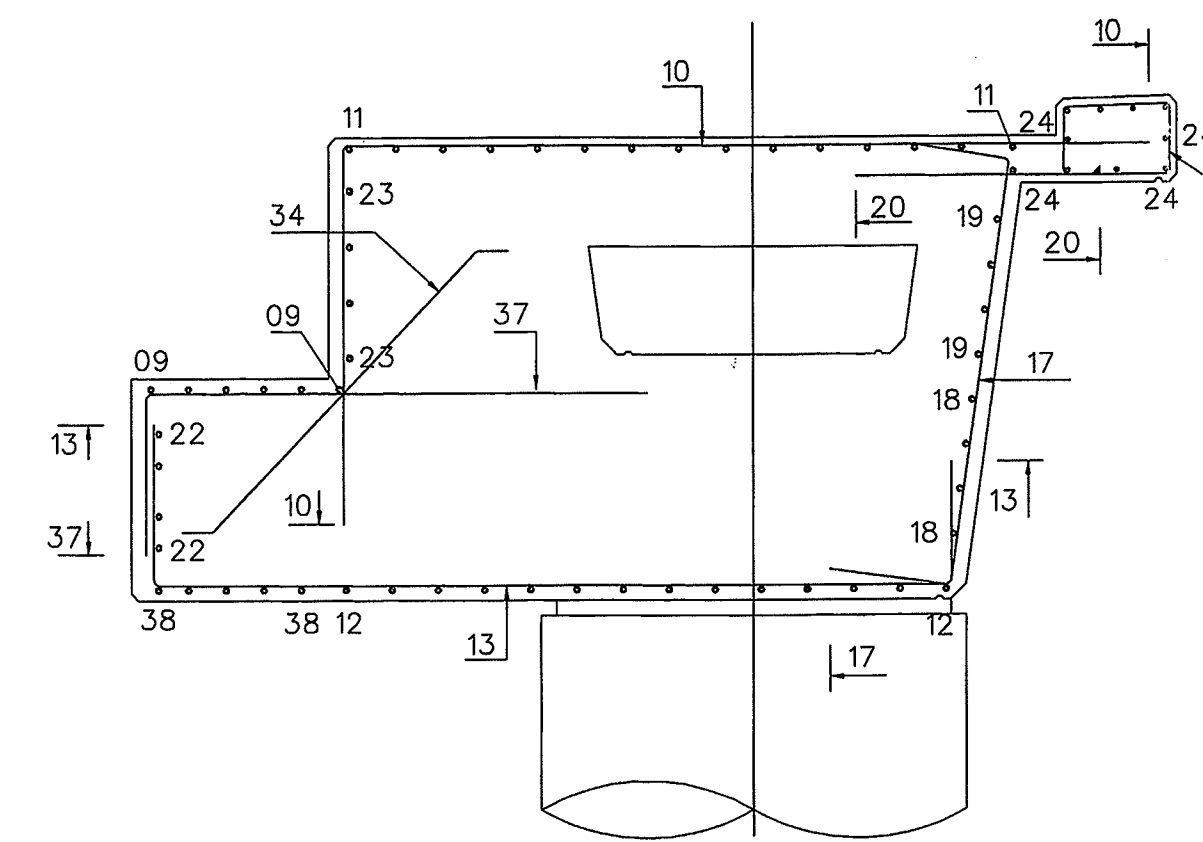


SECTION 2 - 2  
 SCALE 1:25

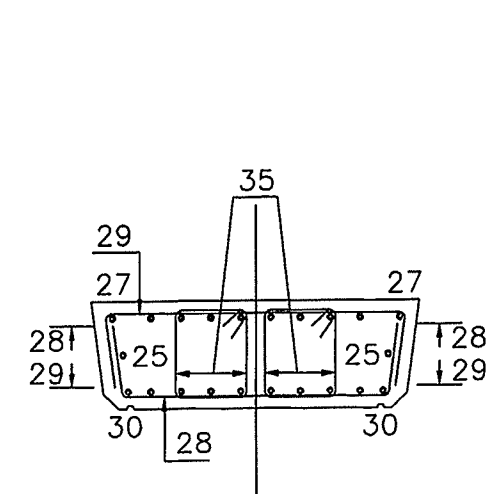

SECTION 3 - 3  
 SCALE 1:25

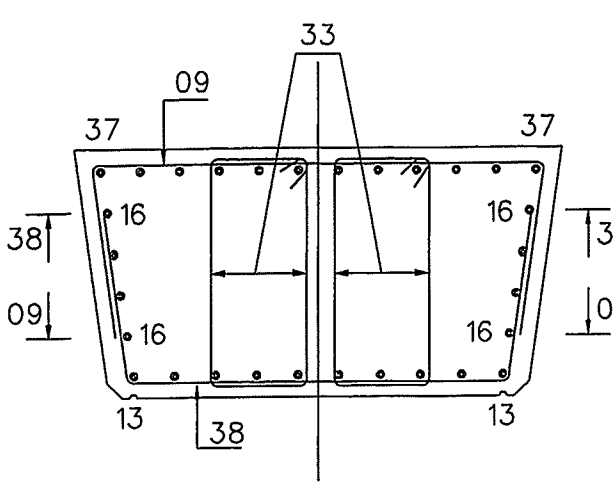

SECTION 4 - 4  
 SCALE 1:25

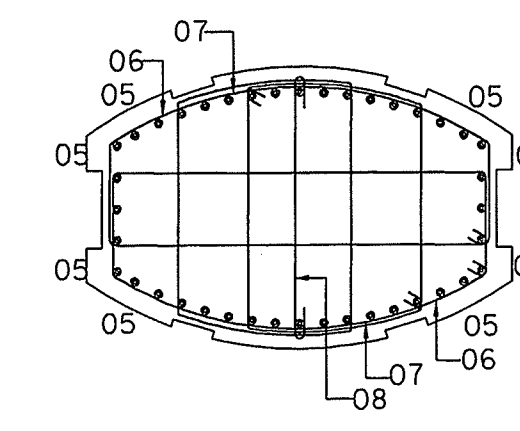

SECTION 5 - 5  
 SCALE 1:25

AS-CONSTRUCTED  
 DRAWING

Major Works Project Management Office,  
 Highways Department,  
 Hong Kong

Project No. 6553TH Contract No. HY / 99 / 18

**Meinhardt Halcrow JV**  
 Sub-Consultants  
 ACL Asia, MVA Asia Ltd.,  
 Townland Consultants Ltd., Chesterton Petty Ltd.  
 Contract Title  
 Castle Peak Road Improvement Between  
 Sham Tseng and Ka Loon Tsuen, Tsuen Wan

Drawing Title  
**FOOTBRIDGE No. 01**  
**NORTH PIER**  
**REINFORCEMENT DETAILS**

Drawn CPS/LLM Checked LC/LC Approved HL/LL  
 Scale 1:25, 1:50 CAD File No. TFB0161 Date NOV 2007  
 AT/AT

Drawing No. 90612/T/FB/0161 Rev Z

# Part C - Checking of Existing Column

**Existing Footbridge Loading**  
Span: 29m/2

**DL of Beam and Deck:**

Mass of concrete x sectional area x length  
 $25 \times 1.48 \times 29/2 = 537 \text{ kN}$

Factored Load  
 $1.35 \times 537 = 724 \text{ kN}$

**DL of Steel Roof:**

Steel (kPa) x width x length  
 $1.5 \times 2.8 \times 29/2 = 61 \text{ kN}$

Factored Load  
 $1.2 \times 61 = 74 \text{ kN}$

**SDL on Beam and Deck:**

Mass of finishes x thickness x width x length  
 $23.6 \times 0.065 \times 2 \times 29/2 = 44.5 \text{ kN}$

Factored Load  
 $1.5 \times 44.5 = 67 \text{ kN}$

**LL on Beam and Deck:**

LL (kPa) x width x length  
 $5 \times 2 \times 29/2 = 145 \text{ kN}$

Factored Load  
 $1.35 \times 145 = 196 \text{ kN}$

**Existing Staircase Loading**  
Span: 9.5m/2

**DL of Beam and Staircase:**

Mass of concrete x Beam sectional area x length  
 + Mass of concrete x stair thickness x Area  
 $25 \times 0.7 \times 9.5/2 + 25 \times 0.3 \times 2.8 \times 9.5/2 = 182 \text{ kN}$

Factored Load  
 $1.35 \times 182 = 246 \text{ kN}$

**DL of Steel Roof:**

Steel (kPa) x width x length  
 $1.5 \times 2.8 \times 9.5/2 = 20 \text{ kN}$

Factored Load  
 $1.2 \times 20 = 24 \text{ kN}$

**SDL on Beam and Staircase:**


Mass of finishes x thickness x width x length  
 $23.6 \times 0.05 \times 2 \times 9.5/2 = 12 \text{ kN}$

Factored Load  
 $1.5 \times 12 = 18 \text{ kN}$

**LL on Beam and Staircase:**

LL (kPa) x width x length  
 $5 \times 2 \times 9.5/2 = 48 \text{ kN}$

Factored Load  
 $1.35 \times 48 = 65 \text{ kN}$

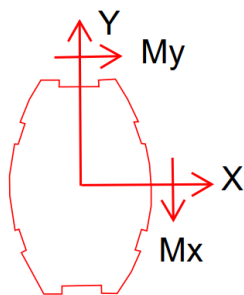

Existing Staircase

Existing Footbridge

**Earthquake Loading Estimation**

Refer to Clause 4.2 of SDMHR 2013, the reference return period, TNCR, shall be taken as 475 years, Class I with importance factor 1.0. Based on the past bridge design experience, a conservative 15% of Total load (DL+SDL+LL) will be adopted for seismic horizontal force at column top

Existing Footbridge Earthquake Lateral Load:  
 $0.15 \times (537+61+44.5+145) = 119 \text{ kN}$

Existing Staircase Earthquake Lateral Load:  
 $0.15 \times (182+20+12+48) = 40 \text{ kN}$

**Loading Summary for Column**

Gravity Load = (Factored DL + SDL + LL) =  $(724+74+67+196+246+24+18+65)$   
 $= 1061+353 = 1414 \text{ kN}$

Consider wind =  $1414 \times 1.2 = 1697 \text{ kN}$

**Moment x (Mx):**

Gravity Load of bridge with wind x level arm of corbel =  $1061 \times 1.2 \times 1.6 = 2038 \text{ kNm}$

Earthquake moment =  $119 \times 7(\text{Column Length}) = 833 \text{ kNm}$

Accidental Load =  $205 \times (2+3) = 1025 \text{ kNm}$

Total Mx =  $3896 \text{ kNm}$

**Moment y (My):**

Gravity Load of bridge with wind x level arm of corbel =  $353 \times 1.2 \times 1.6 = 678 \text{ kNm}$

Earthquake moment =  $40 \times 7(\text{Column Length}) = 280 \text{ kNm}$

Accidental Load =  $85 \times (2+3) = 425 \text{ kNm}$

Total My =  $1383 \text{ kNm}$

## Column

General column design by PROKON. (GenCol Ver W2.4.01 - 01 Apr 2008)

Design code : HK Concrete 2013


### General design parameters:

Given:

$L_0 = 7.000$  m  
 $f_{cu} = 45$  MPa  
 $f_y = 460$  MPa  
 $A_c = 1014955$  mm<sup>2</sup>

Assumptions:

- (1) The general conditions of clause are applicable.
- (2) The specified design axial loads include the self-weight of the column.
- (3) The design axial loads are taken constant over the height of the column.
- (5) Concrete simplified stress block depth set at  $0.9x$ ;  $x$  = N.A. depth ;  $f_{cu}$  in MPa

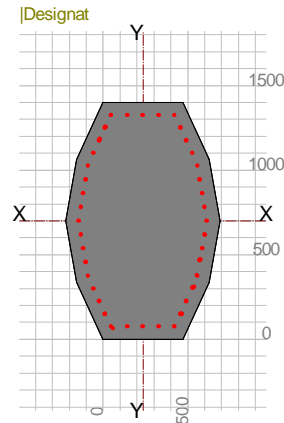

C13

### Design approach:

The column is designed using an iterative procedure:

- (1) An area of reinforcement is chosen.
- (2) The column design charts are constructed.
- (3) The corresponding slenderness moments are calculated.
- (4) The design axis and design ultimate moment are determined .
- (5) The design axial force and moment capacity is checked on the relevant design chart.
- (6) The safety factor is calculated for this load case.

### Check column slenderness:

End fixity and bracing for bending about the Design axis:

At the top end: Condition 4 (free).

At the bottom end: Condition 1 (fully fixed).

The column is unbraced.

$\beta = 2.20$

Effective column height:

$l_e = \beta \cdot L_0 = 15.400$  m

Check if the column is slender:

$l_e/h = 20.0 > 10$

$\therefore$  The column is slender.

### Initial moments:

The initial end moments about the X-X axis:

M1 = Smaller initial end moment = -0.0 kNm

M2 = Larger initial end moment = 3896.0 kNm

The initial moment near mid-height of the column :

$\therefore M_i = 0.4M_1 + 0.6M_2 \geq 0.4M_2 = -2337.6$  kNm

The initial end moments about the Y-Y axis:

M1 = Smaller initial end moment = -0.0 kNm

M2 = Larger initial end moment = 1383.0 kNm

6.1

Table 6.11

6.2.1.1(b)

6.2.1.3(b)

The initial moment near mid-height of the column :

$$\therefore M_i = 0.4M_1 + 0.6M_2 \geq 0.4M_2 = -829.8 \text{ kNm}$$

6.2.1.3(b)

**Deflection induced moments:**

Design ultimate capacity of section under axial load only:

$$N_{uz} = 0.45 \cdot f_{cu} \cdot A_c + 0.87 \cdot f_y \cdot A_{sc} = 30370.3 \text{ kN}$$

6.2.1.3(a)

Maximum allowable stress and strain:

$$\text{Allowable compression stress in steel, } f_{sc} = 0.87 \cdot f_y = 400.0 \text{ MPa}$$

$$\text{Allowable tensile stress in steel, } f_{st} = 0.87 \cdot f_y = 400.0 \text{ MPa}$$

$$\text{Allowable tensile strain in steel, } \epsilon_y = f_{st}/E_s = 0.0020 \text{ m/m}$$

$$\text{Allowable compressive strain in concrete, } \epsilon_c = 0.0035 \text{ m/m}$$

**For bending about the weakest axis:**

Weakest axis lies at an angle of  $-89.78^\circ$  to the X-X axis

Overall dimension perpendicular to weakest axis  $h_{-dc} = 834 \text{ mm}$

Balanced neutral axis depth,  $x_b = e_c/(e_c + e_s) \cdot (h_{-dc}) = 530.7 \text{ mm}$

$$N_{bal} = 0.44 \cdot b \cdot f_{cu} \cdot x_{bal} + \sum(A_{st} \cdot f_s + A_{sc} \cdot f_{sd}) = 12018.1 \text{ kN}$$

$$K = (N_{uz} - N) / (N_{uz} - N_{bal}) = 1.000 \leq 1.0$$

$$\beta_a = (1/2000) \cdot (l_e/h)^2 = 0.200$$

$$\therefore M_{add} = N \cdot \beta_a \cdot K \cdot h = 309.6 \text{ kNm}$$

$$\therefore M_{addx} = M_{add} \cdot \cos(-89.78^\circ) = 1.2 \text{ kNm}$$

$$\therefore M_{addy} = M_{add} \cdot \sin(-89.78^\circ) = 309.6 \text{ kNm}$$

**Design ultimate load and moment:**

Design axial load:

$$P_u = 1697.0 \text{ kN}$$


For bending about the X-X axis, the maximum design moment is the greatest of:

$$(a) M_2 + M_{addx} = -3896.0 \text{ kNm}$$

$$(b) e_{min} \cdot N = 33.9 \text{ kNm}$$

$$\therefore M_x = 3897.2 \text{ kNm}$$

6.2.1.3(g)

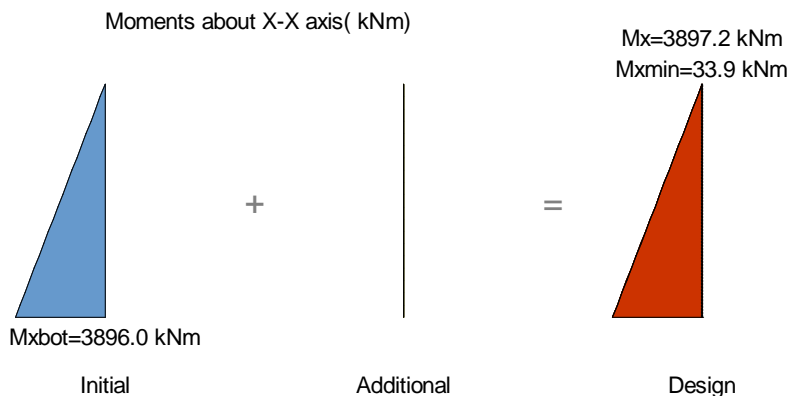

For bending about the Y-Y axis, the maximum design moment is the greatest of:


$$(a) M_2 + M_{addy} = -1383.0 \text{ kNm}$$

$$(b) e_{min} \cdot N = 33.9 \text{ kNm}$$

$$\therefore M_y = 1692.6 \text{ kNm}$$

6.2.1.3(g)

Job Number		Sheet
Job Title		
Client		
Calcs by	Checked by	Date

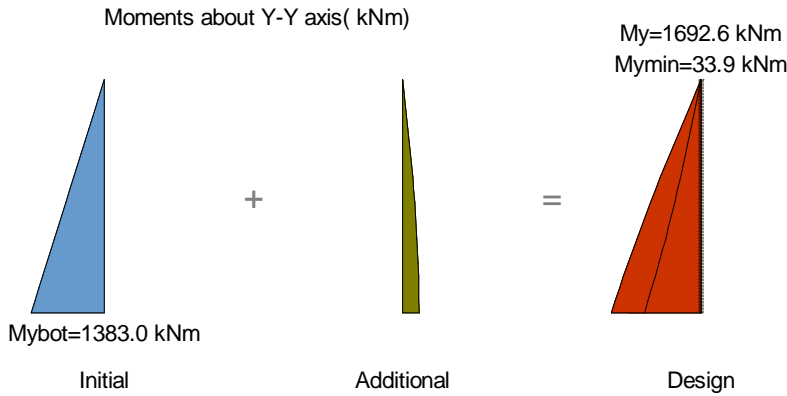

Check for minimum eccentricity:

Check that the eccentricity exceeds the minimum in the plane of bending:

Use  $e_{min} = 20\text{mm}$

$\therefore M_{min} = 33.9 \text{ kNm}$  about the X-X axis.

6.2.1.2(d)

### Design of column section for ULS:

The column is checked for applied moment about the design axis.


Through inspection: the critical section lies at the bottom end of the column.

The design axis for the critical load case 1 lies at an angle of  $336.52^\circ$  to the X-axis

The safety factor for the critical load case 1 is 1.28

For bending about the design axis:


**FOS = 1.28 > 1 OK!**

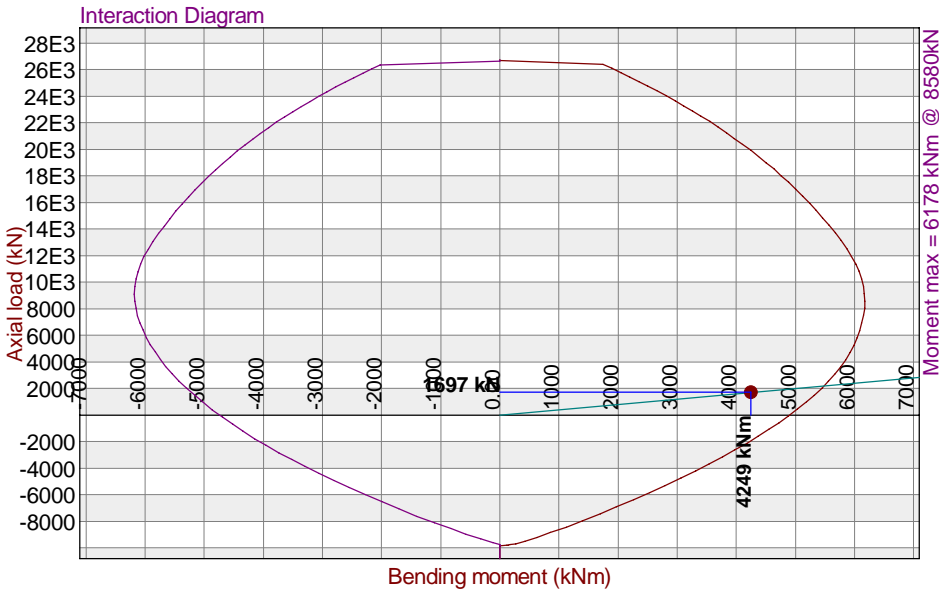



Moment distribution along the height of the column for bending about the design axis:  
 At the top,  $M_x = 33.9 \text{ kNm}$   
 Near mid-height,  $M_x = 2411.9 \text{ kNm}$   
 At the bottom,  $M_x = 4248.9 \text{ kNm}$

### Stresses at the bottom end of the column for the critical load case 1

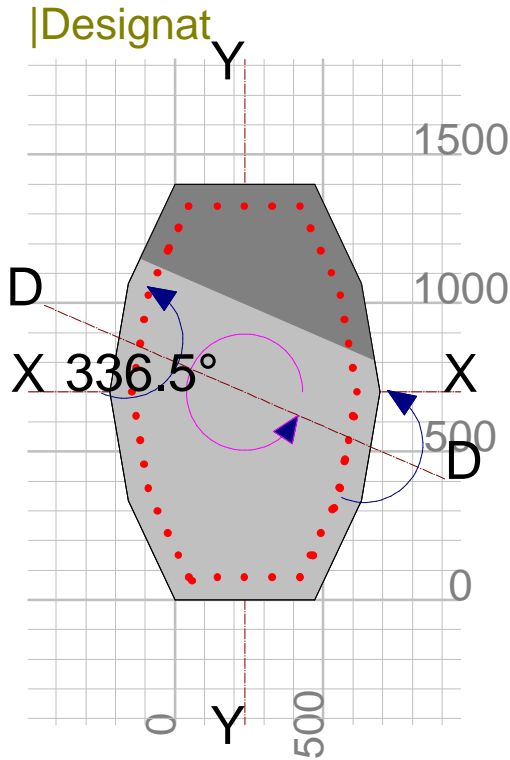

### Summary of design calculations:

Design table for critical load case:

Moments and Reinforcement for LC 1:1			
	Top	Middle	Bottom
Madd-x (kNm)	0.0	0.9	1.2
Madd-y (kNm)	0.0	232.2	309.6
Mx (kNm)	0.0	-2336.7	3897.2
My (kNm)	0.0	-597.6	1692.6
M' (kNm)	33.9	2411.9	4248.9
Design axis (°)	0.00	345.65	336.52
Safety factor	15.76	2.56	1.28
Asc (mm <sup>2</sup> )	24544	24544	24544
Percentage	2.36 %	2.36 %	2.36 %
AsNom (mm <sup>2</sup> )	8120	8120	8120
Critical load case: LC 1			

Design results for all load cases:



Software Consultants (Pty) Ltd  
Internet: <http://www.prokon.com>  
E-Mail: [mail@prokon.com](mailto:mail@prokon.com)

Job Number		Sheet
Job Title		
Client		
Calcs by	Checked by	Date

Load case	Axis	N (kN)	M1 (kNm)	M2 (kNm)	Mi (kNm)	Madd (kNm)	Design	M (kNm)	M' (kNm)	Safety factor
Load case 1	X-X Y-Y	1697.0	0.0 0.0	-3896.0 -1383.0	-2337.6 -829.8	1.2 309.6	Bottom	3897.2 1692.6	4248.9	1.276

# Conclusion

The checking of existing column Type 2 is found satisfactory with  $FOS = 1.29 > 1$ . Therefore, the removal of the existing ramp will not affect the structural adequacy and will not cause stability problem of the column Type 2.

