

**Wilfred Ka Hing CHU/PLAND**

---

寄件者: Hazard Liu  
寄件日期: 2024年12月19日星期四 11:33  
收件者: Wilfred Ka Hing CHU/PLAND  
主旨: Re: Planning Application No. A/YL-LFS/539 - Departmental Comments  
附件: Page8.pdf; Figure 3ver5.pdf  
類別: Internet Email

Dear Wilfred CHU,

No recycle materials will be stored on the application site, open storage is marked on the layout plan in the attachment for your reference please.

Best regards

Joe LIU Kin Ting

Tel:

On Wed, Dec 18, 2024 at 5:31 PM Wilfred Ka Hing CHU/PLAND <[wkhchu@pland.gov.hk](mailto:wkhchu@pland.gov.hk)> wrote:

Dear Mr. Liu,

As spoken, please find our following comments for your further action please.

1. Please clarify whether the application includes the open storage of recyclable materials.
2. Please mark the area for open storage of construction materials on the layout plan.
3. It is noted that the layout plan is not drawn to scale, please revise accordingly.

Urgent Return receipt Expand Group Restricted Prevent Copy Confidential

Should you wish to submit further information in response to the above, please do so by **19.12.2024** and submit in writing to Secretary of the Town Planning Board (email: [tpbpd@pland.gov.hk](mailto:tpbpd@pland.gov.hk); Address: 15/F, North Point Government Offices, 333 Java Road, North Point, Hong Kong; Fax: 2877 0245) with copy to us. In submitting the further information, reference should be made to the TPB Guidelines No. 32B on the Submission of Further Information in Relation to Applications for Amendment of Plan, Planning Permission and Review.


Thanks and Regards,

Wilfred CHU

TP/YLW4, TMYLW DPO, PlanD

Tel: 2158 6290



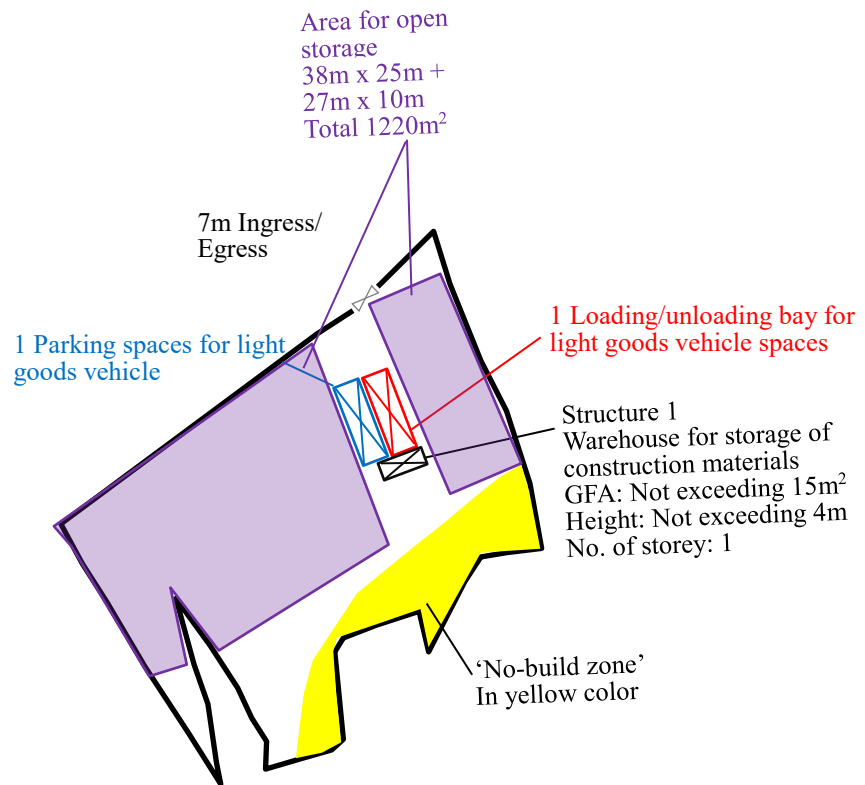

Project 項目名稱：

Temporary open storage of  
construction material for a  
Period of 3 Years at Lots 349  
in D.D.129, Lau Fau Shan  
Road, Ha Tsuen, Yuen Long,  
N.T.

Drawing Title 圖目：

Proposed Layout Plan

Remarks 備註：

Drawing No. 圖號：

Figure 3

Scale 比例：

1:1000