

**Wilfred Ka Hing CHU/PLAND**

---

寄件者: Wilfred Ka Hing CHU/PLAND  
寄件日期: 2025年01月07日星期二 9:54  
收件者: tpbpd/PLAND  
主旨: Fw: Further Information on Planning Application No. A/YL-PN/83  
附件: 布局設計圖.pdf

FI for A/YL-PN/83

**From:** PROJECT CONSULTANCY FBI  
**Sent:** Monday, January 6, 2025 12:57 PM  
**To:** Wilfred Ka Hing CHU/PLAND <[wkhchu@pland.gov.hk](mailto:wkhchu@pland.gov.hk)>  
**Subject:** Re: Clarification for Planning Application No. A/YL-PN/83

回覆 1. 不會有涉及動物寄養設施,批准後將會清走  
2. 佈局圖錯誤已更改

Wilfred Ka Hing CHU/PLAND <[wkhchu@pland.gov.hk](mailto:wkhchu@pland.gov.hk)> 於 2025年1月3日 週五 下午2:24寫道 :

Dear Mr. Chan,

Regarding your submission for planning application no. A/YL-PN/83, grateful if you could clarify on the following:

1. Based on our site inspection dated 31.12.2024, it is observed there are dedicated spaces for cats in the structures at the Site. Please clarify whether the application would involve animal boarding establishment and whether the cats and their dedicated spaces would be kept at the Site in future.
2. Based on our site inspection dated 31.12.2024, the uses of Structures D, E and F do not match with your layout plan. From our observation, Structure F was used for storing beach cleanup related items, Structure E was used for ecological education and Structure D was used for Chinese cultural education and other storage uses. Please review whether the layout plan is correct.

Thanks and Regards,


Wilfred CHU

Urgent Return receipt Expand Group Restricted Prevent Copy Confidential  
TP/YLW4, TMYLW DPO, PlanD

Tel: 2158 6290

申請地點內設有6個構築物：

構築物	總佔地面積	總樓面面積	佈置	用途
A(1層)	61平方米	61平方米	座地不高於4米	不密封停車位簷篷
B(1層)	46.8平方米	46.8平方米	座地不高於4米	洗手間
C(1層)	220平方米	220平方米	座地不高於7米	不密封簷篷戶外休息區及存物
D(1層)	157.5平方米	157.5平方米	座地不高於4米	不密封簷篷中國文化教育和其他儲存用途
E(1層)	58.4平方米	58.4平方米	座地不高於4米	不密封簷篷生態教育及用品區
F(1層)	88平方米	88平方米	座地不高於4米	密封簷篷存放海灘清潔相關物品
	631.7平方米	631.7平方米		

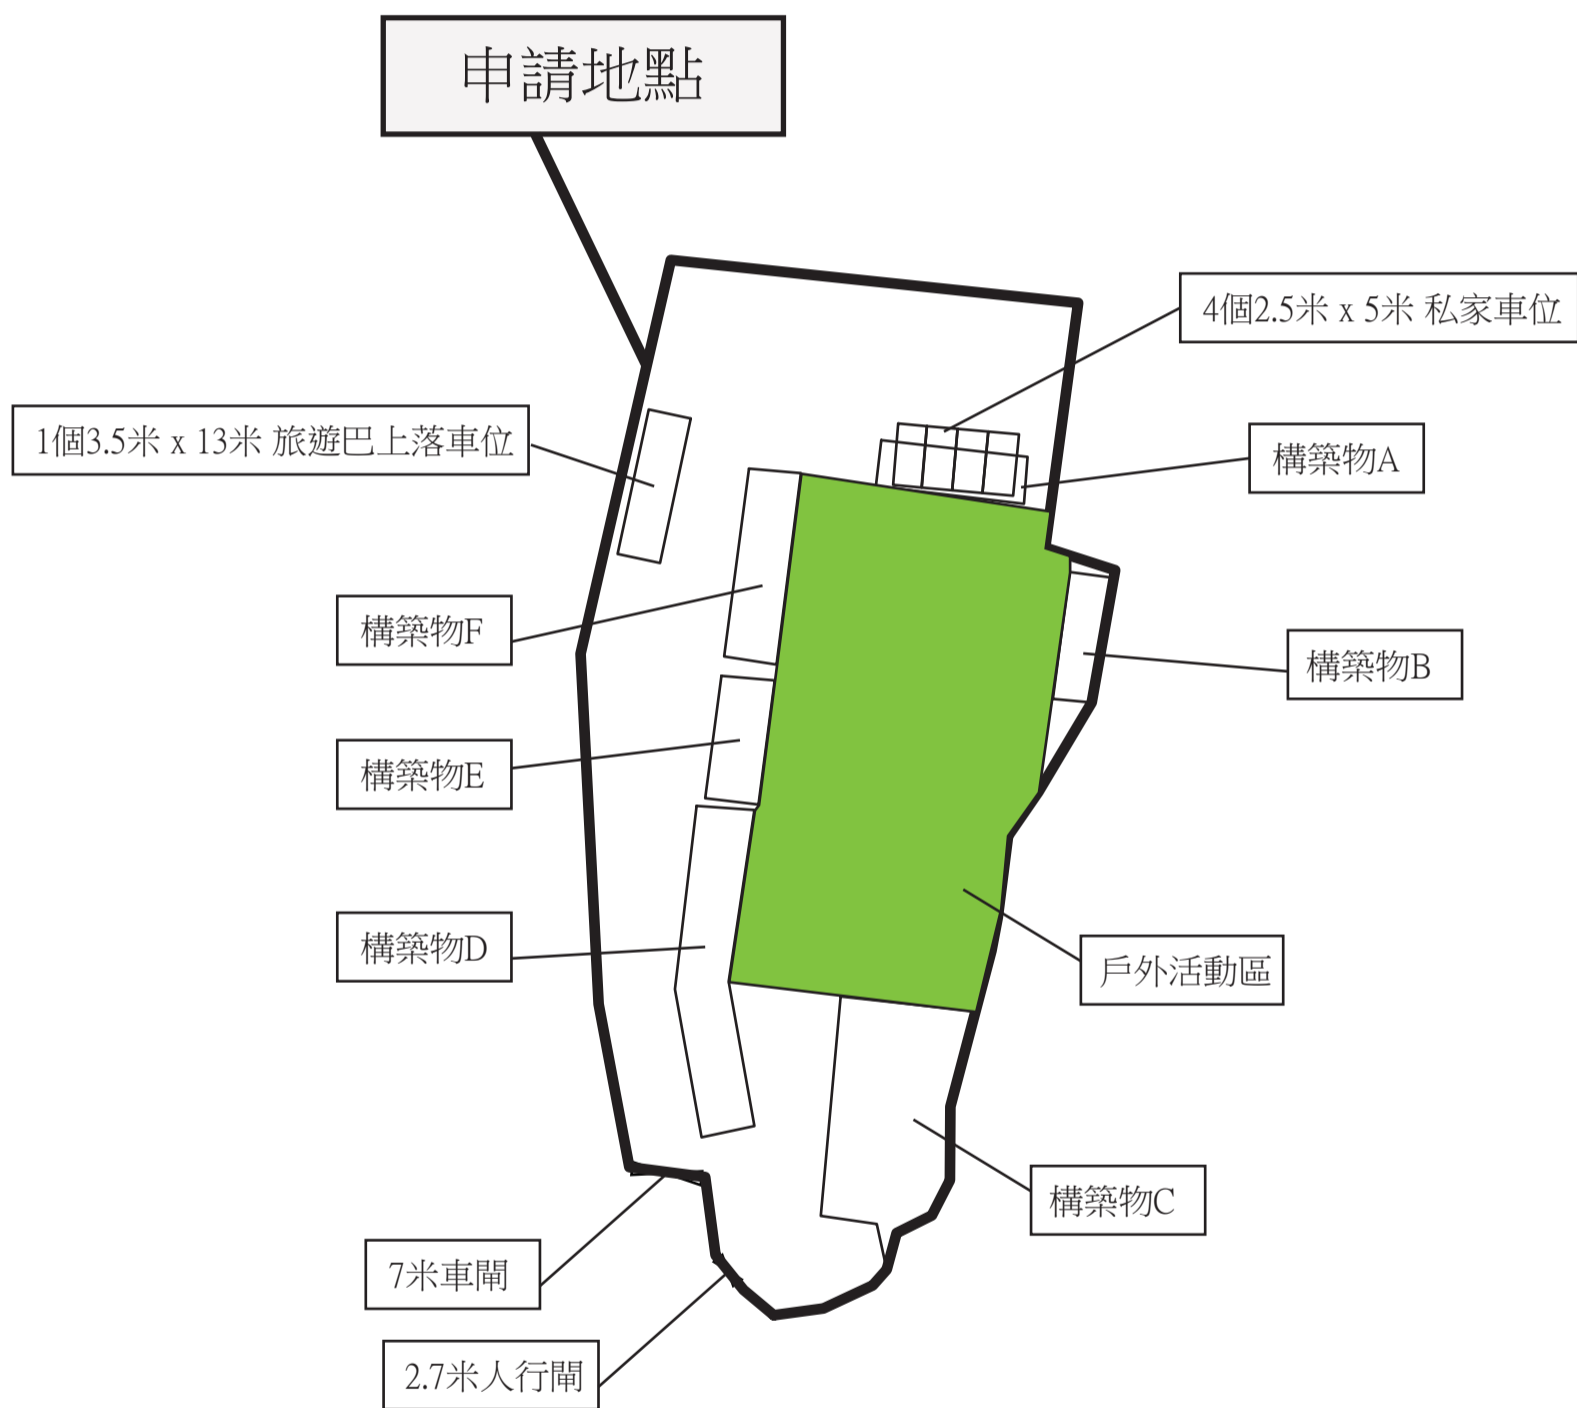

Project 項目名稱：  新界元朗白泥丈量約份第135約地段第68號(部份)、 第69號(部份)、第70號(部份)及71號(部份)土地	Remarks 備註：		Scale 比例：
	Drawing Title 圖紙標題：  布局設計圖	Drawing No 圖紙號：  圖 2	 FiBi International Project Consultancy Co. Limited