


Appendix 3

**Drainage Proposal submitted in the
Previous Approved Planning Application
No. A/YL-TYST/931**

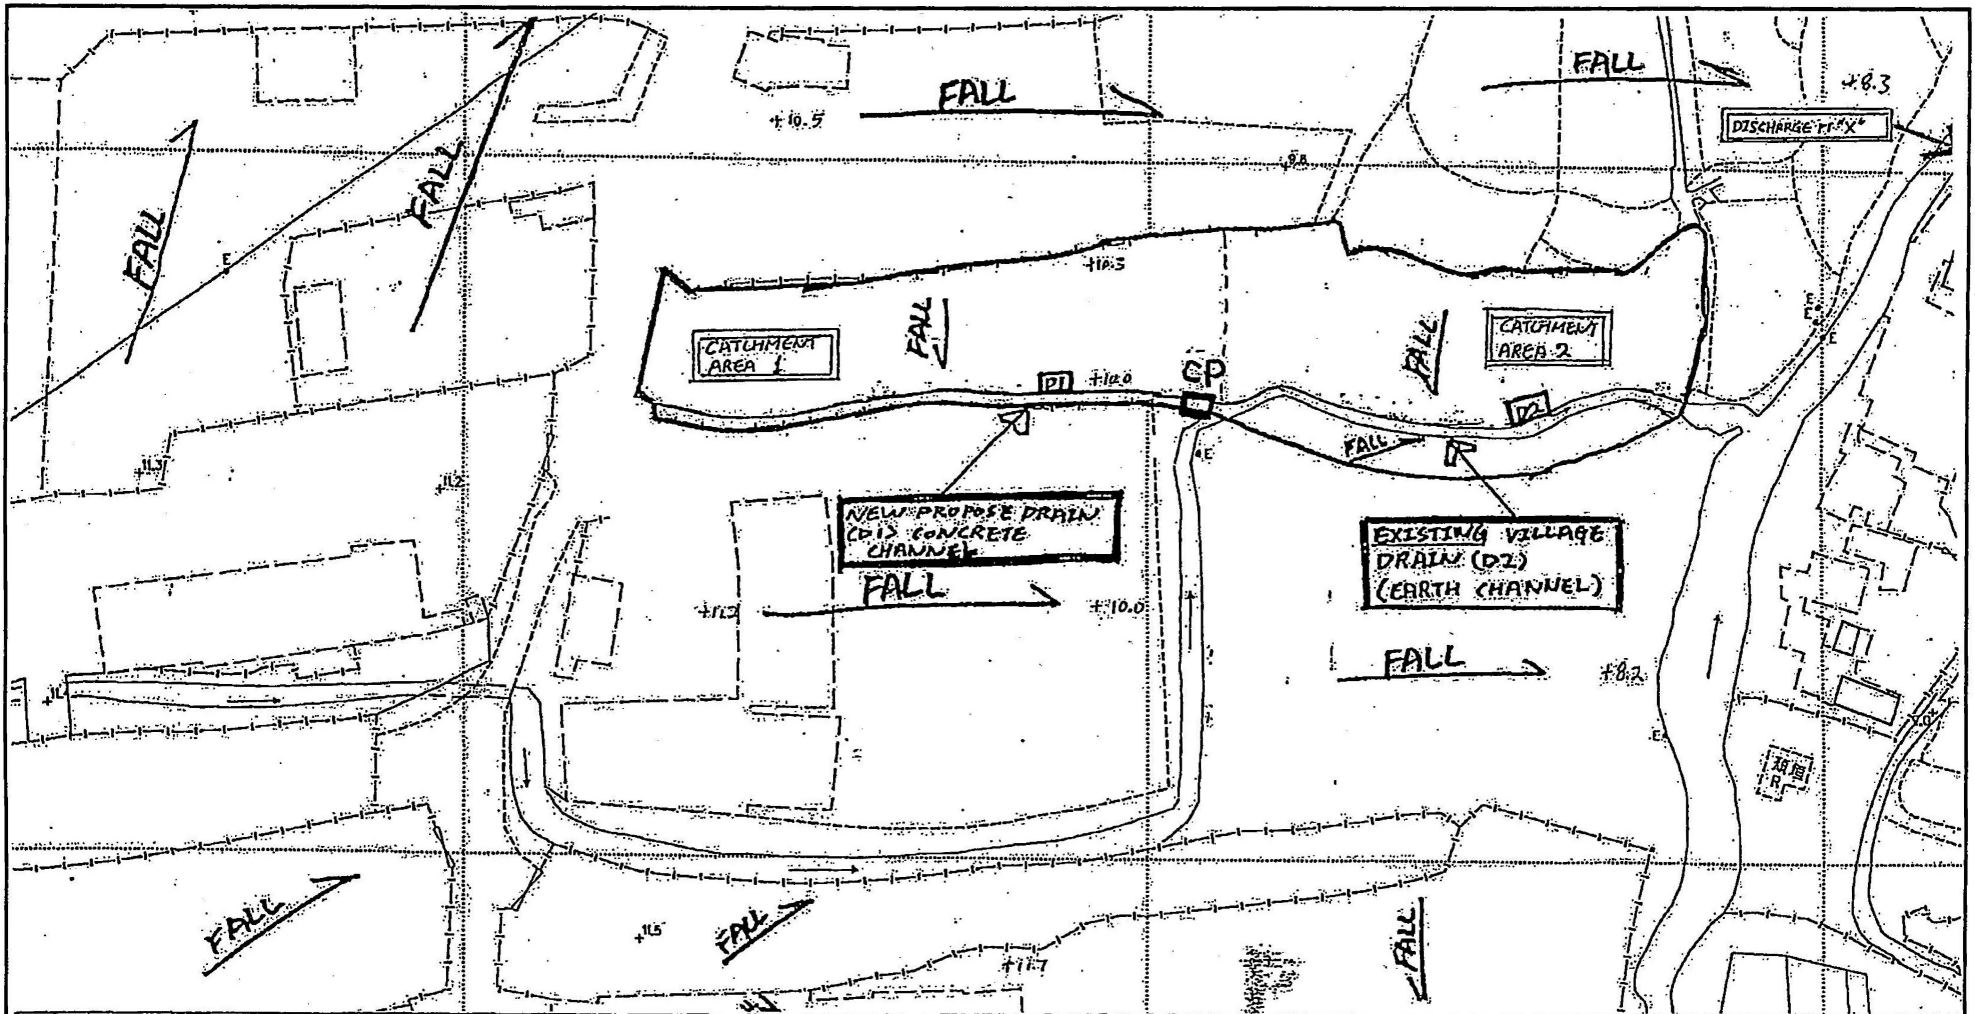

<p>LEGEND:</p> <ul style="list-style-type: none"> Application Site - Paved Concrete Sandy soil Grassland Stormwater Drainage System (including surface channel, earth channel, pipe and rubble) 	<ul style="list-style-type: none"> Proposed Sand Trap Adjacent Catchment Area Access Road CP CATCHPIT 	<p>Proposed Channel D1 (CONCRETE CHANNEL)</p>	<p>Existing Channel D2 (EARTH VILLAGE DRAIN)</p>	<p>Cross section Point 'A'</p>	<p>Drawing No. D-02 Scale: 1:1000</p> <p>Drainage Impact Assessment for open storage at various lots in DD119 Tong Yan San Tsuen, Yuen Long, N.T.</p>
--	--	---	--	--------------------------------	--

<p>Base Plan Extracted from Approved Drainage Plan in June 2003 (Application No. TPB/A/YL-TYST/186)</p>	<p>As-built Drainage Plan</p> <p>S16 Application for Temporary Open Storage of Recycling Materials (Metal, Plastic and Paper) and Used Electrical / Electronic Appliances and Parts with Ancillary Workshop and Packaging Activities at Various Lots in DD 119, Tong Yan San Tsuen, Yuen Long</p> <p>0 10 20 30 40 50 METRES</p>	<p>Plan 5</p> <p>Revision: Date: 17.5.2021</p>
---	--	--