

<p>Project 項目名稱: Proposed Temporary Shop and Services for a Period of 6 Years at Lot 2497 RP (Part) in D.D. 120, Shap Pat Heung Road, Yuen Long, N.T.</p>	<p>Drawing Title 圖目: Application Site</p>	<p>Remarks 備註:</p>
<p>Drawing No. 圖號: Figure 1</p>	<p>Scale 比例: 1:1000</p>	

N



Structure 2

Toilet

GFA: Not exceeding 2m²

Height: Not exceeding 4m

No. of storey: 1

8m wide
Ingress/Egress

One 7m x 3.5m loading/
unloading bay for
light goods vehicle

Structure 1

Shop & services

GFA: Not exceeding 170m²

Height: Not exceeding 4m

No. of storey: 1



Project 項目名稱:

Proposed Temporary Shop and Services for a Period of 6 Years at Lot 2497 RP (Part) in D.D. 120, Shap Pat Heung Road, Yuen Long, N.T.

Drawing Title 圖目:

Proposed Layout Plan


Remarks 備註:


Drawing No. 圖號:

Figure 2

Scale 比例:

1:1000

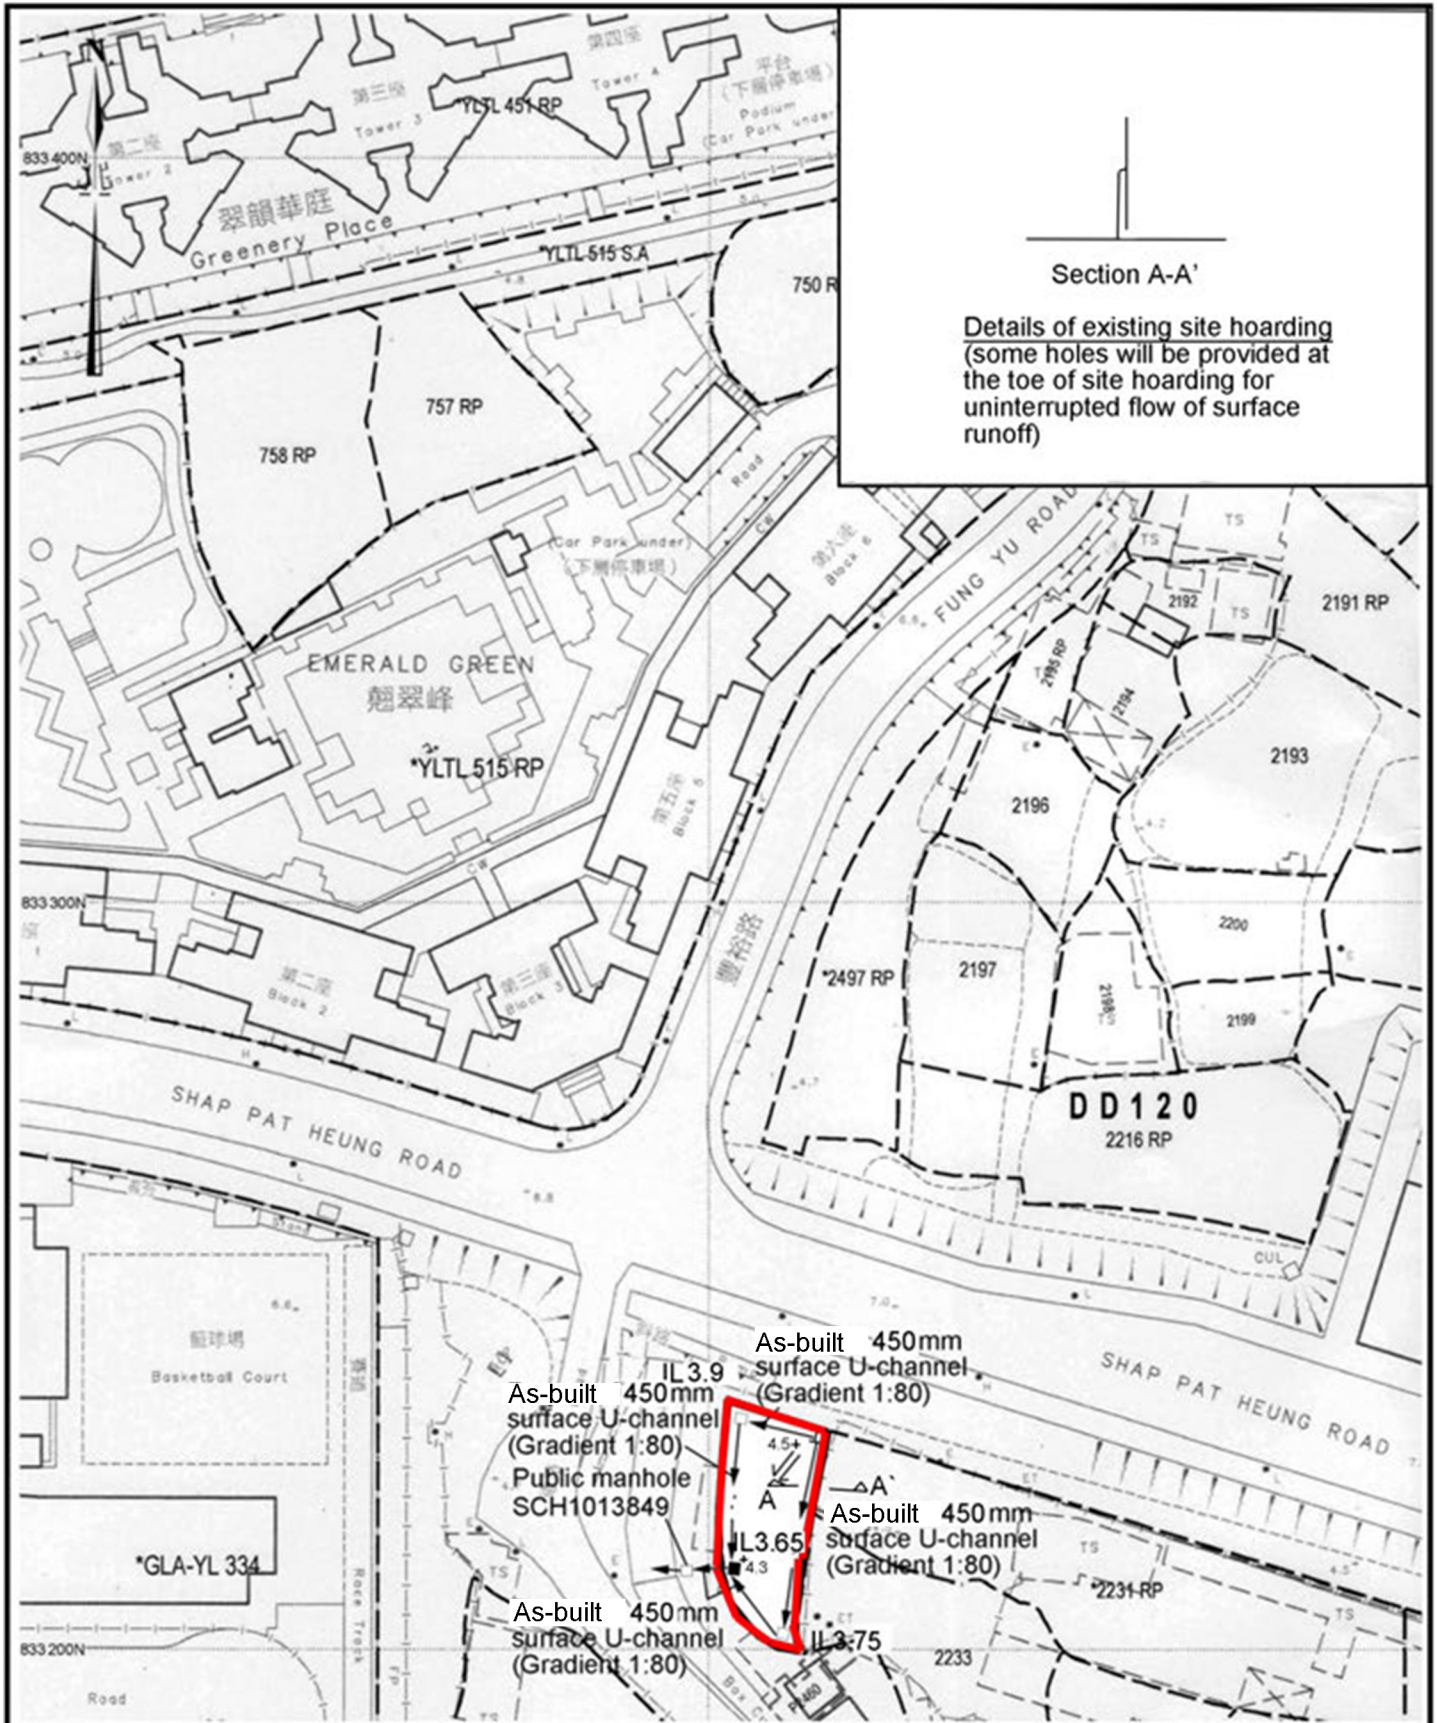


Section A-A'
 Details of existing site hoarding
 (some holes will be provided at
 the toe of site hoarding for
 uninterrupted flow of surface
 runoff)

Project 項目名稱:
 Proposed Temporary Shop and Services for a Period of 6 Years at Lot 2497 RP (Part) in D.D. 120, Shap Pat Heung Road, Yuen Long, N.T.

Drawing Title 圖目:
 As-built Drainage Plan

Remarks 備註:
 ■ Catchpit with sand trap
 □ Catchpit
 — Site hoarding
 ⇐ Flow of surface runoff
 +4.5 Level (in mPD)

Drawing No. 圖號:
 Figure 3

Scale 比例:
 1:1000