


<p>Project 項目名稱: Proposed Temporary Shop and Services for a Period of 6 Years at Lot 2497 RP (Part) in D.D. 120, Shap Pat Heung Road, Yuen Long, N.T.</p>	<p>Drawing Title 圖目: Application Site</p>	<p>Remarks 備註:</p>
<p>Drawing No. 圖號: Figure 1</p>	<p>Scale 比例: 1:1000</p>	

N

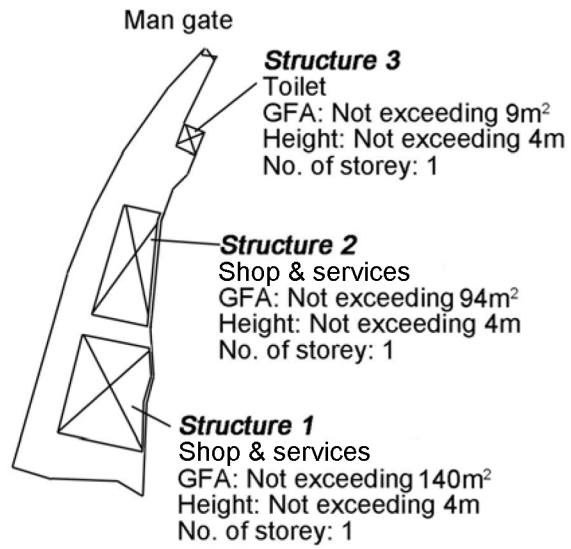

Project 項目名稱:

Proposed Temporary Shop and Services for a Period of 6 Years at Lot 2497 RP (Part) in D.D. 120, Shap Pat Heung Road, Yuen Long, N.T.

Drawing Title 圖目:

Proposed Layout Plan


Remarks 備註:

Drawing No. 圖號:

Figure 2

Scale 比例:

1:1000

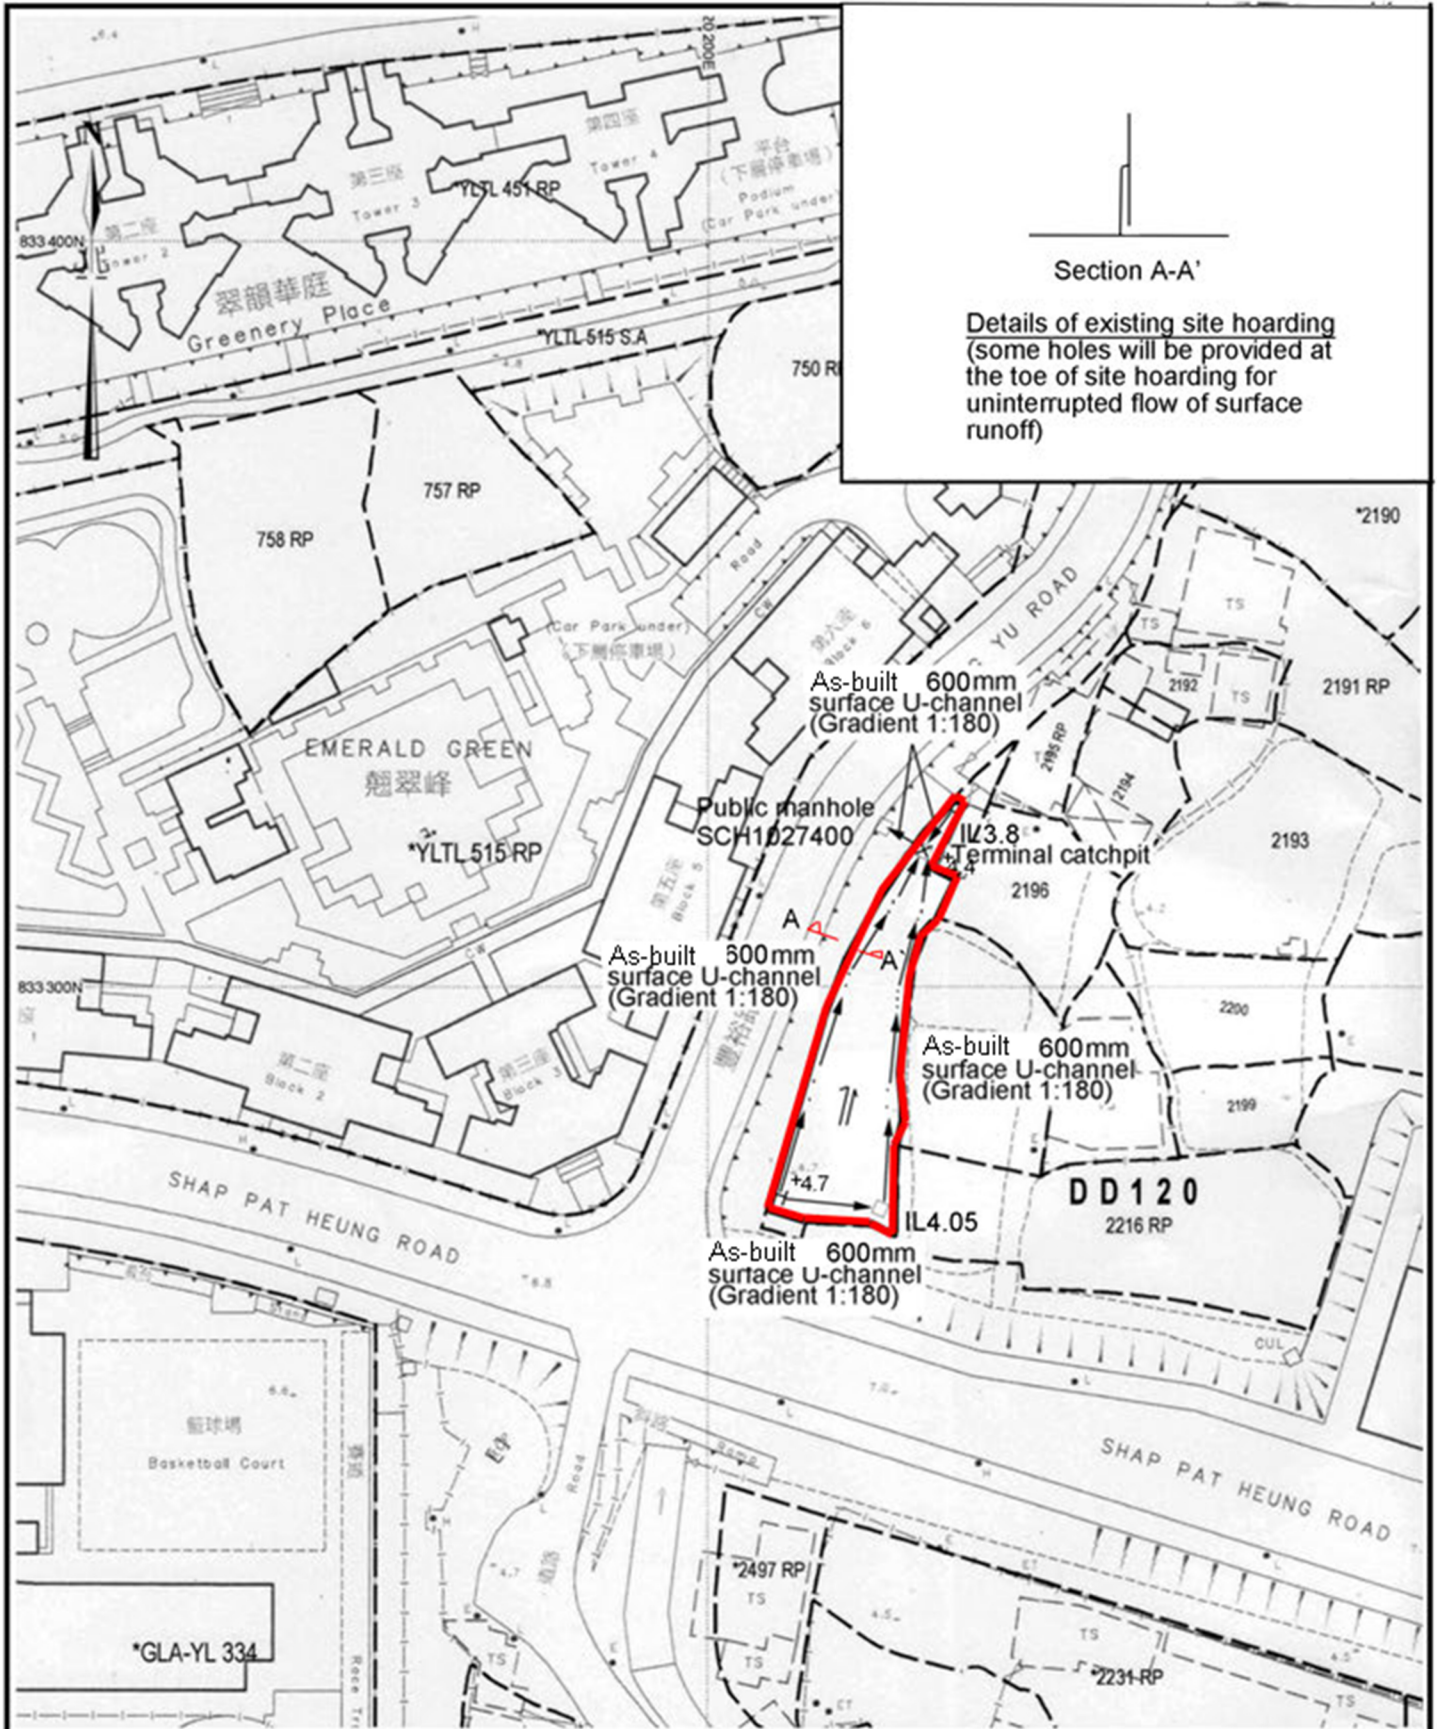

Section A-A'

Details of existing site hoarding (some holes will be provided at the toe of site hoarding for uninterrupted flow of surface runoff)

<p>Project 項目名稱: Proposed Temporary Shop and Services for a Period of 6 Years at Lot 2497 RP (Part) in D.D. 120, Shap Pat Heung Road, Yuen Long, N.T.</p>	<p>Drawing Title 圖目: As-built Drainage Plan</p>	<p>Remarks 備註: <input type="checkbox"/> Catchpit <input checked="" type="checkbox"/> Catchpit with sand trap Flow of surface runoff +4.7 Level (in mPD) site hoarding</p>
	<p>Drawing No. 圖號: Figure 3</p>	<p>Scale 比例: 1:1000</p>