

S12A Application for Amendment of Plan for Proposed Innovation and Technology Hub at  
Various Lots in D.D. 82 and D.D. 86 and Adjoining Government Land, Man Kam To, New Territories

(Application No. Y/NE-MKT/1)

Responses to Departmental Comments – February 2025

## **Appendix B**

### **Revised Water Supply Impact Assessment**

Hong Kong International Innovation and Technology Hub Limited

**S12A Planning Application for  
Proposed Innovation and  
Technology Hub at Various Lots  
in D.D. 82 and D.D. 86 and  
Adjoining Government Land,  
Man Kam To, New Territories**

Water Supply Impact Assessment

Final | Feb 2025

This report takes into account the particular instructions and requirements of our client. It is not intended for and should not be relied upon by any third party and no responsibility is undertaken to any third party.

Job number

**Arup Hong Kong Limited**

Level 5 Festival Walk

80 Tat Chee Avenue

Kowloon Tong

Kowloon

Hong Kong

[www.arup.com](http://www.arup.com)

**ARUP**

# Contents

---

	Page
<b>1      Introduction</b>	<b>1</b>
1.1      Background	1
1.2      Purpose of this Report	1
<b>2      Project Description</b>	<b>2</b>
2.1      Site Area	2
2.2      Development Parameters	2
<b>3      Water Supply Impact Assessment</b>	<b>5</b>
3.1      Methodology and Design Criteria	5
3.2      Existing Water Supply System	6
3.3      Water Demand Estimation	7
3.4      Potential Impact to Existing and Planned Waterworks Facilities	7
3.5      Proposed Water Supply System	8
<b>4      Conclusion</b>	<b>11</b>

## Appendices

**Appendix A** Master Layout Plan

**Appendix B** Existing WSD Water Main Record Plans

**Appendix C** Estimation of Fresh Water Demand

**Appendix D** Hydraulic Calculation

# **1      Introduction**

---

## **1.1     Background**

- 1.1.1    The Applicant proposes amendments to the Approved Man Kam To Outline Zoning Plan No. S/NE-MKT/4 (“the OZP”) by rezoning the Application Site from “Agriculture” (“AGR”), “Green Belt” (“GB”) and “Government, Institution or Community” (“G/IC”) to a tailor-made “Other Specified Uses” (“OU”) annotated “Innovation and Technology Hub”, with a maximum non-domestic gross floor area (GFA) of 365,180 m<sup>2</sup> and a maximum domestic GFA of 170,400 m<sup>2</sup> (including dormitory) and maximum building heights (BH) of 80, 90, 110 and 120 meters above principal datum (mPD) for four sub-areas respectively, to facilitate the development of the proposed Innovation and Technology (I&T) Hub.
- 1.1.2    Currently, the Application Site is largely vacant with vegetation and inactive farmland, and covers a portion of the access road from Lin Ma Hang Road leading to the existing River Ganges Pumping Station.
- 1.1.3    The Application Site, with a site area of about 125,863 m<sup>2</sup>, is located at Man Kam To in the North District. It is on a gentle sloping from site level of about 6mPD near Ping Yuen River to 25mPD near the eastern foot of Lo Shue Ling. The Application Site includes the Development Site (of an area about 102,461 m<sup>2</sup>) and remaining land parcels adjoining the development site for better rationalisation of boundary and land use zoning.

## **1.2     Purpose of this Report**


- 1.2.1    The purpose of the Water Supply Impact Assessment (WSIA) Report is to:
- Assess the potential impact of the proposed development on the existing water mains and installations maintained by WSD; and
  - Provide recommendations for mitigation measures and other improvement works where necessary to address the potential impact identified.

## 2 Project Description

### 2.1 Site Area

2.1.1 The Development Site is located in Man Kam To, New Territory, bounded by Ping Yuen River to the northeast, Lo Shue Ling to the west and Chow Tin Tsuen to the east. There is an existing public school surrounded by the site, as shown in **Figure 2.1**. In the vicinity of the Site there are mainly scattered village houses and agricultural land. A master layout plan of the Indicative Scheme in the Development Site is enclosed in **Appendix A**.

**Figure 2.1:** Location Plan of the Development Site

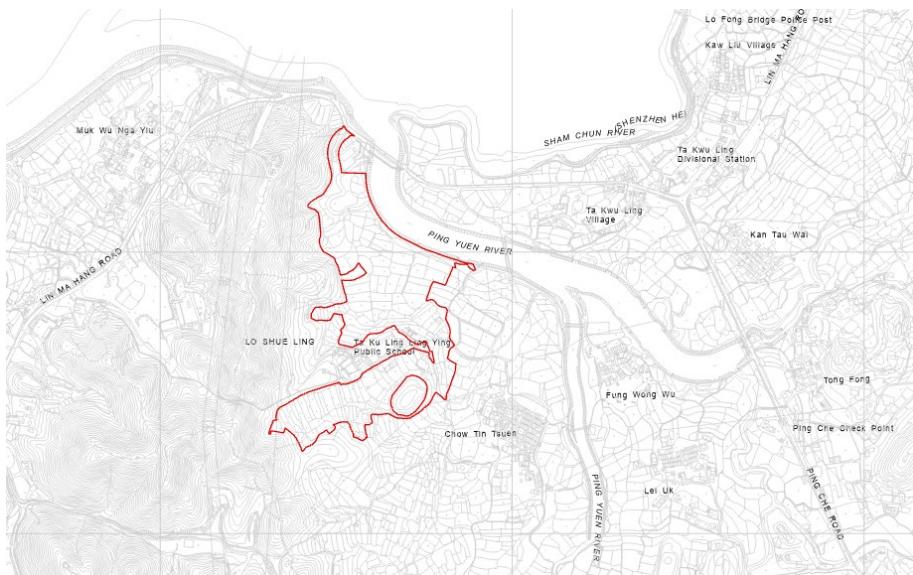

2.1.2 The current zoning of the Site is “AGR”, “GB”, and “G/IC” under the approved Man Kam To Outline Zoning Plan (OZP) No. S/NE-MKT/4. The total area of the Development Site is approximately 102,461 m<sup>2</sup>, and the total area of the Application Site is 125,863 m<sup>2</sup>.

### 2.2 Development Parameters

2.2.1 The development parameters of the Indicative Scheme are presented in **Table 2.1**:

**Table 2.1:** Key Development Parameters Table

	Indicative Scheme
<b>Application Site Area<sup>(1)</sup></b>	About 125,863 m <sup>2</sup>
<b>Development Site Area</b>	About 102,461 m <sup>2</sup>
<b>Total Plot Ratio<sup>(2)</sup></b>	5.23
- Non-Domestic PR	3.57
- Domestic PR	1.66
<b>Total Gross Floor Area</b>	535,580 m <sup>2</sup>
- Non-Domestic GFA	365,180 m <sup>2</sup>

	<b>Indicative Scheme</b>	
• <i>R&amp;D Centre</i>	<i>268,780 m<sup>2</sup></i>	
• <i>Data Centre</i>	<i>86,400 m<sup>2</sup></i>	
• <i>Commercial Centre</i>	<i>9,276 m<sup>2</sup></i>	
• <i>Kindergarten</i> <sup>(3)</sup>	<i>724 m<sup>2</sup></i>	
• <b>Domestic GFA</b>	<b>170,400 m<sup>2</sup></b>	
• <i>Ancillary Dormitories</i>	<i>63,900 m<sup>2</sup></i>	
• <i>Other Residential Uses</i>	<i>106,500 m<sup>2</sup></i>	
• <b>Clubhouse GFA</b> <sup>(4)</sup>	<b>3,500 m<sup>2</sup></b>	
<b>Building Height</b>		
• <i>R&amp;D Centre</i>	Building Height mPD No. of Storeys <sup>(5)</sup>	83m 90mPD 16
• <i>Data Centre</i>	Building Height mPD No. of Storeys <sup>(5)</sup>	73m 80mPD 12
• <i>Commercial Centre</i>	Building Height mPD No. of Storeys <sup>(5)</sup>	30m 37mPD 6
• <i>Ancillary Dormitories</i>	Building Height mPD No. of Storeys <sup>(6)</sup>	99-102.15m 110mPD 30-31
• <i>Other Residential Uses</i>	Building Height mPD No. of Storeys <sup>(6)</sup>	99-105.3m 120mPD 30-32
<b>Anticipated No. of Working Population</b>		6,207
• <i>R&amp;D Centre</i> <sup>(7)</sup>		5,375
• <i>Data Centre</i> <sup>(8)</sup>		432
• <i>Commercial</i> <sup>(9)</sup>		400
<b>No. of Units</b>		3,712
• <i>Ancillary Dormitories</i>		1,392
• <i>Other Residential uses</i>		2,320
<b>Average Flat Size</b> <sup>(10)</sup>		35.5 m <sup>2</sup>
<b>Anticipated Population</b> <sup>(11)</sup>		10,022
• <i>No. of Tenants of Ancillary Dormitories</i>		3,758
• <i>No. of Population of Other Residential Uses</i>		6,264
<b>Local Open Space</b>		Not less than 13,126 m <sup>2</sup>
• <i>For Workers</i>		<i>Not less than 3,104 m<sup>2</sup></i>
• <i>For Residents</i>		<i>Not less than 10,022 m<sup>2</sup></i>
<b>Target Completion Year</b>		2028

Remarks:

<sup>(1)</sup> Application Site includes the Development Site and remaining land parcels adjoining the Development Site for better rationalisation of boundary and land use zoning.

<sup>(2)</sup> PR calculations are based on the area of Development Site. May not add up due to rounding.

<sup>(3)</sup> The kindergarten with 6-classroom of about 724m<sup>2</sup> GFA fulfils the minimum floor space requirement specified in the EBD's Operation Manual for Pre-primary Institute. Indicative only, subject to detailed design.

<sup>(4)</sup> According to APP-104, a maximum area of 3,500m<sup>2</sup> can be applied for GFA concession for a development with domestic GFA of >100,000m<sup>2</sup> to 125,000m<sup>2</sup>. The clubhouse GFA (intended for use by residents of Other Residential Uses) is proposed to be exempted from GFA calculation.

<sup>(5)</sup> The no. of storeys excludes basement carparks.

<sup>(6)</sup> The no. of storeys excludes 1-storey lobby and basement carparks.

<sup>(7)</sup> An assumption of 50m<sup>2</sup> per worker is assumed for R&D Centre, with reference to Employment Density Guide (3rd Ed.) in the UK.

<sup>(8)</sup> An assumption of 200m<sup>2</sup> per worker is assumed for Data Centre, with reference to Employment Density Guide (3rd Ed.) in the UK.

<sup>(9)</sup> An assumption of 25m<sup>2</sup> per worker is assumed for commercial uses (retail, F&B), with reference to HKPSG Chapter 5.

<sup>(10)</sup> Average flat size is assumed as 35.5m<sup>2</sup> which has excluded area required for corridor, lift shaft, lobby, staircase, etc.

<sup>(11)</sup> A person per flat (PFF) ratio of 2.7 is assumed, according to the average household size of the Territory and North District in 2021 Census.

### **3 Water Supply Impact Assessment**

---

#### **3.1 Methodology and Design Criteria**

##### **Methodology**

3.1.1 The following approach is adopted in carrying out the Water Supply Impact Assessment.

- Identify the scope of the development;
- Determine the water demand of the development;
- Identify the existing water supply system within and in the vicinity of the proposed development boundary;
- Examine the impact arising from new water demand from the proposed development on the existing source of supply and the system capacity; and
- Identify improvement and upgrading works.

##### **Design Criteria**

###### ***Unit Demands***

3.1.2 The water demand for the proposed development has been estimated generally based on unit water demand in WSD's Departmental Instruction (DI) 1309 and the latest WSD planning standards.

3.1.3 The unit demands for some of the land uses used in the estimation of the freshwater and flushing water demands are obtained from EPD's "Guidelines for Estimating Sewage Flows for Sewage Infrastructure Planning" (GESF).

3.1.4 The following unit demands presented in **Table 3.1** below have been adopted for estimating the fresh and flushing water demands for the Proposed Development.

**Table 3.1 Unit Water Demands**

<b>Development Type</b>	<b>Fresh Water</b>	<b>Flushing Water</b>	<b>Unit</b>
R1 <sup>1</sup>	230	104	litre/person/day
Service Trade <sup>2</sup>	40	/	litre/person/day
Commercial Employee	30	50	litre/employee/day
Schools <sup>3</sup>	25	25	litre/person/day

<sup>1</sup> Reference is made to WSD comments.

<sup>2</sup> Reference is made to WSD comments.

<sup>3</sup> Reference is made to WSD DI No.1309 Table 1.

<b>Development Type</b>	<b>Fresh Water</b>	<b>Flushing Water</b>	<b>Unit</b>
Irrigation <sup>4</sup>	7	/	litre/m <sup>2</sup> /day

***Water Treatment Works (WTW):***

- 3.1.5 1.2 times mean daily demand (MDD) for mean daily demand > 100 Million Litre per Day (MLD);

***Fresh Water Service Reservoir (FWSR) Capacity:***

- 3.1.6 In accordance with DI 1309, 75% of MDD shall be designed for storage capacity of FWSR in interconnected supply zones.

***Peaking Factors for Trunk and Distribution Mains:***

- 3.1.7 The peaking factors will be in accordance with WSD's DI No. 1309 and are summarised below:

- Peak flow rates in freshwater trunk main supplying a single service reservoir – 1.5 times mean daily demand;
- Peak flow rates in distribution mains for fresh water – 3 times mean daily demand
- Peak flow rates in distribution mains for flush water – 2 times mean daily demand

***Residual Head:***

- 3.1.8 The residual head for the fresh water supply system will be assessed with the following design scenario:

- Fresh Water System – 20m.

## 3.2 Existing Water Supply System

- 3.2.1 The development falls within supply zone of Ping Che Fresh Water Service Reservoir (FWSR). Ping Che FWSR has a design storage capacity of 20,000 m<sup>3</sup> with Top Water Level (TWL) as 87.0mPD. The application site is located approximately 3,200m from Ping Che FWSR.

- 3.2.2 There is no salt water or reclaimed water system in the vicinity of the Development Site.


- 3.2.3 According to the received WSD water main record plans (**Appendix B**), a section of the existing DN300 freshwater main is identified about 600m east from the application site along Ping Che

---

<sup>4</sup> Reference is made to Table 3-4 of WSD's Technical Specifications on Grey Water Reuse and Rainwater Harvesting.

Road and a DN200 water main along Lin Ma Hang Road, as illustrated in **Figure 3.1**.

**Figure 3.1:** Existing Fresh Water Mains in the Vicinity of the Site

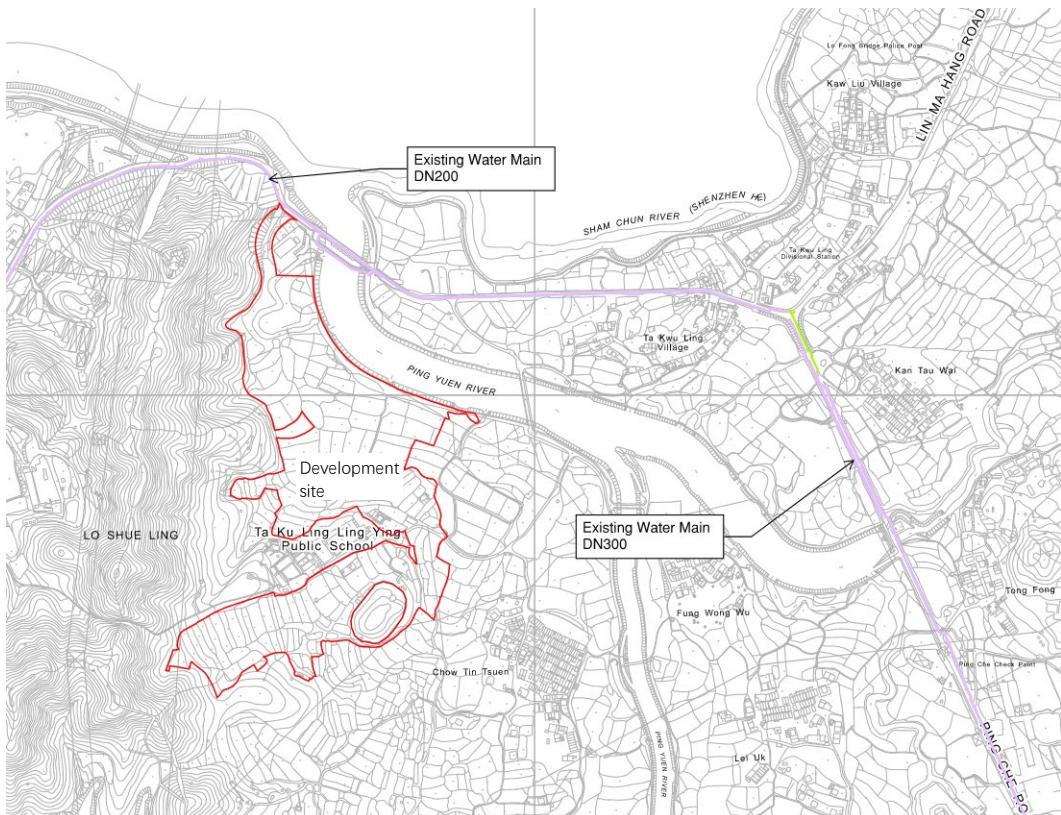

### 3.3 Water Demand Estimation

- 3.3.1 Water demand arising from the Proposed Development has been estimated based on WSD's DI No. 1309 and EPD's GESF as stipulated in **Section 3.1**.
- 3.3.2 The proposed development will generate a total fresh and flushing water demand approximately  $2,977 \text{ m}^3/\text{day}$  and  $2,337 \text{ m}^3/\text{day}$  respectively. The water demand estimation for the proposed development is shown in **Appendix C**.
- 3.3.3 According to Section 3.1.7, peak flow rate of fresh and flushing water of the site is 3 times water demand which are  $8,931 \text{ m}^3/\text{day}$  and  $7,011 \text{ m}^3/\text{day}$ .

### 3.4 Potential Impact to Existing and Planned Waterworks Facilities

- 3.4.1 As per the Water Main Record Plans provided by WSD (**Appendix B**), there is a DN300 water main with a capacity of  $10,992 \text{ m}^3/\text{day}$  (under average velocity of  $1.8 \text{ m/s}$ ) was laid on the east side of the site. The total water demand from application site is **27.1%** of

capacity of distribution main. Considering the land use nature and the development status of the adjacent area, the potential impact of the application site to the distribution main is severe.

- 3.4.2 The proposed development is located in existing supply zone of Ping Che Fresh Water Service Reservoir (PC FWSR) which has no spare capacity to serve the development.
- 3.4.3 There is another FWSR close to the proposed development, which is Table Hill Fresh Water Service Reservoir (TBH FWSR). TBH FWSR has a design storage capacity of 27,450 m<sup>3</sup> with Top Water Level (TWL) as 106.0mPD. The application site is located approximately 3,200m away. According to WSD recording, THB has spare capacity for the development.
- 3.4.4 According to the communication with WSD, Table Hill No.2 Fresh Water Service Reservoir is now used as a Reclaimed Water Service Reservoir, which will possibly have the capacity for the development.
- 3.4.5 Hydraulic analysis is made in order to evaluation the residual head from the TBH FWSR and TBH Reclaimed Water Service Reservoir. Two different scenarios are included for the fresh water supply system:
- (a) Peak Flow with 3 x Mean Daily Demand;
  - (b) Fire-fighting Scenario with 1 x Mean Daily Demand.
- For reclaimed water supply system, one scenario is included:
- (c) Peak Flow with 2 x Mean Daily Demand;
- 3.4.6 For fresh water supply system, only the worse case scenario as scenario (a) is reviewed. The total headloss for scenario (a) is calculated to be 33.61m. As the highest Ground Level of the Development Site is approximately 24mPD and the Invert Level of TBH FWSR is 100mPD, the residual head for the worse case (scenario a) is 42.39m, which should be sufficient for the Development Site.
- 3.4.7 For reclaimed water supply system, total headloss for scenario (c) is calculated to be 7.97m. The Invert Level of TBH RWSR is 70mPD, the residual head is 38.03m, which is sufficient for the Development Site.
- 3.4.8 Hydraulic calculation can be referred to Appendix D.


## 3.5 Proposed Water Supply System

- 3.5.1 It is noted that the site is nearby the study boundary of the Remaining Phase Development of the New Territories North (NTN) - Planning and Engineering Study for NTN New Town and

Man Kam To – Investigation, CE 21/2021(CE) under CEDD. Since new waterworks infrastructures are required for the CE 21/2021(CE) Study for the long-term land supply in NTN New Town and Man Kam To, it is suggested to switch the water source from TBH FWSR to the new water supply infrastructure. Preliminary communication is started and further liaise is necessary during the development of both project.


- 3.5.2** For temporary measure, a DN300 water main is proposed to be laid from the development to the distribution main of existing TBH FWSR close to Man Kam To Road and Sha Lin Road. Possible route and the connection point of the new water main is shown in **Figure 3.2**. Water meter is proposed within the site boundary of Development Site. The proposed fresh water main will be constructed by Project Proponent and handle over to WSD for future maintenance.

**Figure 3.2:** Indicative Fresh Water Supply Connection to Application Site

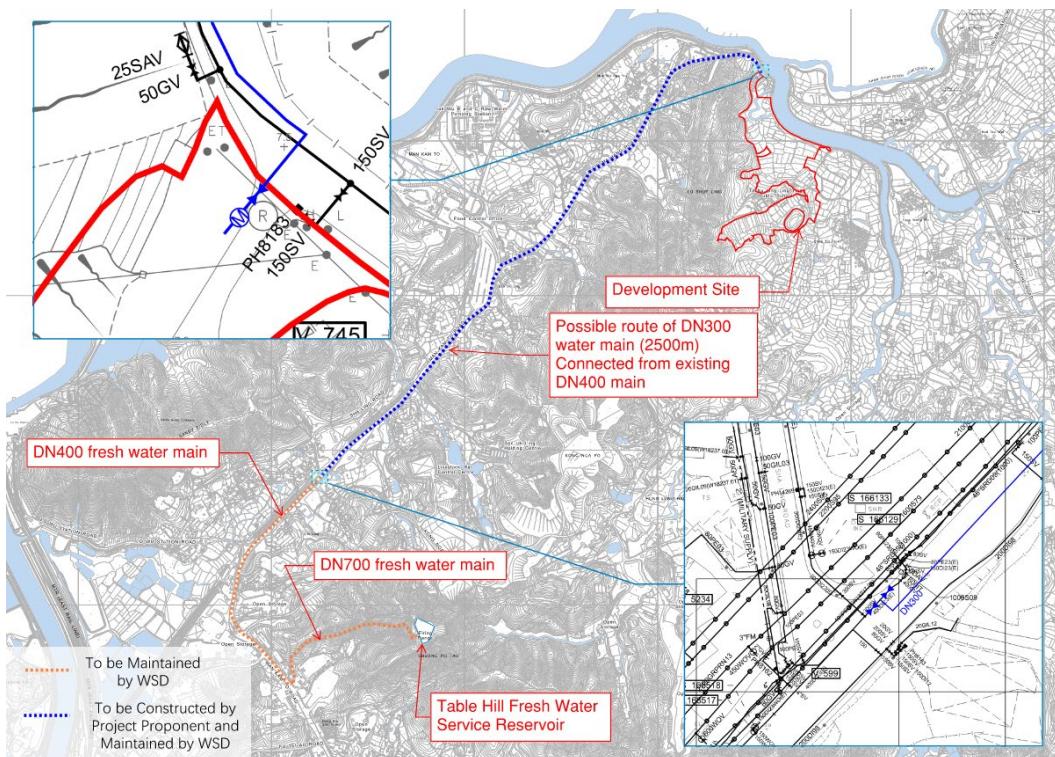

- 3.5.3** A DN300 reclaimed water main connecting from existing Table Hill Reclaimed Water Service Reservoir is proposed for flushing use as shown in **Figure 3.3**. Water meter is proposed within the site boundary of Development Site. The proposed reclaimed water main will be constructed by Project Proponent and handle over to WSD for future maintenance.

**Figure 3.3: Indicative Reclaimed Water Supply Connection to Application Site**

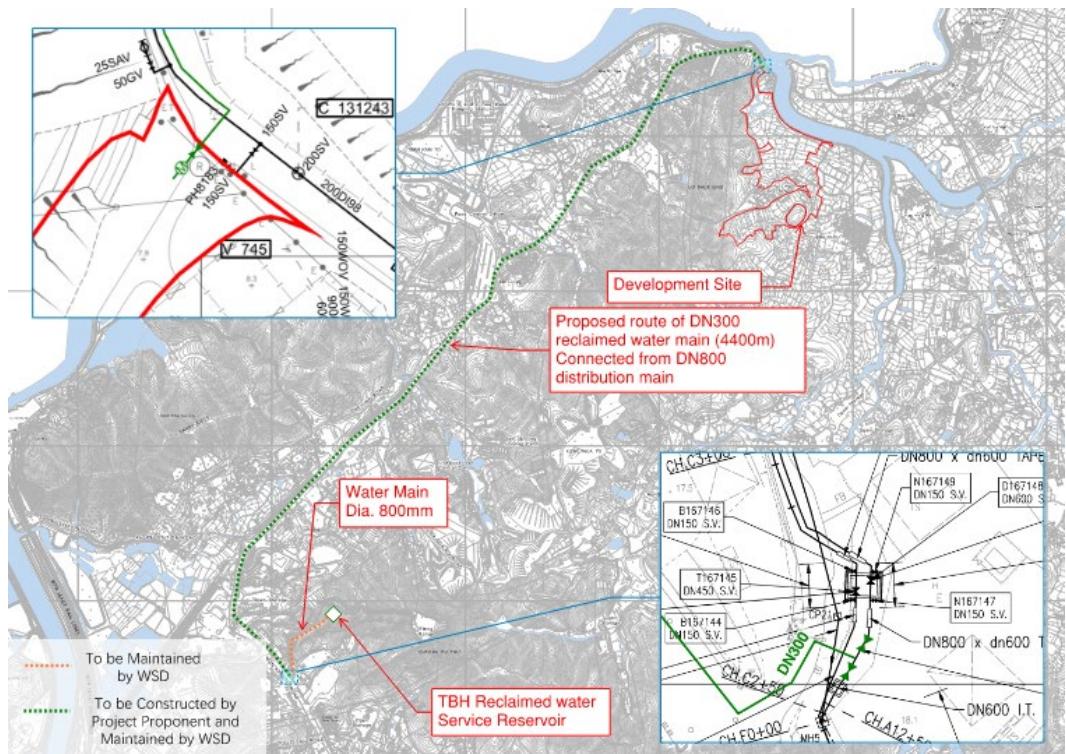


## 4 Conclusion

---

- 4.1.1 The Indicative Scheme will generate a total freshwater demand of 4,913 m<sup>3</sup>/day, which includes temporary main fresh (TMF) 2,337 m<sup>3</sup>/day.
- 4.1.2 For temporary measure, Table Hill Fresh Water Service Reservoir has the spare capacity for the site. But for the long term, new water infrastructure from CE21/2021 is suggested for future development.
- 4.1.3 This WSIA has proposed temporary measures of water supply for the Proposed Development to make up for the capacity of the water supply infrastructure in the existing supply zone. Detailed design on the proposed water supply scheme for the Proposed Development will be carried out at detailed design/ GBP submission stage should this application for plan amendment be approved.

# **Appendix A**

## **Master Layout Plan**

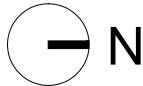


## LEGEND

- Application Site Boundary
- - - Development Site Boundary
- - - Site Formation Level

- ▶ SITE RUN-IN/OUT
- ▶ ACCESS TO BASEMENT CARPARK

<span style="background-color: #4f81bd; border: 1px solid black; width: 15px; height: 15px; display: inline-block;"></span>	R&D CENTRE	<span style="background-color: #c8e6c9; border: 1px solid black; width: 15px; height: 15px; display: inline-block;"></span>	ANCILLARY DORMITORIES	<span style="background-color: #ff7f50; border: 1px solid black; width: 15px; height: 15px; display: inline-block;"></span>	PROMENADE
<span style="background-color: #8050a0; border: 1px solid black; width: 15px; height: 15px; display: inline-block;"></span>	DATA CENTRE	<span style="background-color: #82e0AA; border: 1px solid black; width: 15px; height: 15px; display: inline-block;"></span>	CLUBHOUSE		
<span style="background-color: #fca82d; border: 1px solid black; width: 15px; height: 15px; display: inline-block;"></span>	RESIDENTIAL	<span style="background-color: #32CD32; border: 1px solid black; width: 15px; height: 15px; display: inline-block;"></span>	LANDSCAPE AREA		
<span style="background-color: #8050a0; border: 1px solid black; width: 15px; height: 15px; display: inline-block;"></span>	COMMERCIAL	<span style="background-color: #cccccc; border: 1px solid black; width: 15px; height: 15px; display: inline-block;"></span>	SEWAGE TREATMENT PLANT		

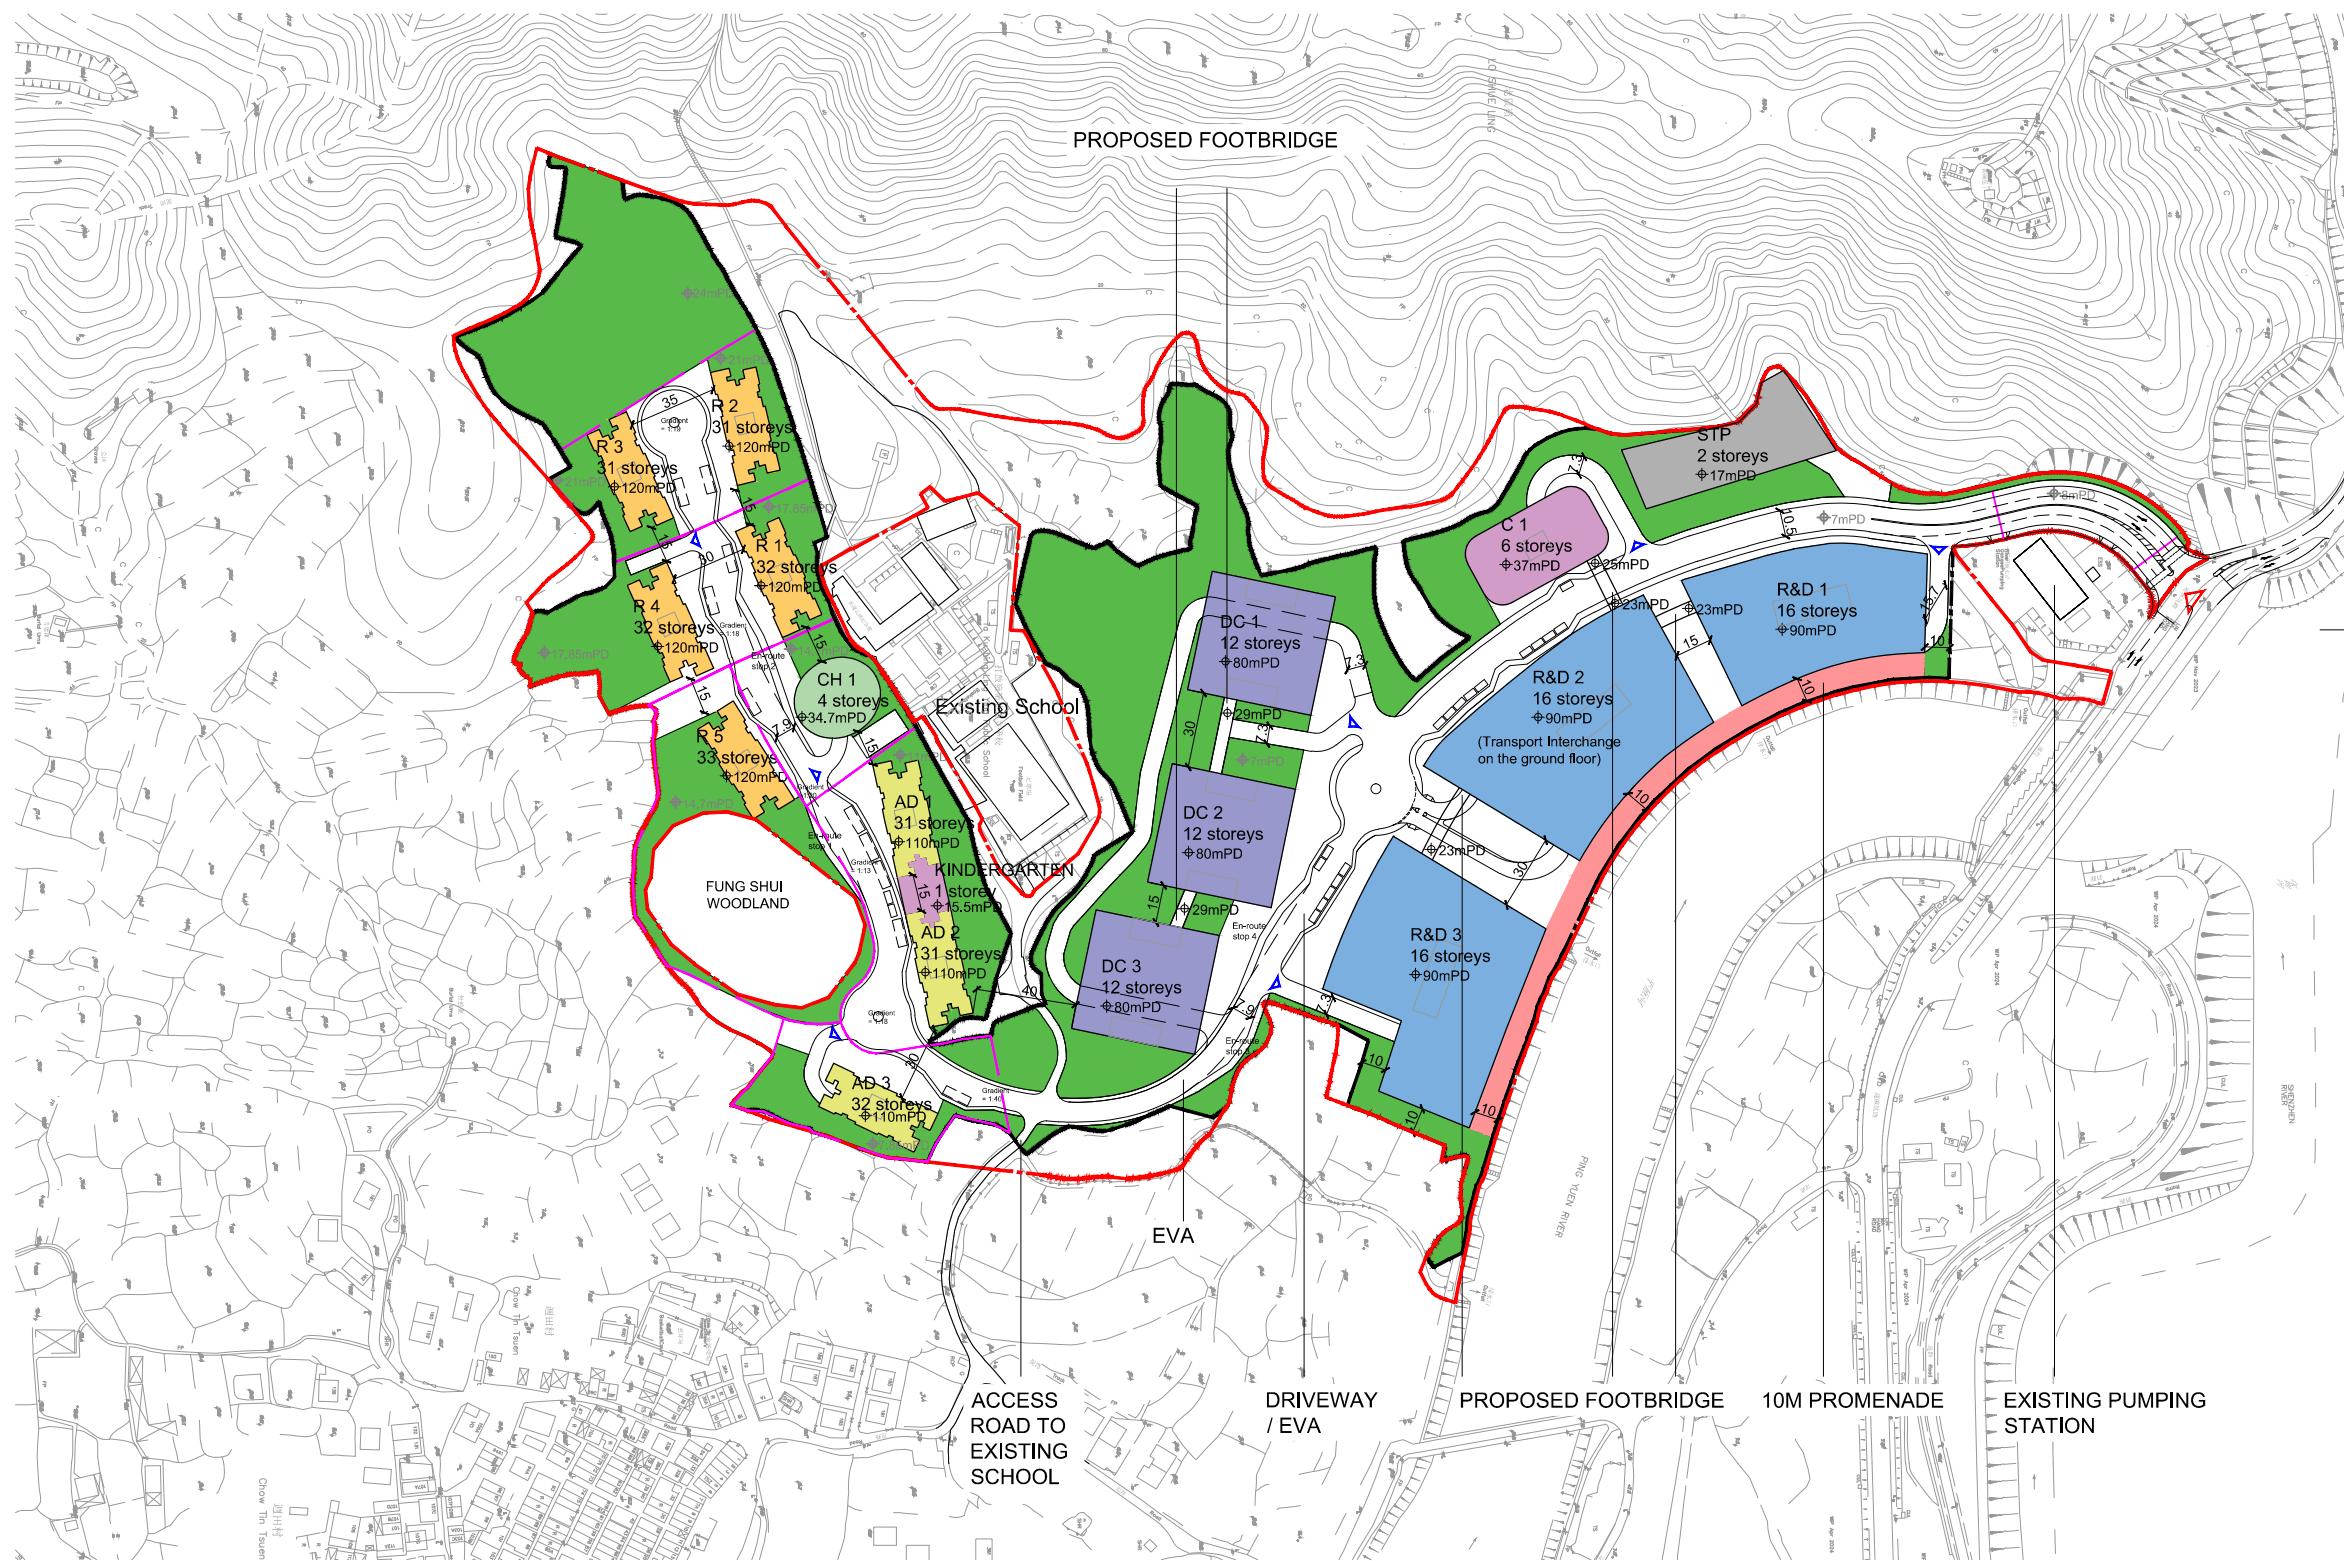

Rev. Date Description

Notes  
1. Do not scale drawings. Dimensions govern.  
2. Verify dimensions in field. Notify WCWP if discrepancies.  
3. Dimensions in m unless otherwise noted.  
4. Not for construction unless expressly certified.



Client  
Hong Kong International Innovation Tech Hub

Consultants

Issue  
Planning Application

BD Ref: BD 2/9188/10 (PT. II)  
FSD Ref: FP 8/9584/VII <131>

Authorized Person

Project  
The Nexus

Project Number 20027 Date 20241219

Scale 1:3000 at A3 Drawn/Approved CL/TL


Title Master Layout Plan

Number MLP-001 Revision -


## **Appendix B**

### Existing WSD Water Main Record Plans

INSET 'A'

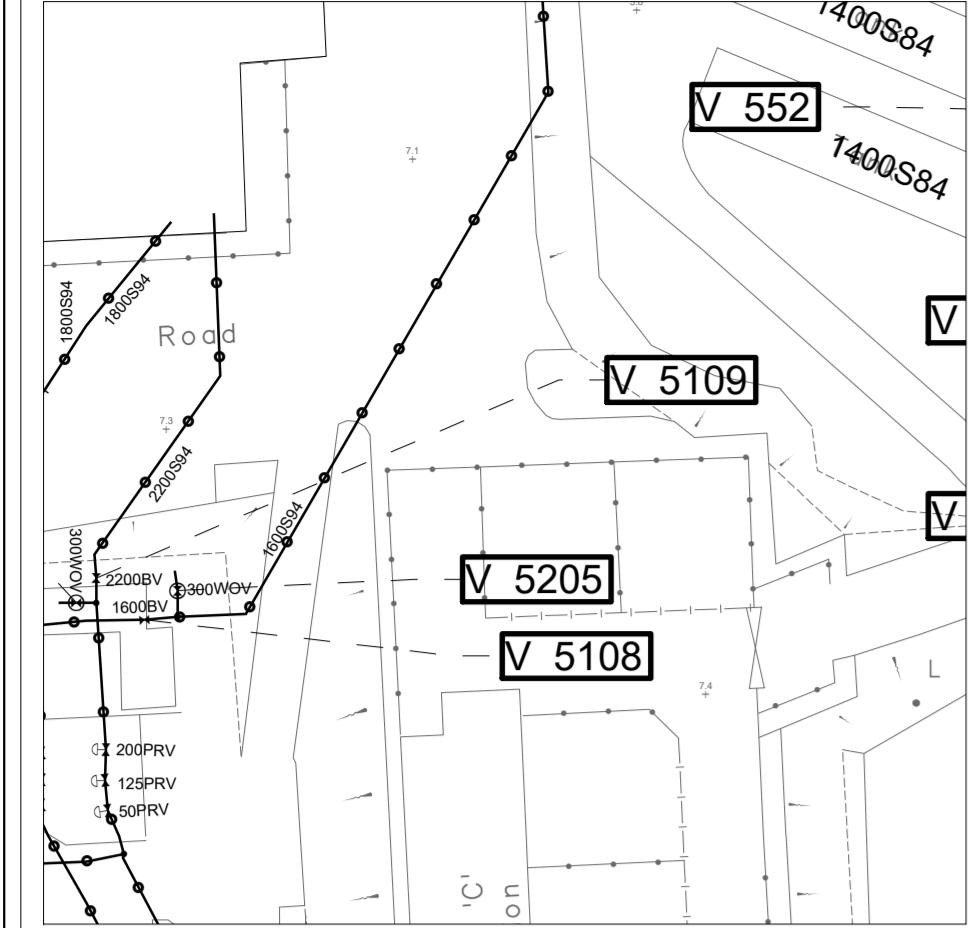

INSET 'B'

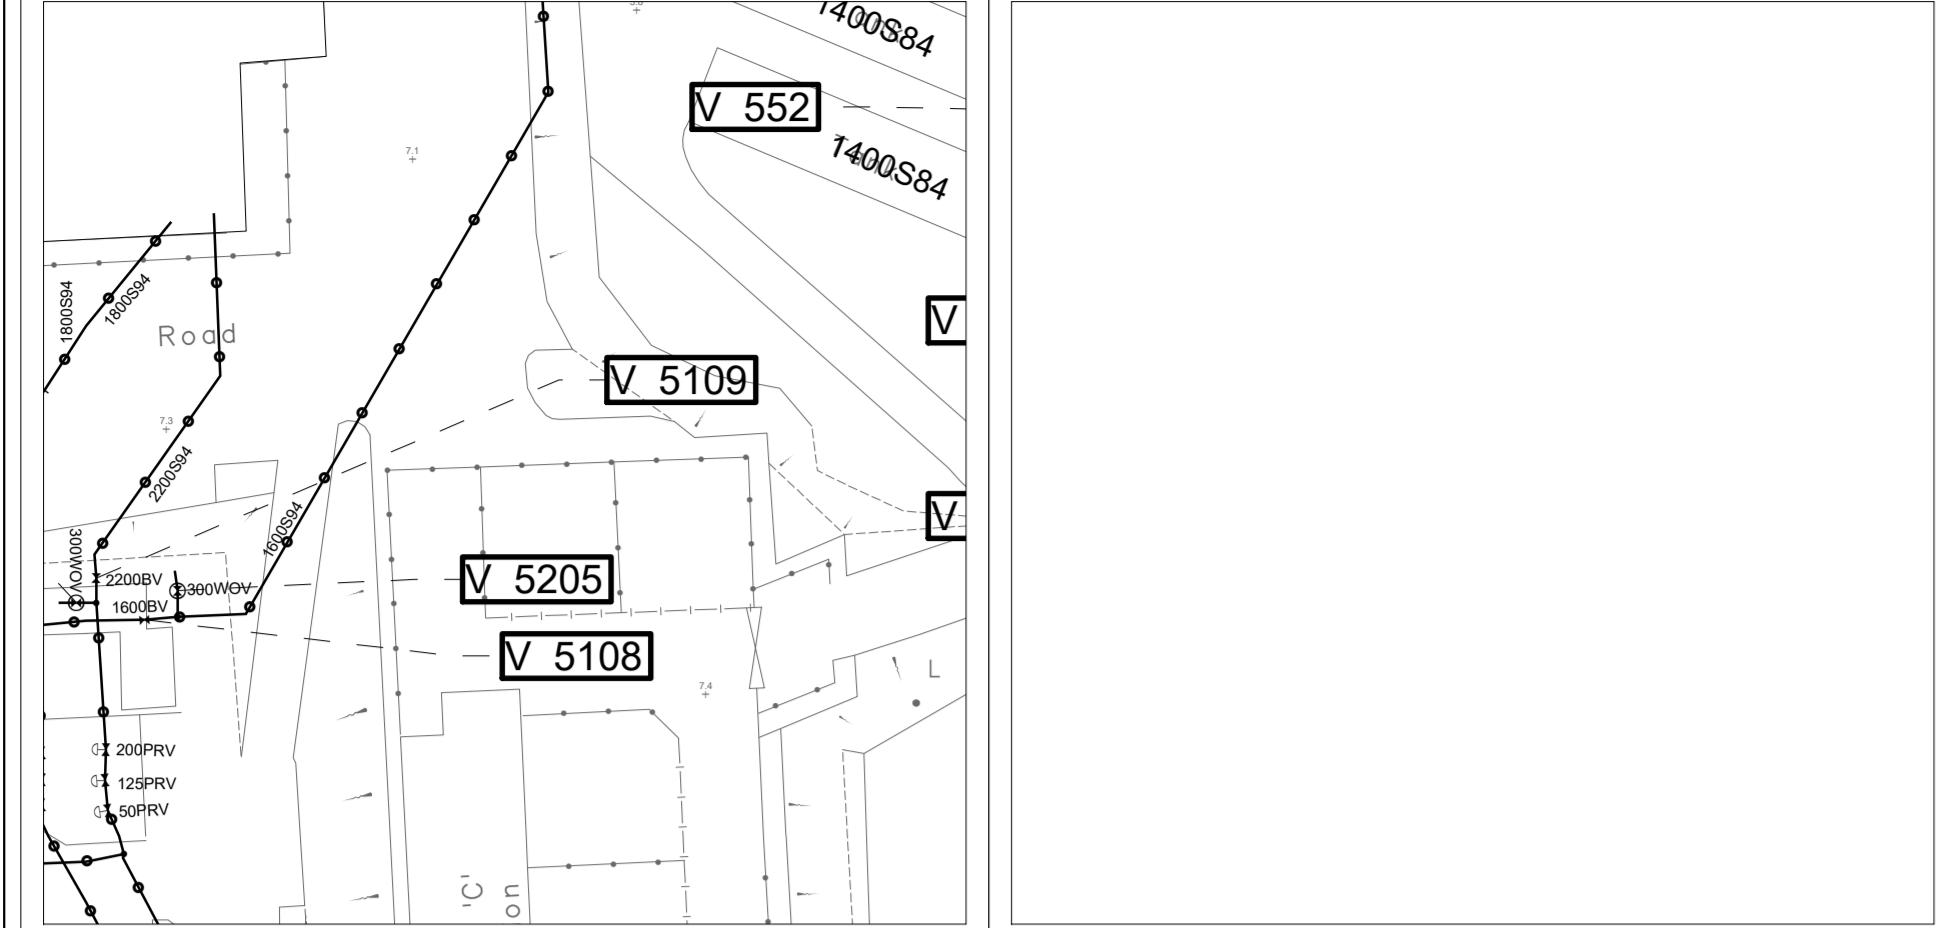


INSET 'C'




INSET 'D'



INSET 'E'

 

INSET 'F'

 

Scale 1:500

3-NW-12A



## NOTES:

1. FOR MAINS RECORDS SIGN CONVENTIONS AND DESIGNATIONS SEE SKETCH NO.3988.
2. DIMENSIONS OF MAINS ARE IN MILLIMETRES UNLESS OTHERWISE SPECIFIED.
3. ALL LEVELS ARE IN METRES ABOVE PRINCIPAL DATUM.


3-NW-17A

FRESH WATER MAINS RECORD PLAN

MUK WU 'B' F.W. P/S, MUK WU

THIS IS A COMPUTER PRINTOUT,  
NO SIGNATURE IS REQUIRED.COPYRIGHT RESERVED  
DATE REVISED : 02/04/2024DRAWING NO.  
W67880/ 3-NW-12CSIGNED  
C.S. CHIN  
CE/MNEWater Supplies Department  
HONG KONG

DATE: 09/11/1998

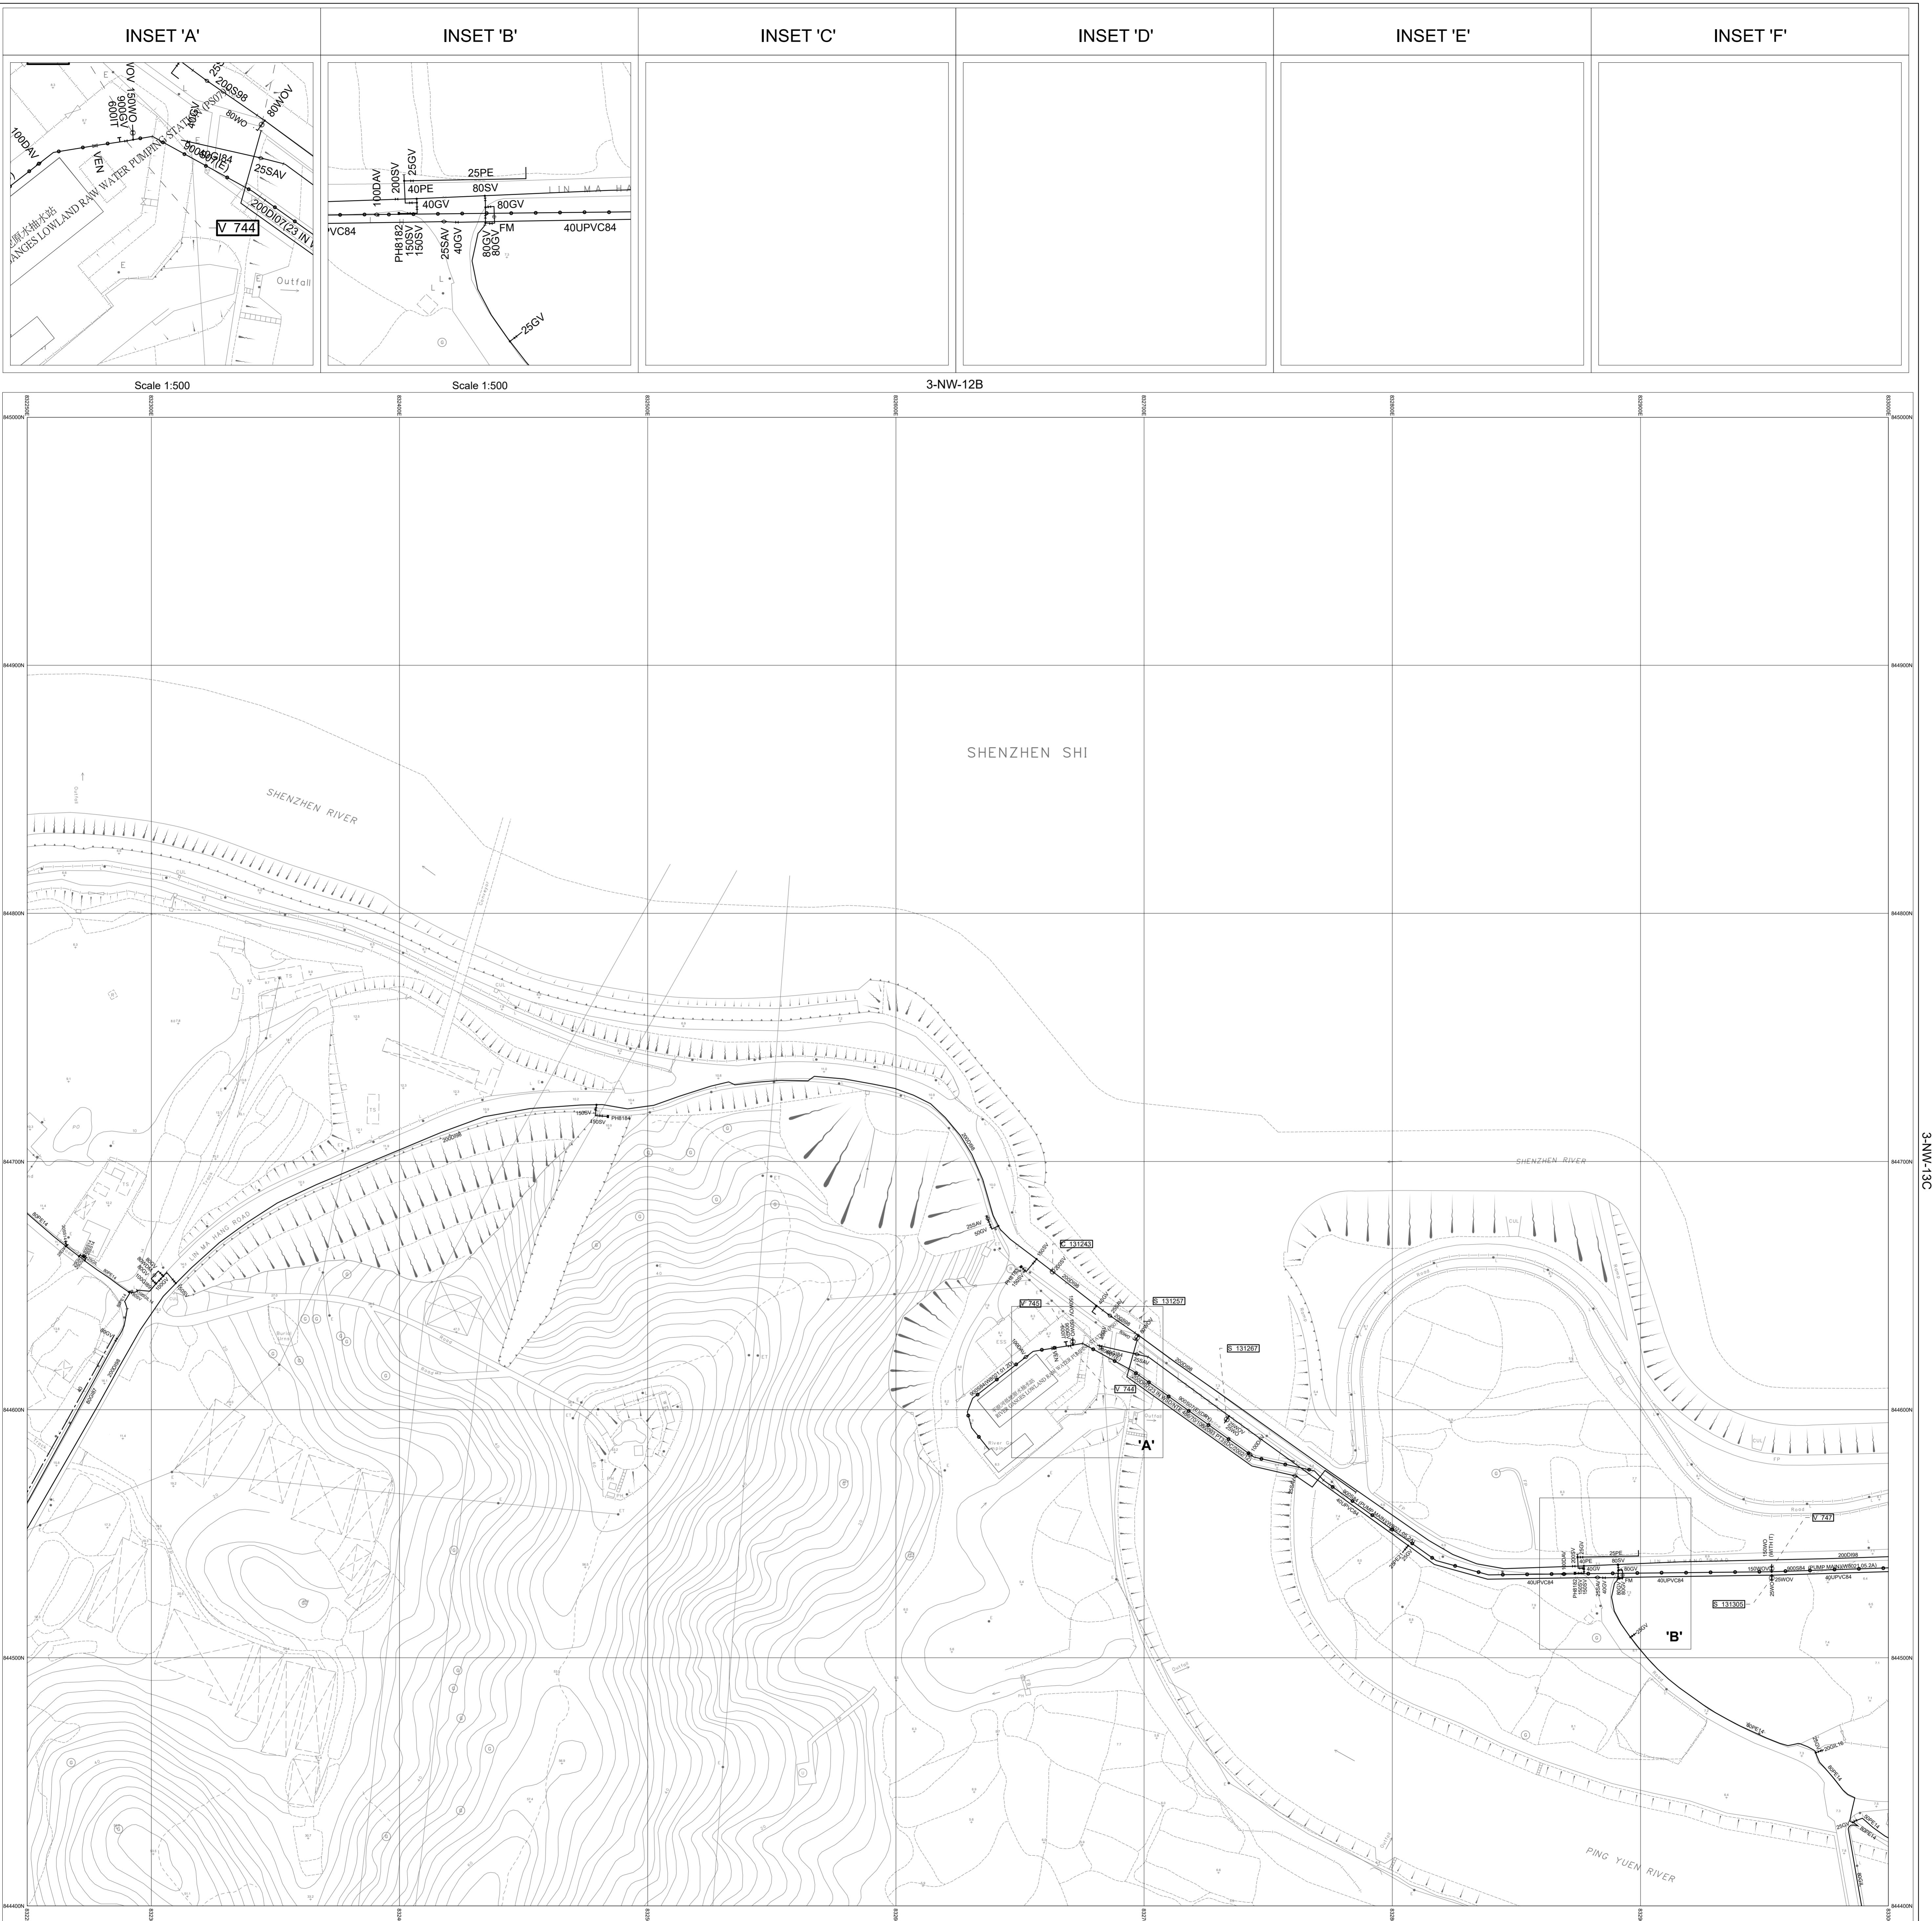

## NOTES

- NOTES.**

  1. FOR MAINS RECORDS SIGN CONVENTIONS AND DESIGNATIONS SEE SKETCH NO.3988.
  2. DIMENSIONS OF MAINS ARE IN MILLIMETRES UNLESS OTHERWISE SPECIFIED.
  3. ALL LEVELS ARE IN METRES ABOVE PRINCIPAL DATUM.

Date Updated On: 30/04/2019

SCALE 1:1 000


---

1

# FRESH WATER MAINS RECORD PLAN

RIVER GANGES F.W. P/S

THIS IS A COMPUTER PRINTOUT  
NO SIGNATURE IS REQUIRED.

COPYRIGHT RESERVED

DATE REVISED : 02/04/2024

DRAWING NO.

W67880/ 3-NW-12D

 Water Supplies Department

CE/MNE



## Water Supplies Department

## HONG KONG

DATE: 09/11/1998

© The Government of the Hong Kong

INSET 'A'


INSET 'B'

INSET 'C'

INSET 'D'

INSET 'E'

INSET 'F'

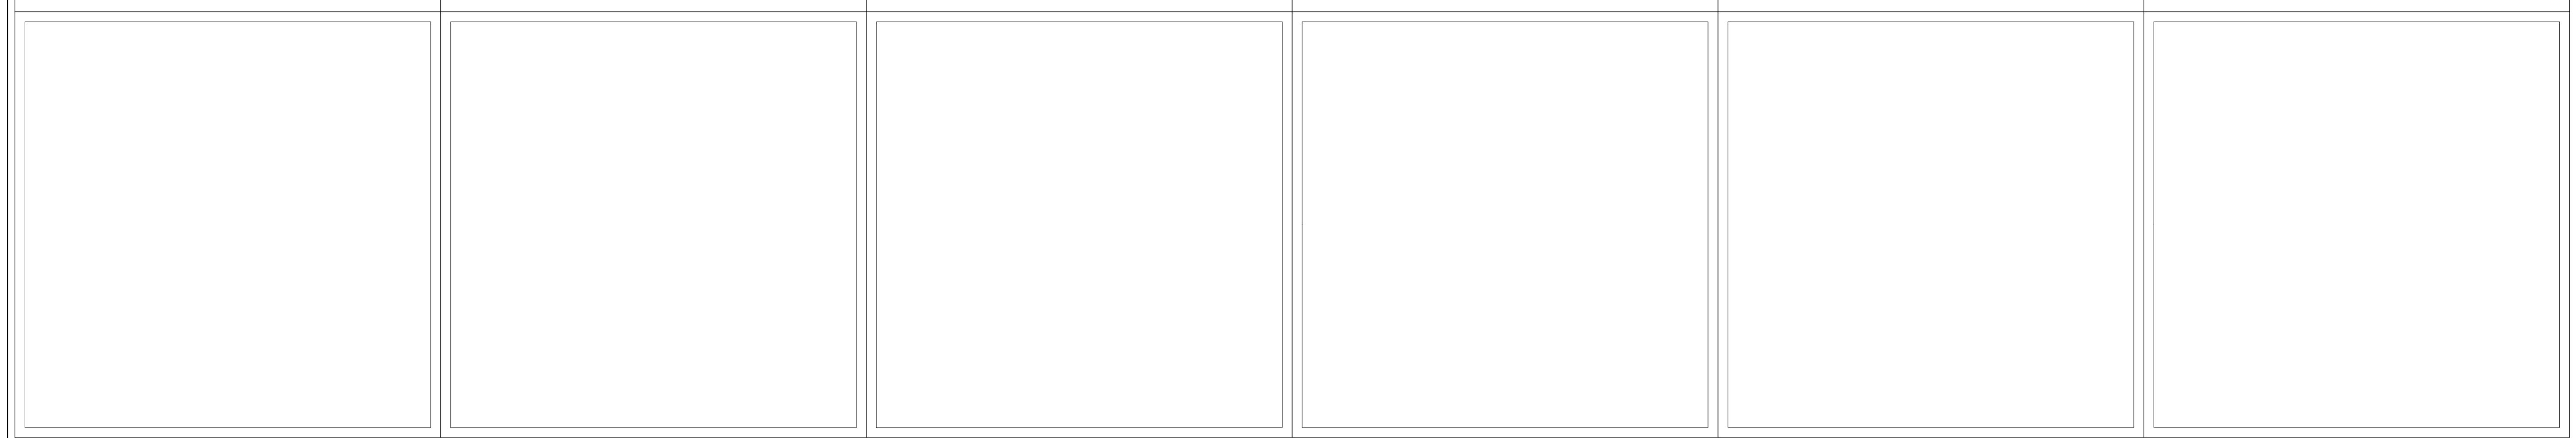

3-NW-16B



3-NW-17C

NOTES:	
1. FOR MAINS RECORDS SIGN CONVENTIONS AND DESIGNATIONS SEE SKETCH NO.3988.	
2. DIMENSIONS OF MAINS ARE IN MILLIMETRES UNLESS OTHERWISE SPECIFIED.	
3. ALL LEVELS ARE IN METRES ABOVE PRINCIPAL DATUM.	
Basemap Data Updated On: 30/04/2019	THIS IS A COMPUTER PRINTOUT, NO SIGNATURE IS REQUIRED.
SCALE 1:1 000	COPYRIGHT RESERVED
METRES 20 10 0 20 40 60 80 100 METRES	DATE REVISED : 01/03/2024


3-NW-21B

### FRESH WATER MAINS RECORD PLAN

MAN KAM TO ROAD, SHA LING

SIGNED	C.S. CHIN CE/MNE	DRAWING NO. W67880/ 3-NW-16D
		Water Supplies Department
		HONG KONG

DATE: 09/11/1998

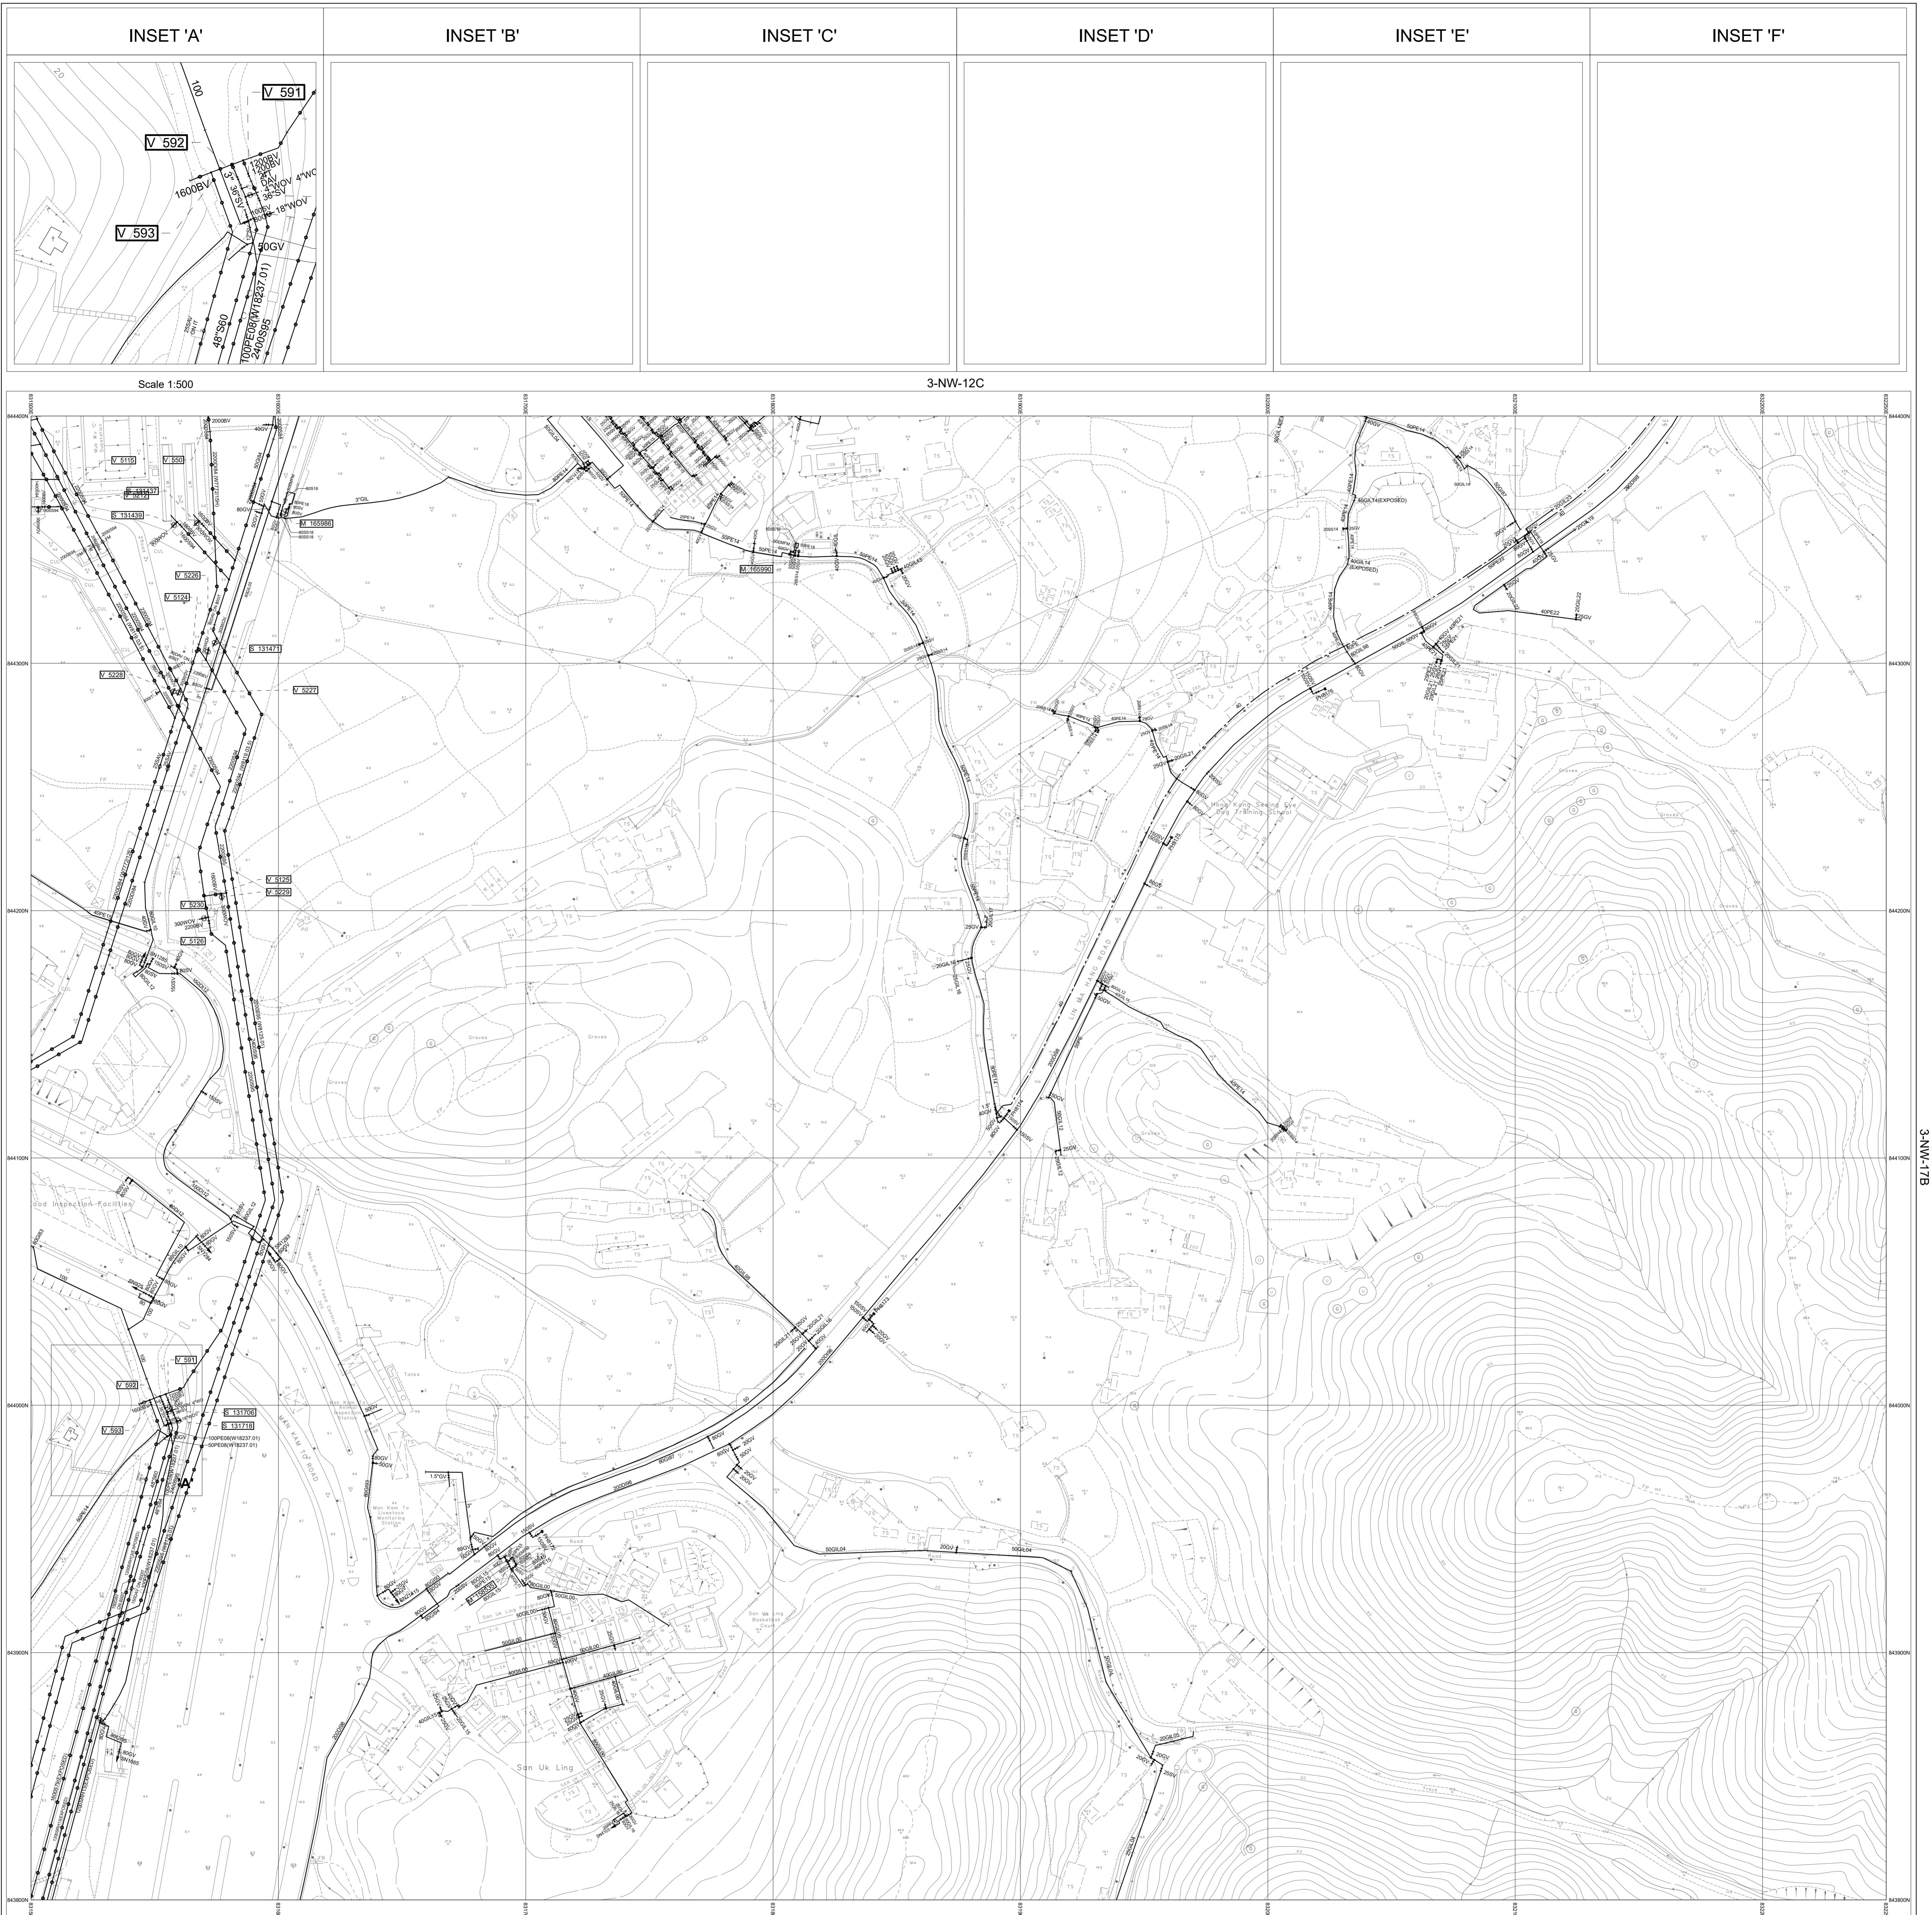

## NOTE

- NOTES.**

  1. FOR MAINS RECORDS SIGN CONVENTIONS AND DESIGNATIONS SEE SKETCH NO.3988.
  2. DIMENSIONS OF MAINS ARE IN MILLIMETRES UNLESS OTHERWISE SPECIFIED.
  3. ALL LEVELS ARE IN METRES ABOVE PRINCIPAL DATUM.

Last Update On: 30/04/2019

SCALE 1:1 000


1

# FRESH WATER MAINS RECORD PLAN

## J/O MAN KAM TO ROAD & LIN MA HANG ROAD

THIS IS A COMPUTER PRINTOUT  
NO SIGNATURE IS REQUIRED.

COPYRIGHT RESERVED

**DRAWING NO.**


DATE REVISED : 02/05/2024

 Water Supplies Department

HONG KONG

SIGNED C.S. CHIN  
CHIN

DATE: 09/11/1998

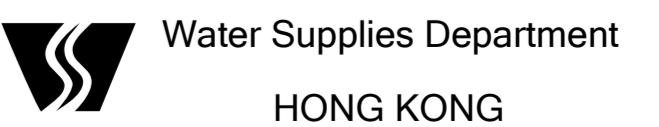










INSET 'A'

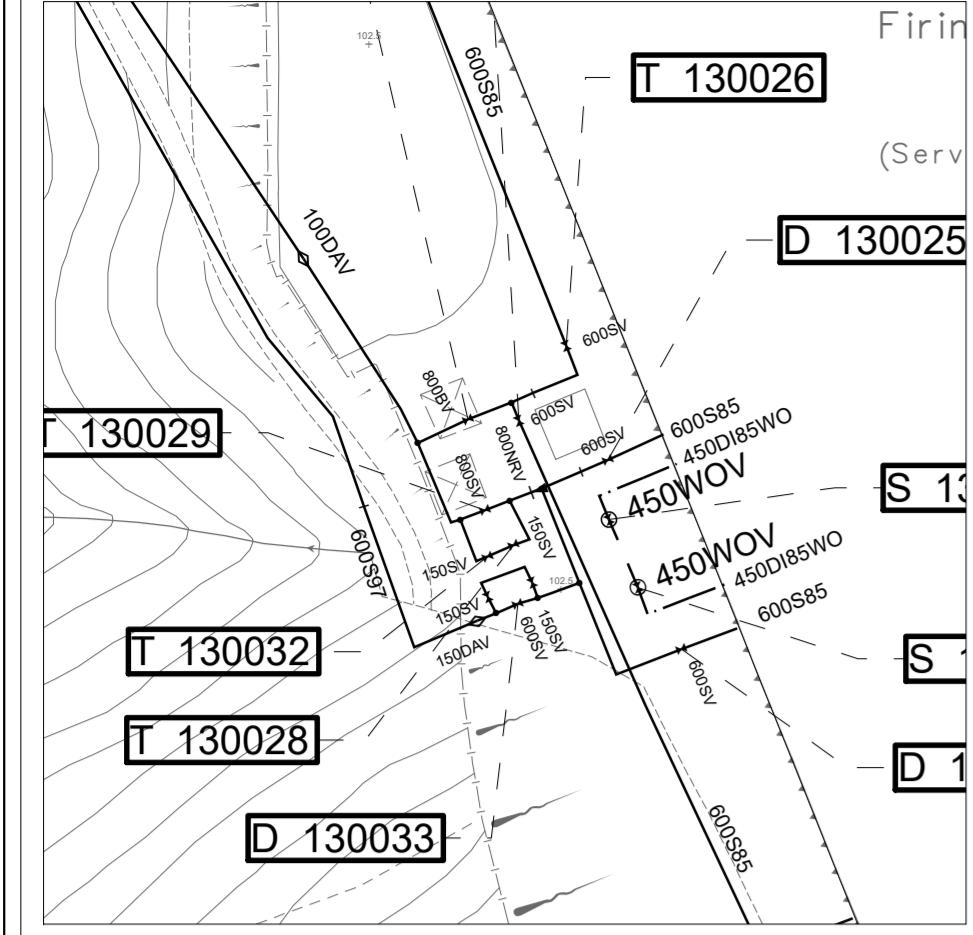


INSET 'B'

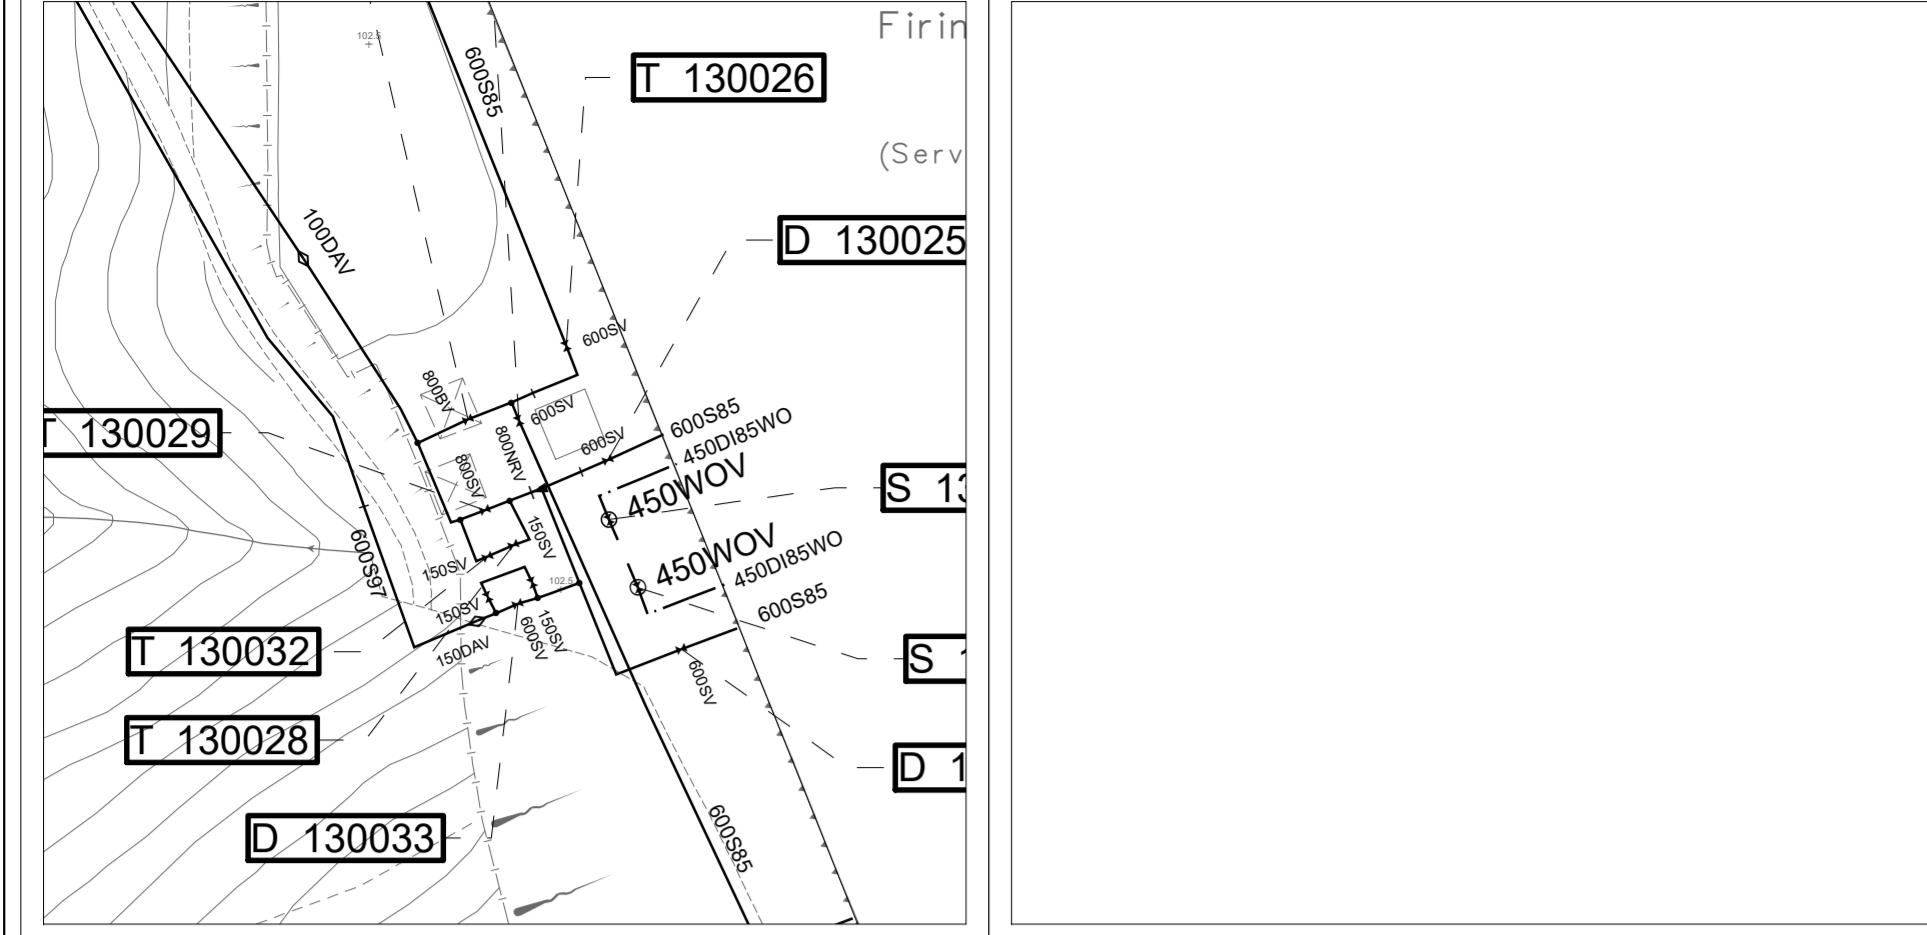


INSET 'C'

 


INSET 'D'

 

INSET 'E'

 

INSET 'F'

 

Scale 1:500

3-NW-21B



3-NW-21C

3-NW-21B

3-SW-1B

## NOTES:

1. FOR MAINS RECORDS SIGN CONVENTIONS AND DESIGNATIONS SEE SKETCH NO.3988.
2. DIMENSIONS OF MAINS ARE IN MILLIMETRES UNLESS OTHERWISE SPECIFIED.
3. ALL LEVELS ARE IN METRES ABOVE PRINCIPAL DATUM.

THIS IS A COMPUTER PRINTOUT,  
NO SIGNATURE IS REQUIRED.COPYRIGHT RESERVED  
DATE REVISED : 02/01/2025DRAWING NO.  
W67880/ 3-NW-21DSIGNED  
C.S. CHIN  
CE/MNEWater Supplies Department  
HONG KONG

DATE: 09/11/1998

FRESH WATER MAINS RECORD PLAN


TABLE HILL F.W. S/R, CHEUNG PO TAU


Baseline Data Updated On: 23/12/2024




SCALE 1:1 000

METRES 20 10 0 20 40 60 80 100 METRES

1

 

 

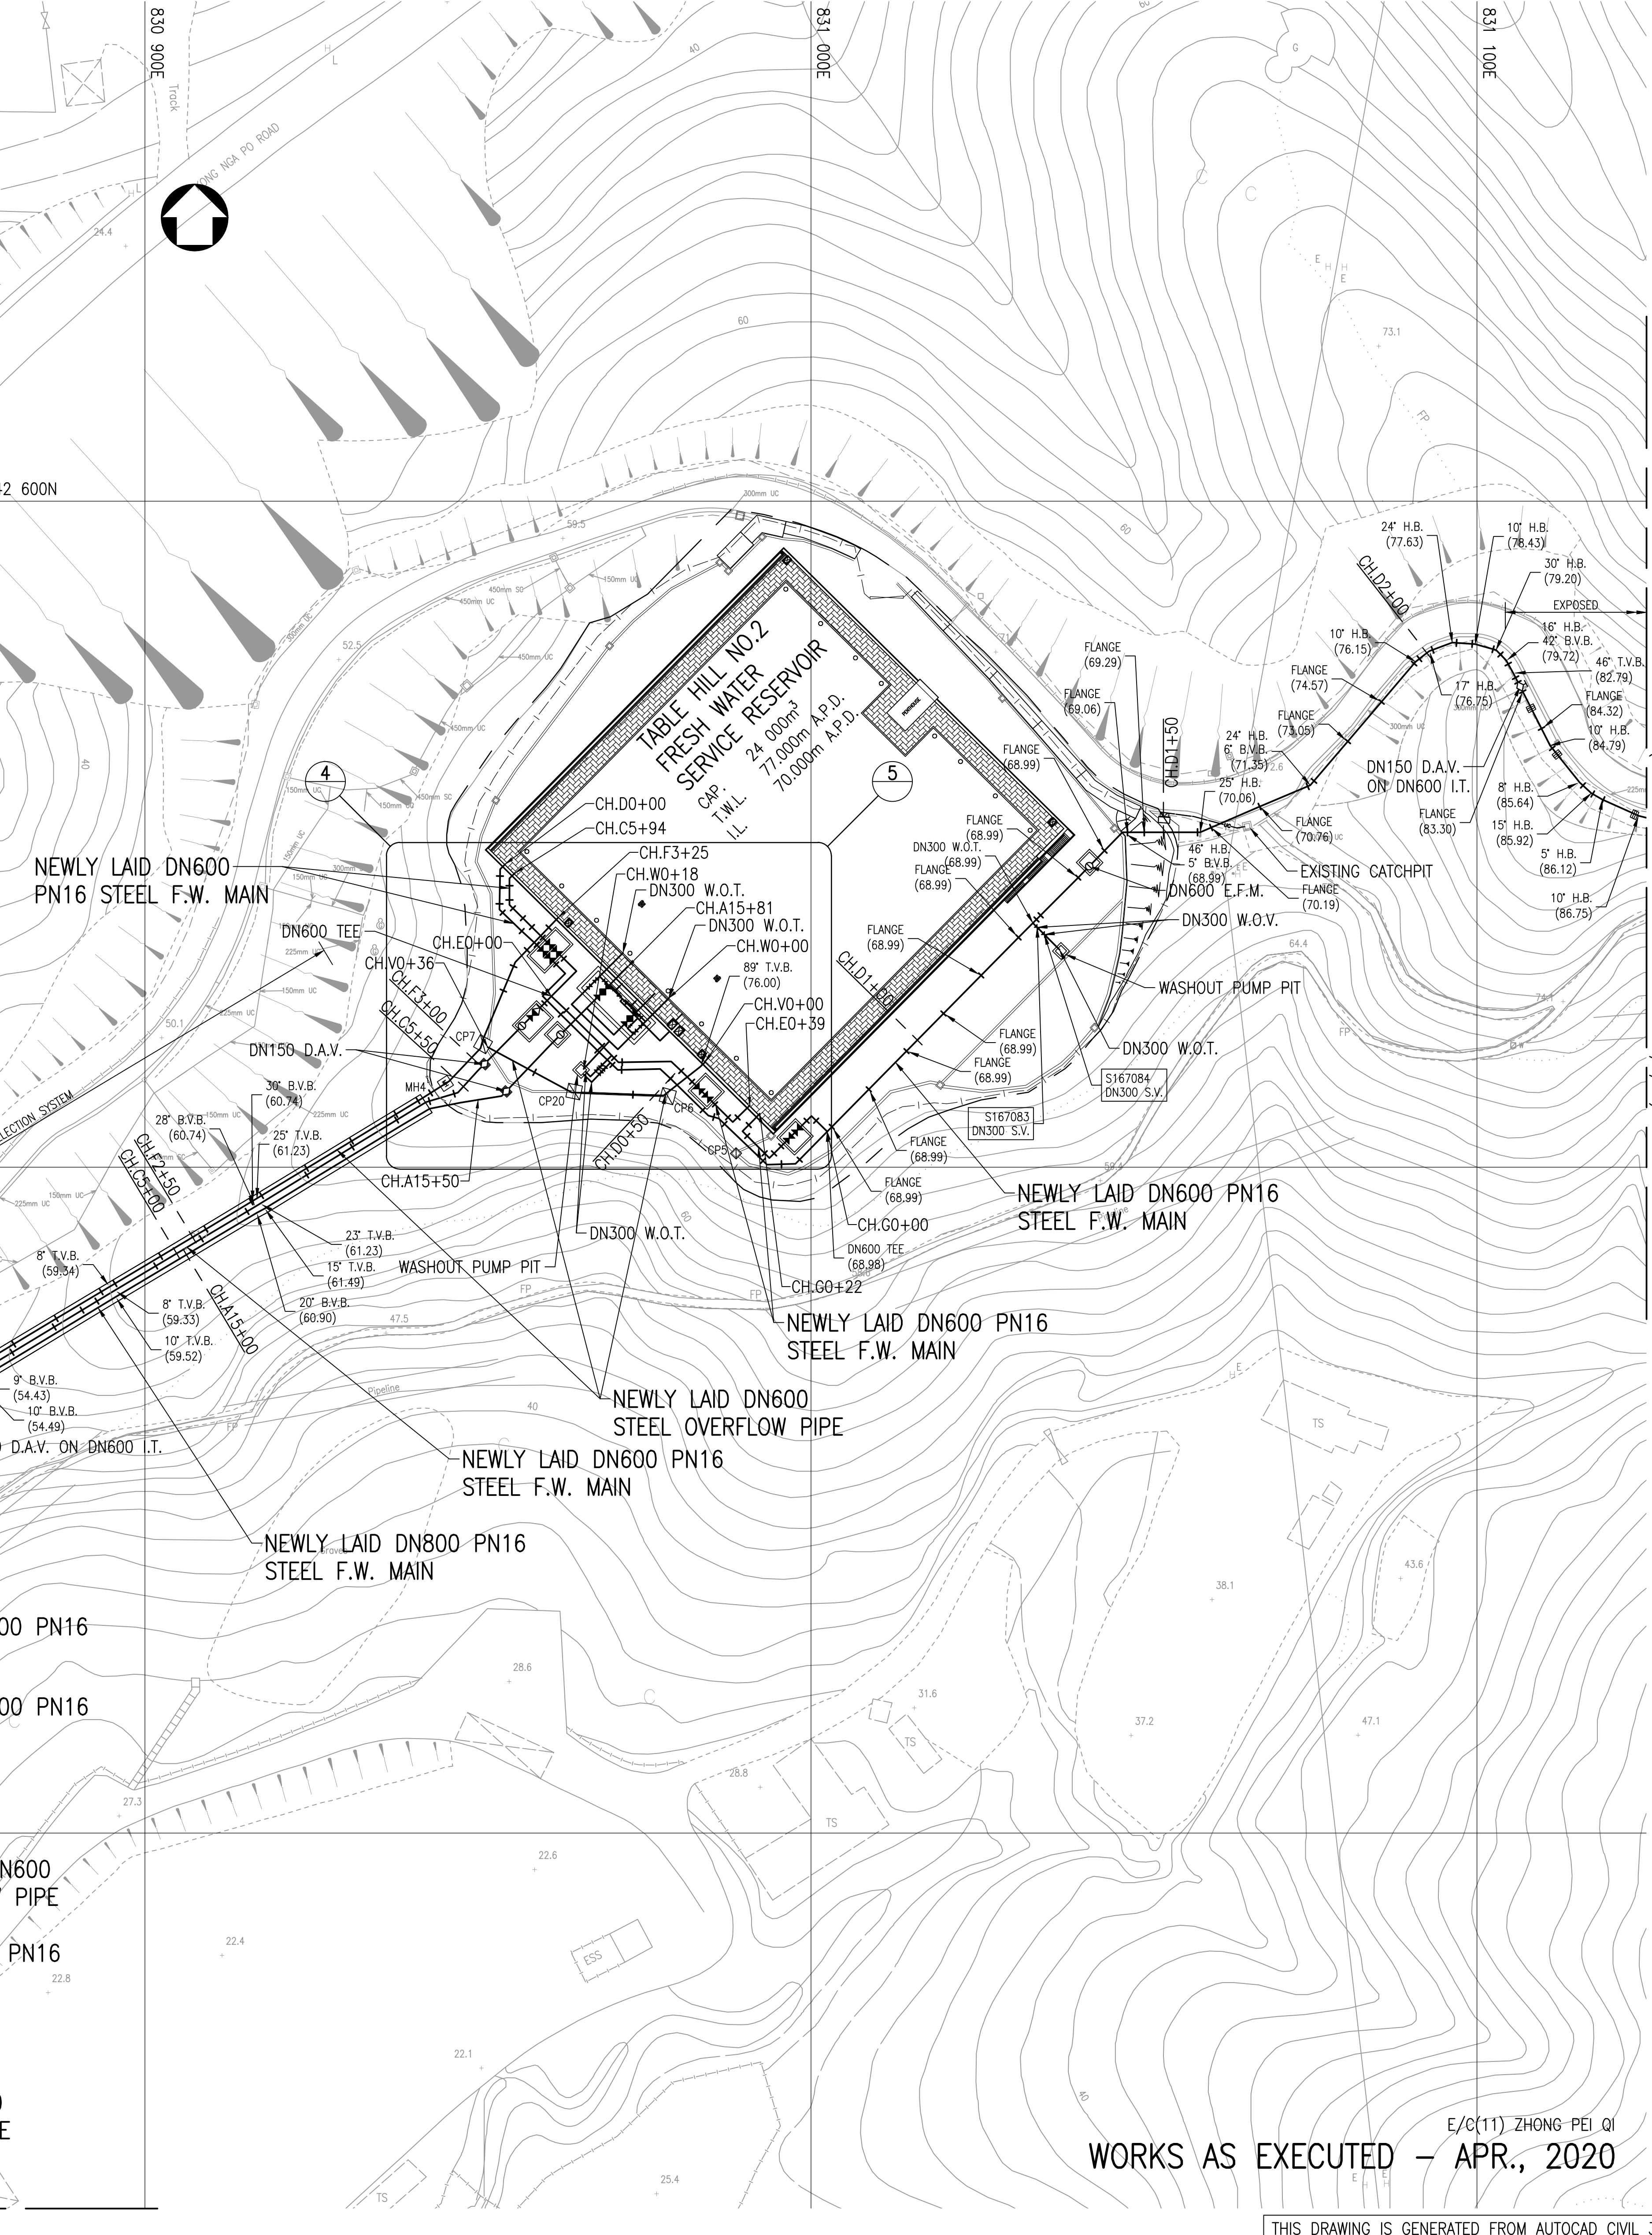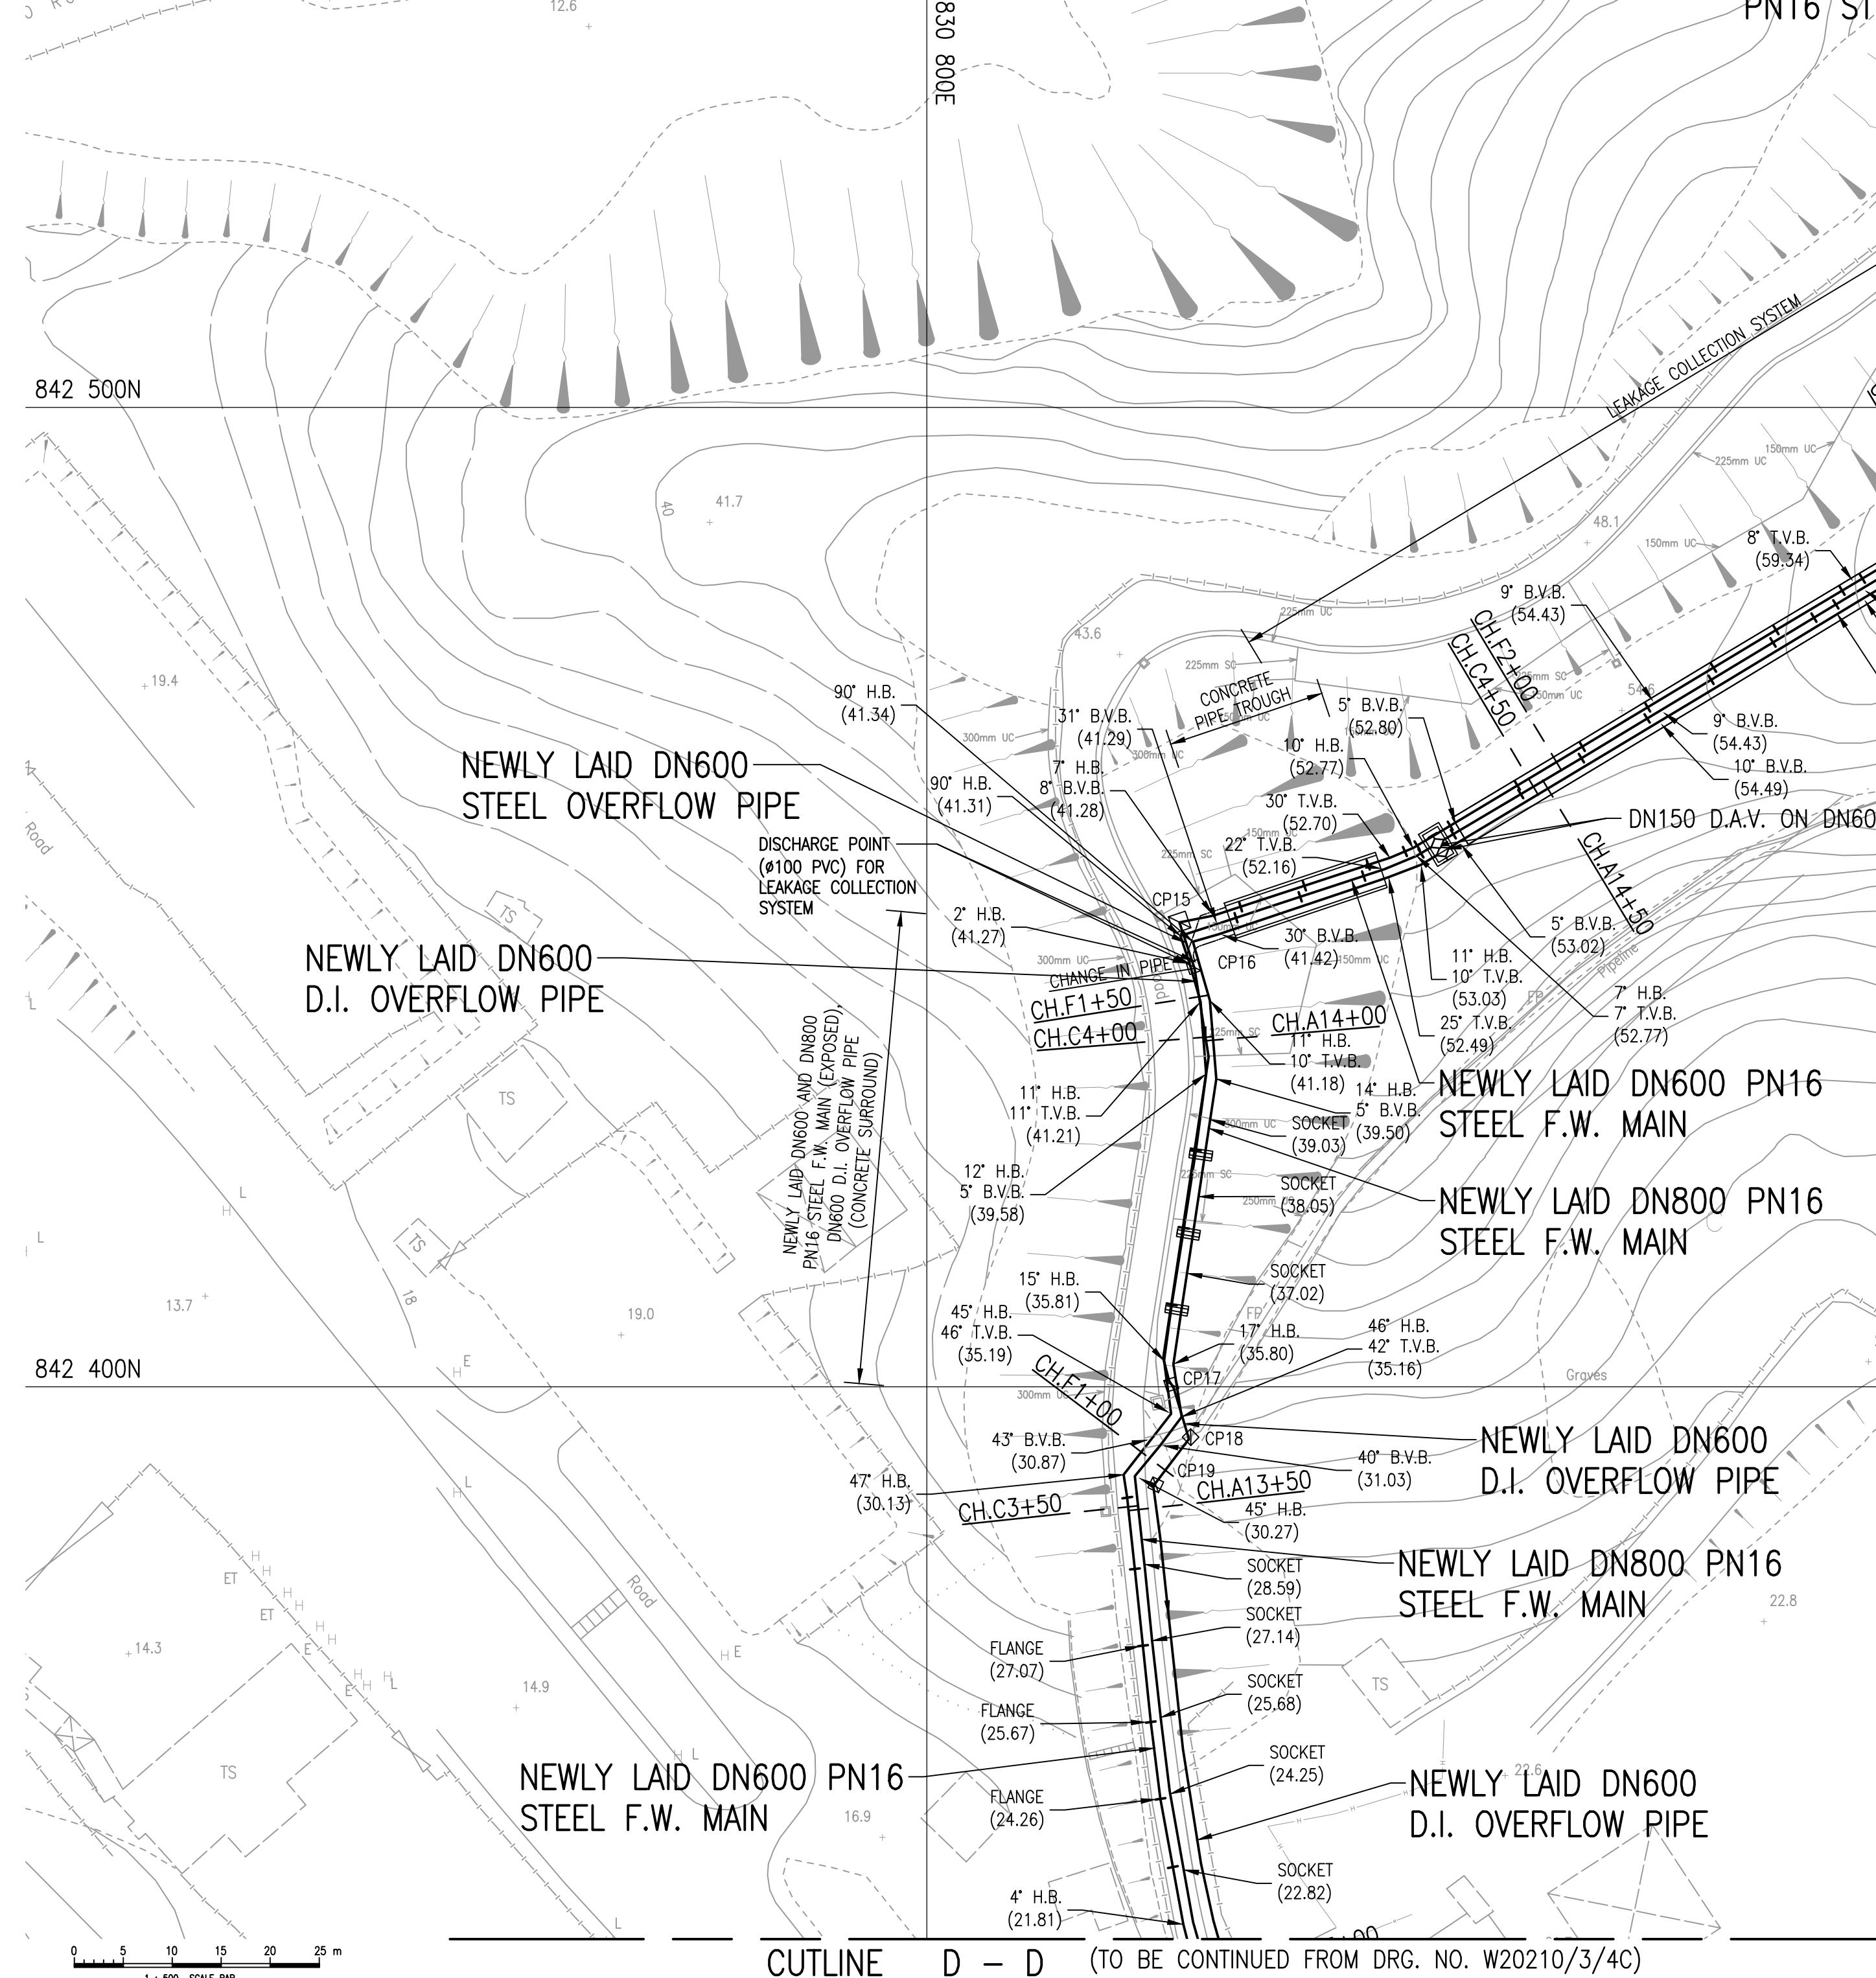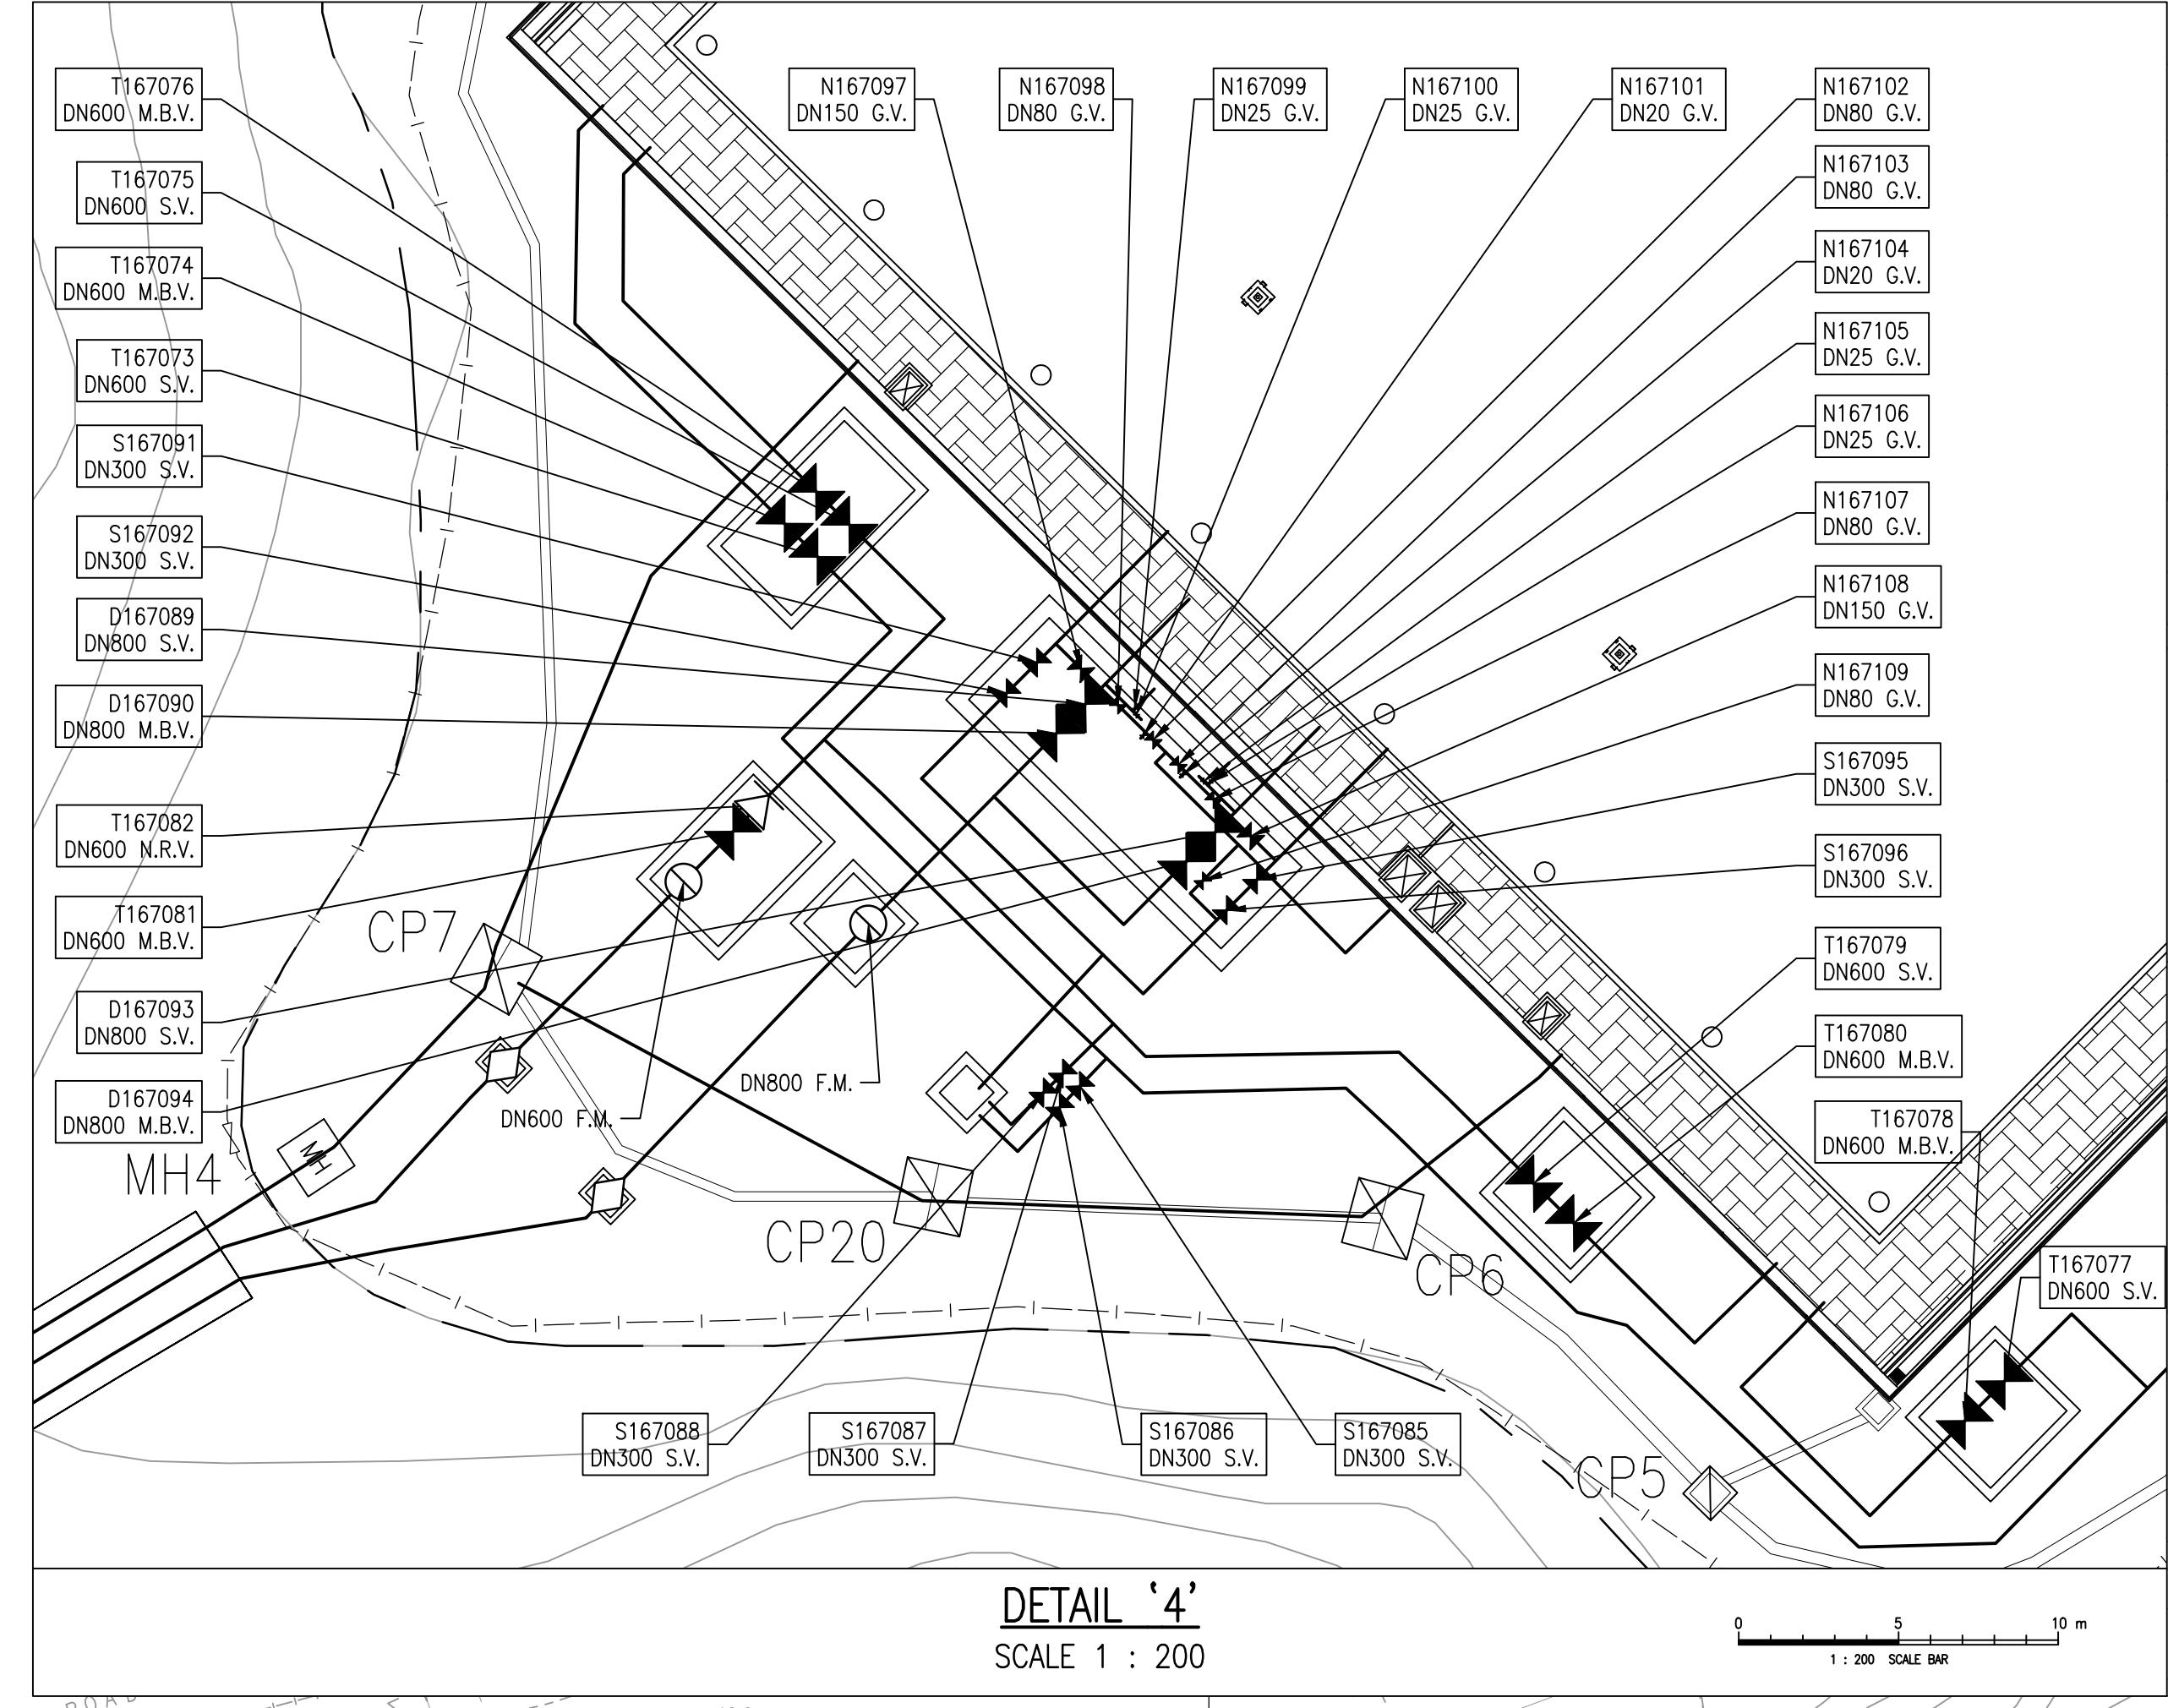

**NOTES:**

**COPYRIGHT RESERVED**  
This print may not be copied, traced, or exhibited without permission of the Water Authority.

1. FOR GENERAL NOTES, LEGEND AND ABBREVIATIONS REFER TO DRAWING NO. W20210/3/1C.
2. THE BASE MAP IS EXTRACT FROM SURVEY SHEET NOS. 3-NW-21A, 21B, 21C & 21D AND DRAWING NOS. WS1130/T/10, 11 & 22 OF SURVEY SECTION, WSD.
3. REFER TO DRAWING NO. W20210/3/6B FOR DETAIL 5.

**C // AS CONSTRUCTED**  
E/C(11)  
ZHONG PEI QI  
CONTRACTOR'S REPRESENTATIVE

**B // THIS AS-CONSTRUCTED DRAWING IS PREPARED BY VASTEAM CONSTRUCTION LIMITED**

**A // GENERAL REVISION**  
E/DW/12  
ANDREE LAU  
W. Y. WAN

**REVISION**

序號	設計	姓名	簽名	日期
1	designed	W. Y. WAN	(SIGNED)	13/12/16
2	drawn	W. S. FUNG	(SIGNED)	13/12/16
3	checked	W. Y. WAN	(SIGNED)	13/12/16
4	endorsed	W. C. KWOK	(SIGNED)	13/12/16
5	approved	S. K. YEUNG CE/Design	(SIGNED)	13/12/16

合約編號 4/WSD/16  
合同編號 WSD 7497/0/10/4 PT.5  
工程編號 9350WF  
合約 contract

IMPROVEMENT OF WATER  
SUPPLY TO SHEUNG SHUI AND  
FANLING

圖則名稱 drawing title  
**MAINLAYING -**

ALIGNMENT PLAN  
(SHEET 5 OF 6)

圖則編號 drawing no.  
**W 20210/3/5C**  
比例 scale  
1 : 500  
OR  
AS SHOWN

**水務署**  
Water Supplies Department

THIS DRAWING IS GENERATED FROM AUTOCAD CIVIL 3D

CAD REF. 04WSD16-WSD-SS-WS-ML-WM-M3\_A-001.dwg

PLOTTING SCALE 1 = 1

## **Appendix C**

### Water Demand Estimation

**Appendix C : Water Demand Estimation from Proposed Development at Various Lots in D.D. 82 and D.D. 86, Man Kam To, New Territories**

		GFAs (m <sup>2</sup> )	Population (nos.)	Type	Fresh Water Demand			Flusing Water Demand		Total Water Demand (m <sup>3</sup> /d)
					UD (l/h/day)	Units	Demand (m <sup>3</sup> /day)	UD (l/h/day)	Water Demand (m <sup>3</sup> /day)	
Residential	Ancillary Dormitories	63,900	3,758	R1	230	(l/h/day)	864	104	391	1,255
	Other Residential Uses	106,500	6,264	R1	230	(l/h/day)	1,441	104	651	2,092
			10,022	Service Trade	40	(l/h/day)	401			
Non-residential	Data Centre employee	86,400	432	Commercial Employee	30	(l/h/day)	13	50	22	35
	Data Centre Cooling Water								1,000	1,000
	R&D Centre employee	268,780	5,375	Commercial Employee	30	(l/h/day)	161	50	269	430
	Kindergarten Pupil	724	180	Schools	25	(l/h/day)	5	25	5	9
	Irrigation	13,126			7	(l/m <sup>2</sup> /day)	92			92
<b>Total Water Demand (m<sup>3</sup>/day)</b>							<b>2,977</b>		<b>2,337</b>	<b>4,913</b>

NOTES:

- (1) UD for Ancillary Dormitories as per WSD (DI)1309 Table 1 "R1" & Table 2 "other rural areas".
- (2) UD for Other Residential Uses as per WSD (DI)1309 Table 1 "R1" & Table 2 "other rural areas".
- (3) Water demand of service trade is adopted for commercial associated with the residential development.
- (4) UD for Data Centre employee as per GESF Table T-2 Commercial Employee.
- (5) UD for R&D Centre as per GESF Table T-2 Commercial Employee.
- (6) UD for Kindergarten Pupils Uses as per WSD (DI) 1309 Table 1 "Schools".

## **Appendix D**

### **Hydraulic Calculation**

## Appendix D - Hydraulic Calculation

### **Assumptions:**

Kinematic viscosity of liquid in pipe	v	1.01E-06	$\text{m}^2/\text{s}$
---------------------------------------	---	----------	-----------------------

v for water at 20°C 1.01E-06

### **Check conditions**

For the calculations to be accurate (within 1%), the below criteria must be met. These are checked automatically in the "Check" columns, ensure all "Check" cells read "TRUE".

	Lower bound	Upper bound
Roughness Coefficient	k (mm)	0.001
Reynolds Number (Turbulent)	R	4000
Reynolds Number (Laminar)	R	1.00E+08
		2300

## Calculation Table